

MISHRA  
ARCHITECTURE PLLC

6800 S. Creek Rd., Charlotte, NC 28277  
Ph:(704) 625-6554 Fax:(704) 919-5922  
EMAIL: [sashh@mishraarch.com](mailto:sashh@mishraarch.com)  
WEB: [www.mishraarch.com](http://www.mishraarch.com)

OWNER: Anna Beisler & Associates, Inc.  
105 Commercial Parkway  
West Monroe, LA 71294  
Phone (318) 386-3227  
Email: [gabe@abengineering.com](mailto:gabe@abengineering.com)

STRUCTURAL:

WCBP, Inc.  
11225 E. 112th Avenue, Suite 201  
Charlotte, NC 28277  
Phone (704) 542-7199  
Fax: (704) 542-7195  
Email: [mkg@wcbpinc.com](mailto:mkg@wcbpinc.com)

ELECTRICAL:

R. Stane Riter, P.E.  
14032 Montross Lane  
Matthew, NC 28014  
Phone (704) 516-0365  
Email: [stane@ritering.com](mailto:stane@ritering.com)  
Project Number: 13015

MECHANICAL:

W. B. Beisler Engineering Group, P.C.  
212 North McDowell St., Suite 204  
Charlotte, NC 28204  
Phone (704) 334-7963  
Fax: (704) 334-4069  
Email: [dw@wbeng.com](mailto:dw@wbeng.com)

REVISIONS	
No.	Description
11-5-13	Review Comments
11-15-13	Final Comments

--

Information contained on this drawing and in all digital files associated is authorized for use on the project named herein only and is the property of MISHRA ARCHITECTURE PLLC and may not be reproduced, stored in a retrieval system, or transmitted in any form or by any means, electronic or verbal permission from express written or verbal permission from MISHRA ARCHITECTURE PLLC. Original drawing is 24x36" and scales are as indicated. 2011 MISHRA ARCHITECTURE PLLC



KEY PLAN

Southern Hospitality  
Services

Hampton Inn and  
Suites


5400 I-20 & Frontage Rd.  
Monroe, LA 71201

Drawing Title  
Electrical Site Plan

Phase  
Construction Documents


Project No.	12-111	Sheet No.
Prepared by	RSR	
Checked by	RSR	E0.3
Date	Sept. 16, 2013	

Released for  
PERMIT ONLY

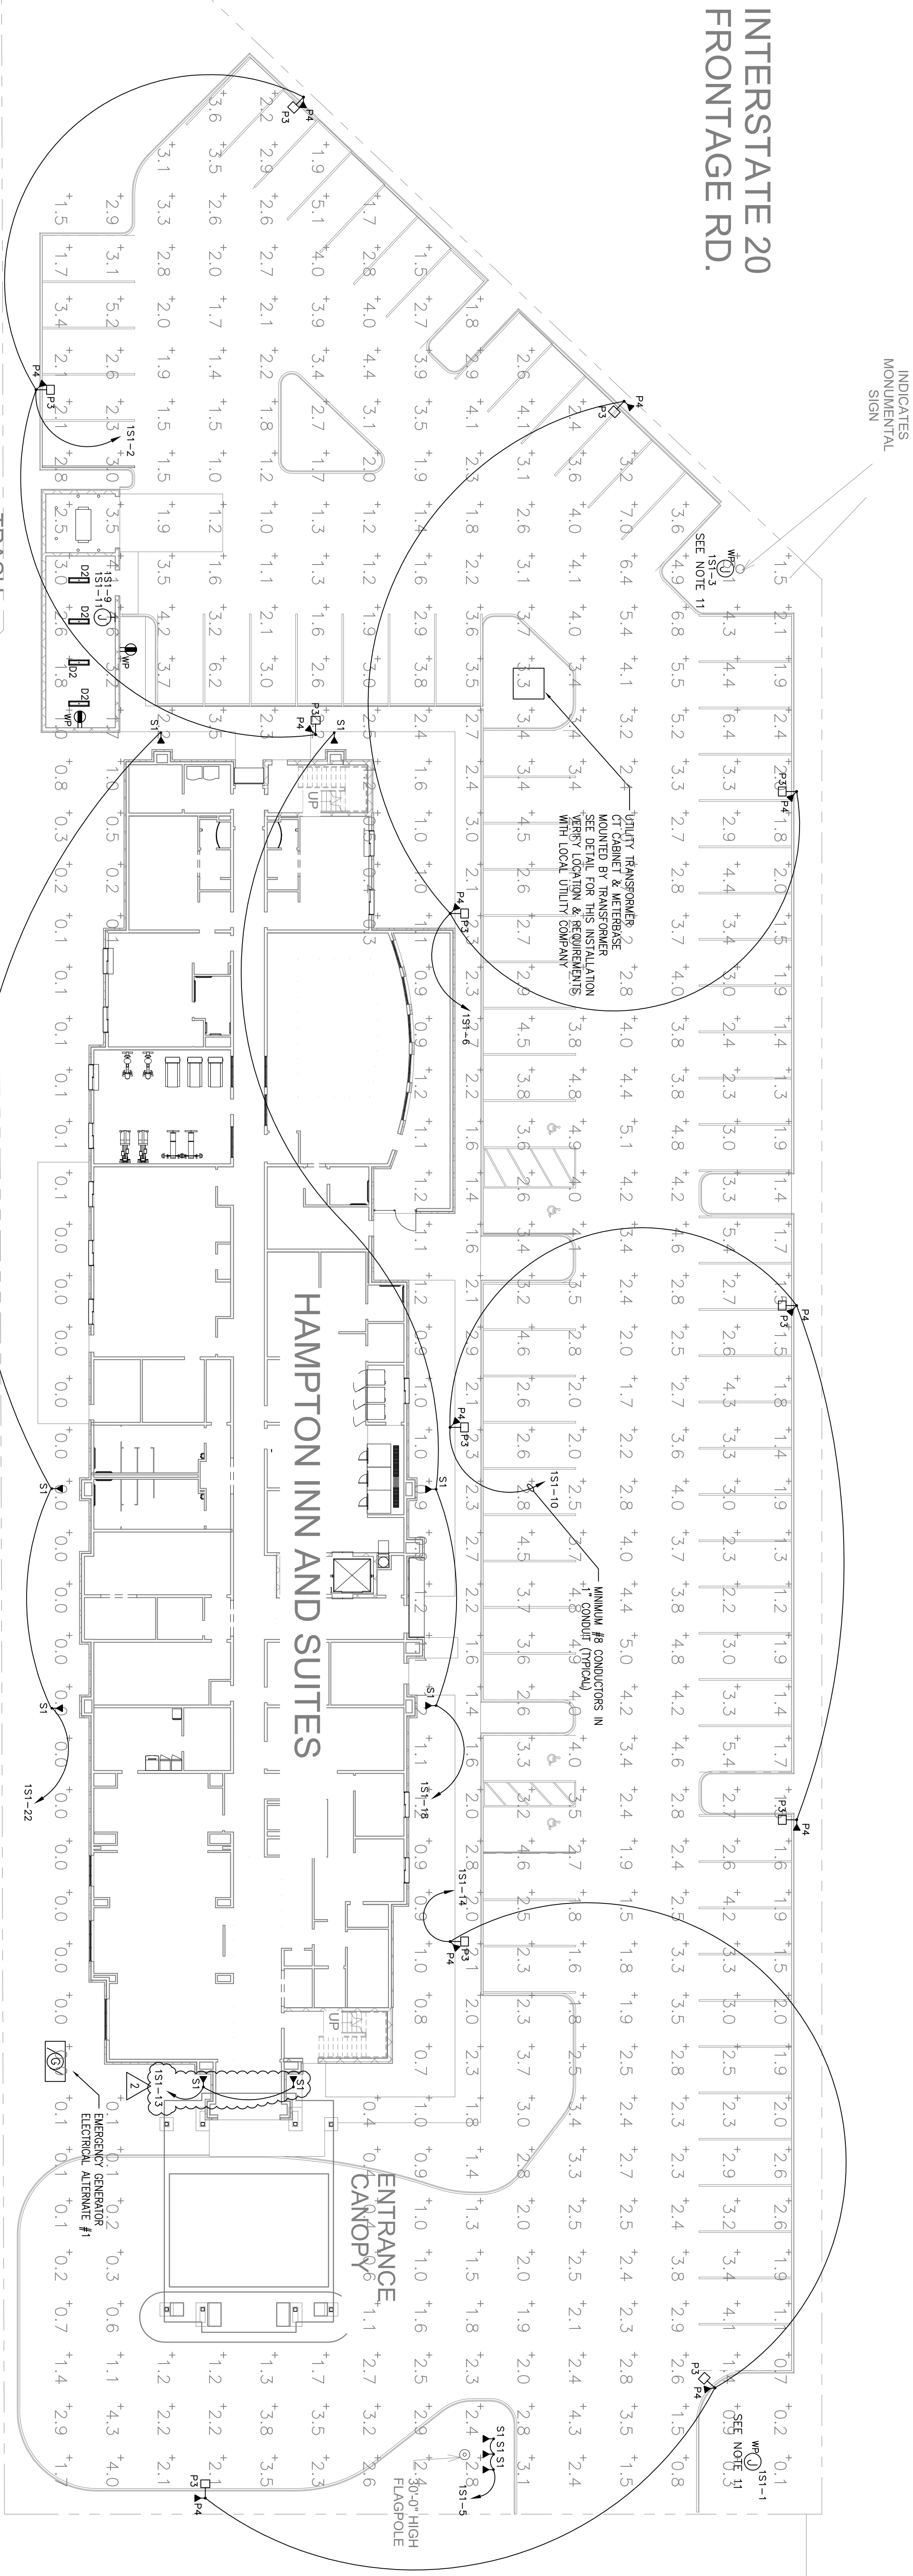

ELECTRICAL SITE PLAN

SCALE: 1/16" = 1'

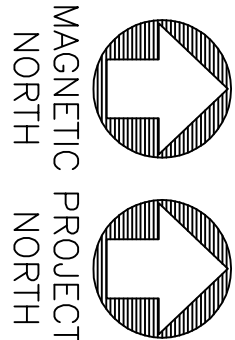

LIGHT POINT-TO-POINT CALCULATION NOW SHOWN  
CALCULATED VALUES ARE FROM TYPE "P3" FIXTURES ONLY  
TYPE "P4" FIXTURES TO BE ADJUSTED AT TIME OF INSTALLATION  
TO INSURE PROPER AND EVEN LIGHTING LEVELS ACROSS PARKING LOT

GENERAL NOTES:

1. ALL WORK SHALL CONFORM TO ALL STATE, LOCAL AND FEDERAL CODES, INCLUDING THE LATEST EDITION OF THE NATIONAL ELECTRICAL CODE.
2. RUN ALL LIGHTING AND OUTDOOR CIRCUITS FROM PANEL "1S1"
3. VERIFY LOCATION AND TYPES OF ALL FIXTURES WITH ARCHITECT
4. RUN ALL OUTDOOR LIGHTING THROUGH PHOTOCELL AND CONTROL RELAY "POR"
5. SEE 4/ES.3 FOR MORE DETAILS
6. THE CONTRACTOR IS TO, AT HIS OWN EXPENSE, OBTAIN ALL NECESSARY PERMITS, INSPECTIONS, AND LICENSES, ETC. NECESSARY TO COMPLETE THE PROJECT.
7. VERIFY ALL REQUIREMENTS OF TRANSFORMER, OF CABINET, METER BASE, AND WIRE SIZE SHALL BE #8 CU MINIMUM IN A 1" CONDUIT FOR ALL OUTDOOR LIGHTING CIRCUITS.
8. MOUNT PHOTO CONTROL RELAY IN ELECTRICAL ROOM ON THE FIRST FLOOR.
9. CONTRACTOR TO VERIFY LOCATION OF EXISTING PRIMARY POWER FOR CONNECTION FOR NEW RUN ONE EXTRA SPARE 1" CONDUIT FROM PANEL "1S1" TO OUTSIDE OF BUILDING FOR FUTURE USE.
10. SEE ALSO RISER DIAGRAM FOR OTHER REQUIREMENTS.
11. CONTRACTOR TO PROVIDE AND INSTALL SAFETY DISCONNECT SWITCH AT EACH SIGN LOCATION
12. REMOVE AND INSTALL MANUAL OFFENSE SWITCH FOR ALL OUTDOOR POLE LIGHTING CIRCUITS.
13. CONTRACTOR RESPONSIBLE FOR TRANSFORMER P.O.D. VERIFY REQUIREMENTS WITH LOCAL UTILITY CO.
14. VERIFY LOCATION OF FLAG POLE LIGHTS BEFORE ROUGH-IN.