
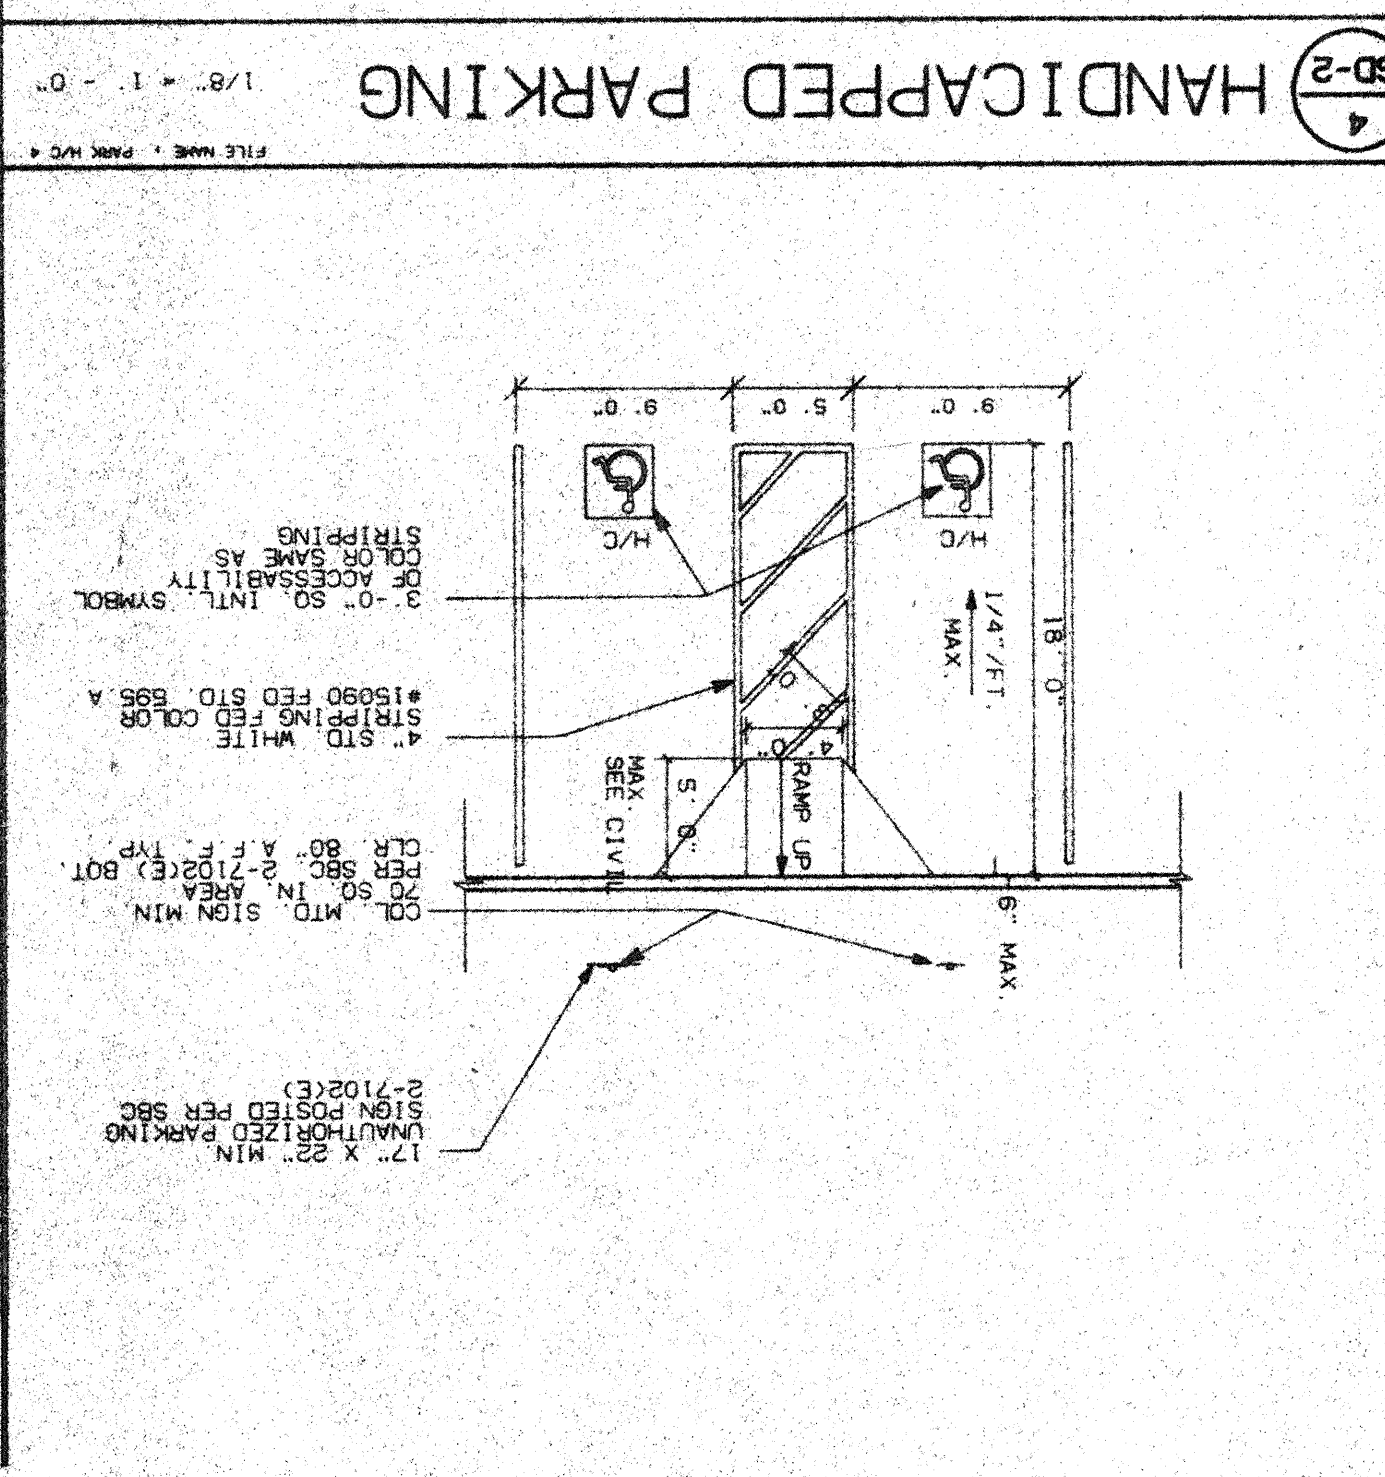
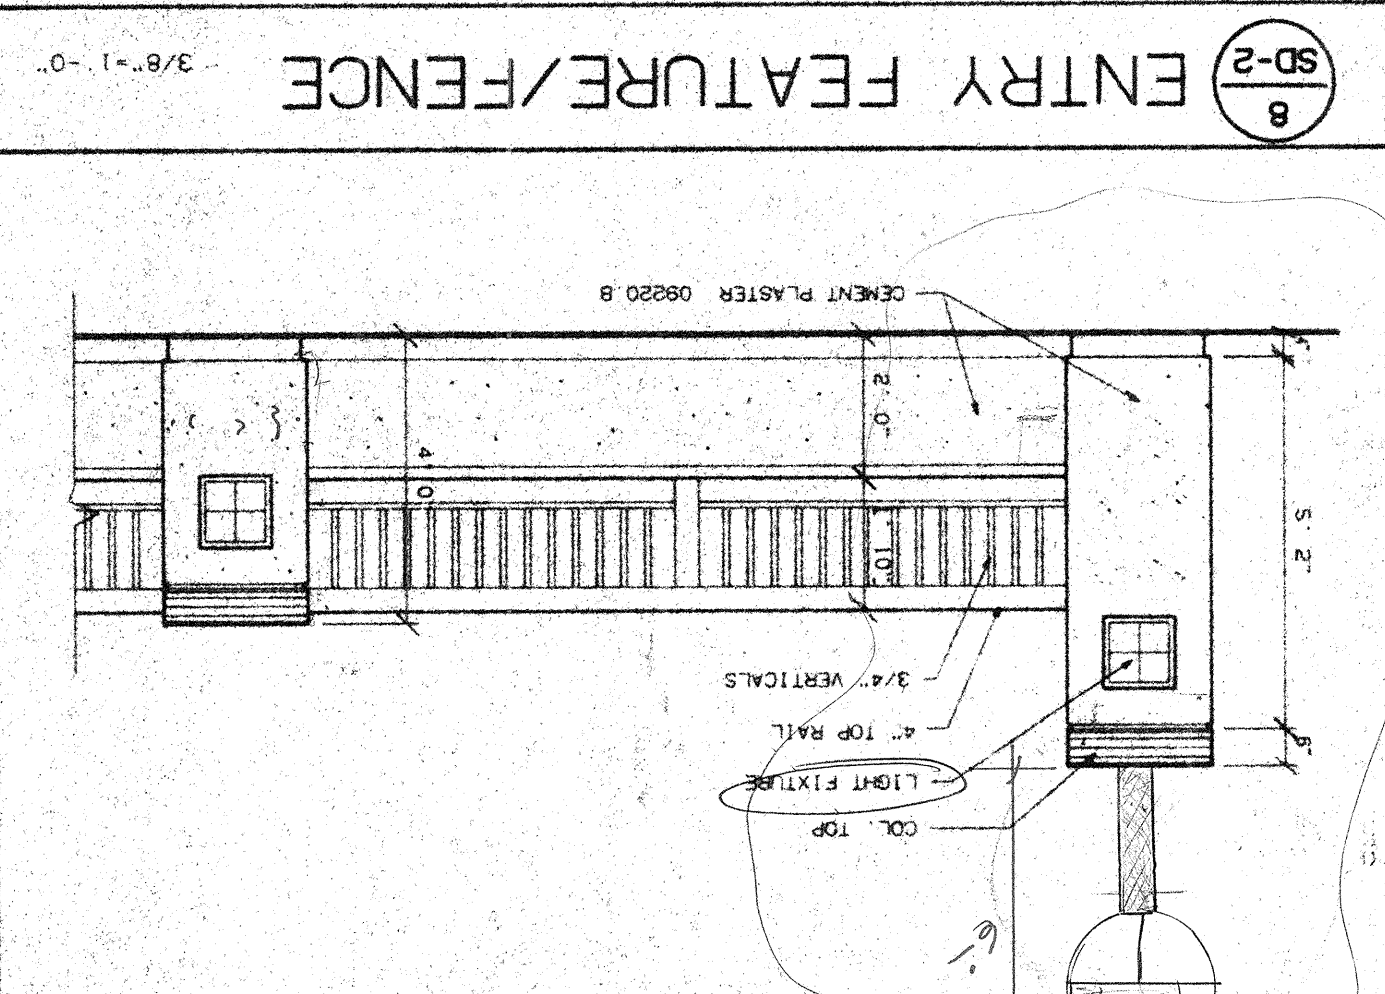
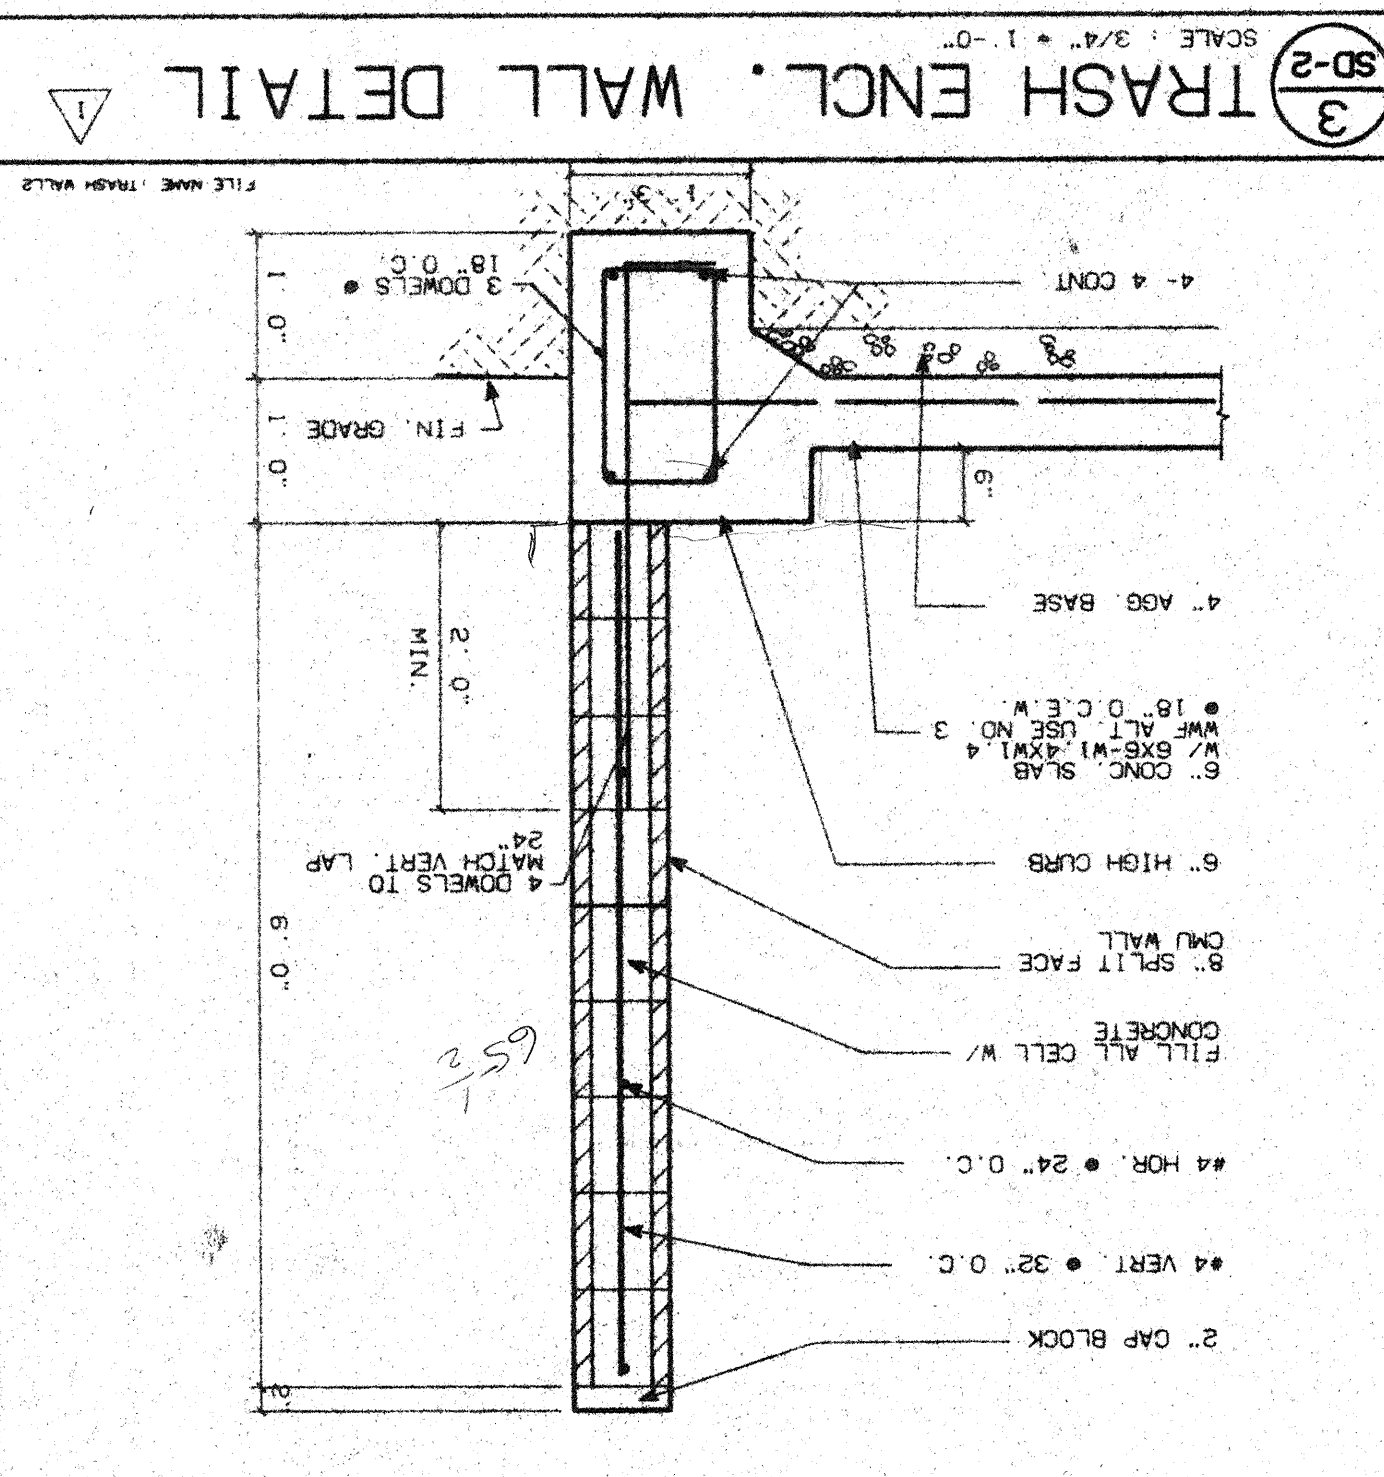
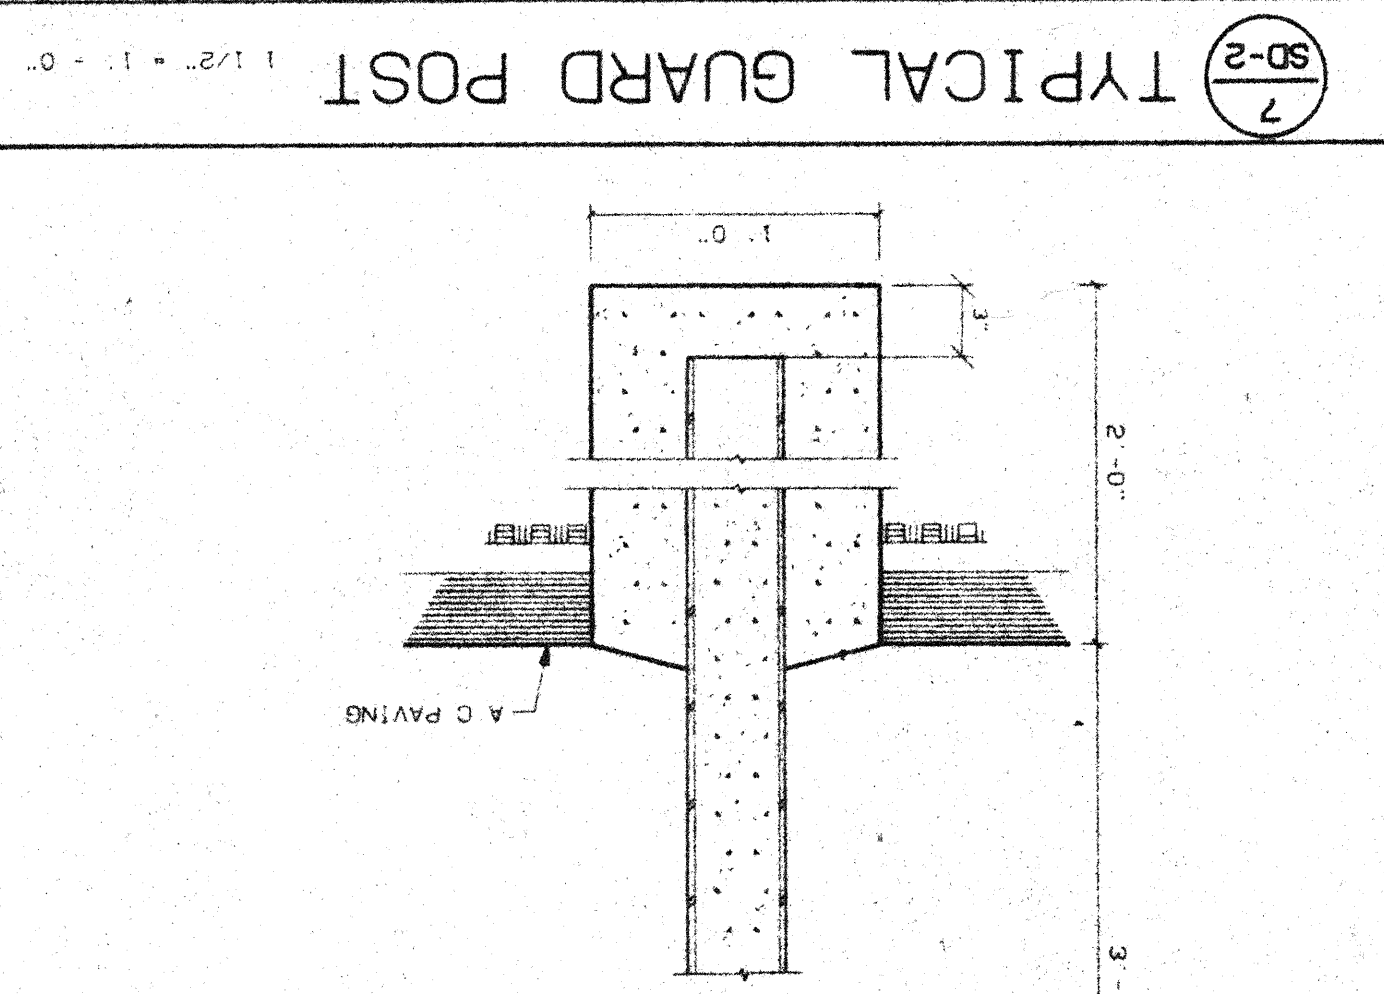
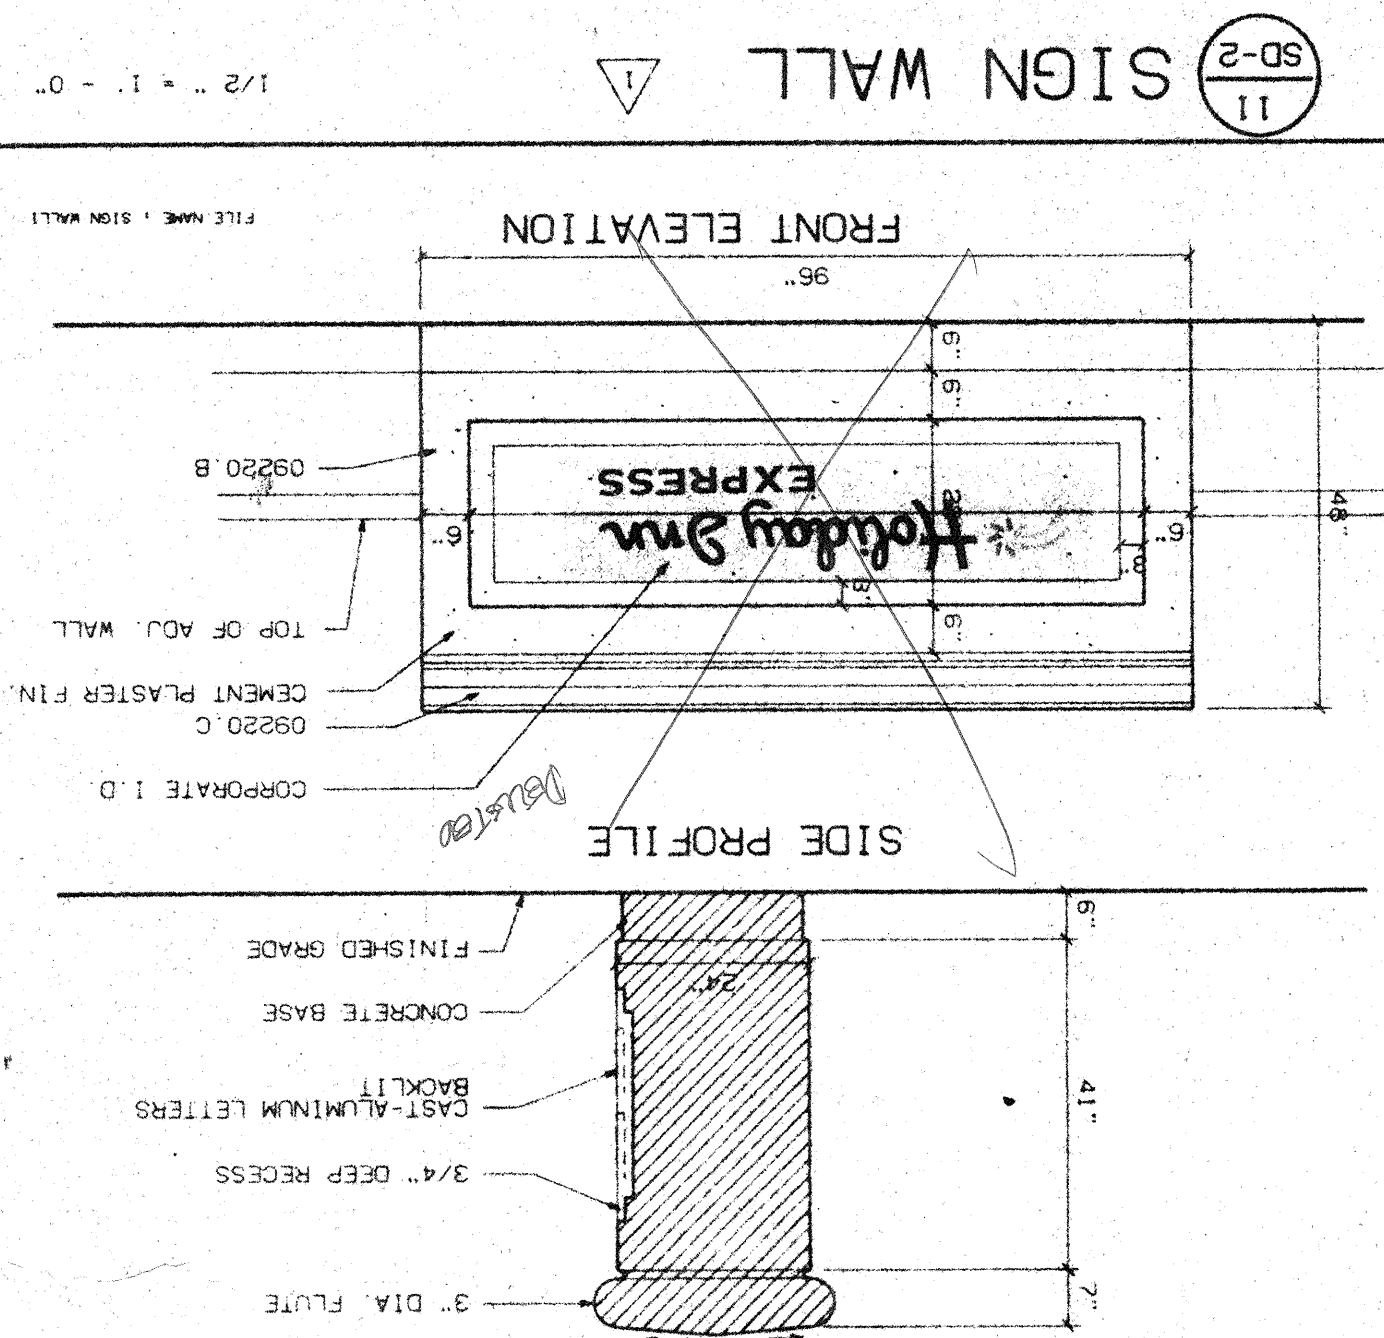
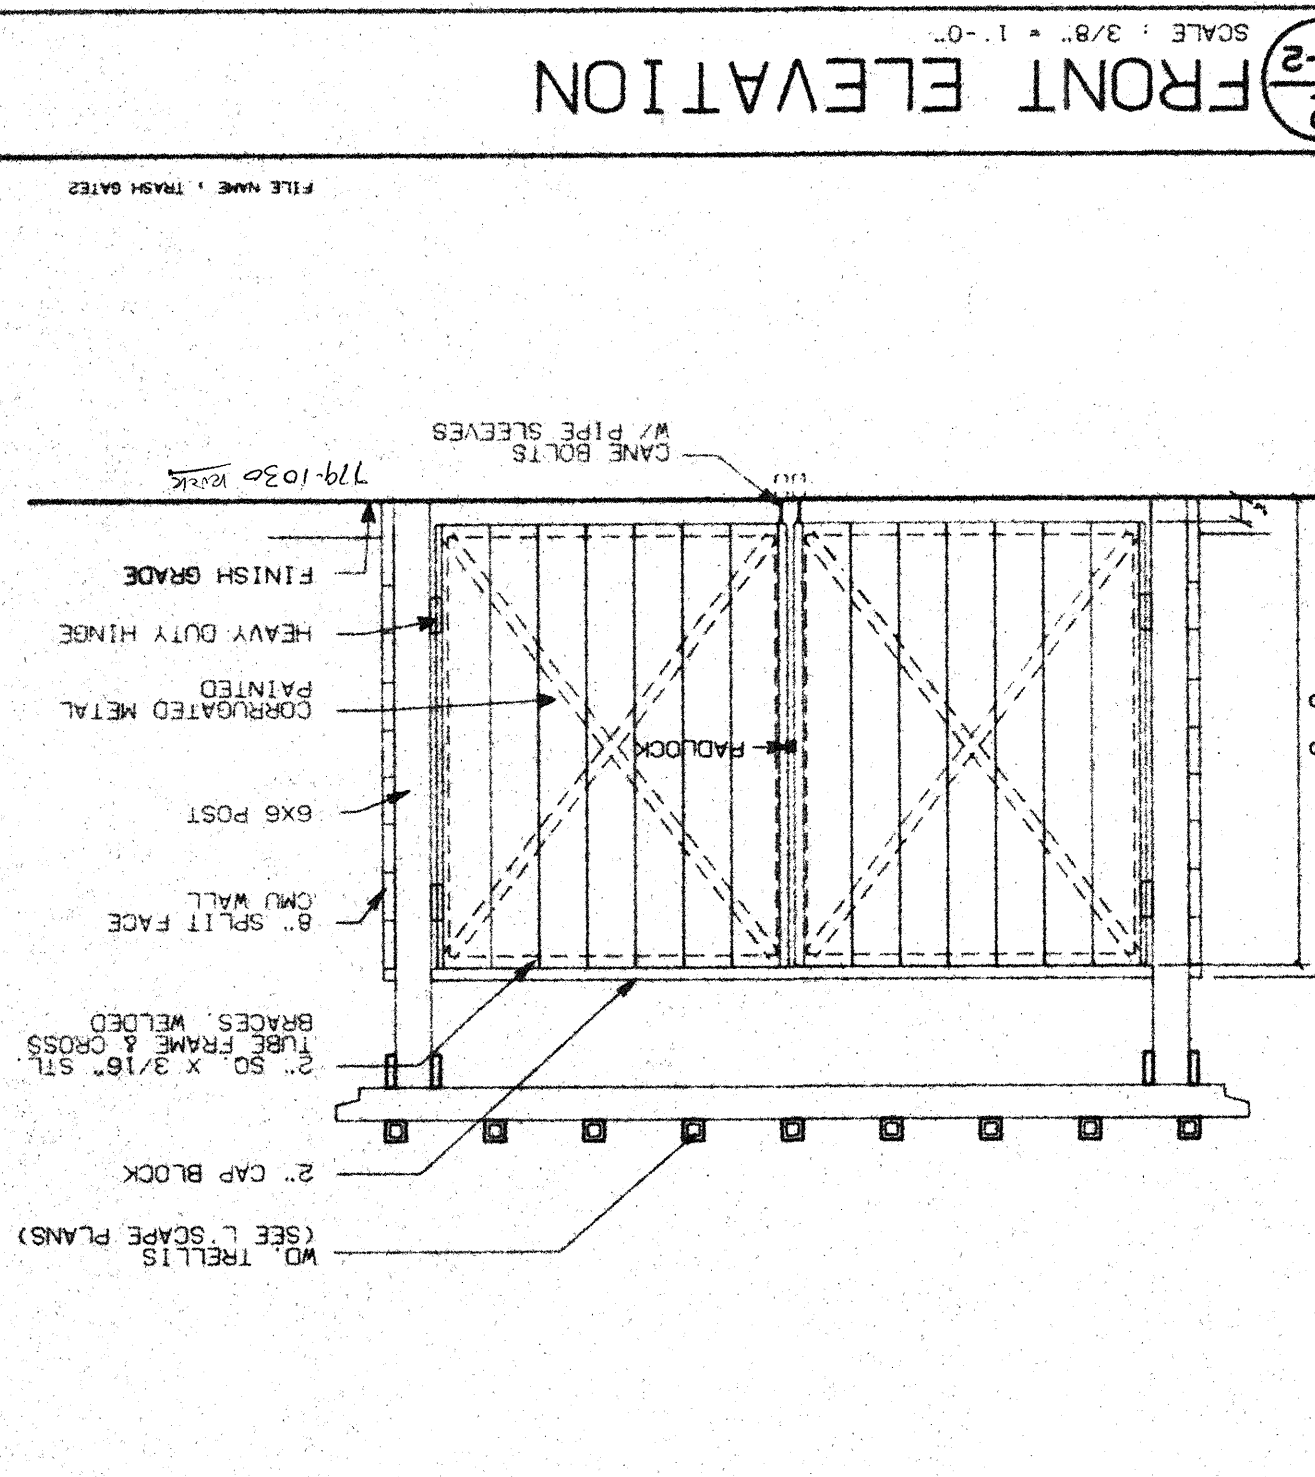
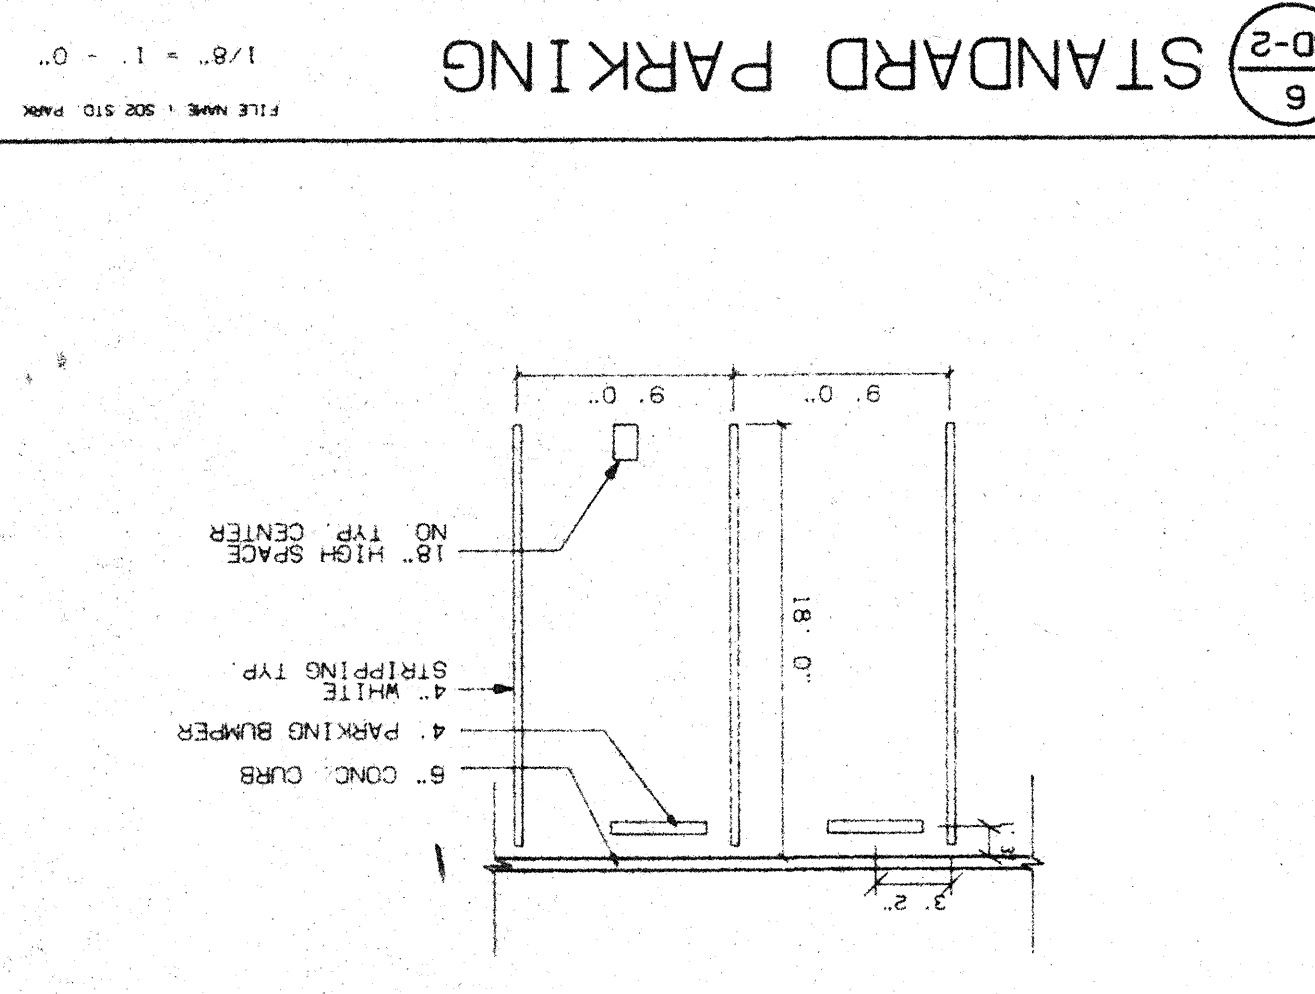
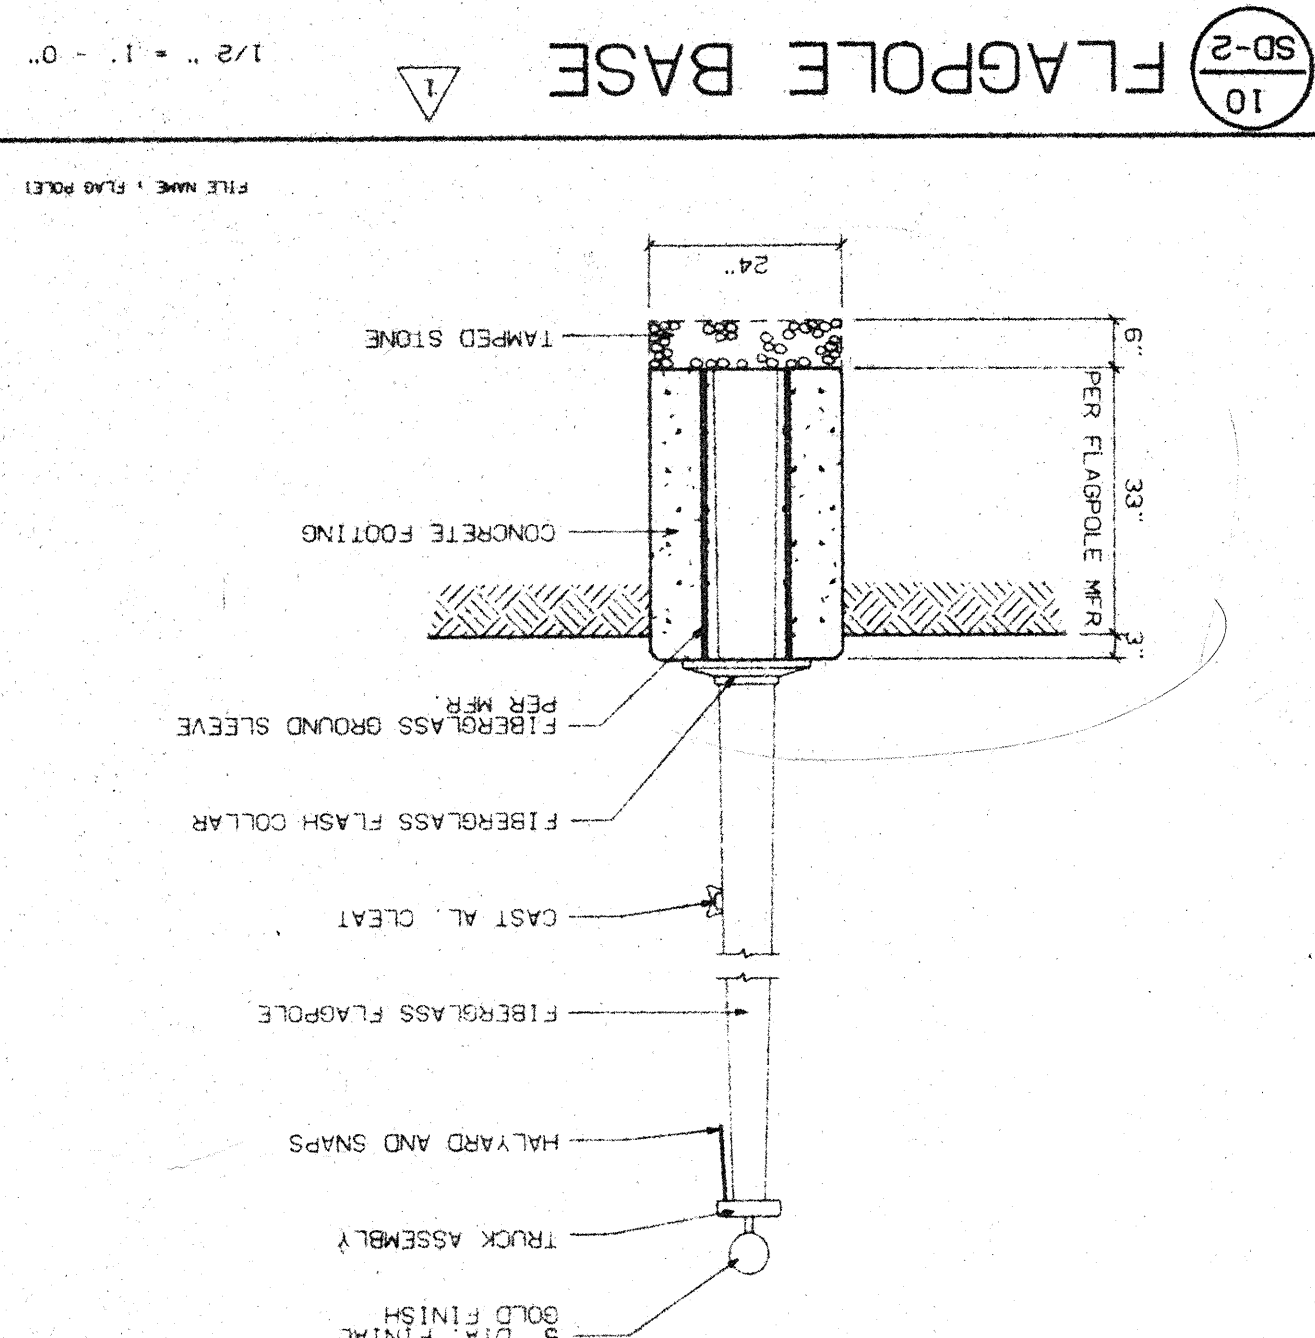
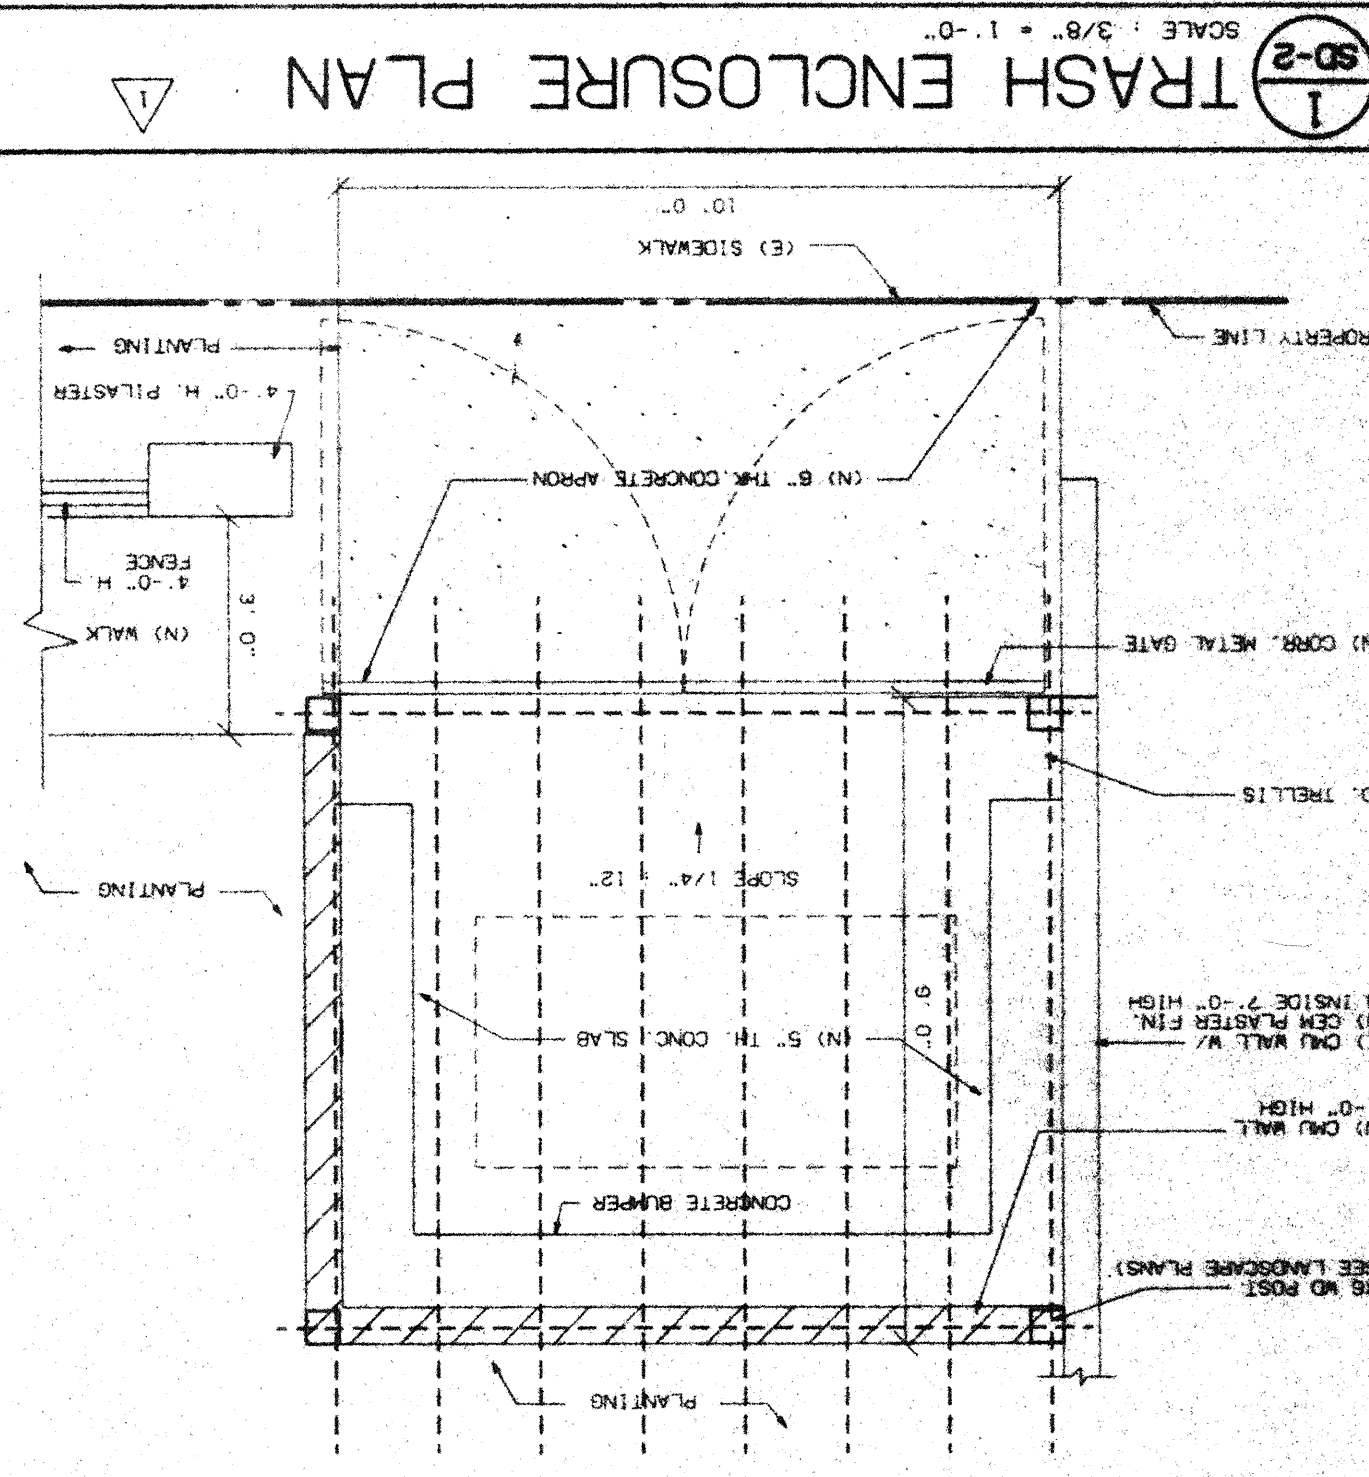
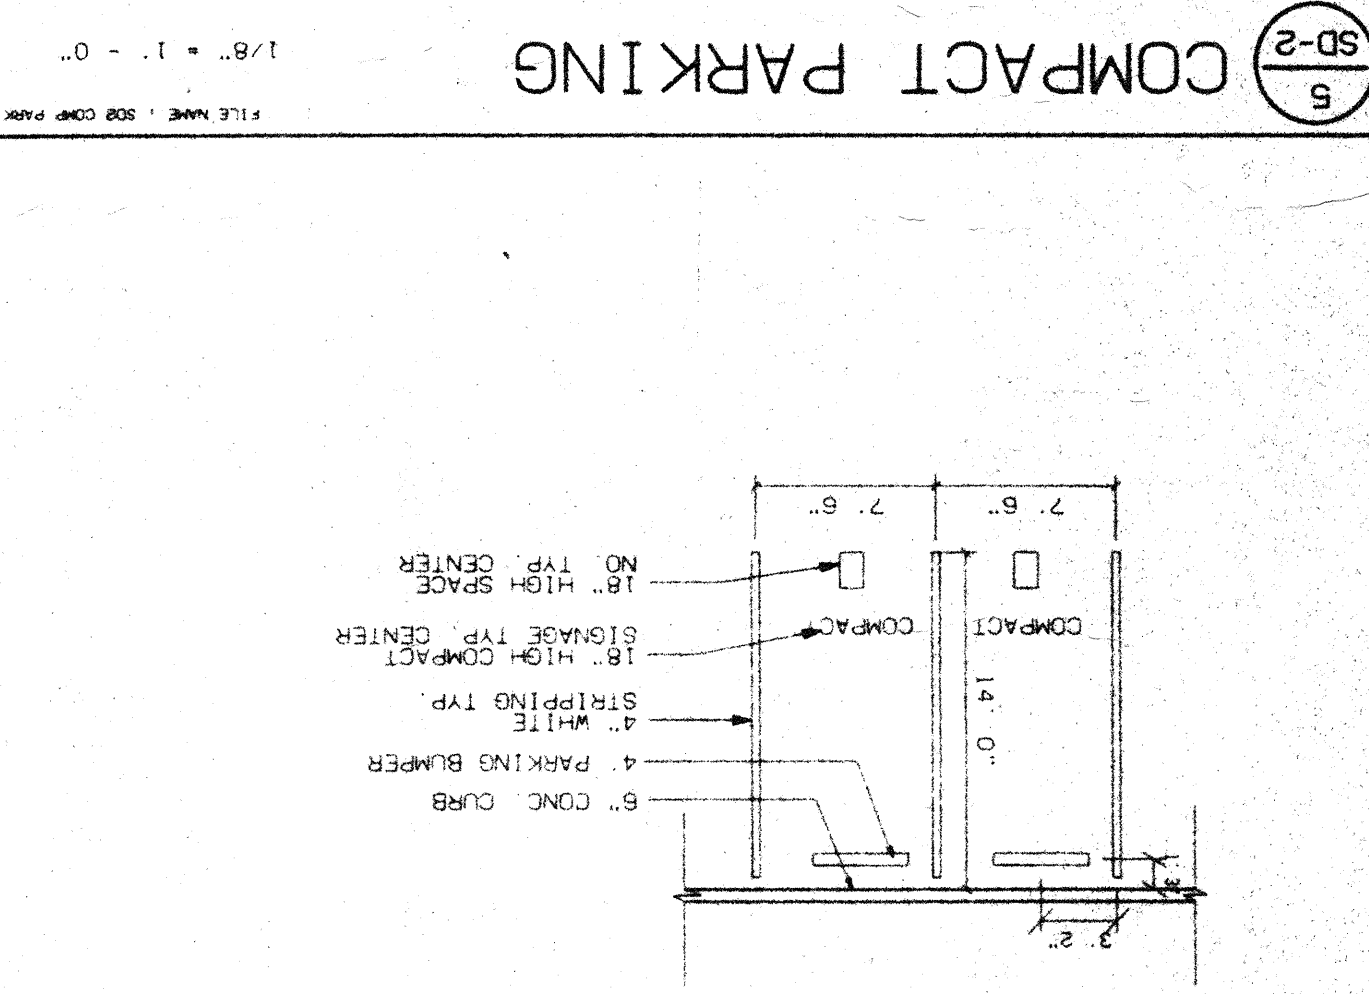


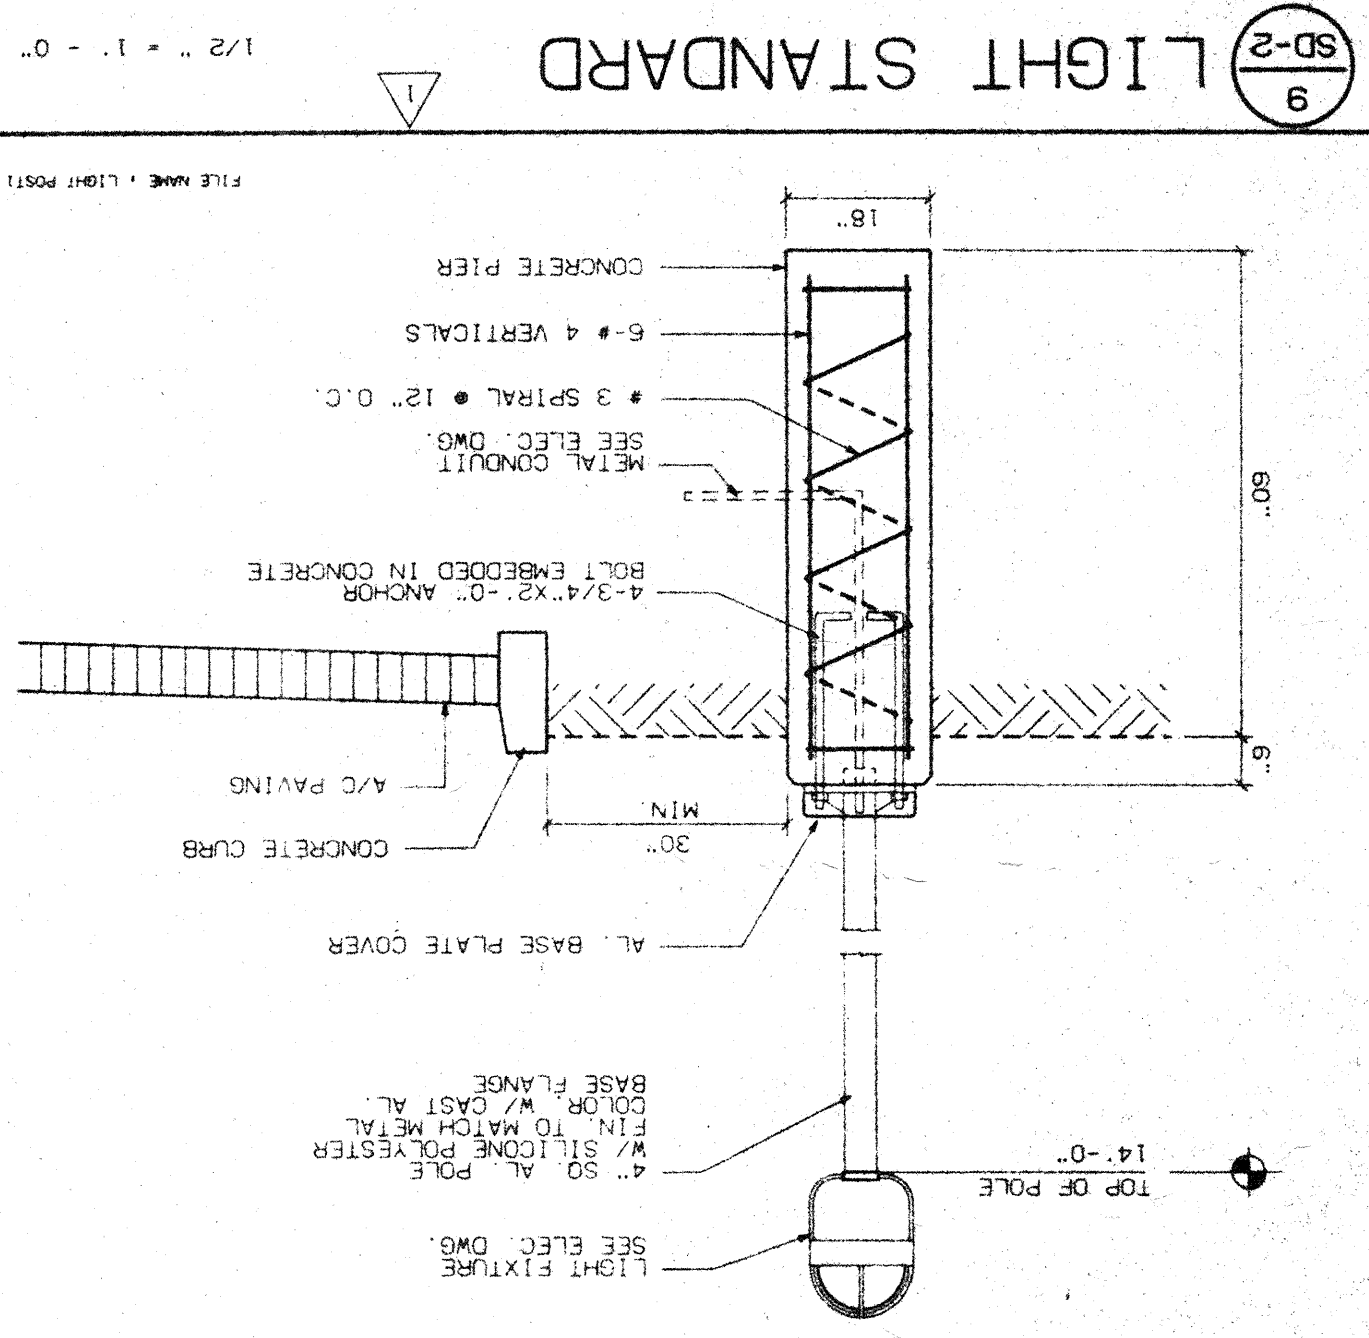

SKL ARCHITECTURE & PLANNING

3018 Wilshire Park Road, Suite 206
Compton, California 90215
Phone: 510 680 2711
Fax: 510 680 2717

OWNER
H.L. PATEL
CONTACT: VIJAY PATEL
1133 PEBBLEWOOD WAY
SAN MATEO, CA 94403
TEL: (415) 570 6970

PROJECT
PROPOSED 37-UNIT HOTEL
2834 EL CAMINO REAL
REDWOOD CITY, CA 94063

NORTH
SHEET TITLE

SITE DETAILS

SD-2

FILE NAME: PCSD-2

DATE	DESCRIPTION	REV.	BY
12-21-92	PLAN CHECK	1	SKL

SHEET NOTES

LEGEND