
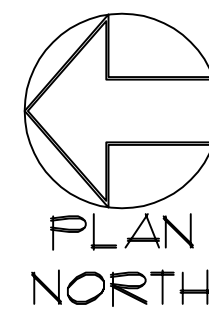


OLD FANNIN ROAD ~ FLOWOOD, MS


[illegible]

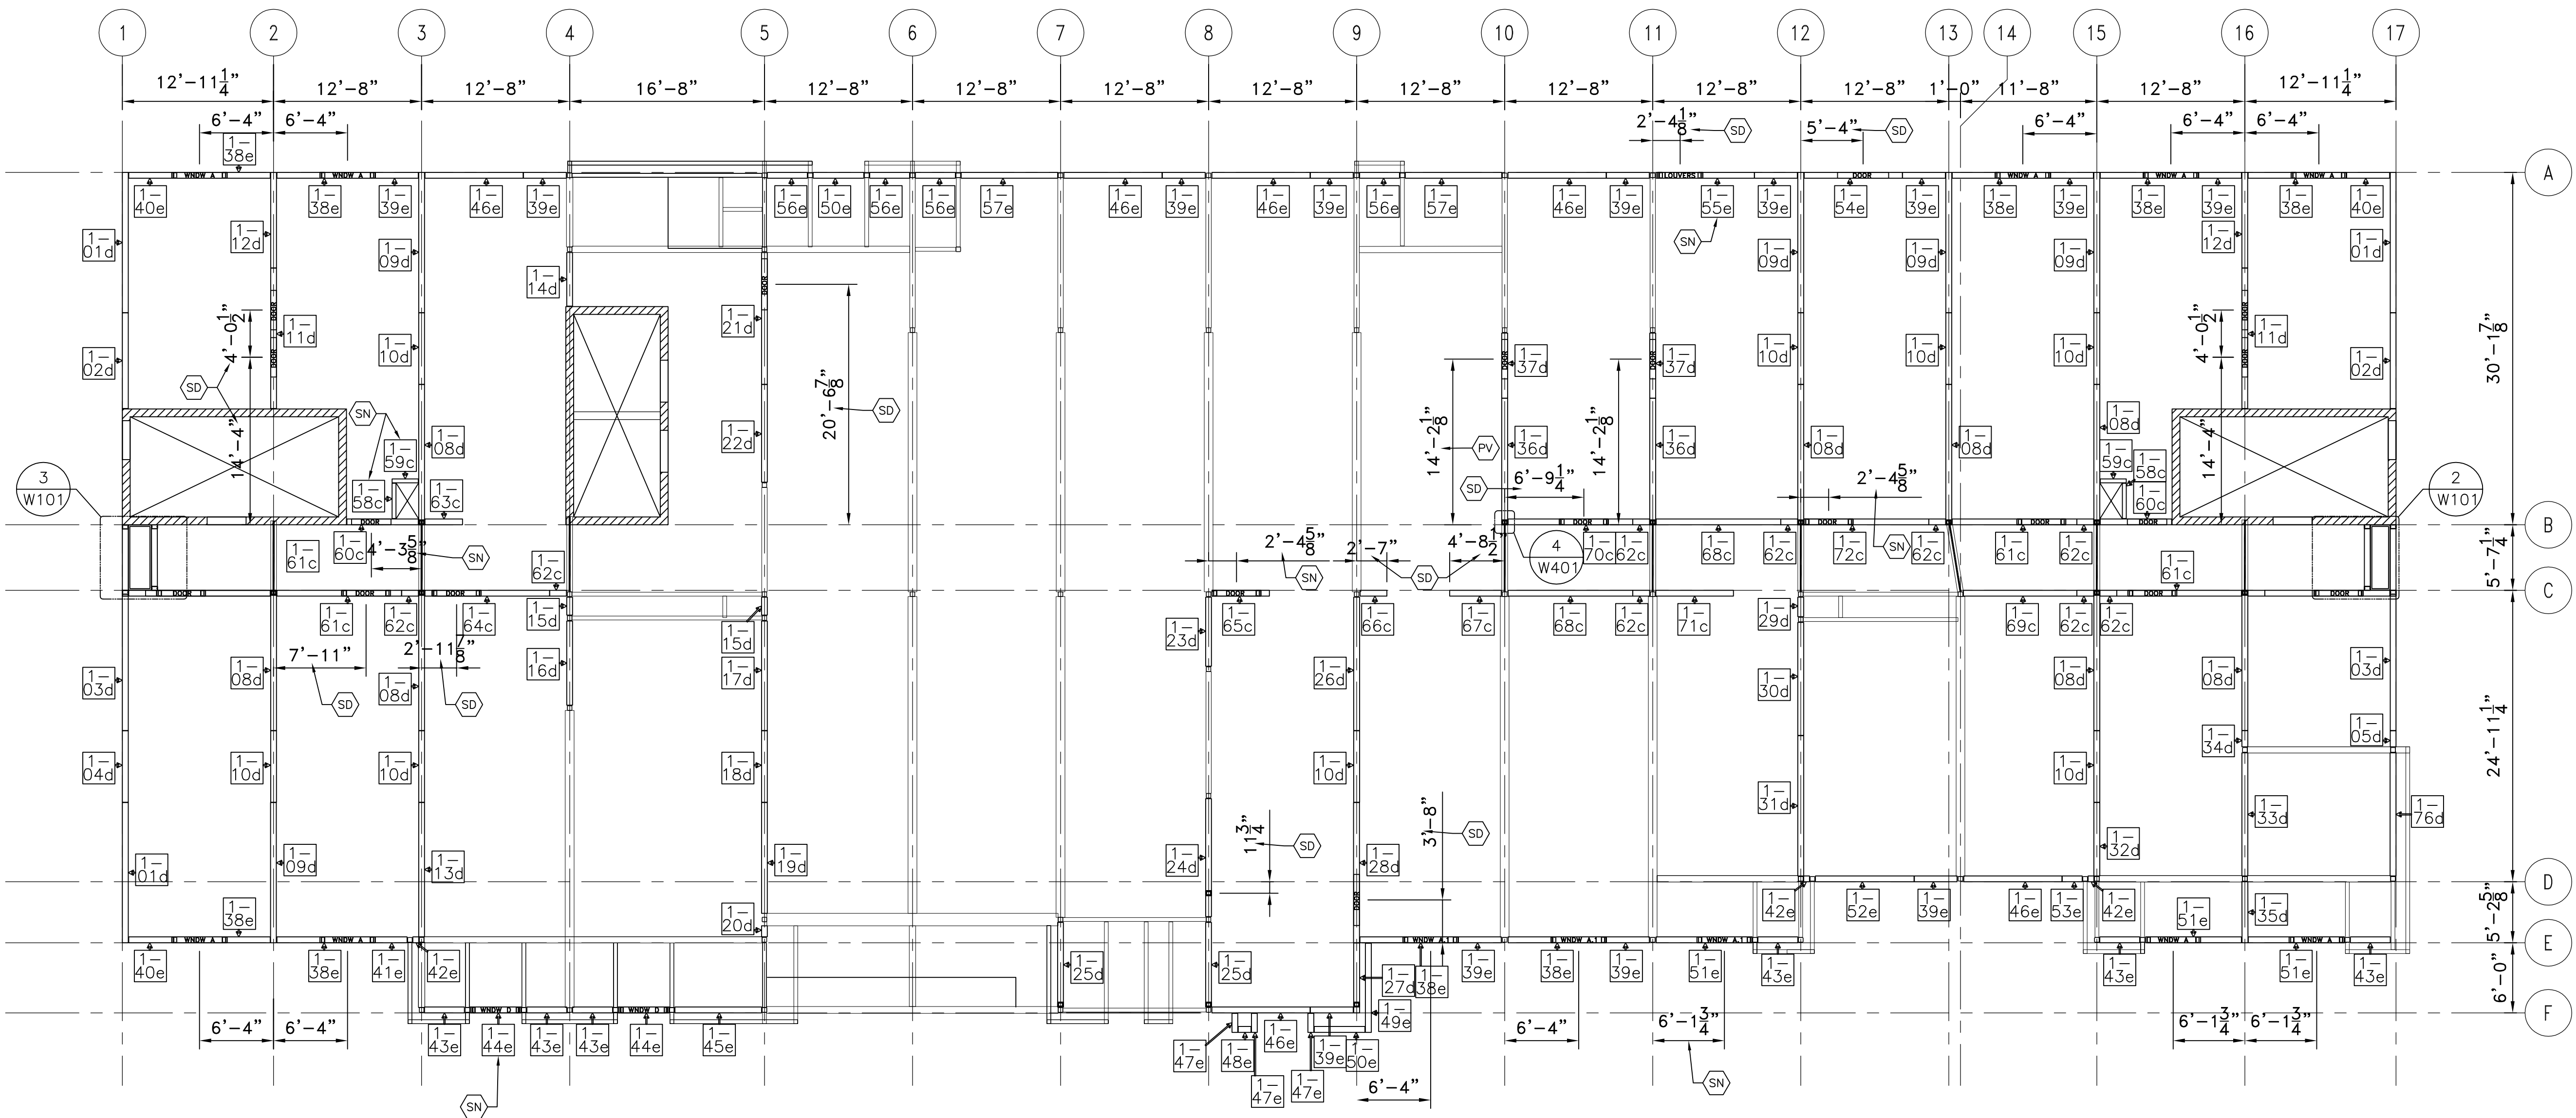


1st FLOOR STRUCTURAL PANEL PLAN/TAG
SCALE: 1/8" = 1'-0"

GENERAL NOTES:
1) SEE W301 THROUGH W401 FOR SECTIONS AND DETAILS.
2) WALLS UNDERNEATH RED IRON BEAMS ARE NOT INCLUDED.
3) SEE QUESTIONS ON THIS SHEET AND AT PANEL DRAWINGS.

- AFFIX PANEL TO STUD PACK WITH (3) EVENLY SPACED #12 SCREWS
- AFFIX STUD PACK TO STUDS WITH (6) EVENLY SPACED #12 SCREWS
- AFFIX STUD PACK TO CMU WITH (4) EVENLY SPACED 1/2" EXPANSION BOLTS
- MC1 STUD PACK BY PANELIZERS, LLC
- 1-01d DEMISING WALL BY PANELIZERS, LLC
- 1-02c CORRIDOR WALL BY PANELIZERS, LLC
- 1-03e EXTERIOR WALL BY PANELIZERS, LLC
- 1-04h HORIZONTAL BY PANELIZERS, LLC
- PV → PLEASE VERIFY.
- EN → ENGINEER'S NOTE. PLEASE VERIFY CONNECTION.
- SD → SCALED DIMENSION. PLEASE VERIFY.
- SN → SEE NOTE ON PANEL DRAWING
- (2) L5x3x3/8, NOT BY PANELIZERS, LLC
- CMU WALL, NOT BY PANELIZERS, LLC
- WALL WITH DOOR OPENING BY PANELIZERS, LLC
- WALL WITH WINDOW OPENING BY PANELIZERS, LLC

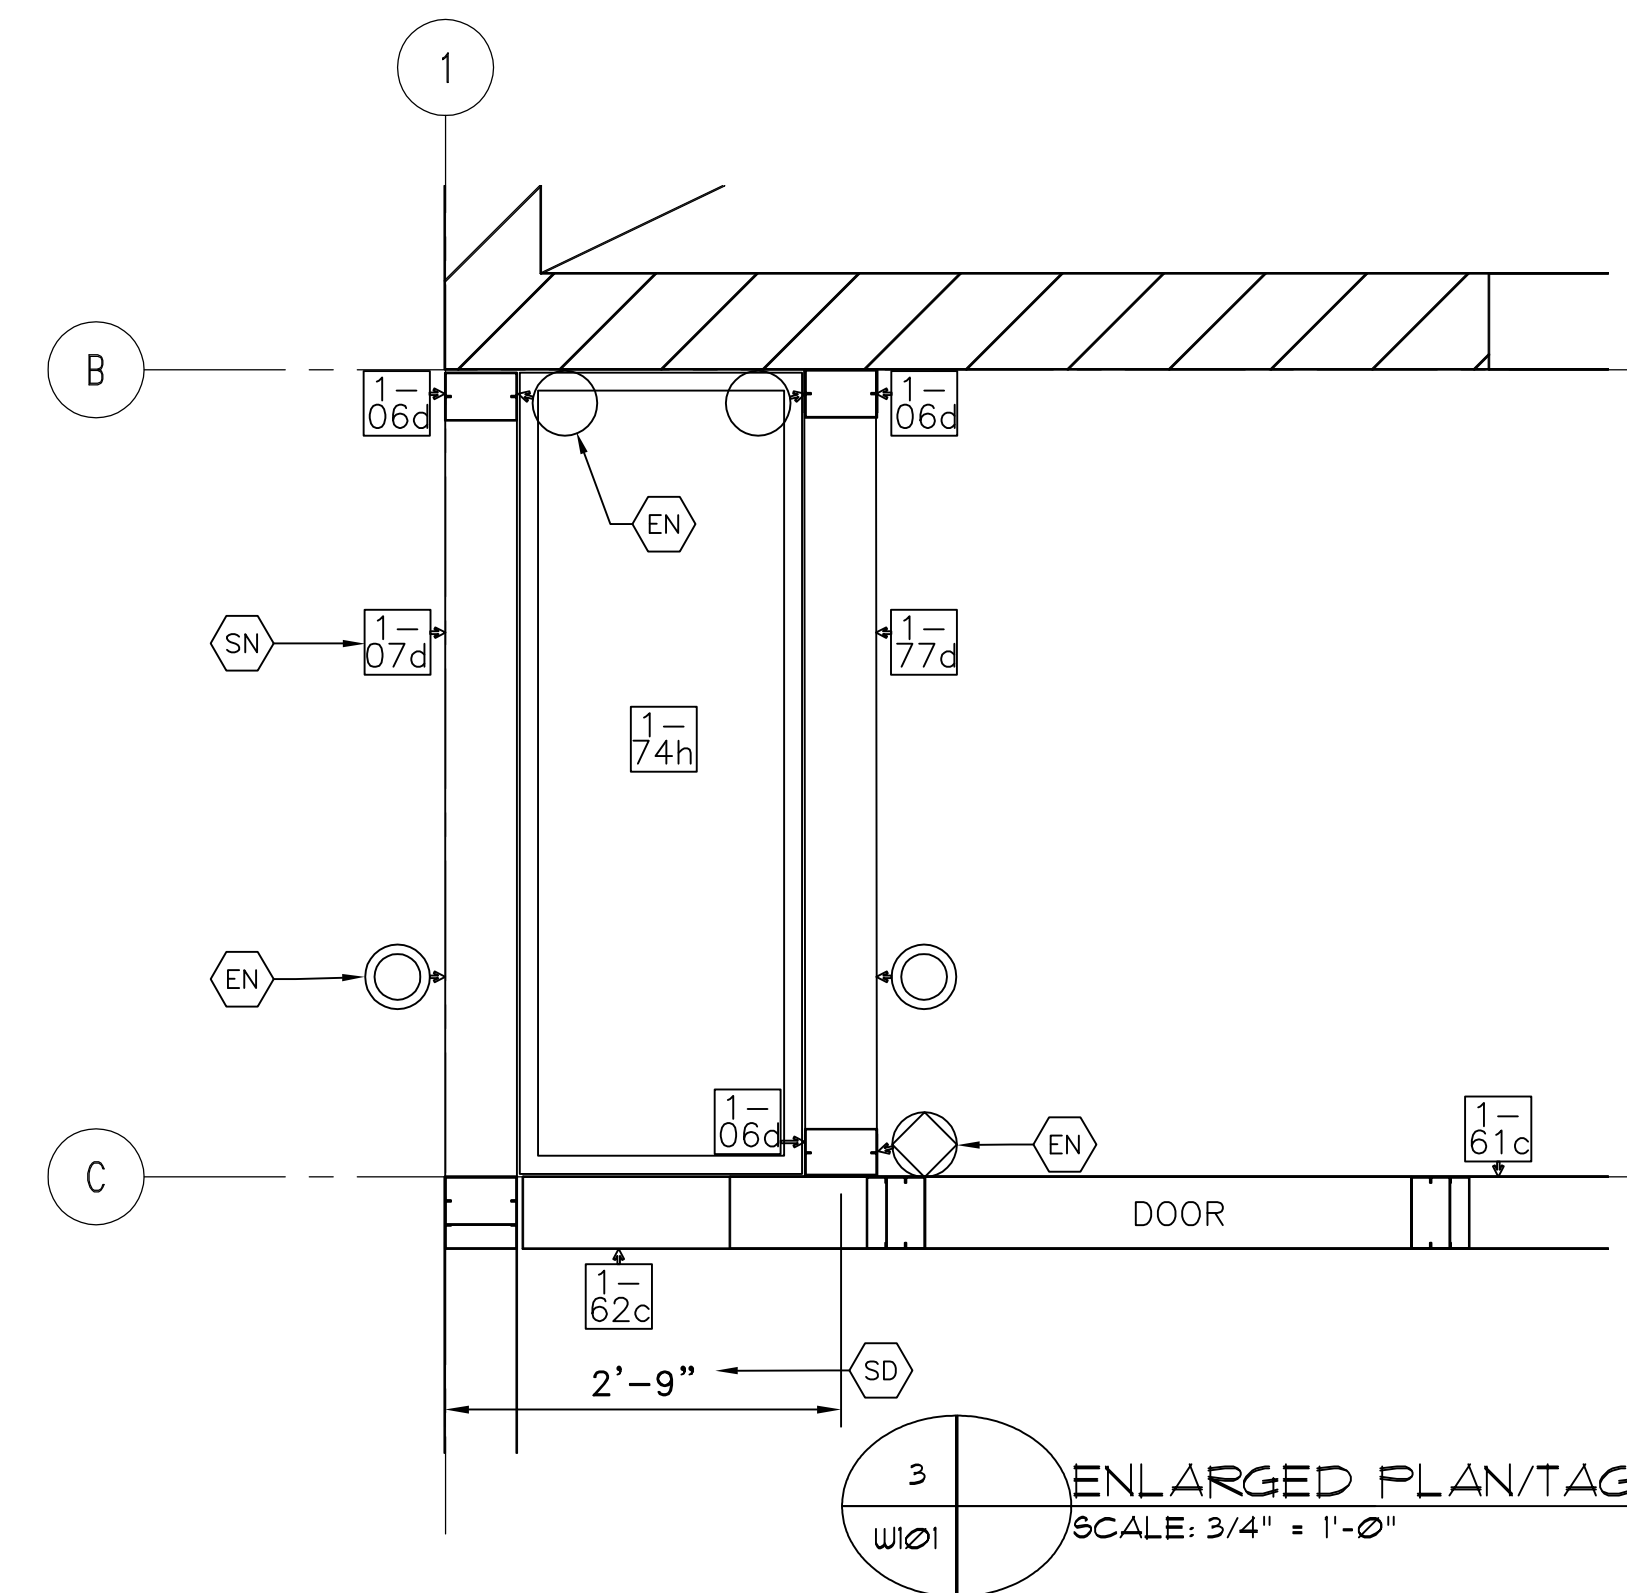


ENLARGED PLAN/TAG
SCALE: 3/4" = 1'-0"

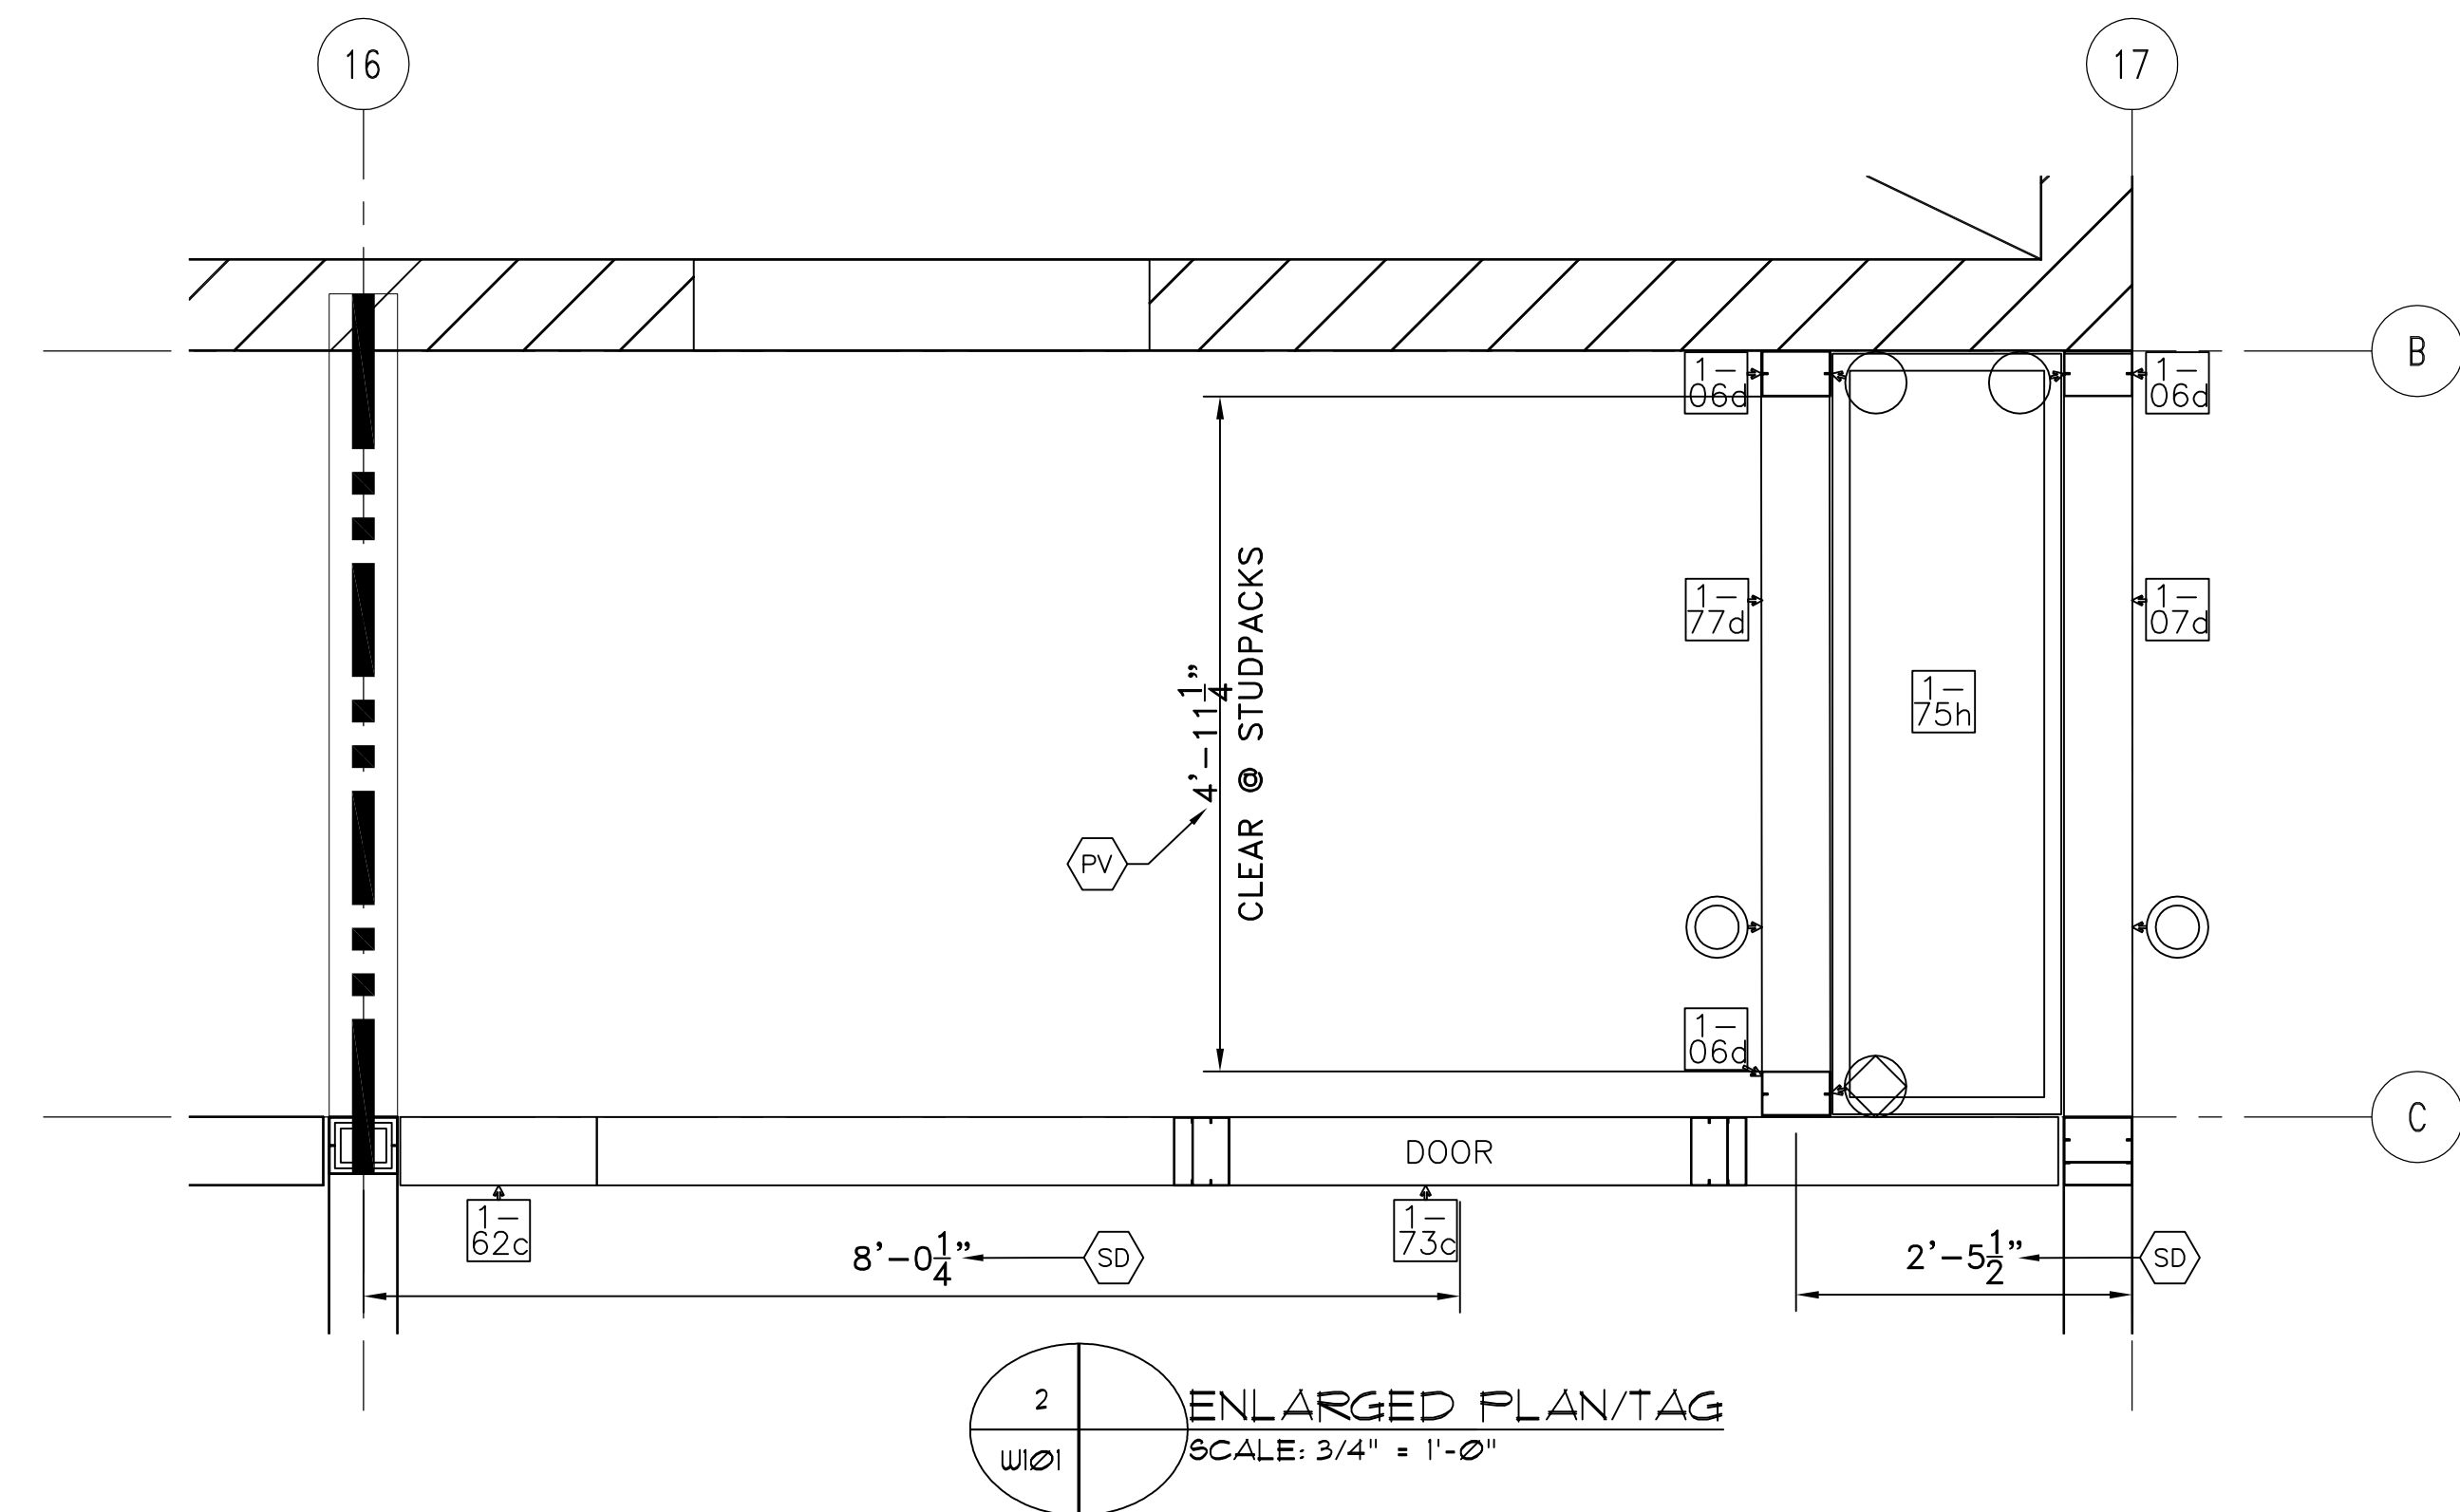

ENLARGED PLAN/TAG
SCALE: 3/4" = 1'-0"

Home2 Suites
Flowood, MS

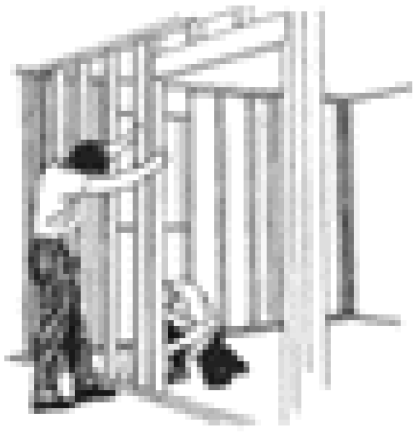




PANELIZERS, LLC
7635 HWY 161
WALLS, MS 38680
PHONE: (662) 936-5260
FAX: (662) 936-5262

Shop Drawings by:
HILLMAN ENTERPRISES, INC.
P.O. Box 106
Graham, AL 36263
PHONE: (256) 443-3261

Sheet Number:
W101

Job Number:
1605/1655

Date:
01/26/17

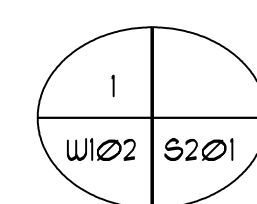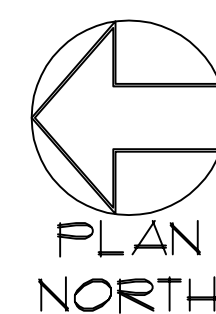
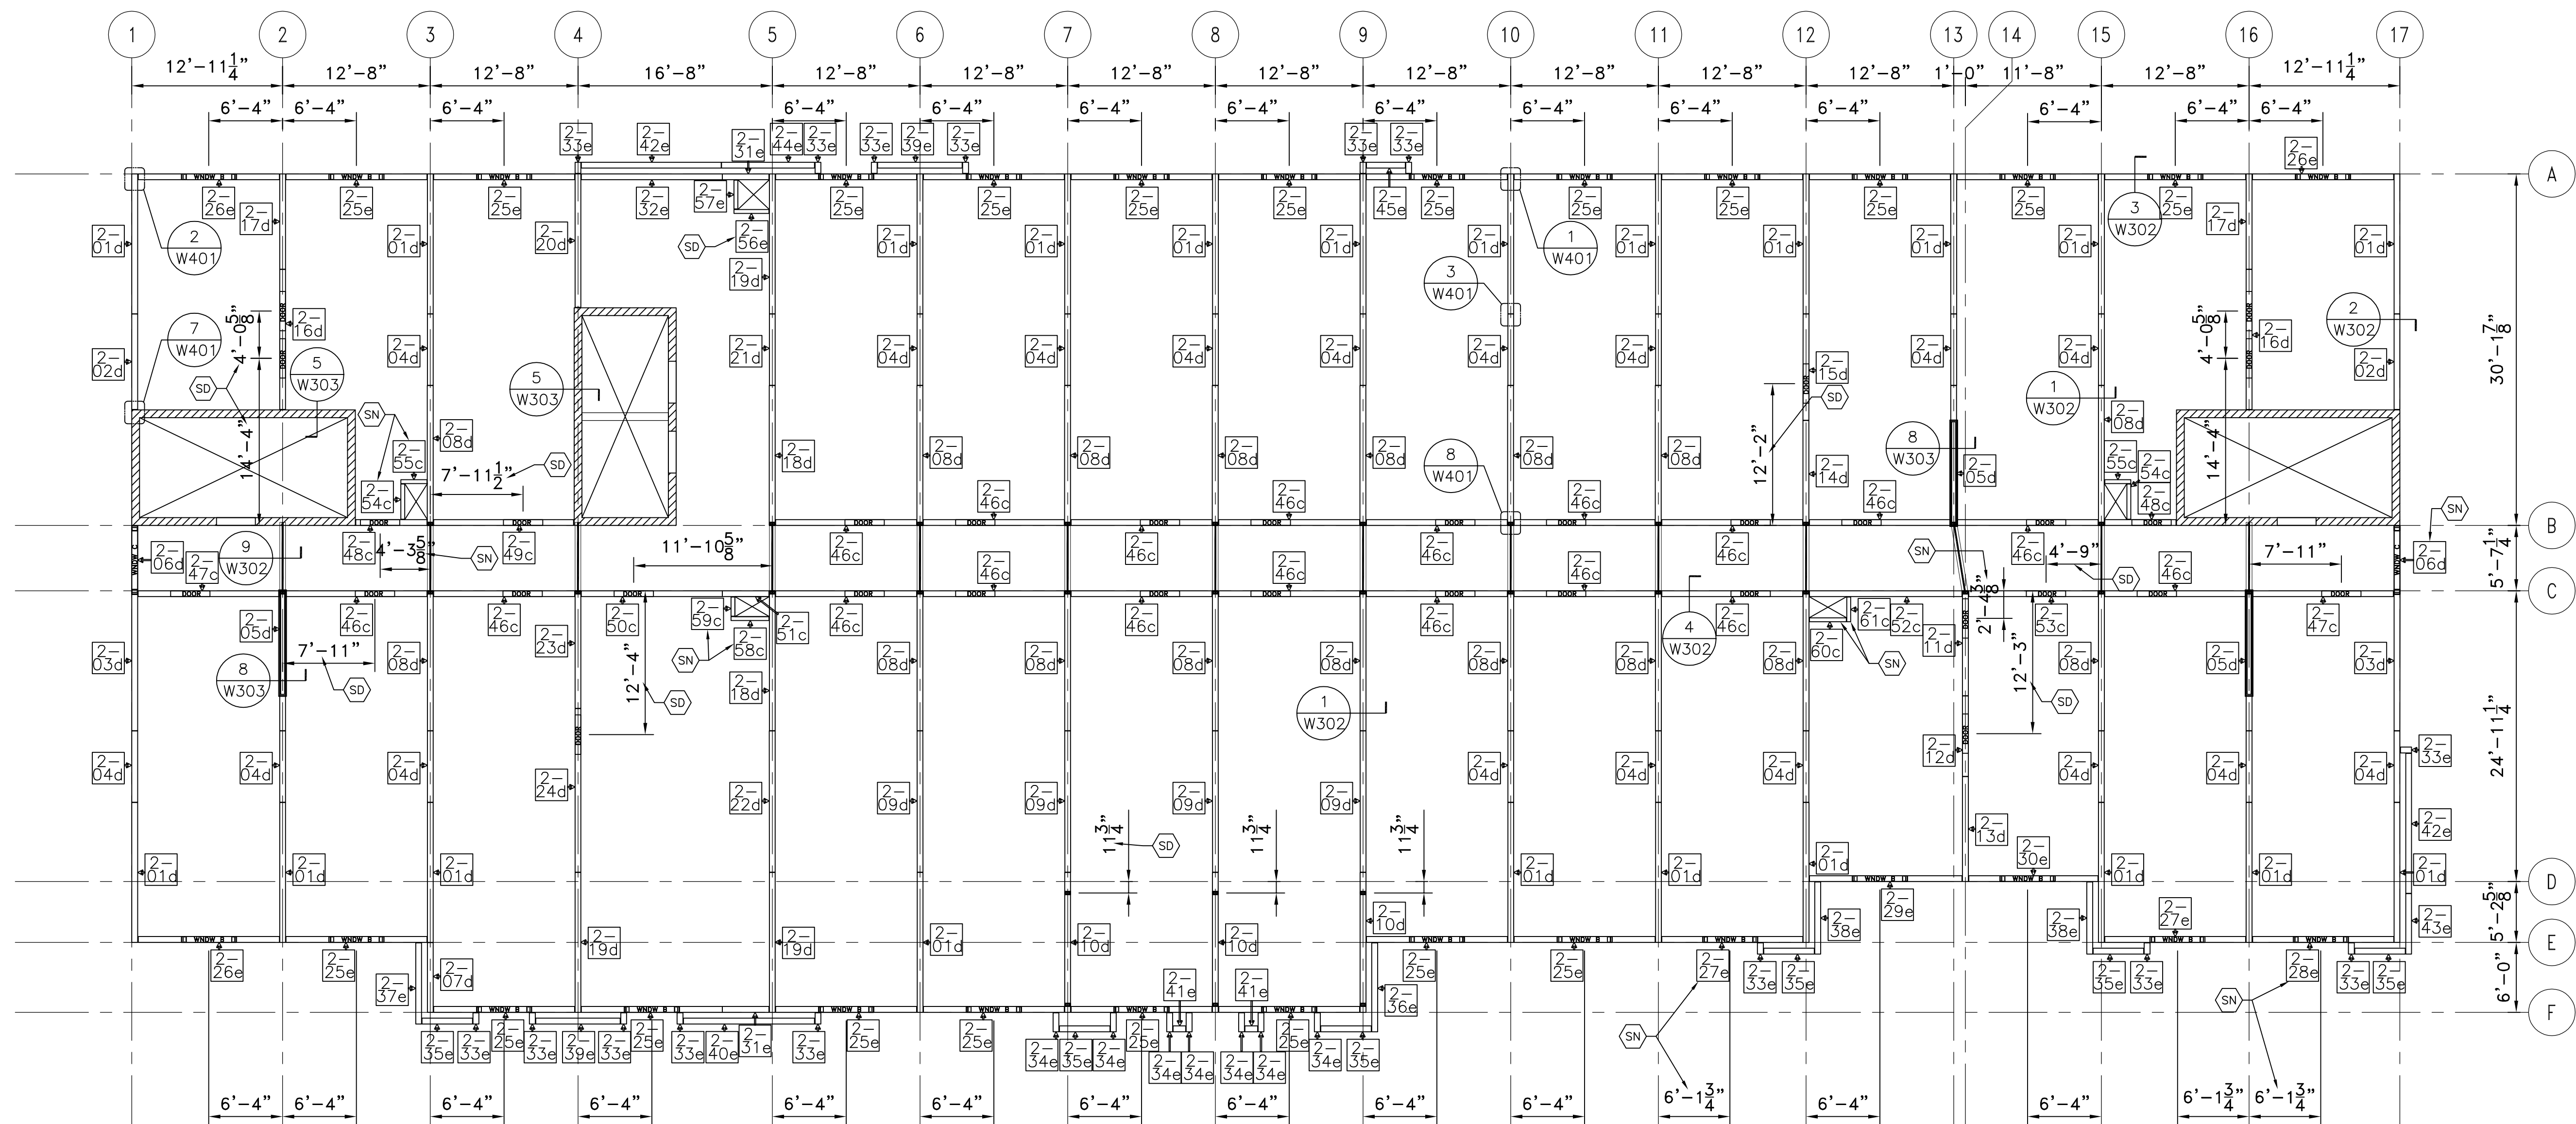


2nd FLOOR STRUCTURAL PANEL PLAN/TAG
SCALE: 1/8" = 1'-0"

GENERAL NOTES:


- SEE W301 THROUGH W401 FOR SECTIONS AND DETAILS.
- WALLS UNDERNEATH RED IRON BEAMS ARE NOT INCLUDED.
- SEE QUESTIONS ON THIS SHEET AND AT PANEL DRAWINGS.

- MC1 STUD PACK BY PANELIZERS, LLC
- DEMISING WALL BY PANELIZERS, LLC
- CORRIDOR WALL BY PANELIZERS, LLC
- EXTERIOR WALL BY PANELIZERS, LLC
- PLEASE VERIFY.
- ENGINEER'S NOTE. PLEASE VERIFY CONNECTION.
- SCALED DIMENSION. PLEASE VERIFY.
- SEE NOTE ON PANEL DRAWING
- MECHANICAL CHASE WALL BY PANELIZERS, LLC
- (2) L5x3x3/8, NOT BY PANELIZERS, LLC
- CMU WALL, NOT BY PANELIZERS, LLC
- WALL WITH OPENING/HEADER BY PANELIZERS, LLC
- WALL WITH DOOR OPENING BY PANELIZERS, LLC
- WALL WITH WINDOW OPENING BY PANELIZERS, LLC

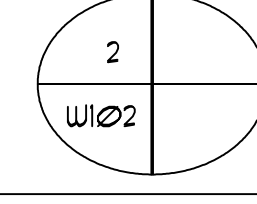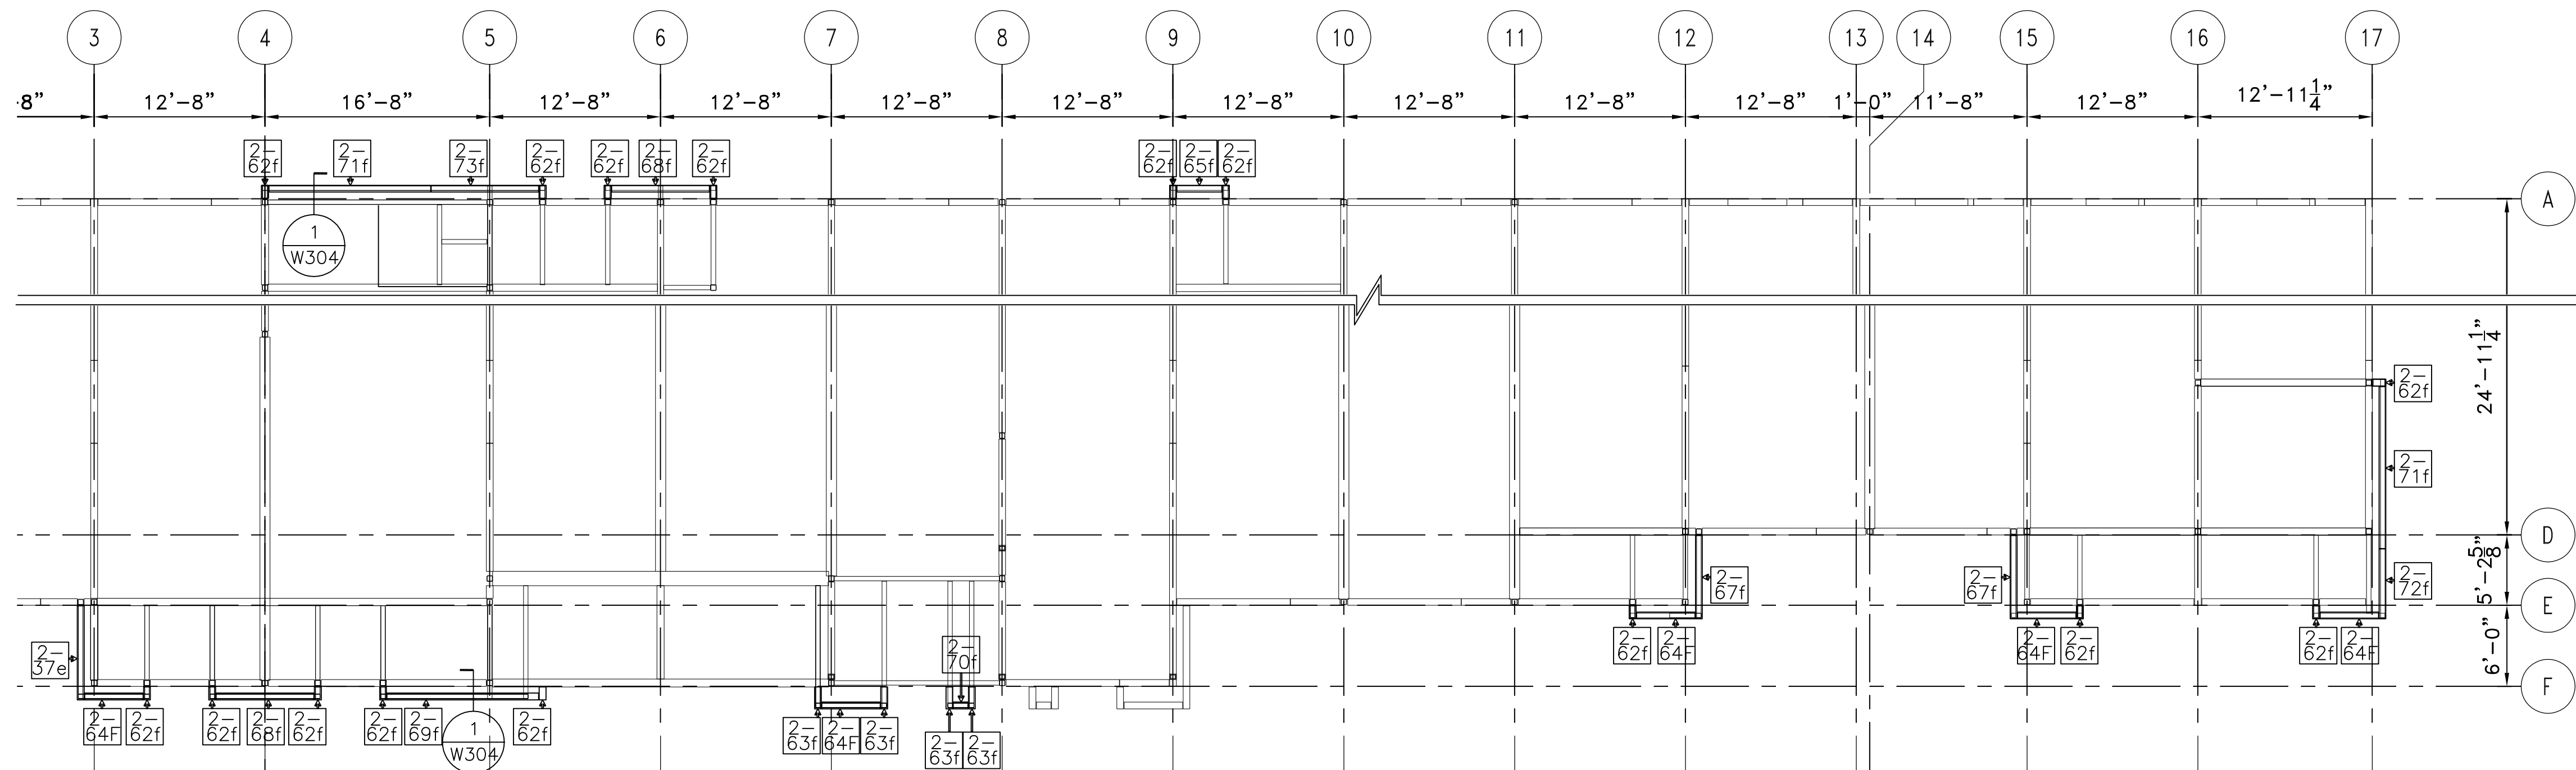

1st FLOOR FASCIA PANEL PLAN/TAG
SCALE: 1/8" = 1'-0"

Home2 Suites
Flowood, MS

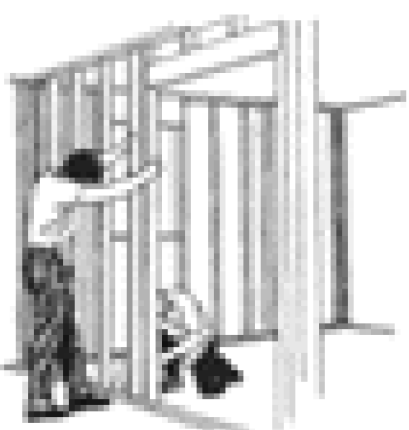


PANELIZERS, LLC
1695 HWY 161
WALLS, MS 38680
PHONE: (662) 936-5260
FAX: (662) 936-5262

Shop Drawings by:
HILLMAN ENTERPRISES, INC.
P.O. Box 106
Graham, AL 36263
PHONE: (256) 449-3261

Sheet Number:
W102

Job Number:
1605/1655

Date:
02/02/17

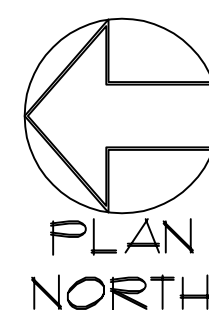

GENERAL NOTES:

- 1) SEE W301 THROUGH W401 FOR SECTIONS AND DETAILS.
- 2) WALLS UNDERNEATH RED IRON BEAMS ARE NOT INCLUDED.
- 3) SEE QUESTIONS ON THIS SHEET AND AT PANEL DRAWINGS.

3-01d DEMISING WALL BY PANELIZERS, LLC

3-
02c CORRIDOR WALL BY PANELIZERS, LLC

3-0.3e* EXTERIOR WALL BY PANELIZERS, LLC

 PLEASE VERIFY.

ENGINEER'S NOTE. PLEASE VERIFY CONNECTION.

 → SCALED DIMENSION. PLEASE VERIFY.

 SEE NOTE ON PANEL DRAWING

 MECHANICAL CHASE WALL BY PANELIZERS, LLC

===== (2) L5x3x3/8, NOT BY PANELIZERS, LLC

 CMU WALL, NOT BY PANELIZERS, LLC

 WALL WITH OPENING/HEADER BY PANELIZERS, LLC

 WALL WITH DOOR OPENING BY PANELIZERS, LLC

 WALL WITH WINDOW OPENING BY PANELIZERS, LLC


7695 HWY 161
WALLS, MS 38680
PHONE: (662) 996-5260
FAX: (662) 996-5262

Shop Drawings by:
HILLMAN ENTERPRISES, INC.
P.O. Box 106
Graham, AL 36263
PHONE: (256) 449-9261

Sheet Number: W103

Job Number:
1605/1655




Date: 02/02/17

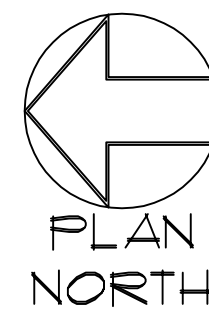

4th FLOOR STRUCTURAL PANEL PLAN/TAG
SCALE: 1/8" = 1'-0"

 WALL WITH WINDOW OPENING BY PANELIZERS, LLC

Date: 02/02/17

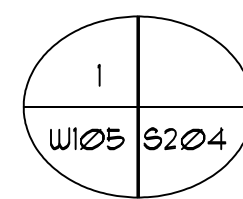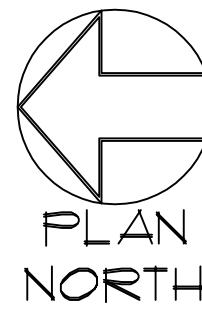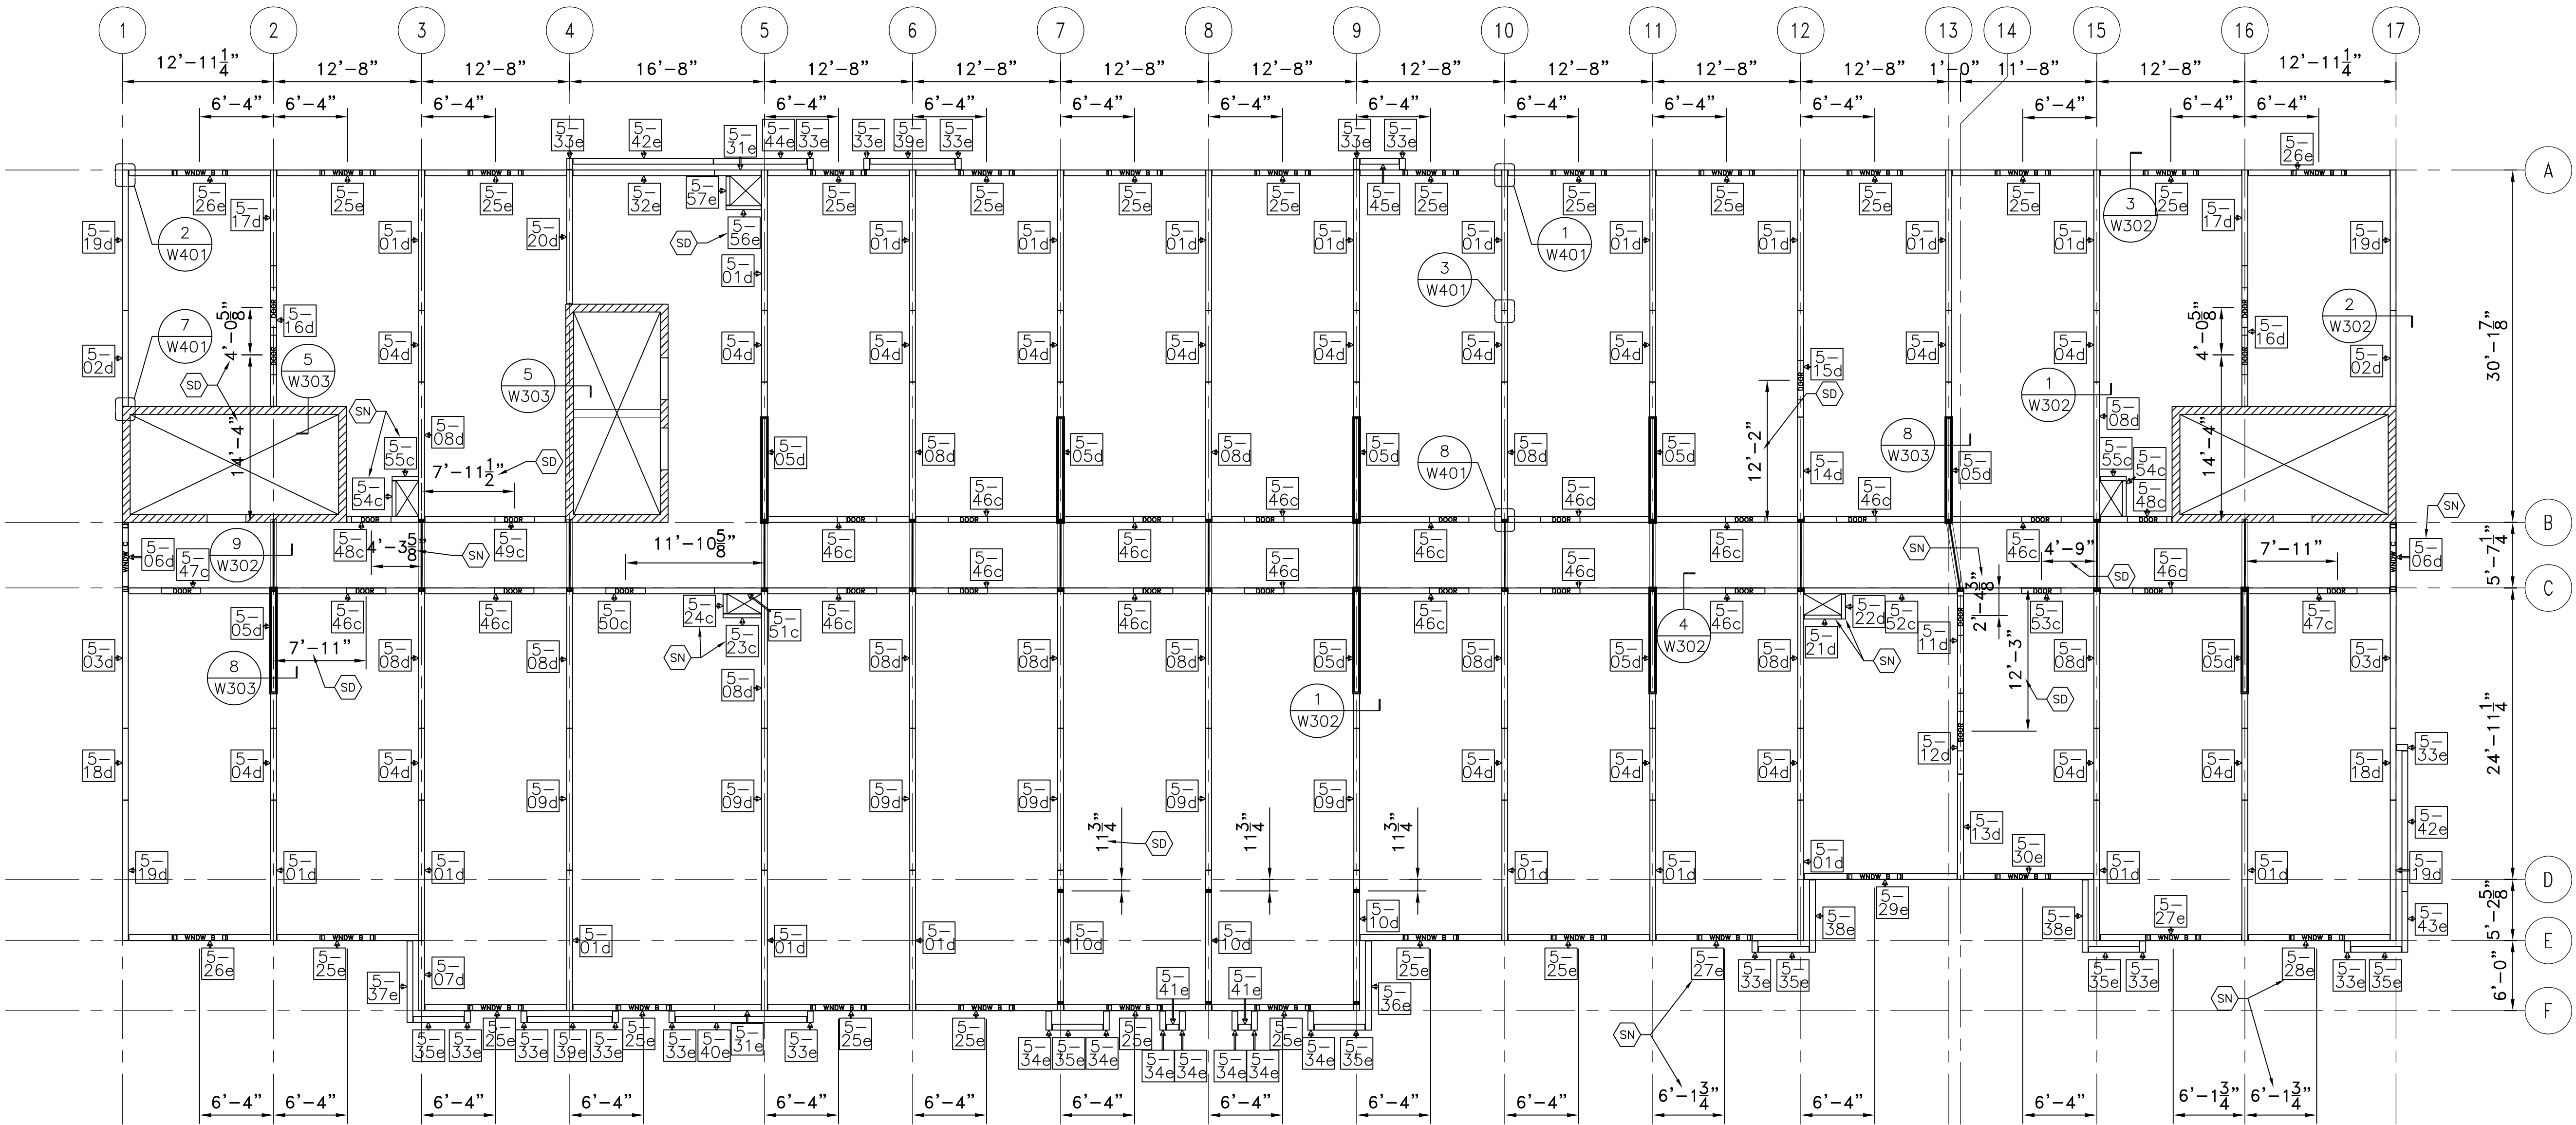

5TH FLOOR STRUCTURAL PANEL PLAN/TAG

SCALE: 1/8" = 1'-0"

GENERAL NOTES:

- 1) SEE W301 THROUGH W401 FOR SECTIONS AND DETAILS.
- 2) WALLS UNDERNEATH RED IRON BEAMS ARE NOT INCLUDED.
- 3) SEE QUESTIONS ON THIS SHEET AND AT PANEL DRAWINGS.

MC1 STUD PACK BY PANELIZERS, LLC

DEMISING WALL BY PANELIZERS, LLC

CORRIDOR WALL BY PANELIZERS, LLC

EXTERIOR WALL BY PANELIZERS, LLC

PLEASE VERIFY.

ENGINEER'S NOTE. PLEASE VERIFY CONNECTION.

SCALED DIMENSION. PLEASE VERIFY.

SEE NOTE ON PANEL DRAWING

MECHANICAL CHASE WALL BY PANELIZERS, LLC

(2) L5x3x3/8, NOT BY PANELIZERS, LLC


CMU WALL, NOT BY PANELIZERS, LLC

WALL WITH OPENING/HEADER BY PANELIZERS, LLC

WALL WITH DOOR OPENING BY PANELIZERS, LLC

WALL WITH WINDOW OPENING BY PANELIZERS, LLC

Home2 Suites
Flowood, MS

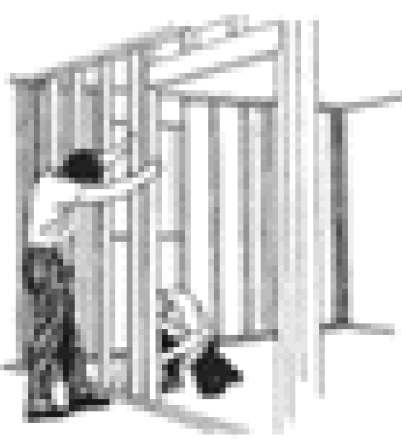

PANELIZERS, LLC




1695 HWY 161
WALLS, MS 38680
PHONE: (662) 936-5260
FAX: (662) 936-5262

Shop Drawings by:
HILLMAN ENTERPRISES, INC.
P.O. Box 106
Graham, AL 36263
PHONE: (256) 449-3261

Sheet Number:
W105

Job Number:
1605/1655


Date:
02/02/17

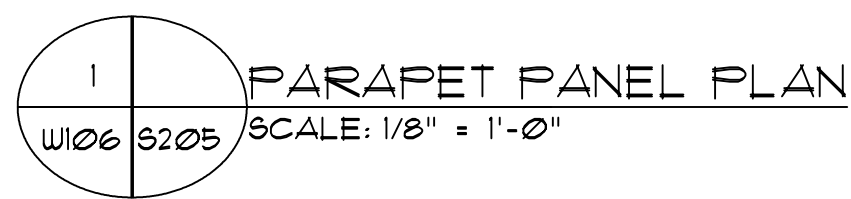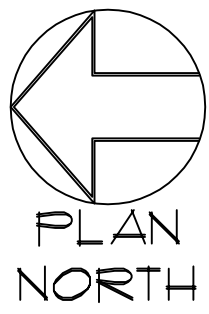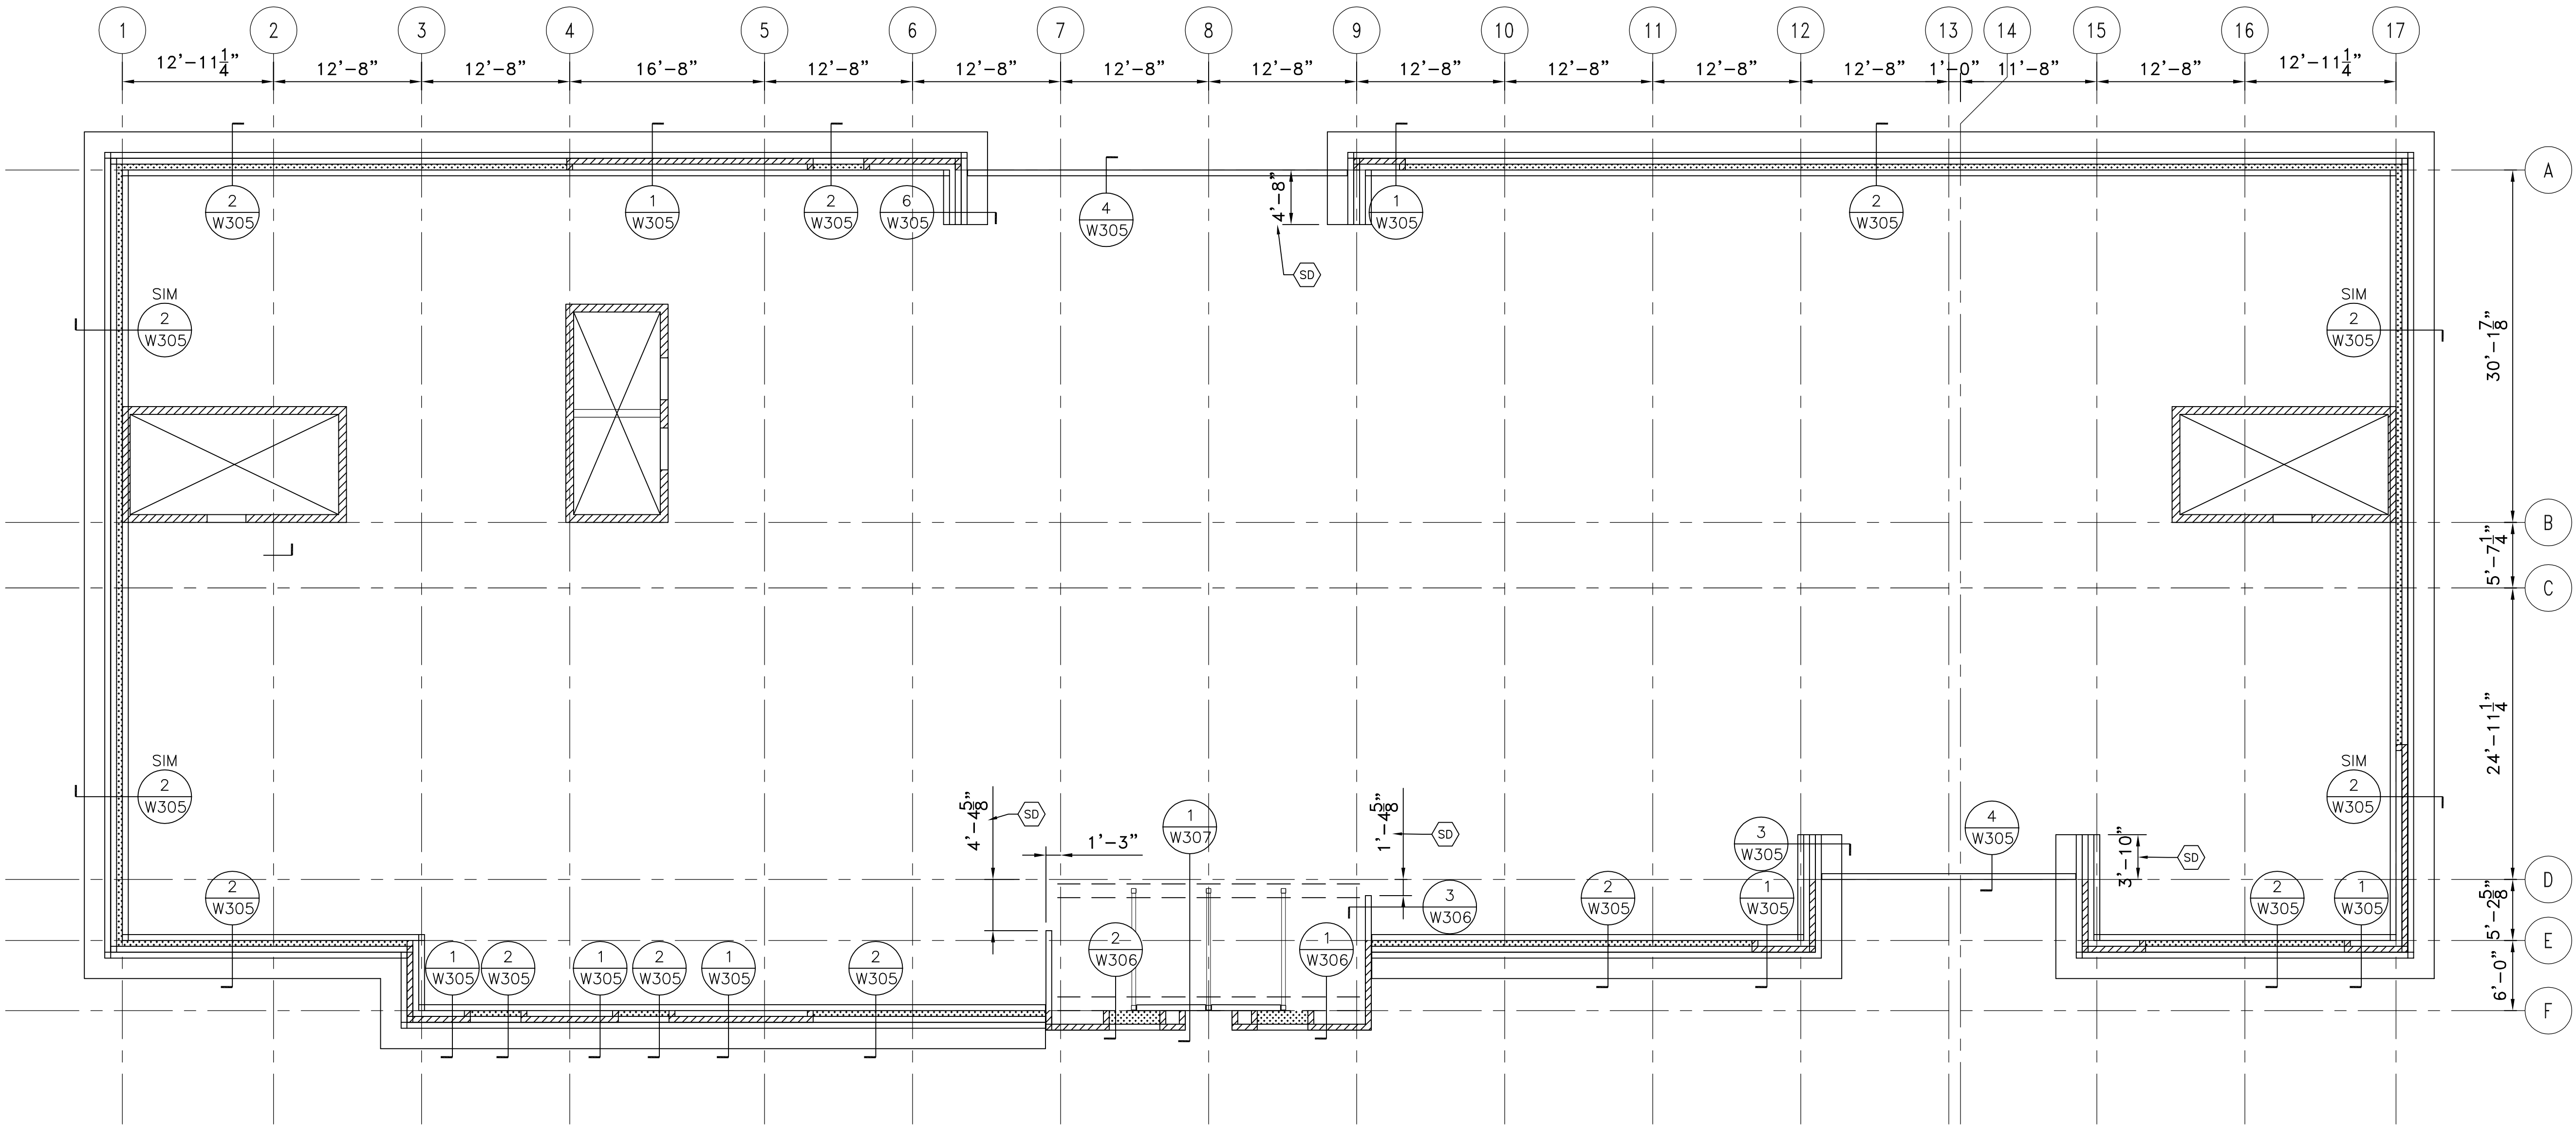

GENERAL NOTES:
1) SEE W301 THROUGH W401 FOR SECTIONS AND DETAILS.
2) WALLS UNDERNEATH RED IRON BEAMS ARE NOT INCLUDED.
3) SEE QUESTIONS ON THIS SHEET AND AT PANEL DRAWINGS.

- MC1 STUD PACK BY PANELIZERS, LLC
- PARAPET BY PANELIZERS, LLC
- PLEASE VERIFY.
- ENGINEER'S NOTE. PLEASE VERIFY CONNECTION.
- SCALED DIMENSION. PLEASE VERIFY.
- SEE NOTE ON PANEL DRAWING
- MECHANICAL CHASE WALL BY PANELIZERS, LLC
- (2) L5x3x3/8, NOT BY PANELIZERS, LLC
- CMU WALL, NOT BY PANELIZERS, LLC
- WALL WITH OPENING/HEADER BY PANELIZERS, LLC
- WALL WITH DOOR OPENING BY PANELIZERS, LLC
- WALL WITH WINDOW OPENING BY PANELIZERS, LLC

Home2 Suites
Flowood, MS

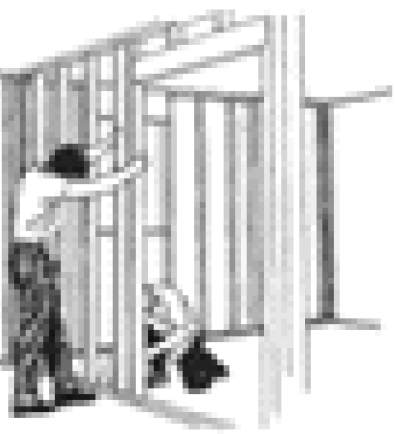



PANELIZERS, LLC
7695 HWY 161
WALLS, MS 38680
PHONE: (662) 996-5260
FAX: (662) 996-5262

Shop Drawings by:
HILLMAN ENTERPRISES, INC.
P.O. Box 106
Graham, AL 36263
PHONE: (256) 449-3261

Sheet Number:
W106

Job Number:
1605/1655

Date:
02/02/17

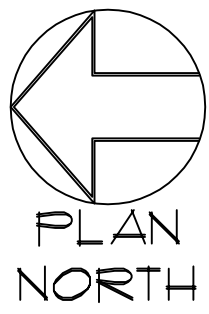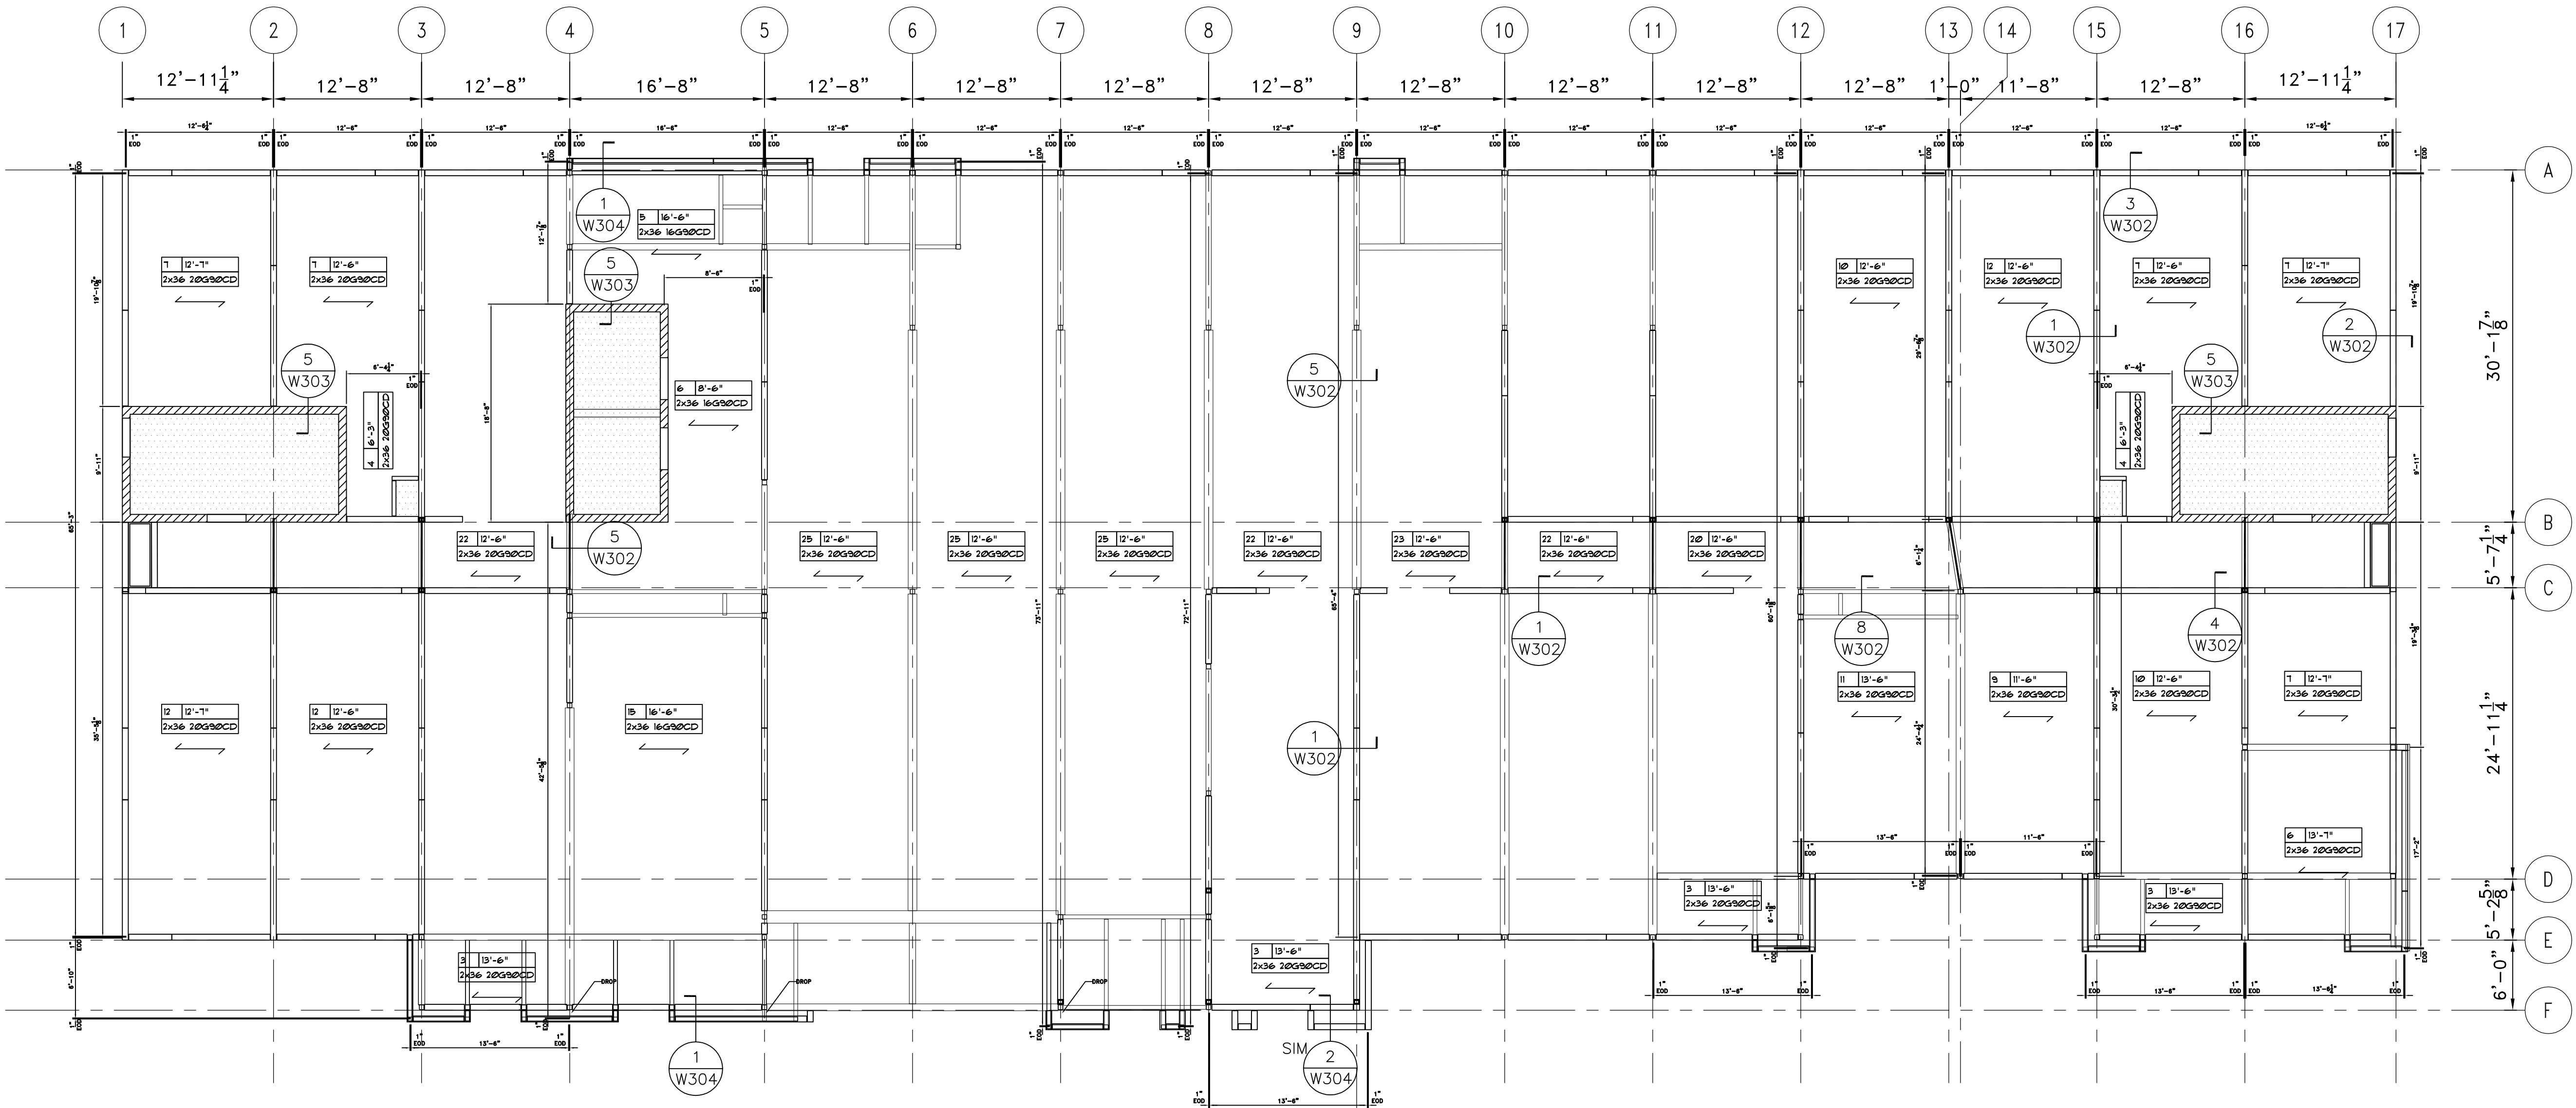

2nd FLOOR DECK PLAN, SHOWN OVER 1ST FLOOR WALLS
SCALE: 1/8" = 1'-0"

DECK PLACEMENT PLAN

[Hatched Pattern] = 5" TOTAL THICKNESS (3" CONCRETE + 2" DECK)



[White Pattern] = NO DECKING NO CONCRETE

GENERAL NOTES:


1) SEE W301 THROUGH W401 FOR SECTIONS AND DETAILS.

2) WALLS UNDERNEATH RED IRON BEAMS ARE NOT INCLUDED.

3) SEE QUESTIONS ON THIS SHEET AND AT PANEL DRAWINGS.

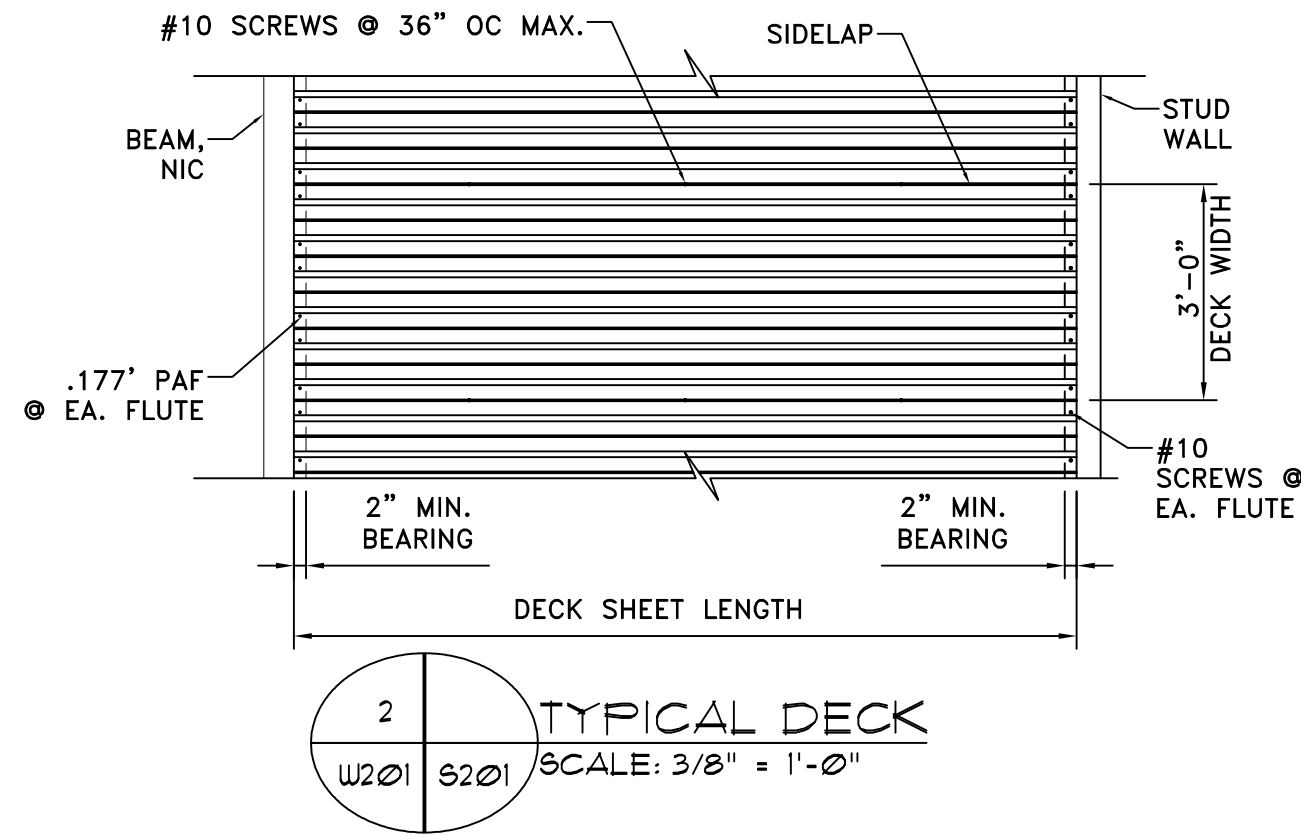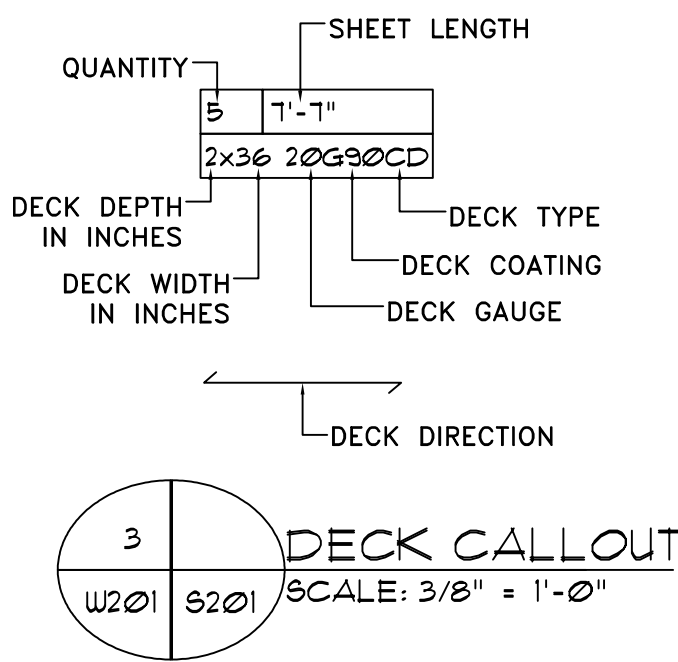

Home2 Suites
Flowood, MS

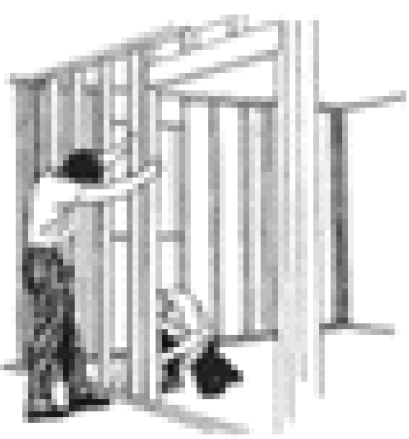



PANELIZERS, LLC
1695 HWY 161
WALLS, MS 38680
PHONE: (662) 936-5260
FAX: (662) 936-5262

Shop Drawings by:
HILLMAN ENTERPRISES, INC.
P.O. Box 106
Graham, AL 36263
PHONE: (256) 449-3261

Sheet Number:
W201

Job Number:
1605/1655
Date:
02/02/17

FOR
APPROVAL
ONLY

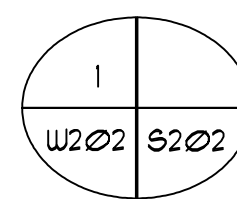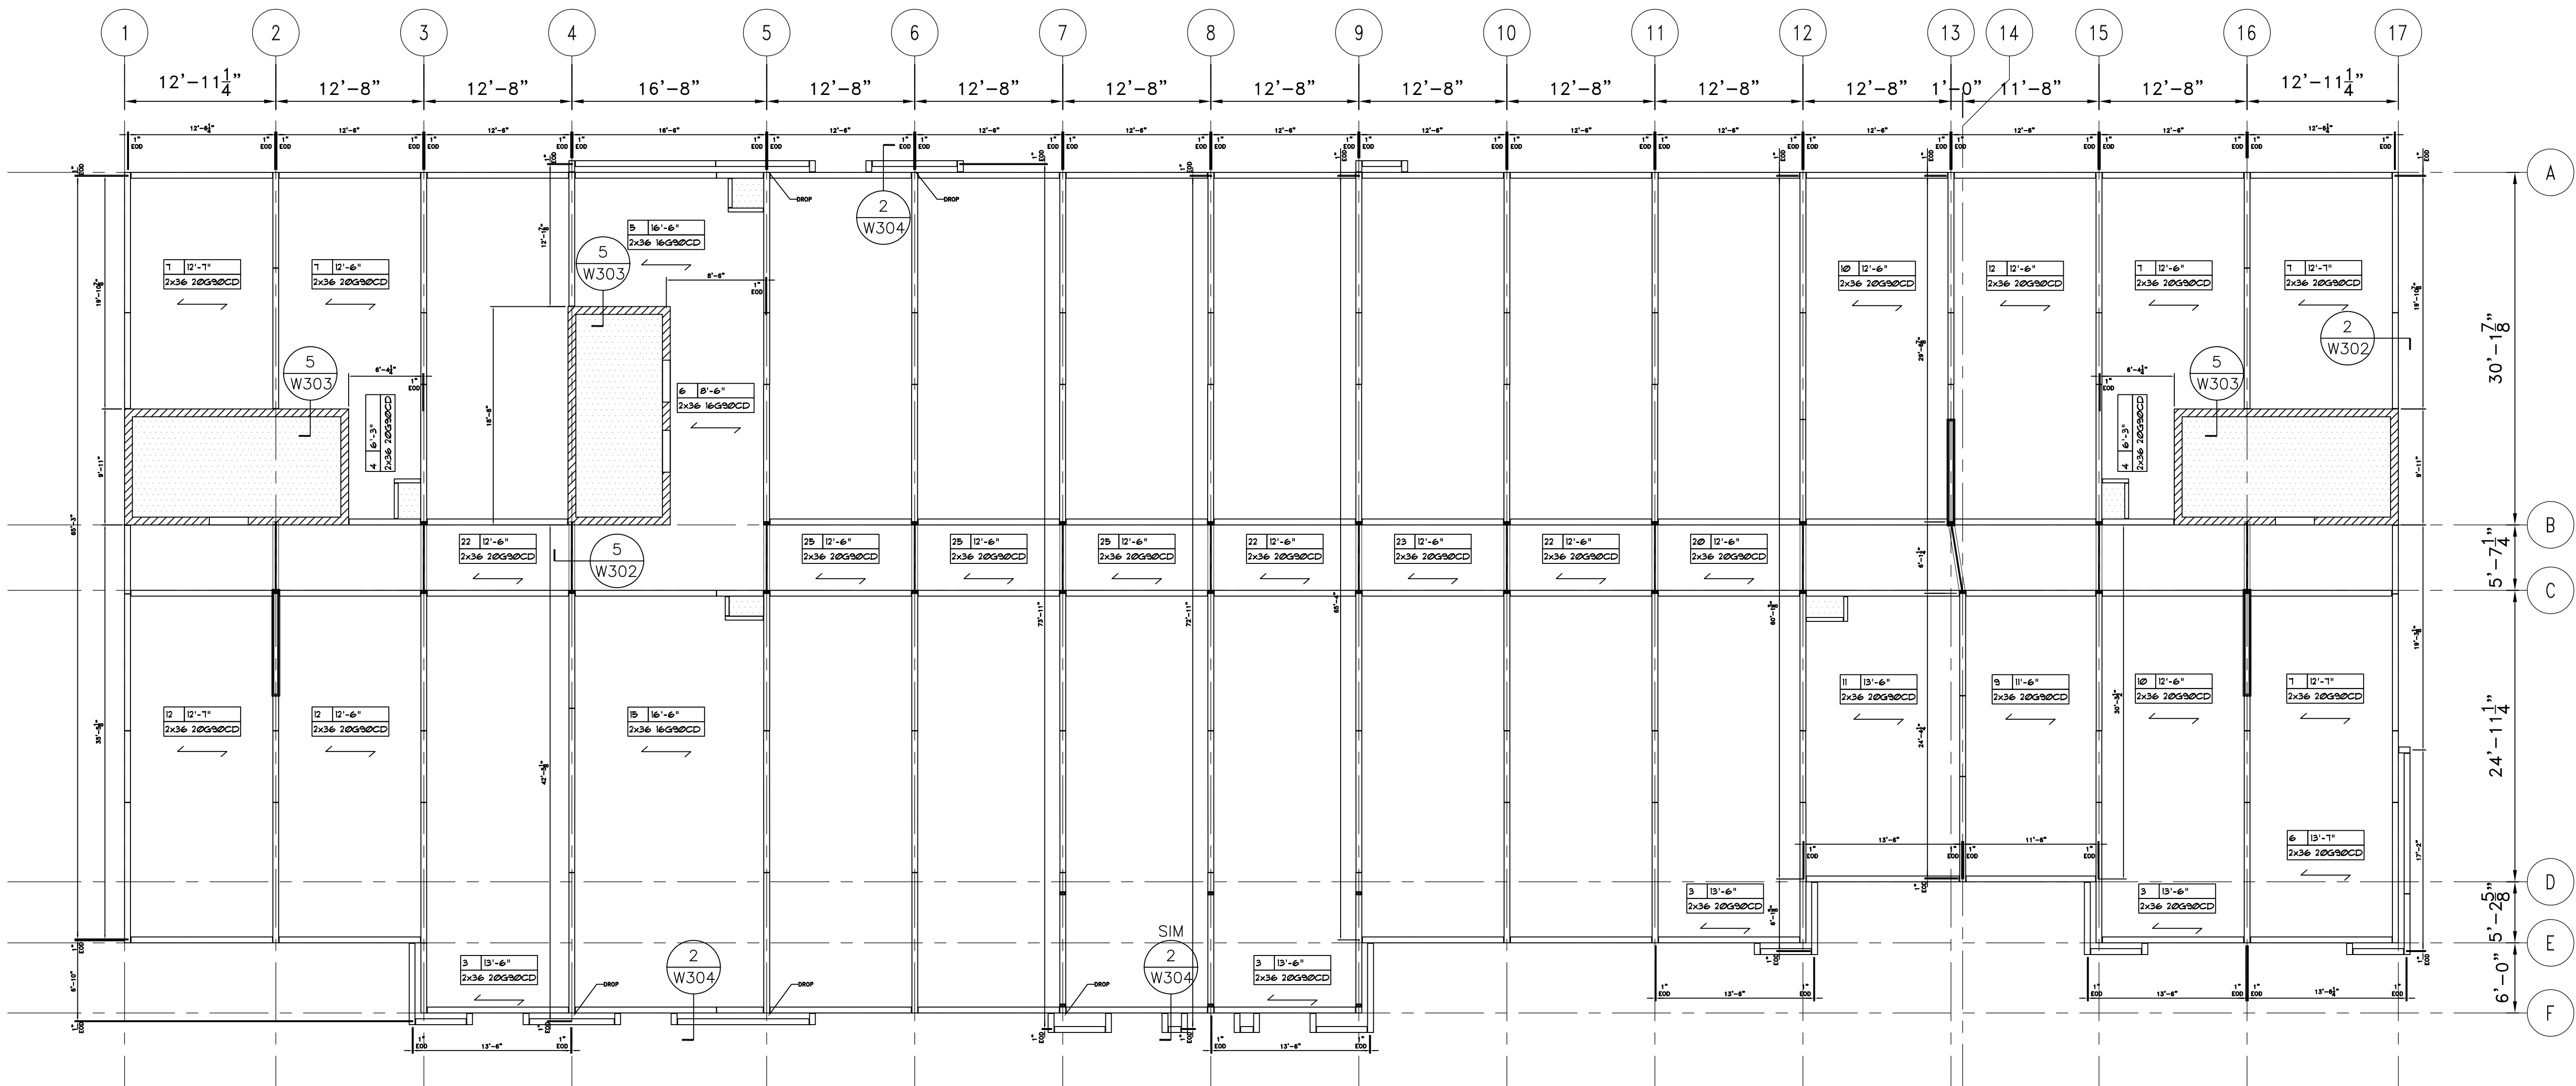

3rd FLOOR DECK PLAN, SHOWN OVER 2nd FLOOR WALLS
SCALE: 1/8" = 1'-0"

DECK PLACEMENT PLAN


[Solid line] = 5" TOTAL THICKNESS (3" CONCRETE + 2" DECK)

[Hatched area] = NO DECKING NO CONCRETE

GENERAL NOTES:

- 1) SEE W301 THROUGH W401 FOR SECTIONS AND DETAILS.
- 2) WALLS UNDERNEATH RED IRON BEAMS ARE NOT INCLUDED.
- 3) SEE QUESTIONS ON THIS SHEET AND AT PANEL DRAWINGS.

Home2 Suites
Flowood, MS

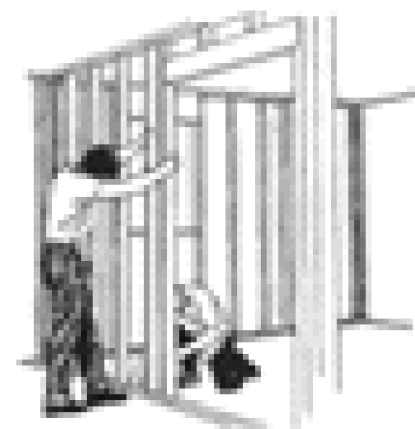

PANELIZERS, LLC
7695 HWY 161
WALLS, MS 38680
PHONE: (662) 996-5260
FAX: (662) 996-5262


Shop Drawings by:
HILLMAN ENTERPRISES, INC.
P.O. Box 106
Graham, AL 36263
PHONE: (256) 449-9261

Sheet Number:
W202




Job Number:
1605/1655

Date:
02/02/17

FOR
APPROVAL
ONLY

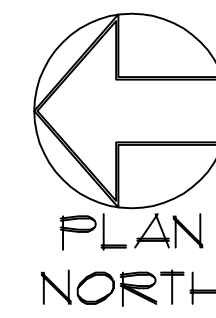

Date: 02/02/17

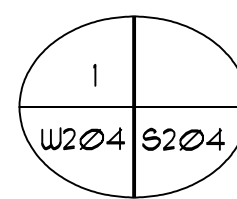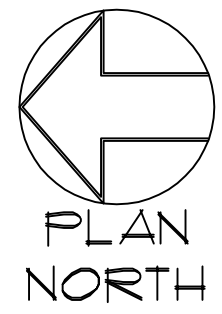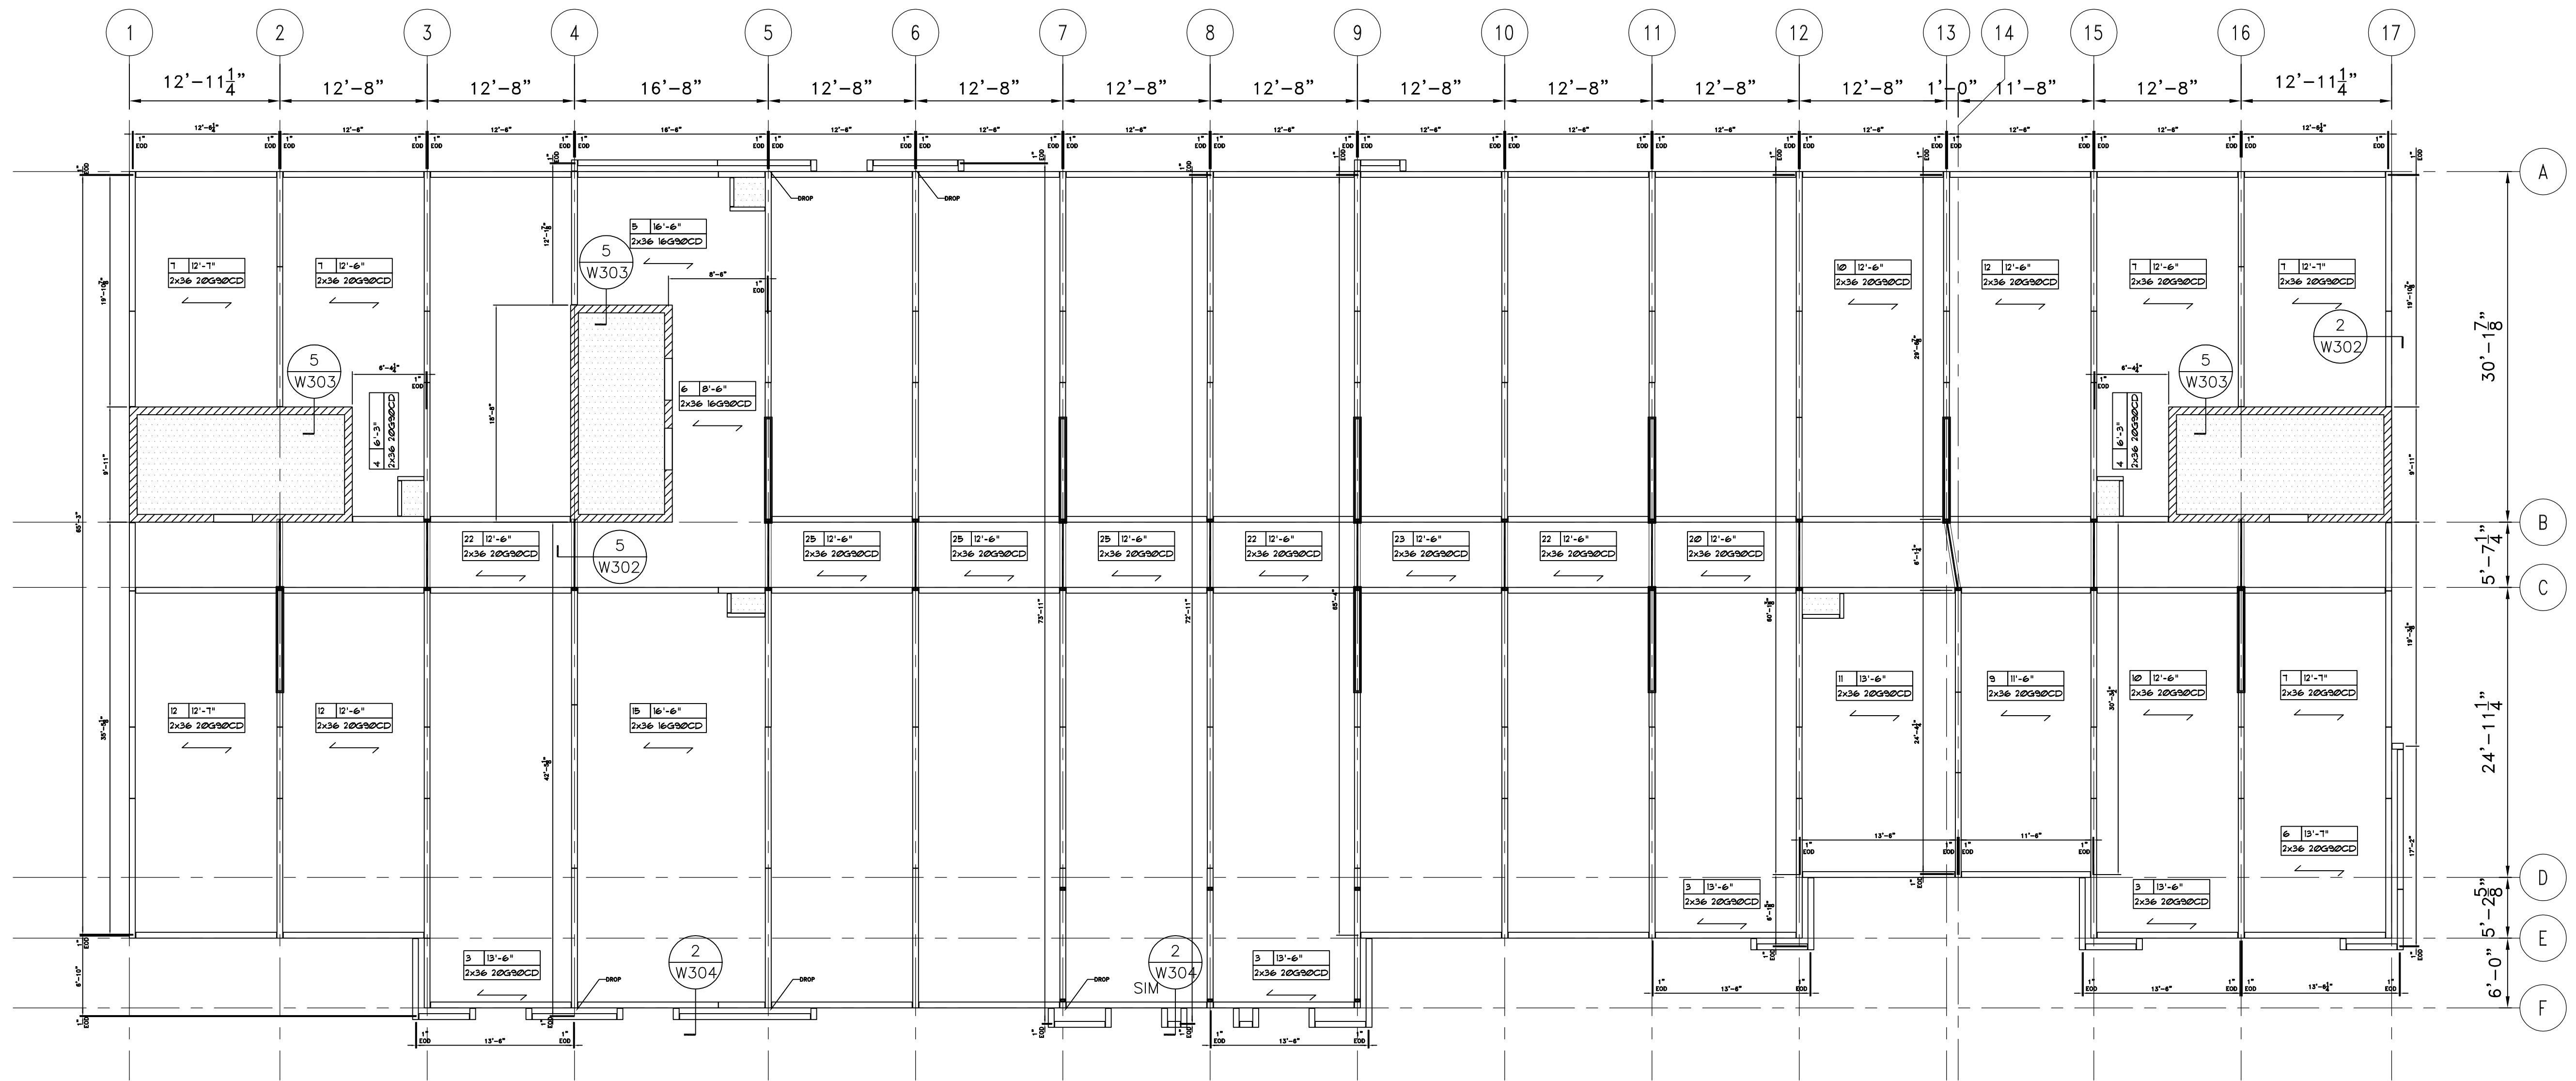

5TH FLOOR DECK PLAN, SHOWN OVER 4TH FLOOR WALLS

SCALE: 1/8" = 1'-0"

DECK PLACEMENT PLAN


[Hatched Box] = 5" TOTAL THICKNESS (3" CONCRETE + 2" DECK)

[Solid Box] = NO DECKING NO CONCRETE

GENERAL NOTES:

- 1) SEE W301 THROUGH W401 FOR SECTIONS AND DETAILS.
- 2) WALLS UNDERNEATH RED IRON BEAMS ARE NOT INCLUDED.
- 3) SEE QUESTIONS ON THIS SHEET AND AT PANEL DRAWINGS.

Home2 Suites
Flowood, MS

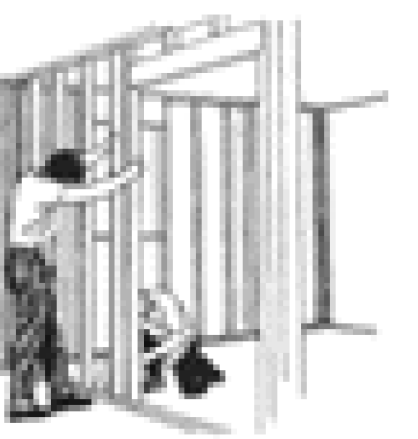

PANELIZERS, LLC
1695 HWY 161
WALLS, MS 38680
PHONE: (662) 996-5260
FAX: (662) 996-5262



Shop Drawings by:
HILLMAN ENTERPRISES, INC.
P.O. Box 106
Graham, AL 36263
PHONE: (205) 443-9261

Sheet Number:
W204


Job Number:
1605/1655

Date:
02/02/17


FOR
APPROVAL
ONLY

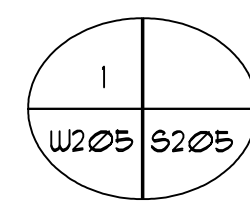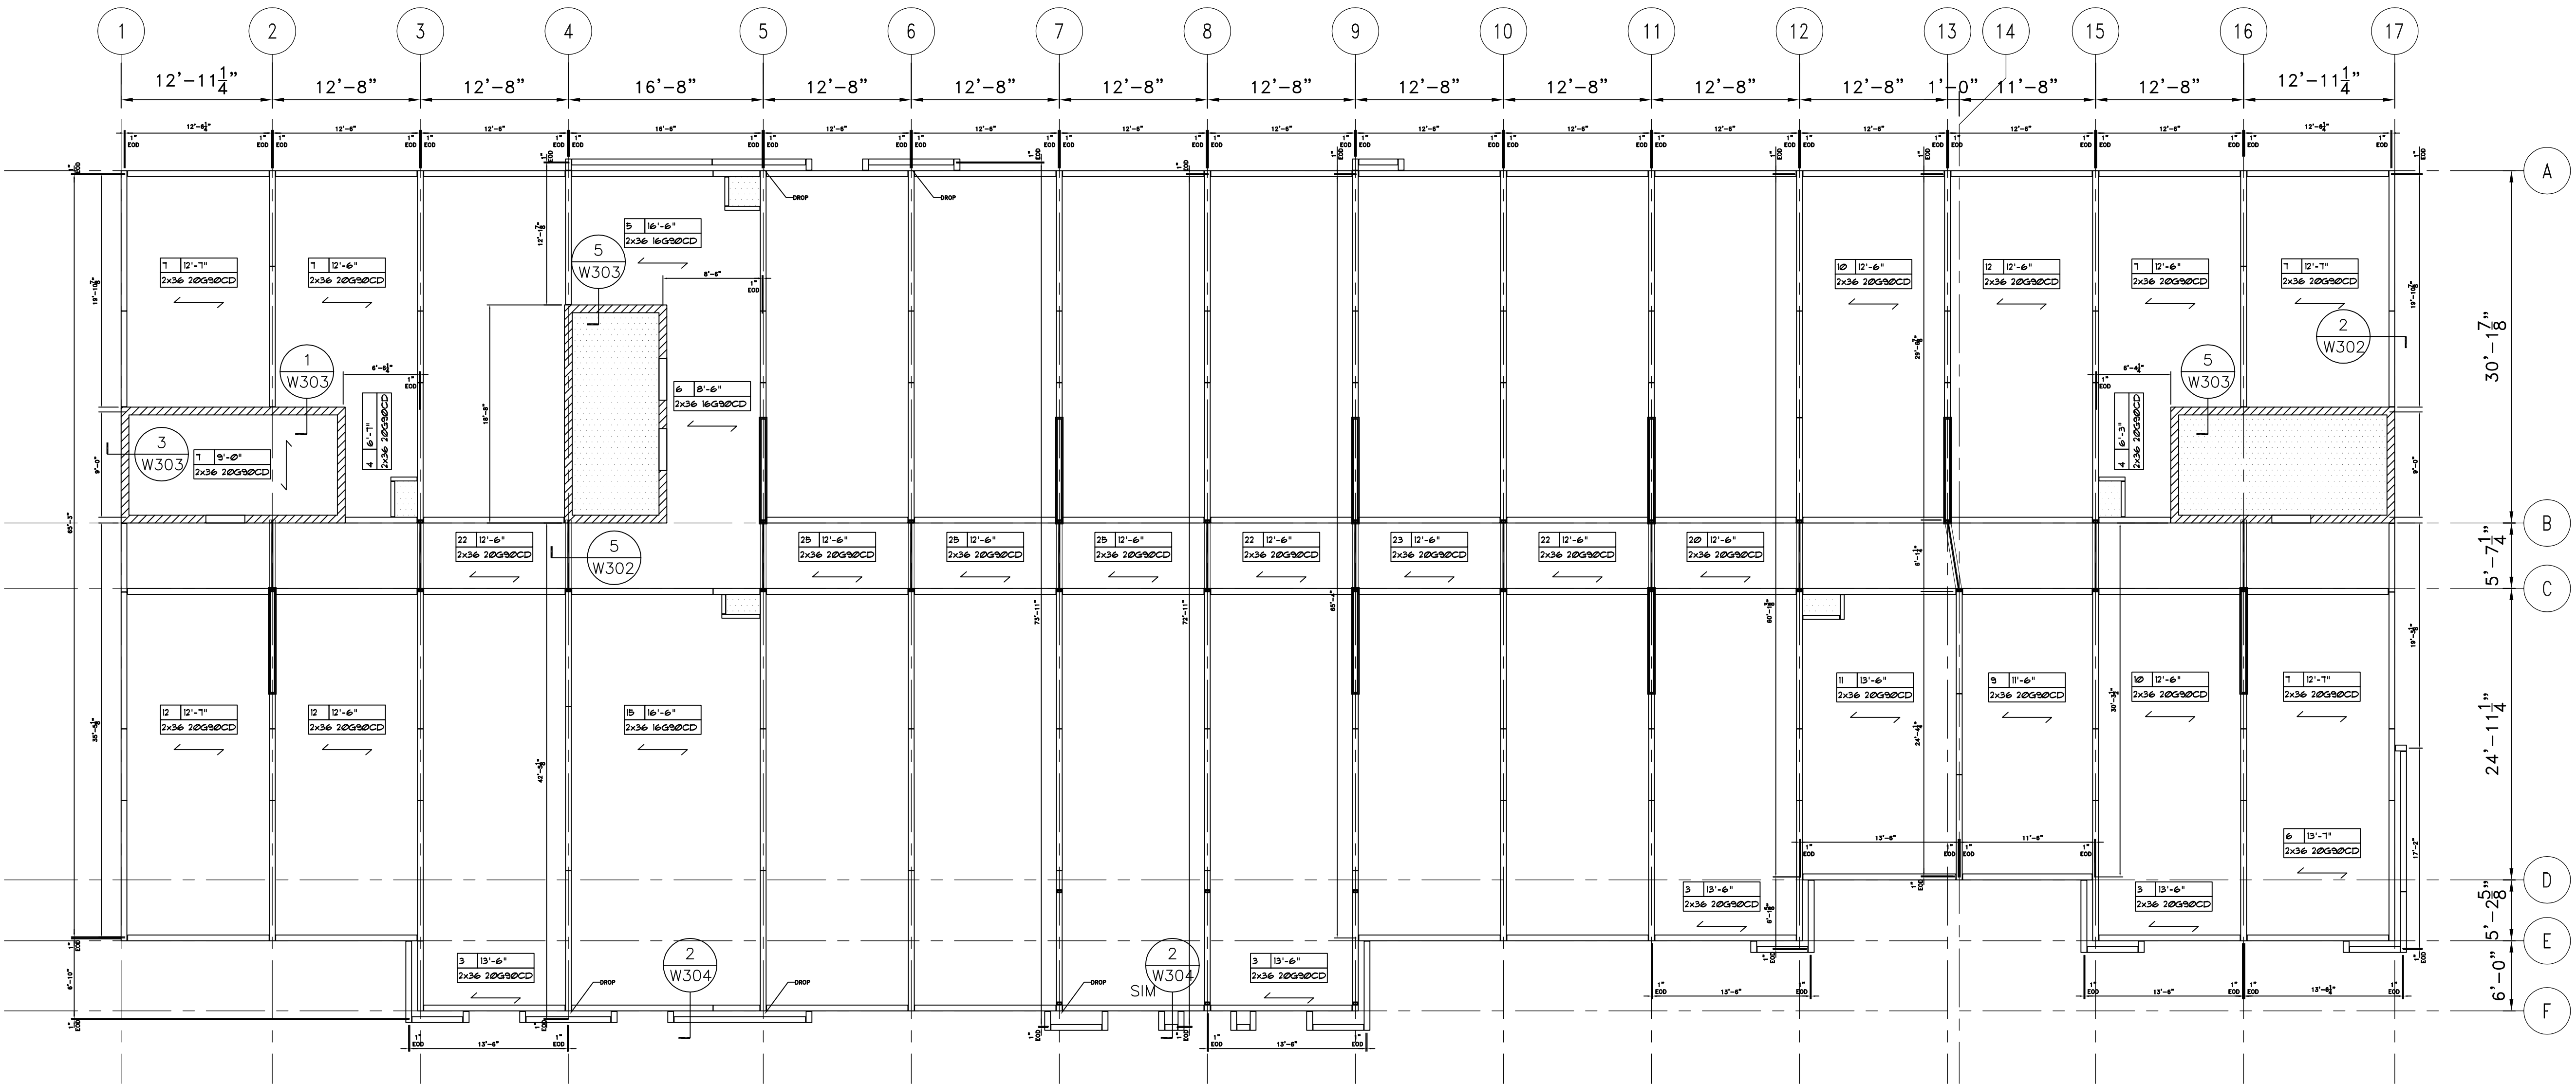

ROOF DECK PLAN, SHOWN OVER 5TH FLOOR WALLS
SCALE: 1/8" = 1'-0"

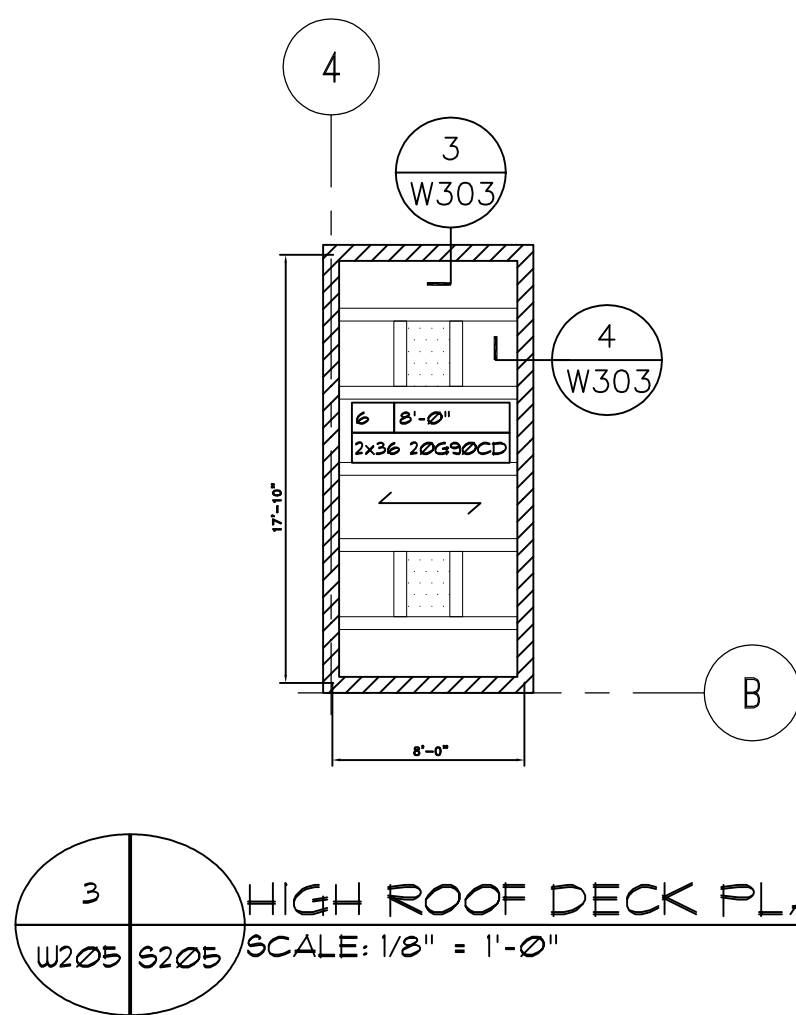

HIGH ROOF DECK PLAN
SCALE: 1/8" = 1'-0"

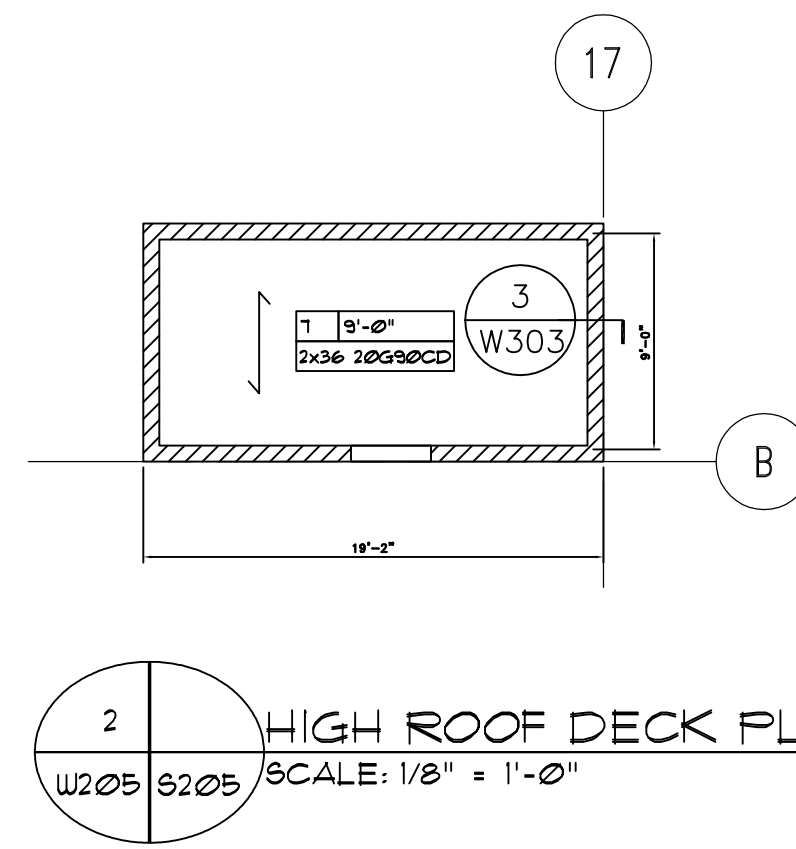

HIGH ROOF DECK PLAN
SCALE: 1/8" = 1'-0"

DECK PLACEMENT PLAN

[Solid Line] = 5" TOTAL THICKNESS (3" CONCRETE + 2" DECK)

[Dashed Line] = NO DECKING NO CONCRETE

GENERAL NOTES:


1) SEE W301 THROUGH W401 FOR SECTIONS AND DETAILS.

2) WALLS UNDERNEATH RED IRON BEAMS ARE NOT INCLUDED.

3) SEE QUESTIONS ON THIS SHEET AND AT PANEL DRAWINGS.

FOR
APPROVAL
ONLY

Home2 Suites
Flowood, MS

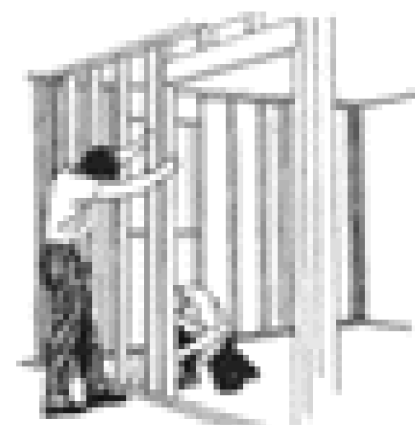


PANELIZERS, LLC
16935 HWY 161
WALLS, MS 38680
PHONE: (662) 996-5260
FAX: (662) 996-5262

Shop Drawings by:
HILLMAN ENTERPRISES, INC.
P.O. Box 106
Graham, AL 36263
PHONE: (256) 449-9261


Sheet Number:
W204

Job Number:
1605/1655









Date:
02/02/17

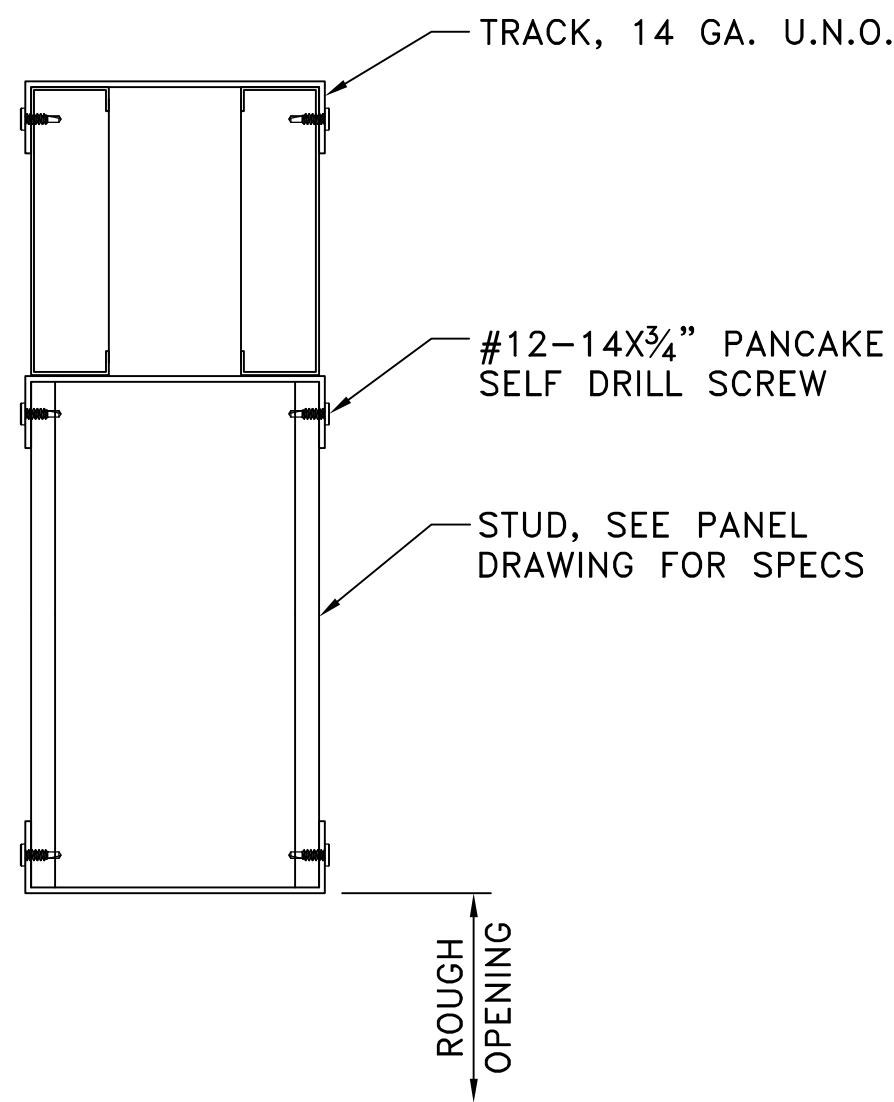


3
W301
SECTION DETAIL
SCALE: 3" = 1'-0"

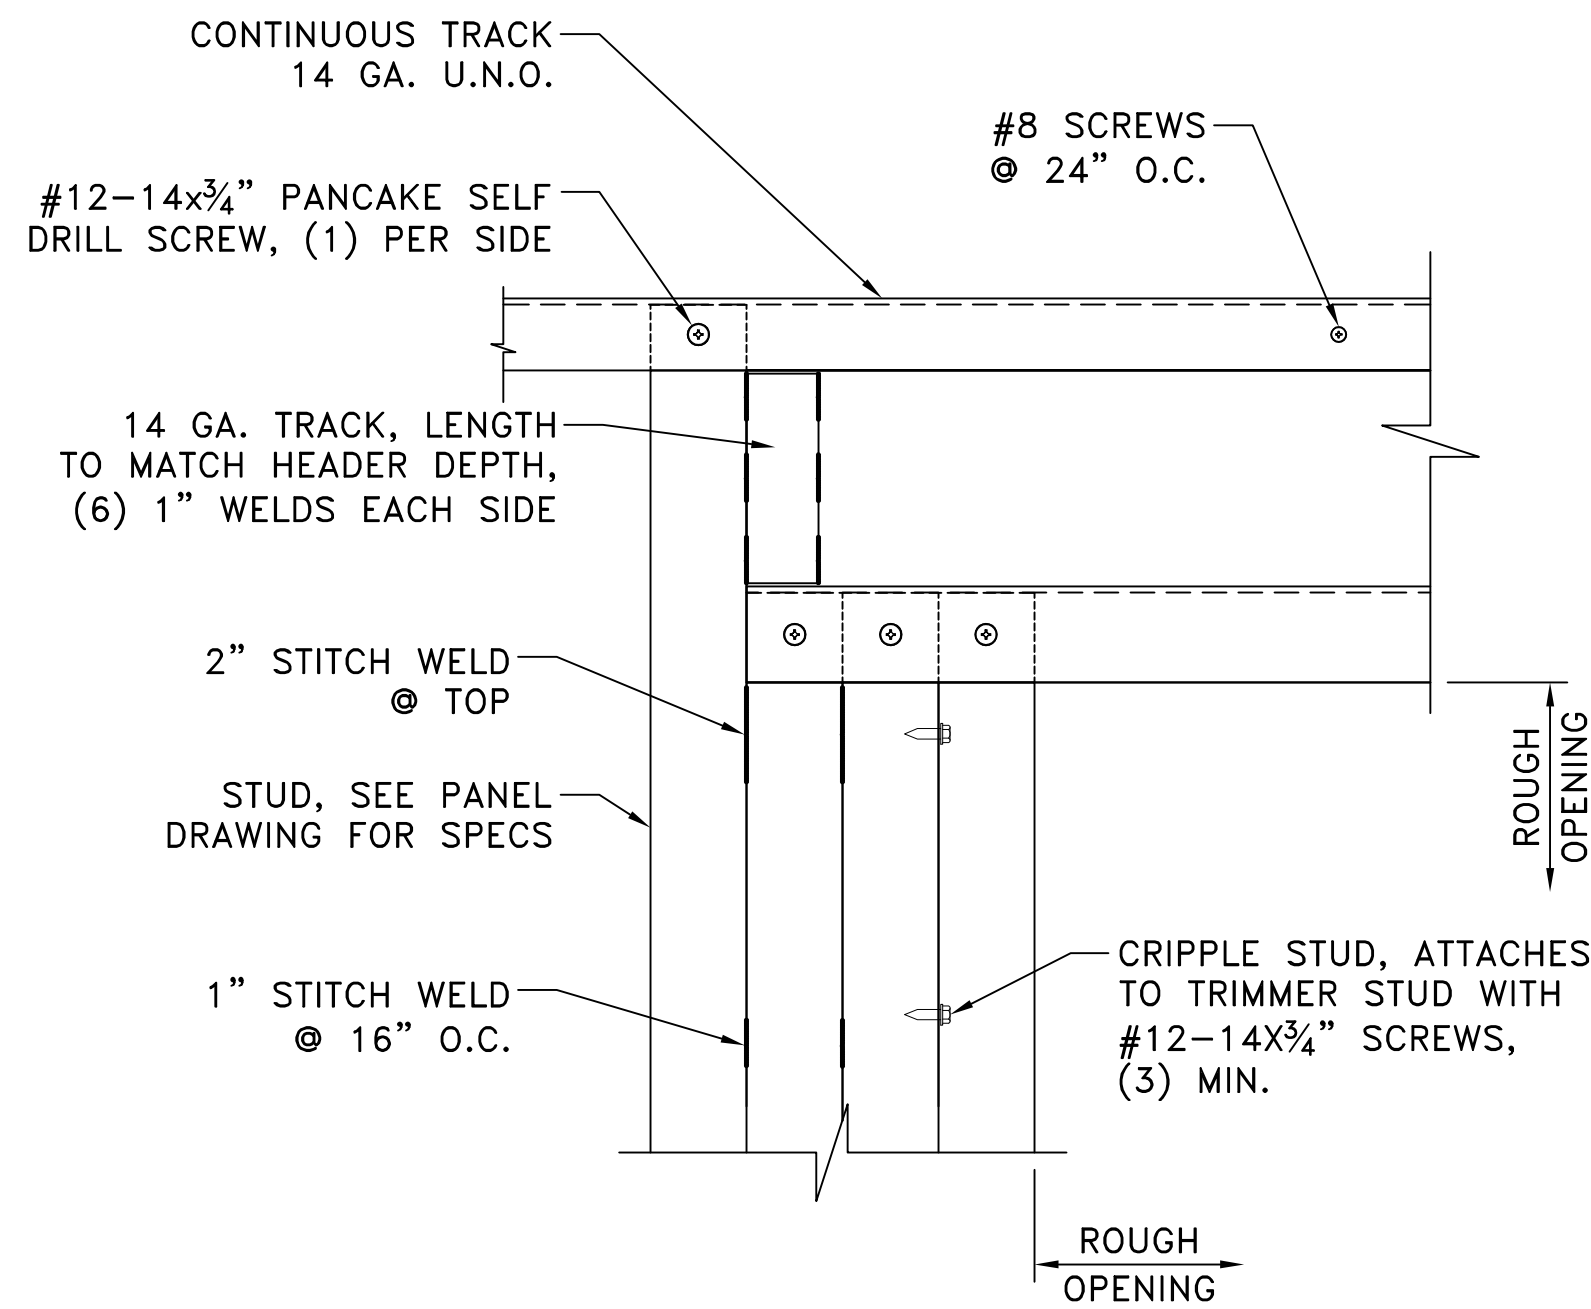

2
W301
ENLARGED AREA
SCALE: 3" = 1'-0"

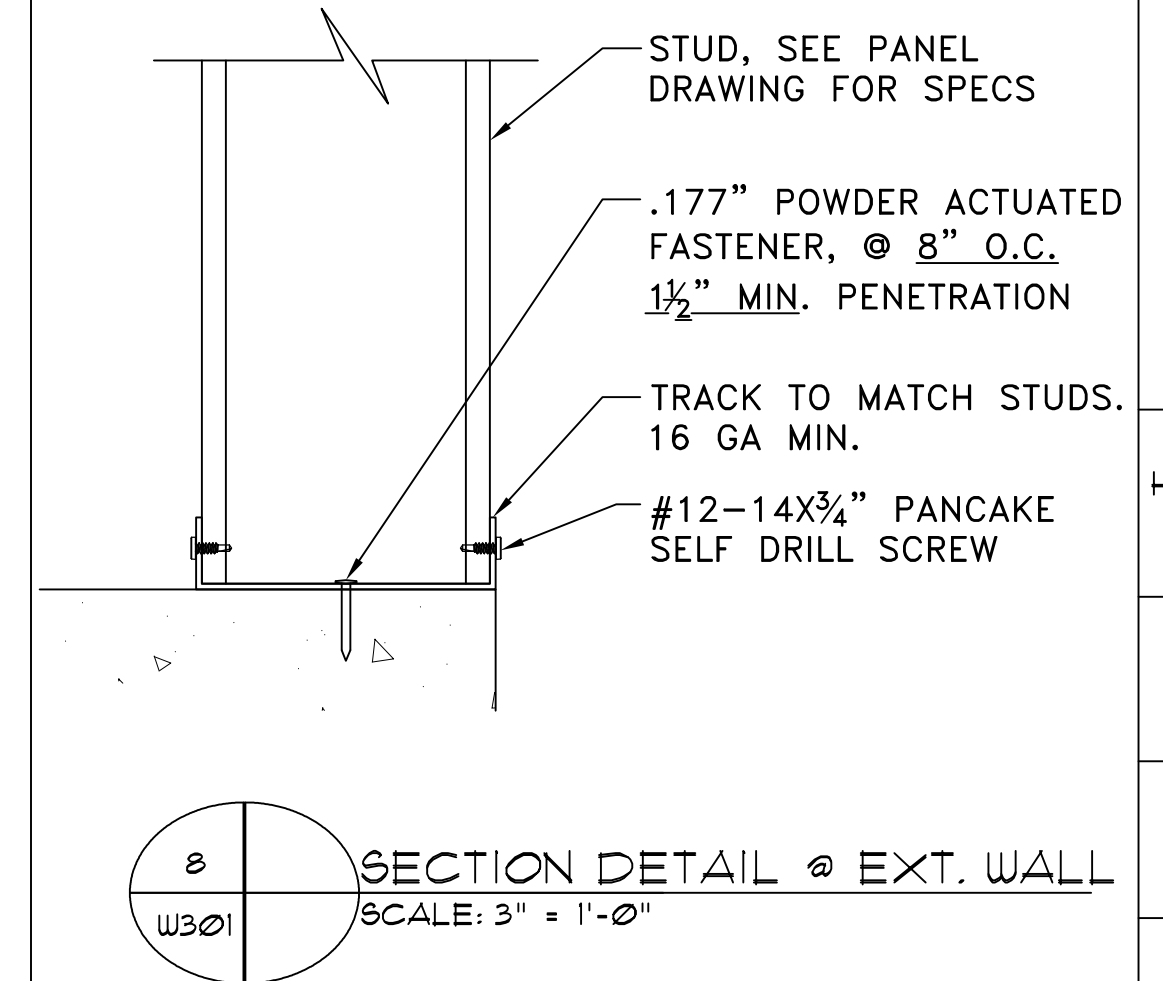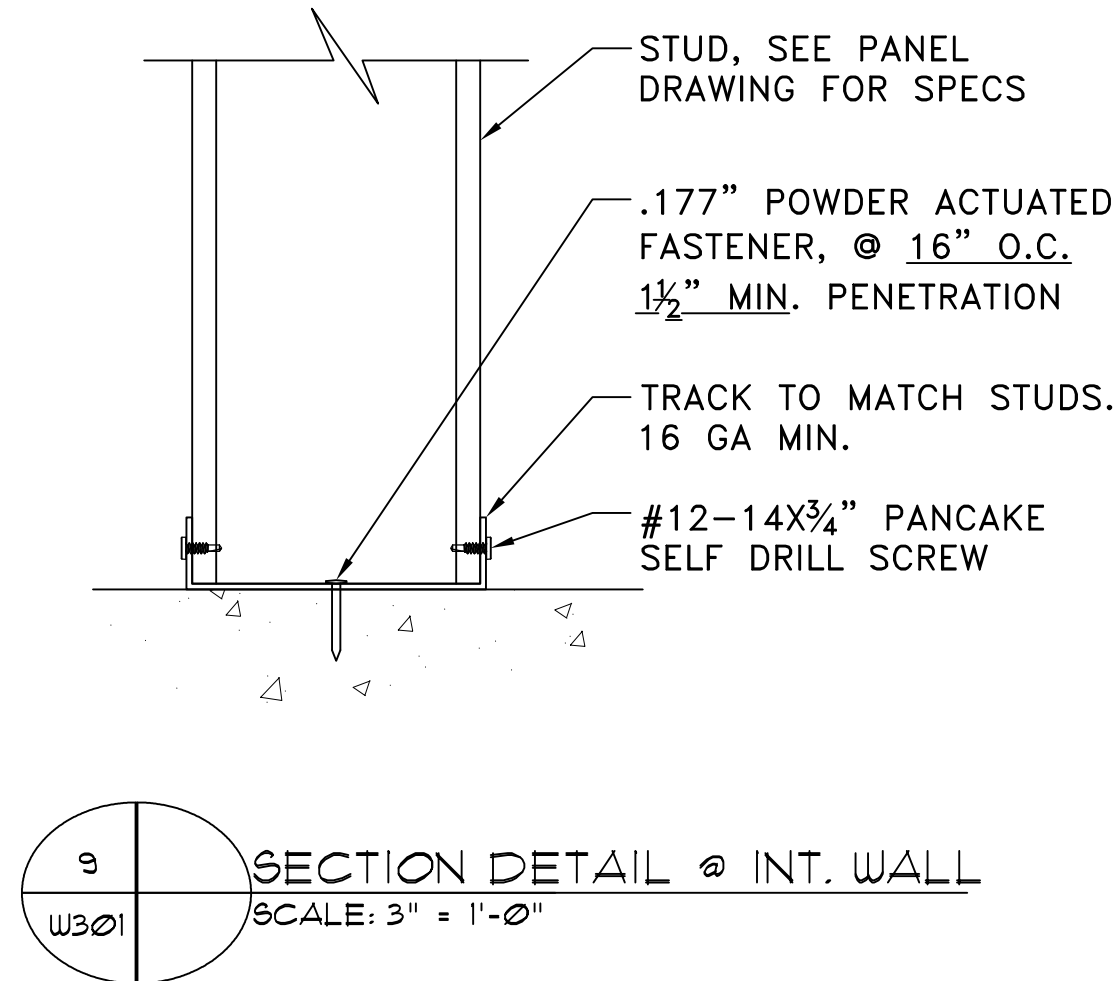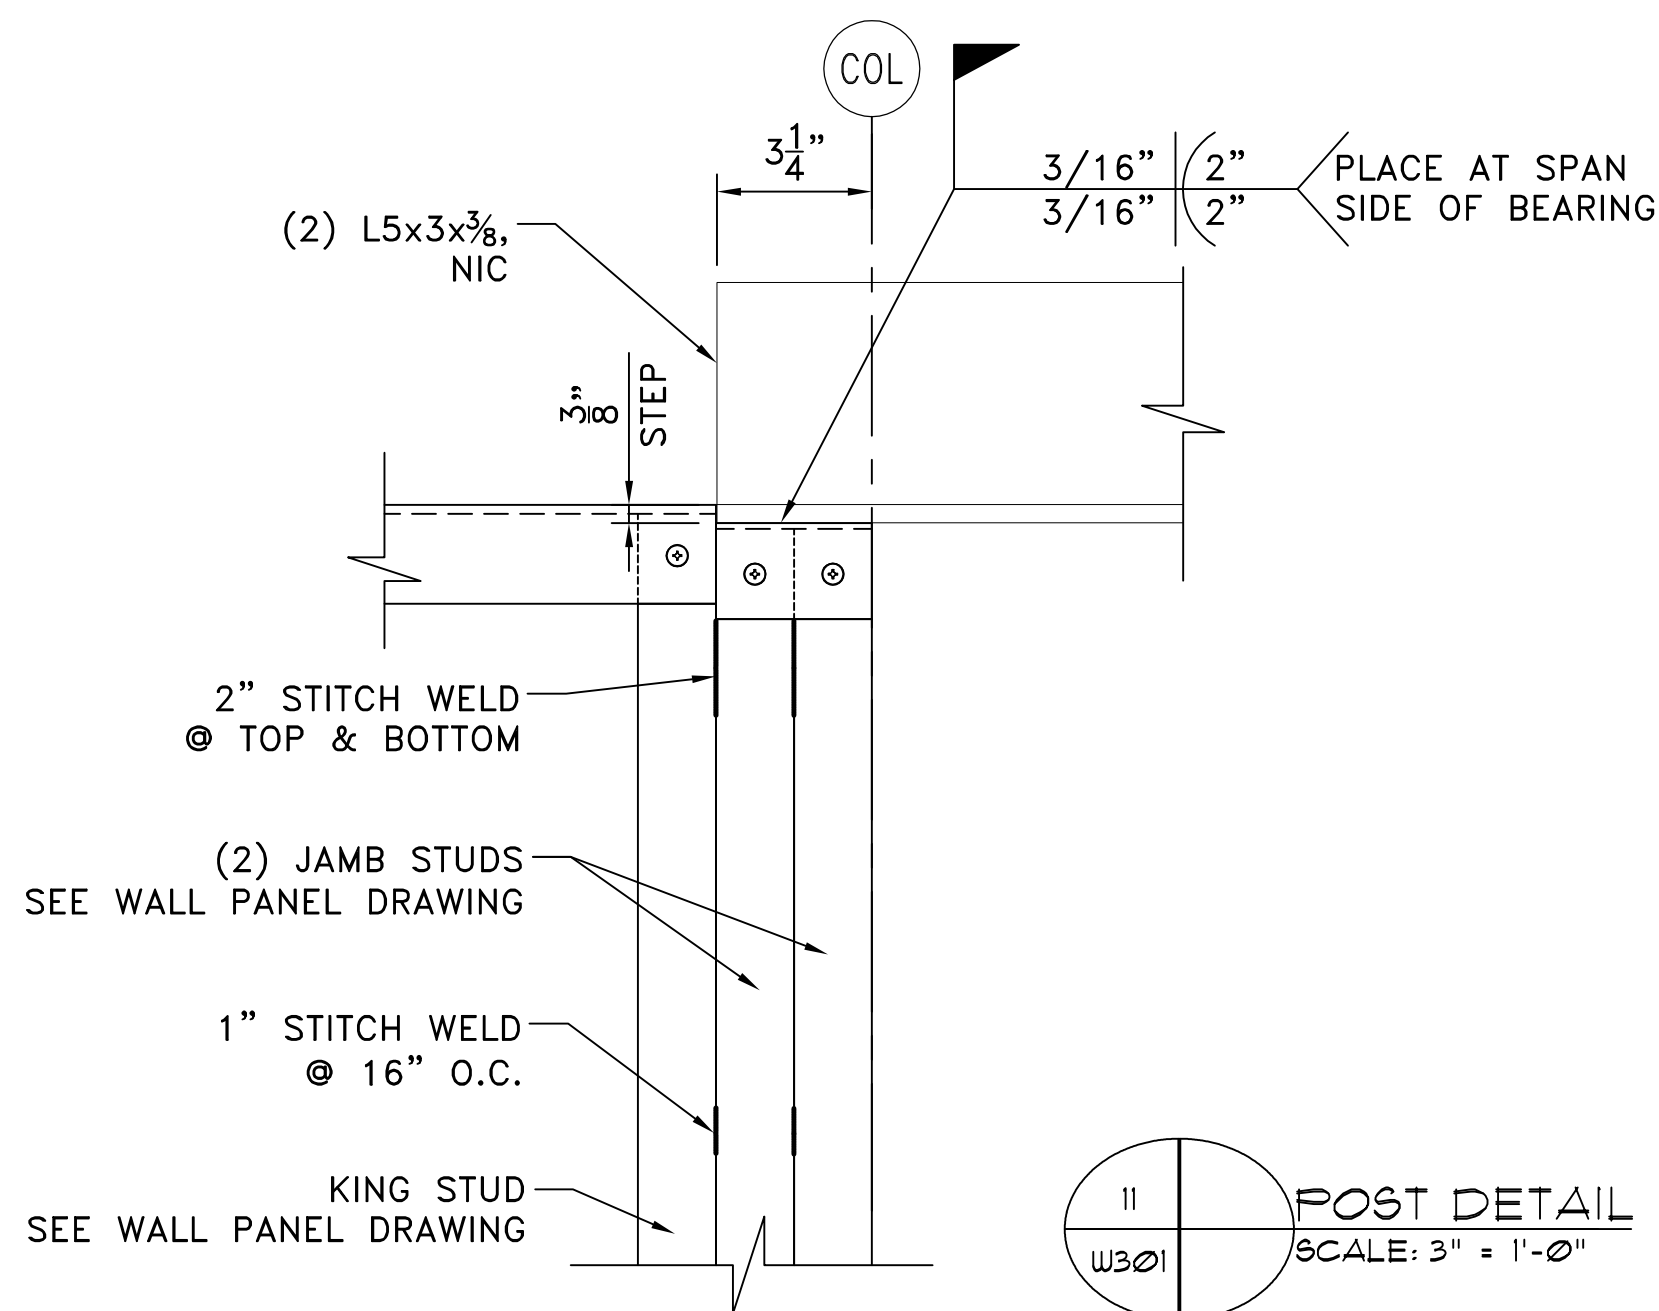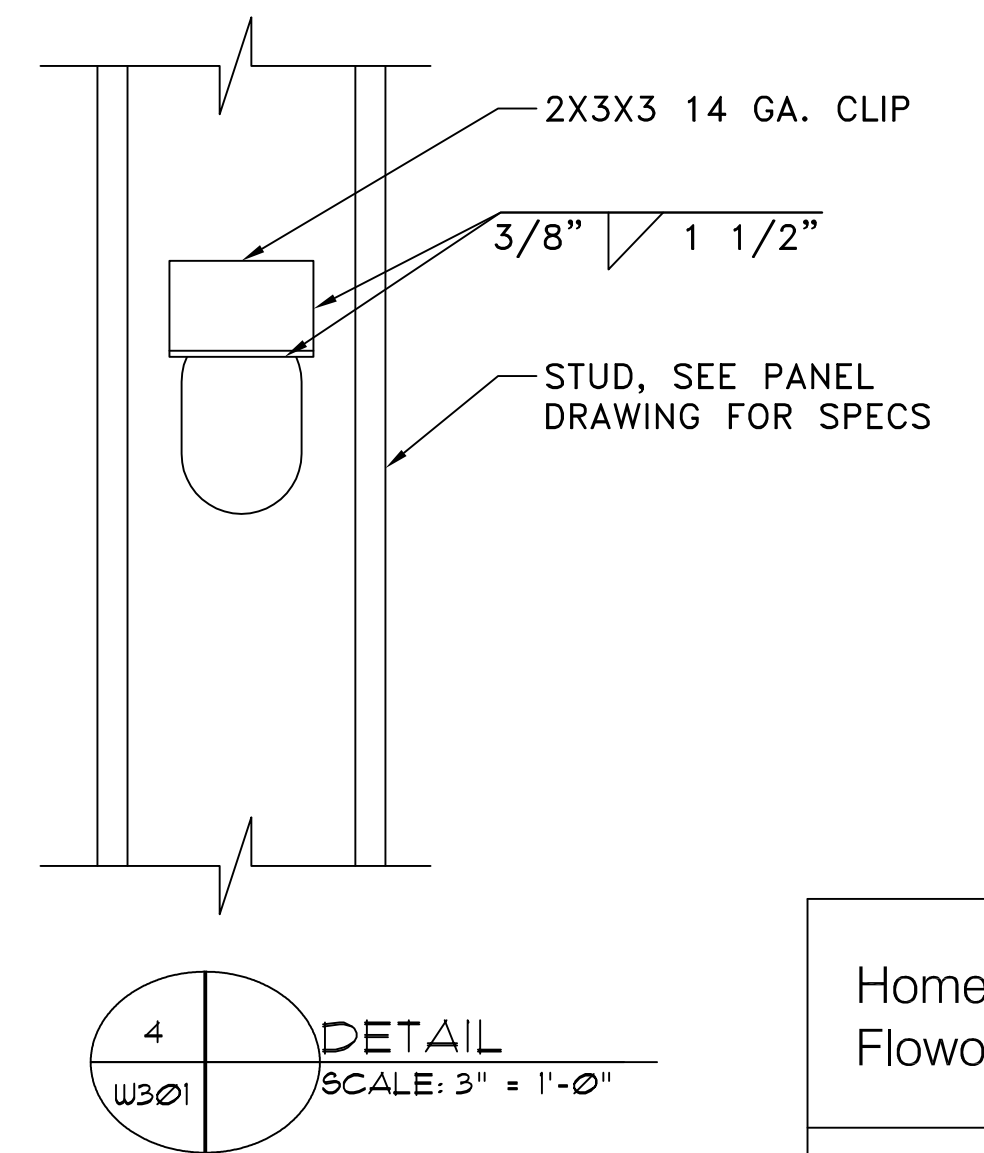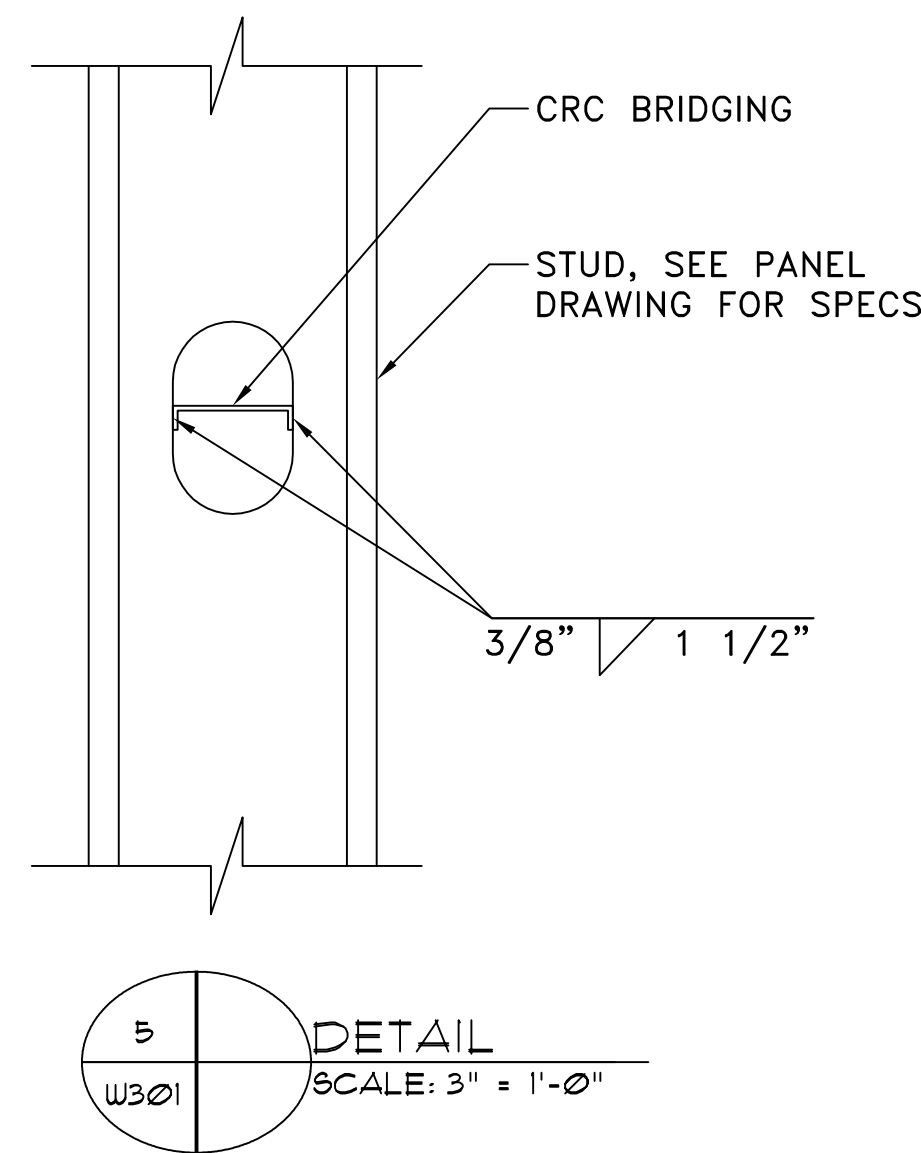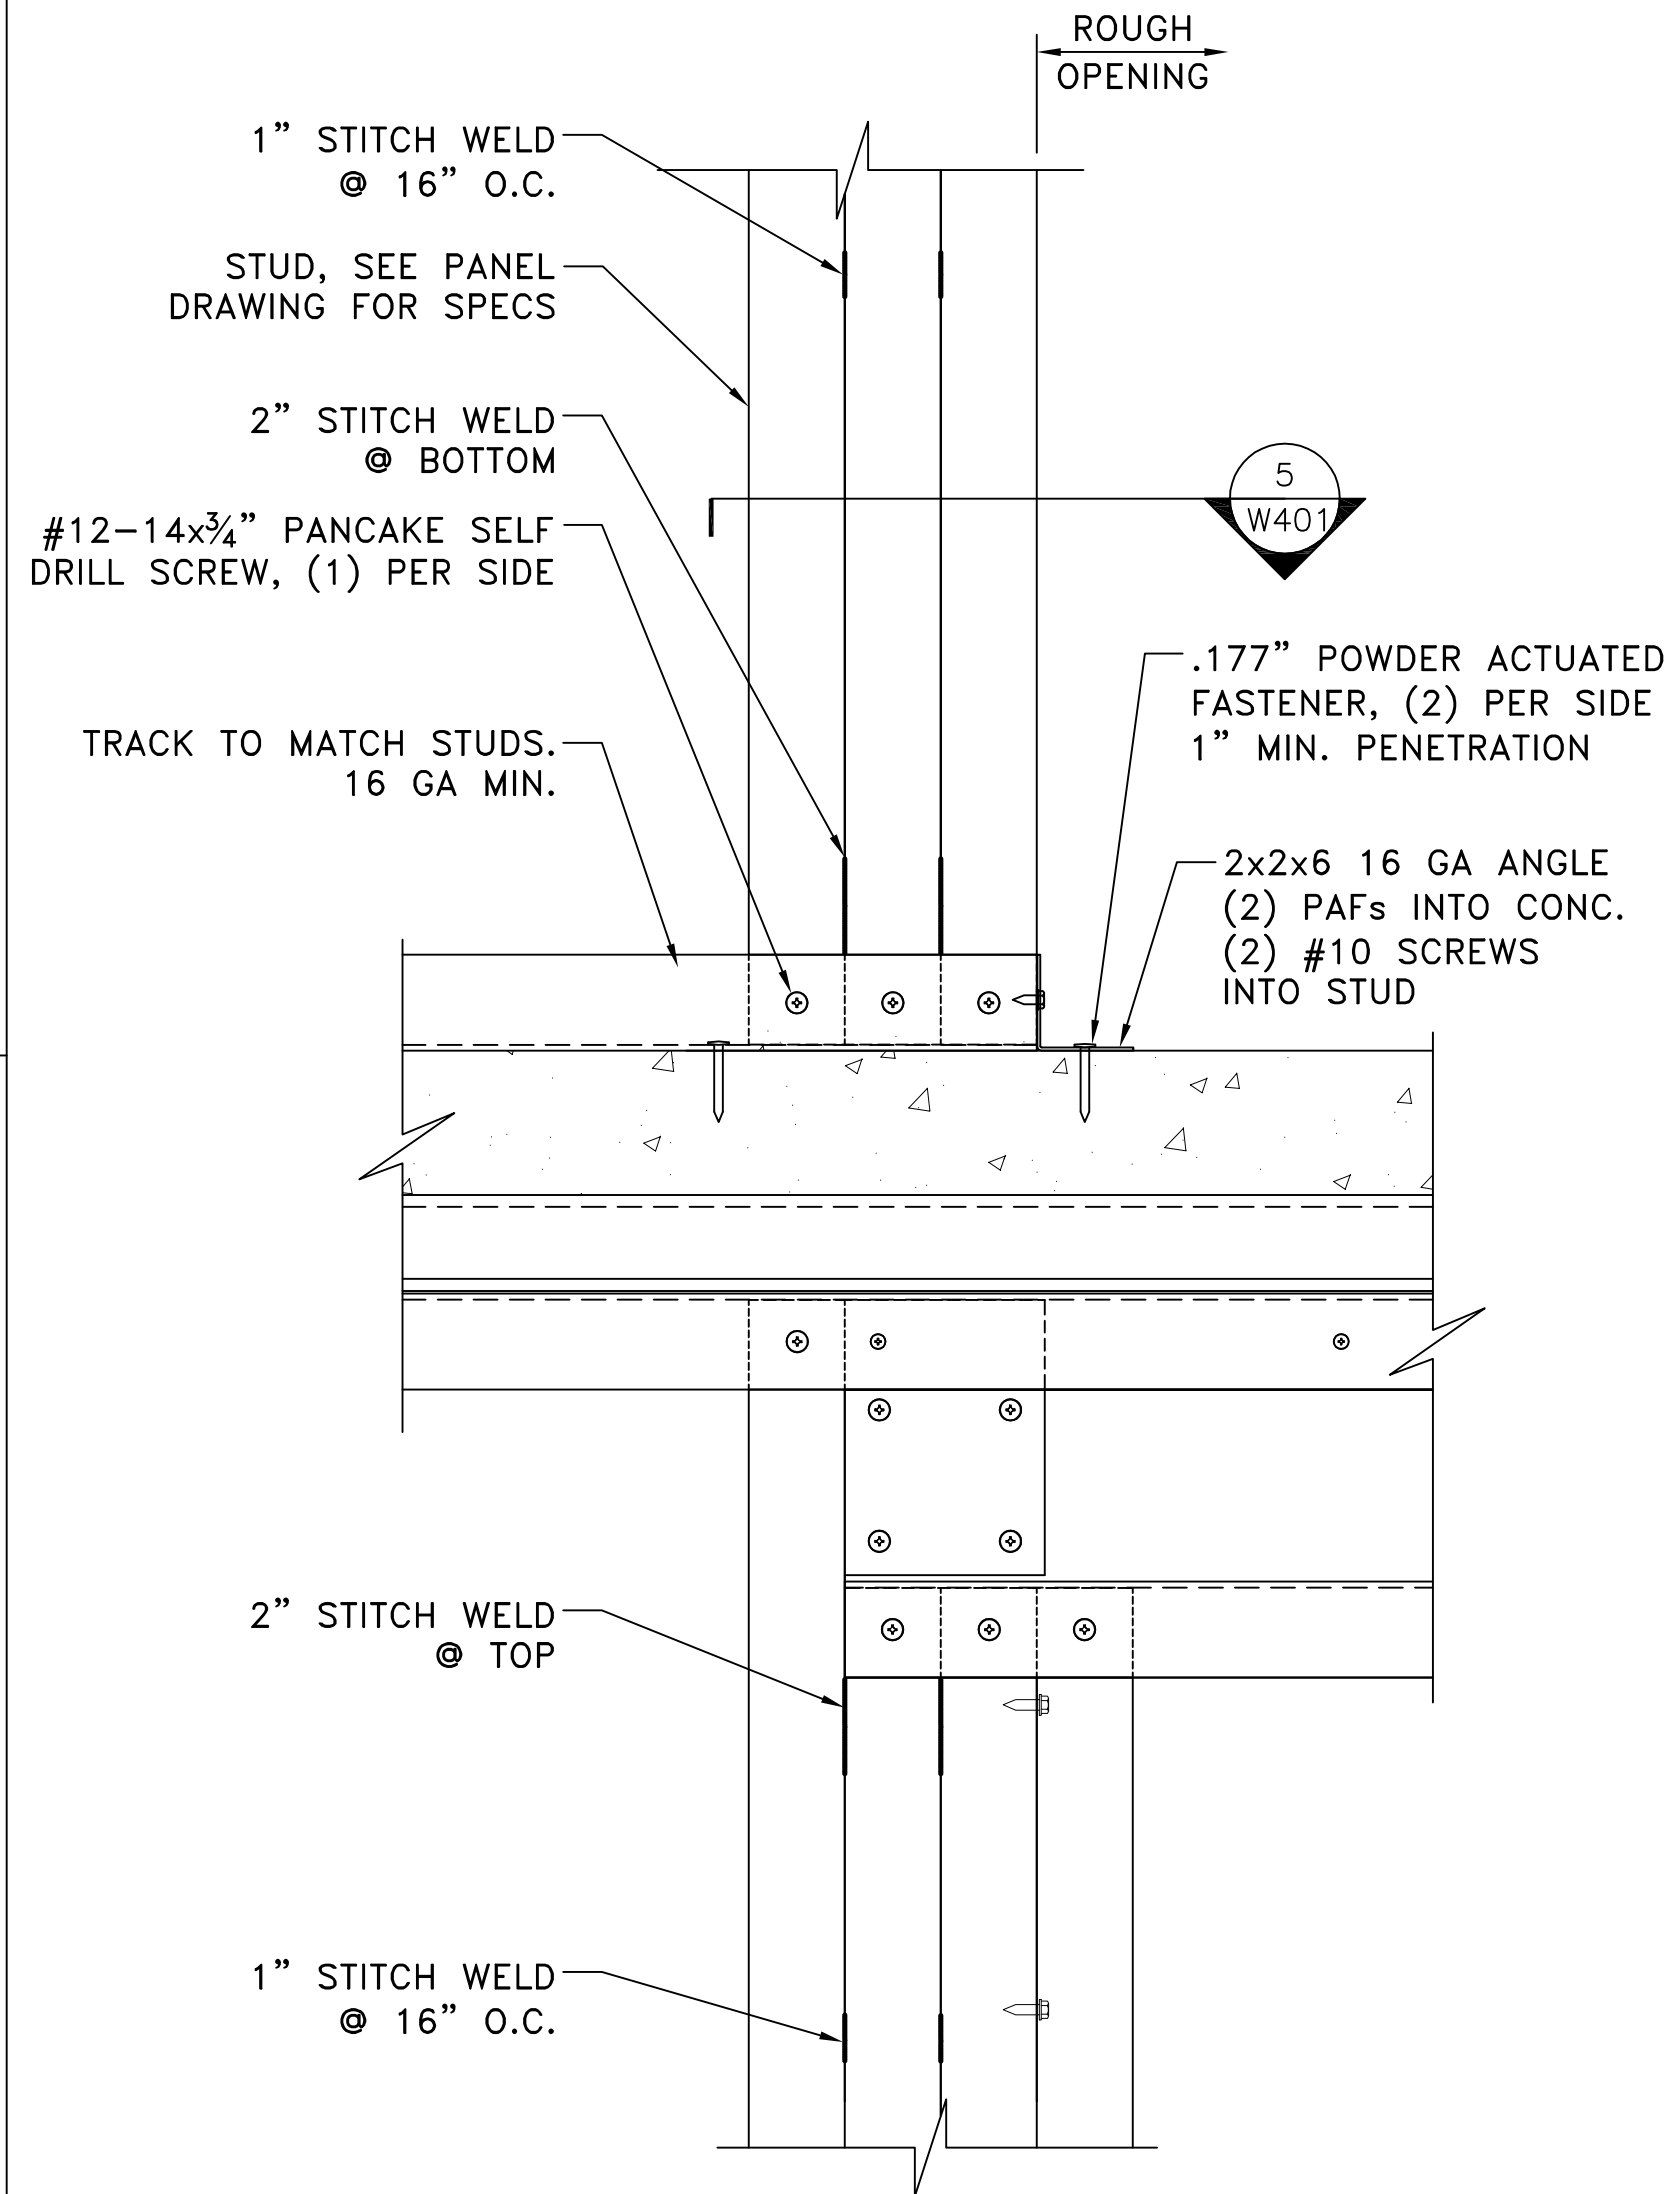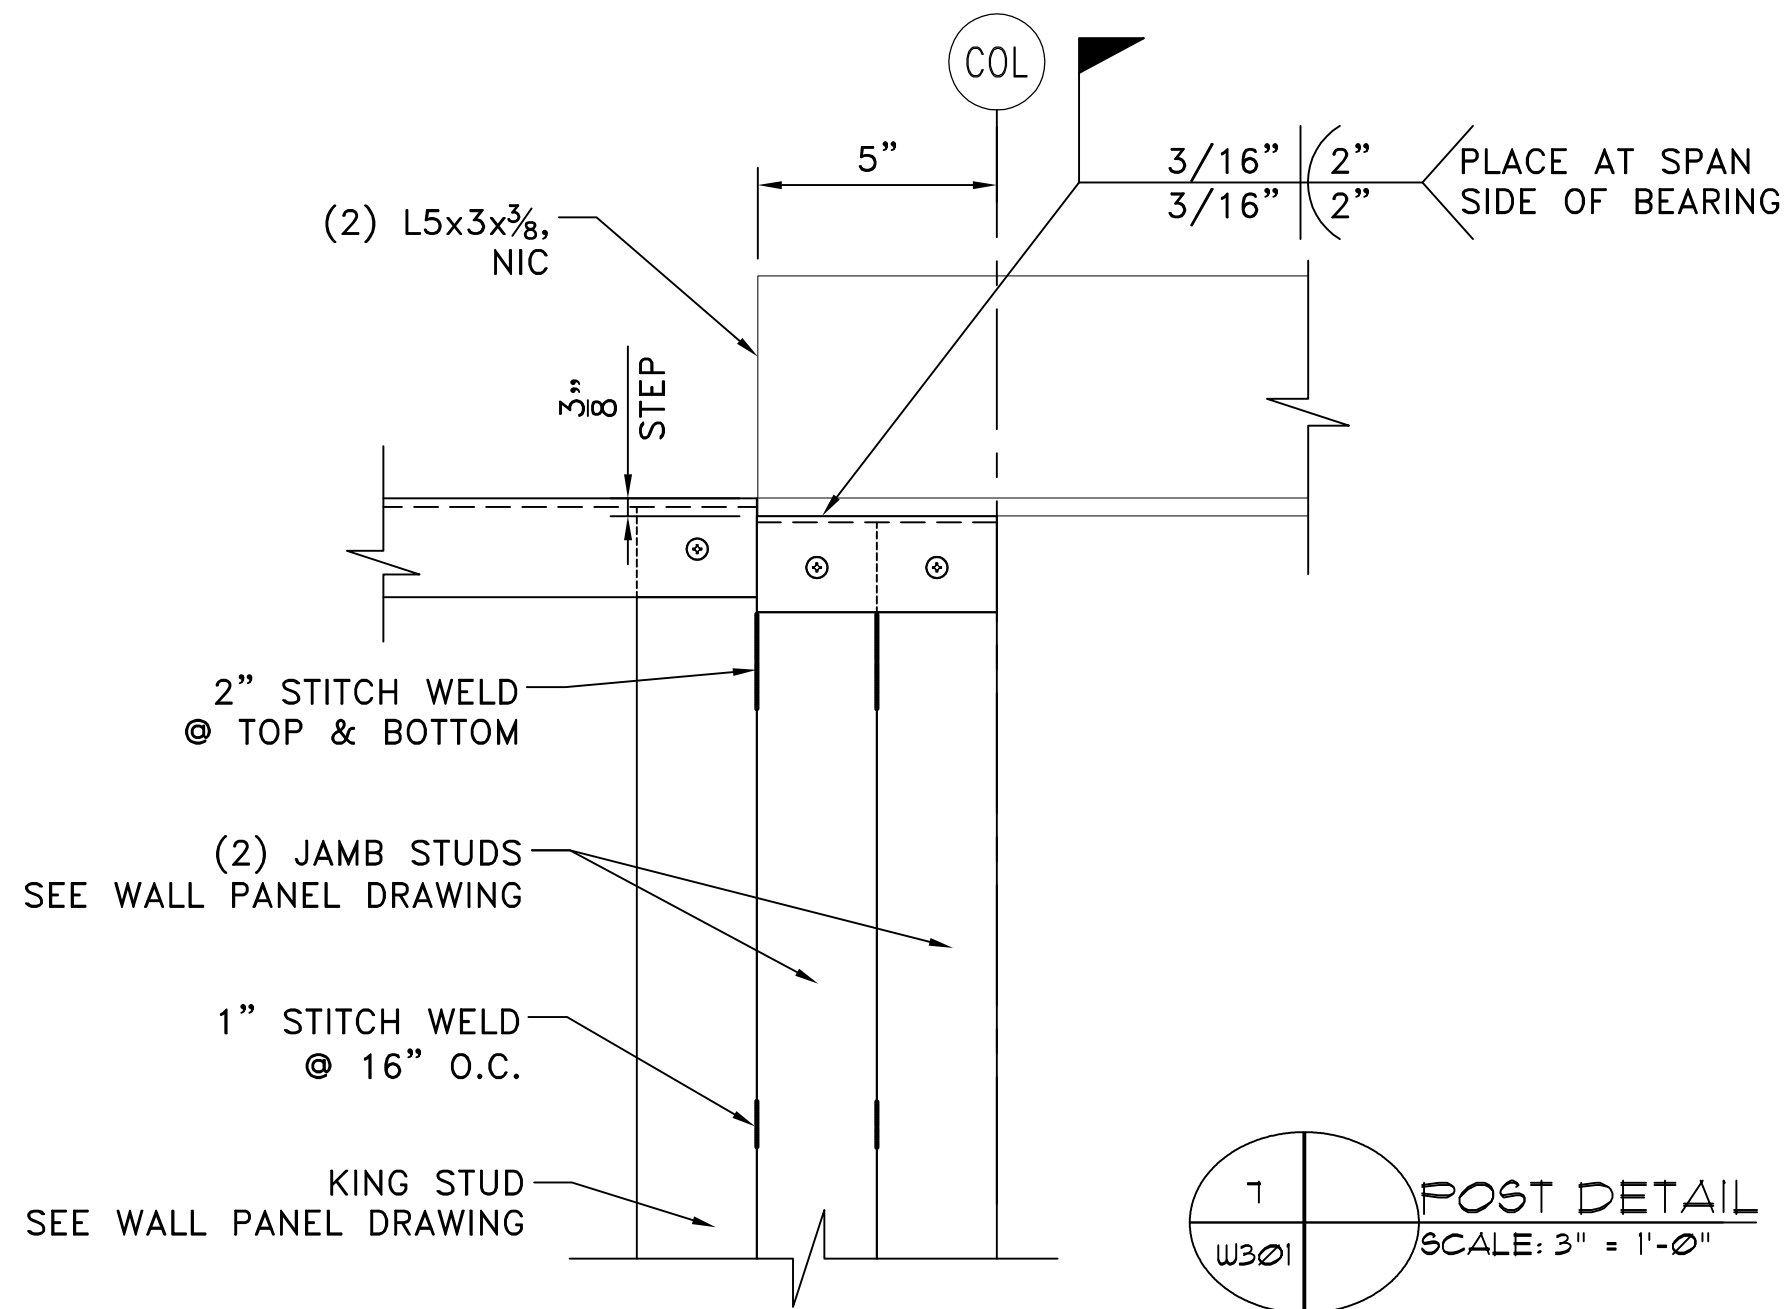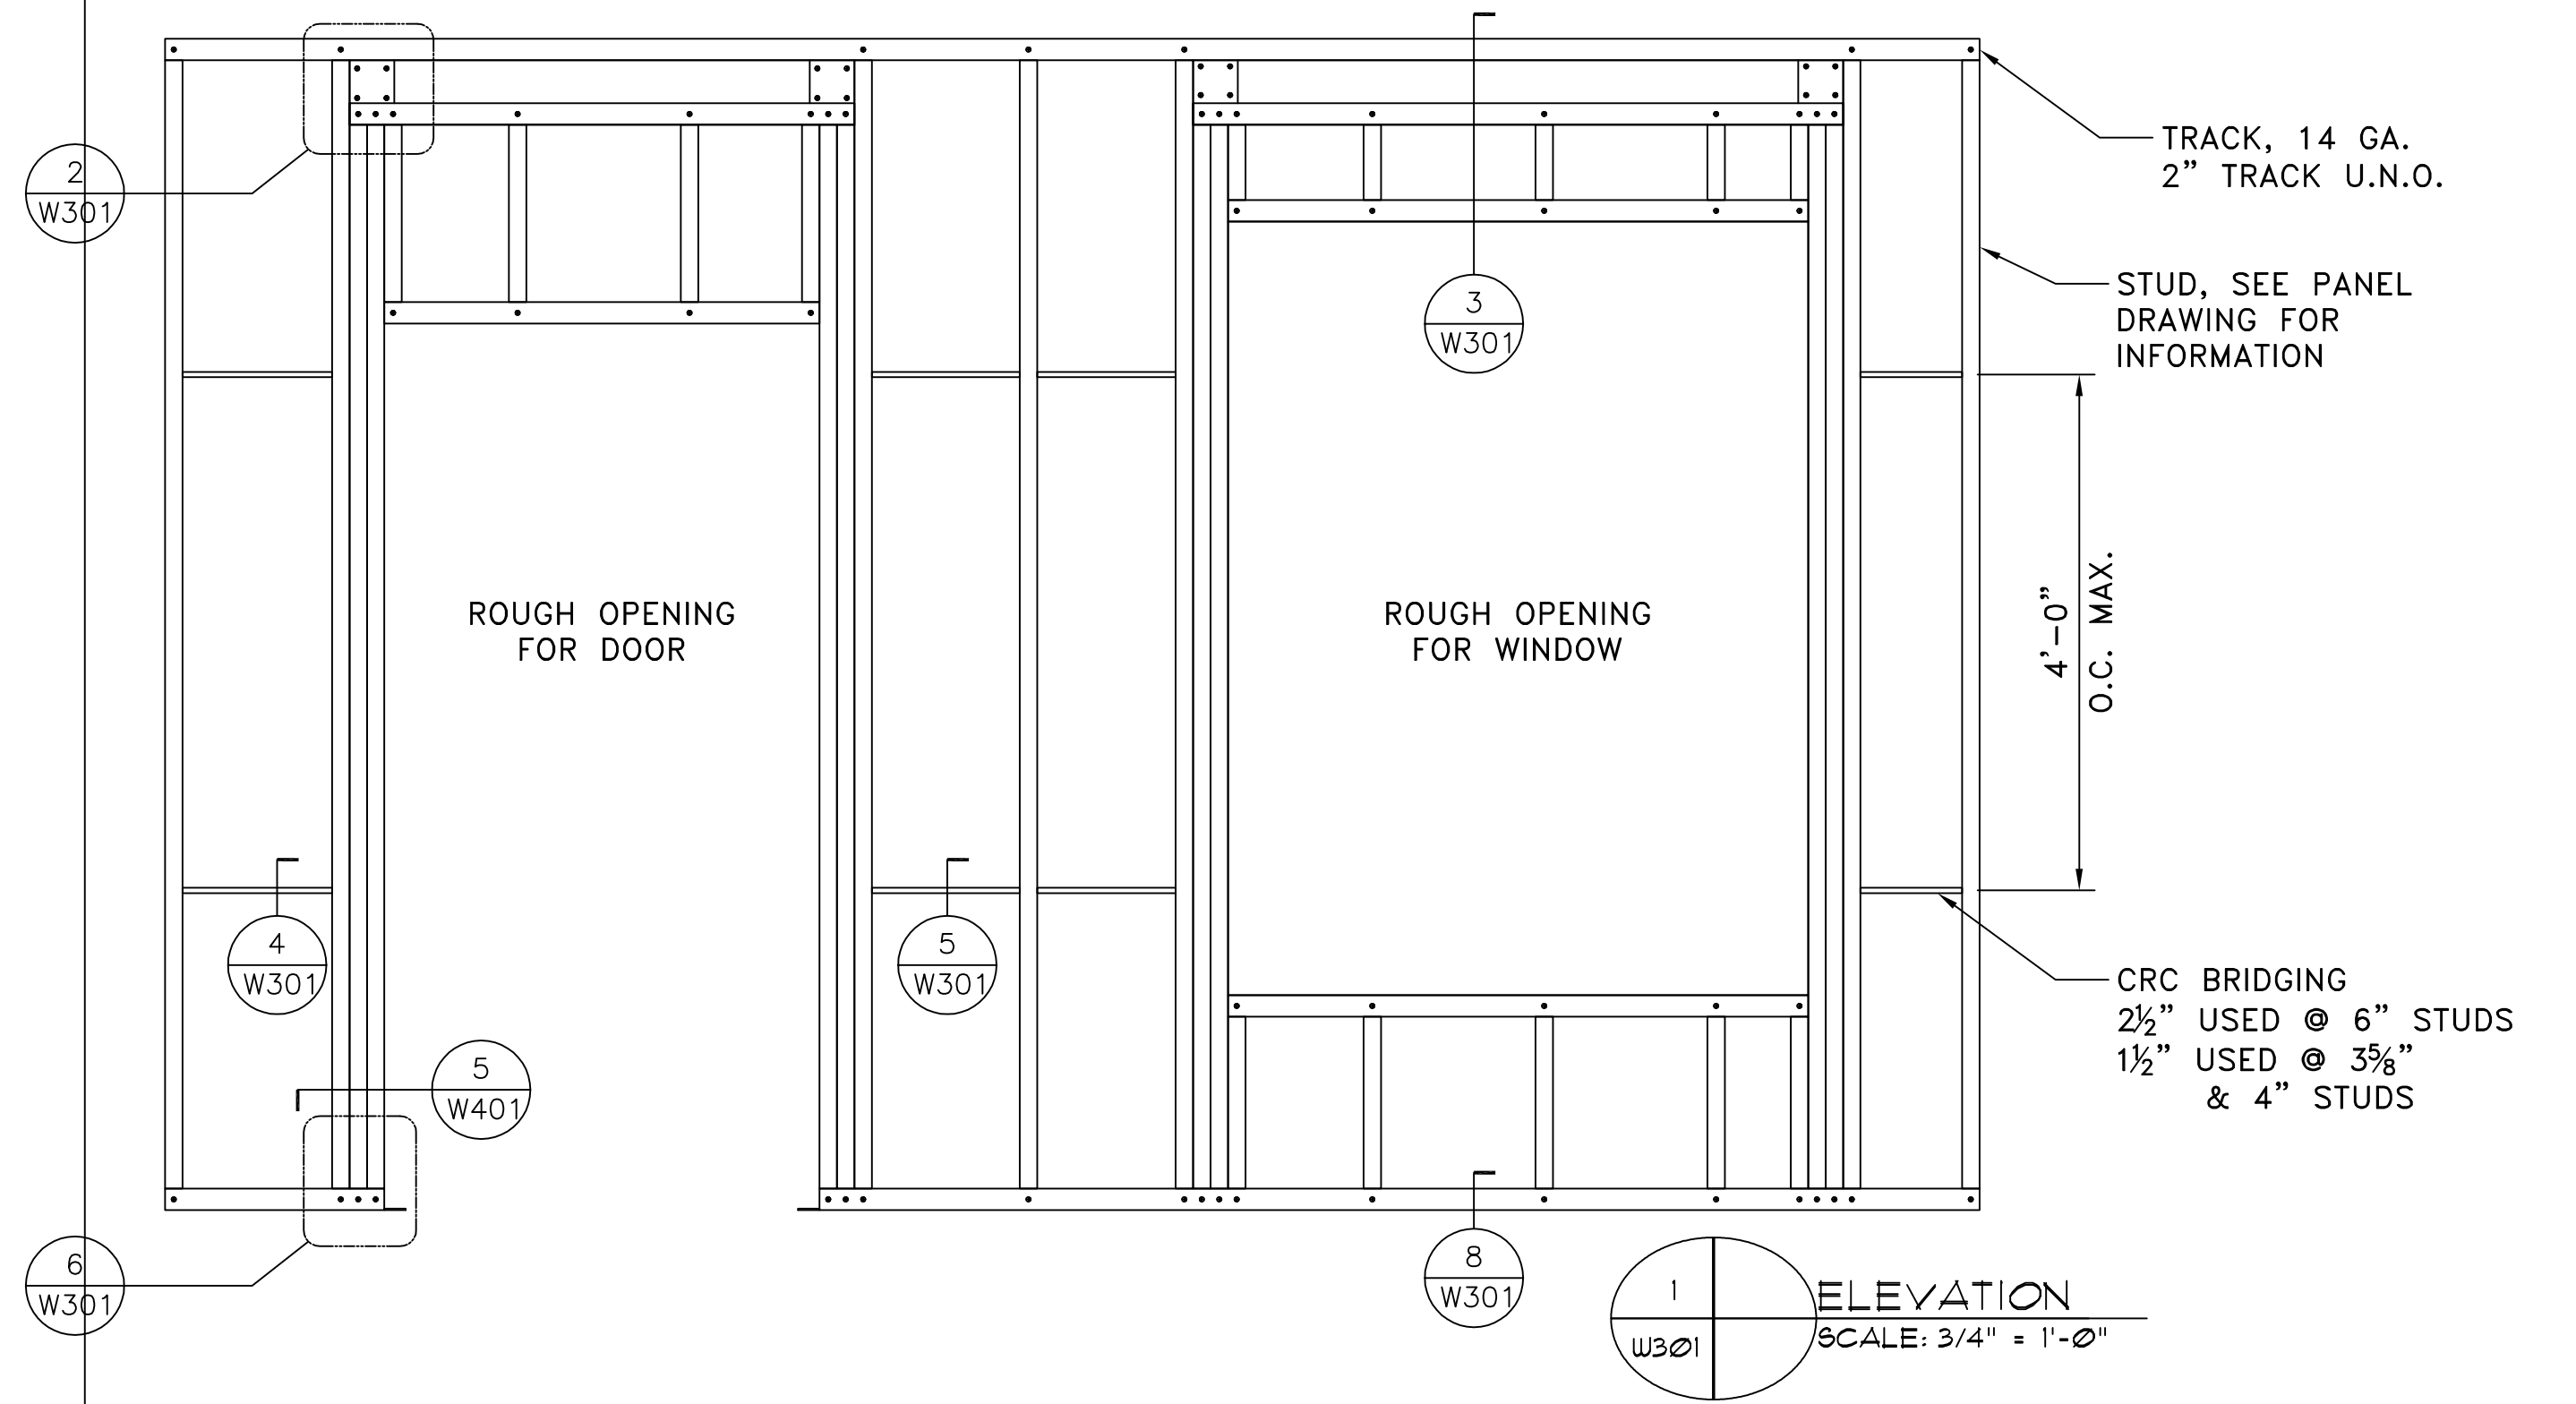

Home2 Suites
Flowood, MS

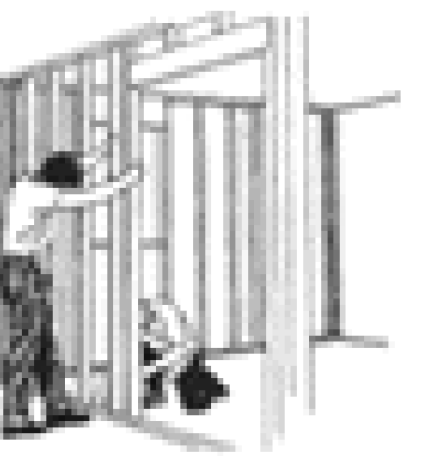












PANELIZERS, LLC
7695 HWY 161
WALLS, MS 38680
PHONE: (662) 936-5260
FAX: (662) 936-5262

Shop Drawings by:
HILLMAN ENTERPRISES, INC.
P.O. Box 106
Graham, AL 36263
PHONE: (256) 449-9261

Sheet Number:
W301

Job Number:
1605/1655

 Date:
01/26/17

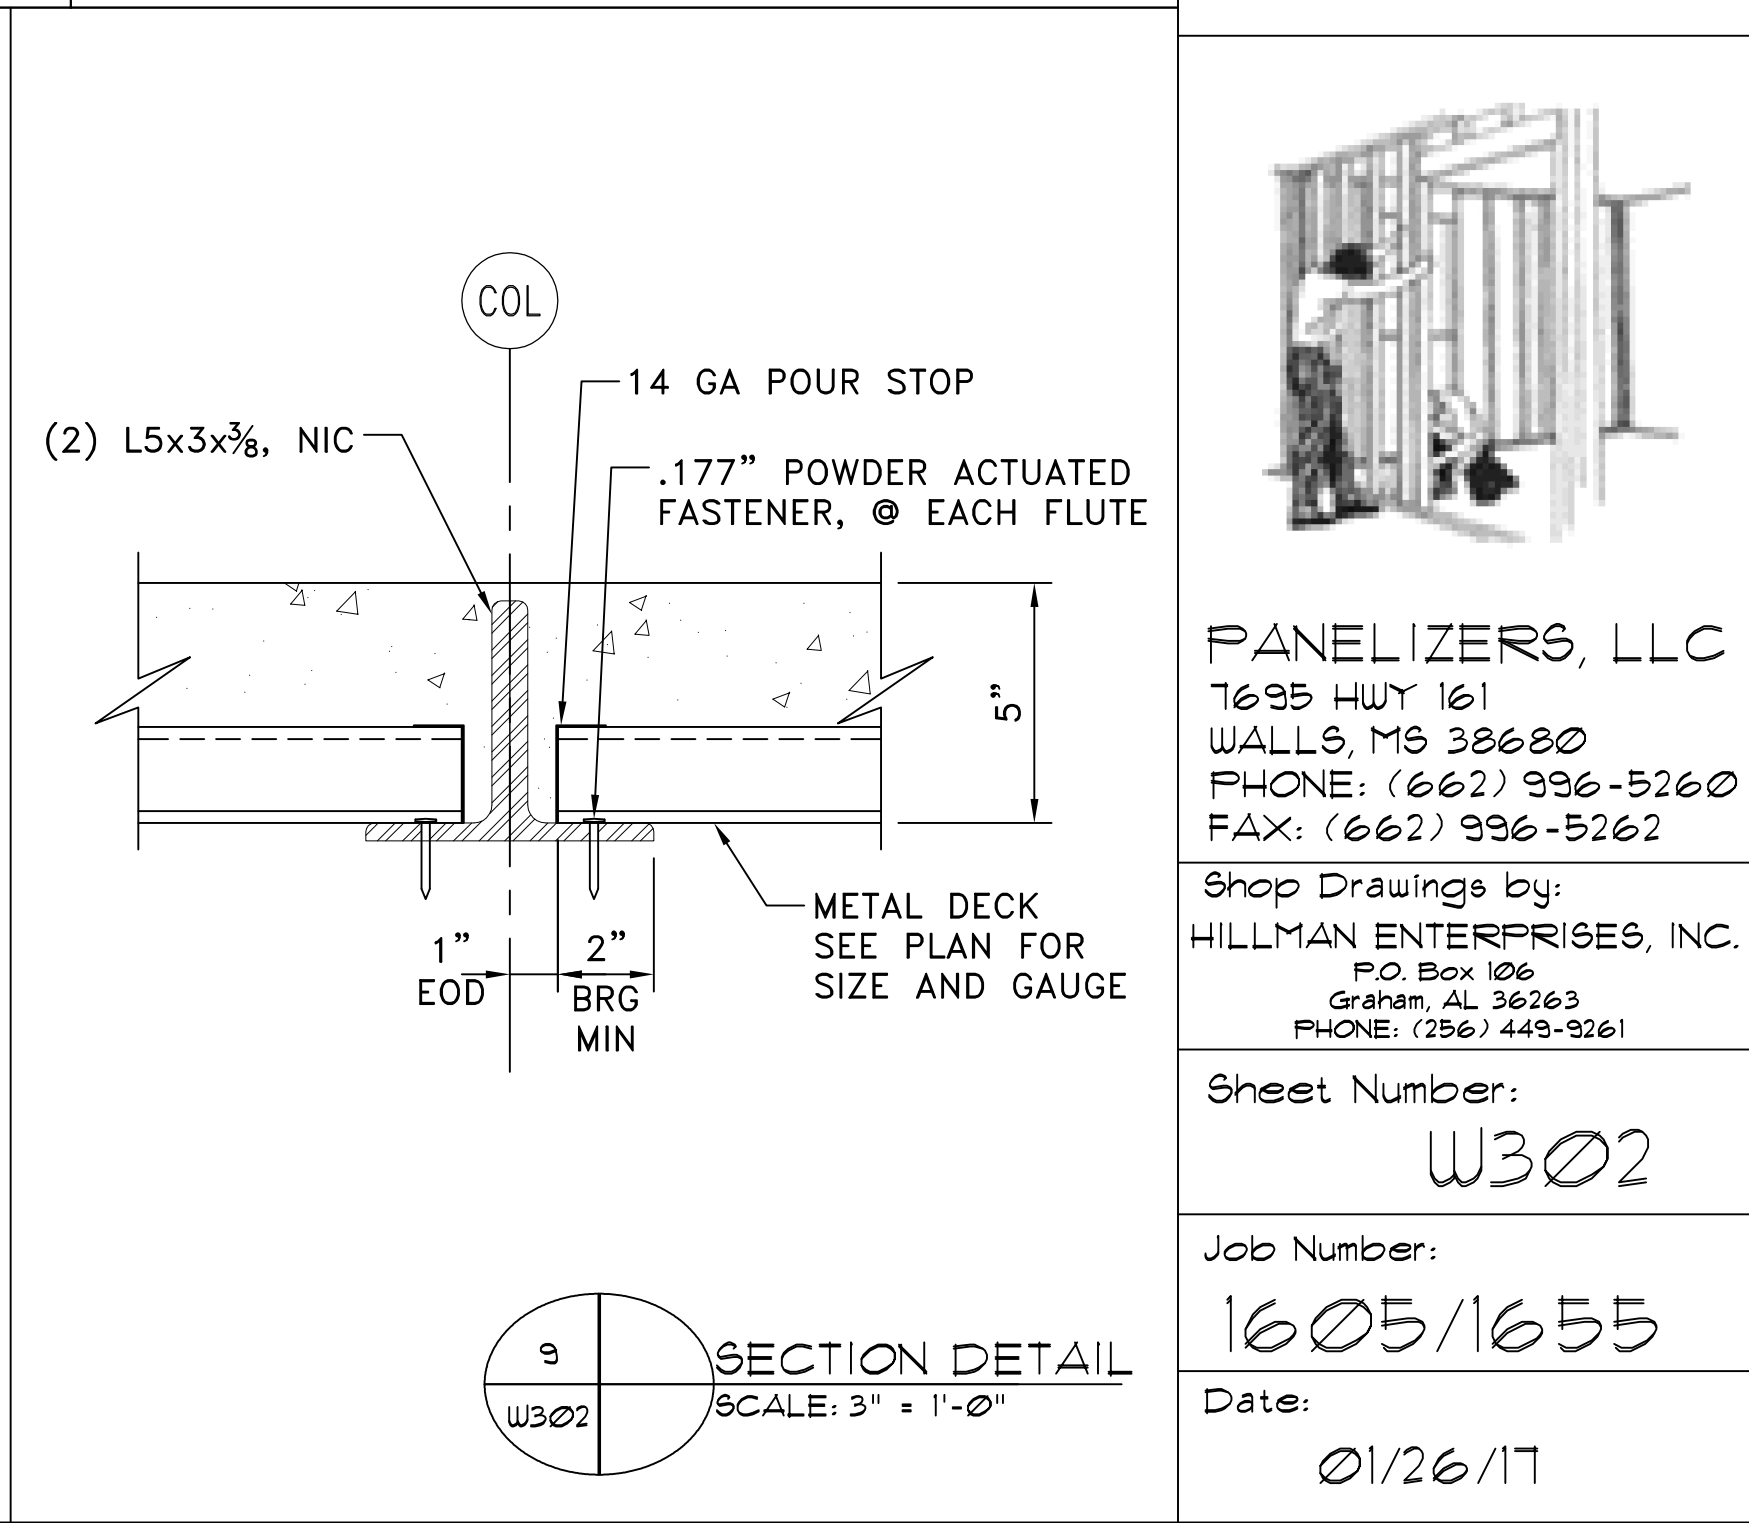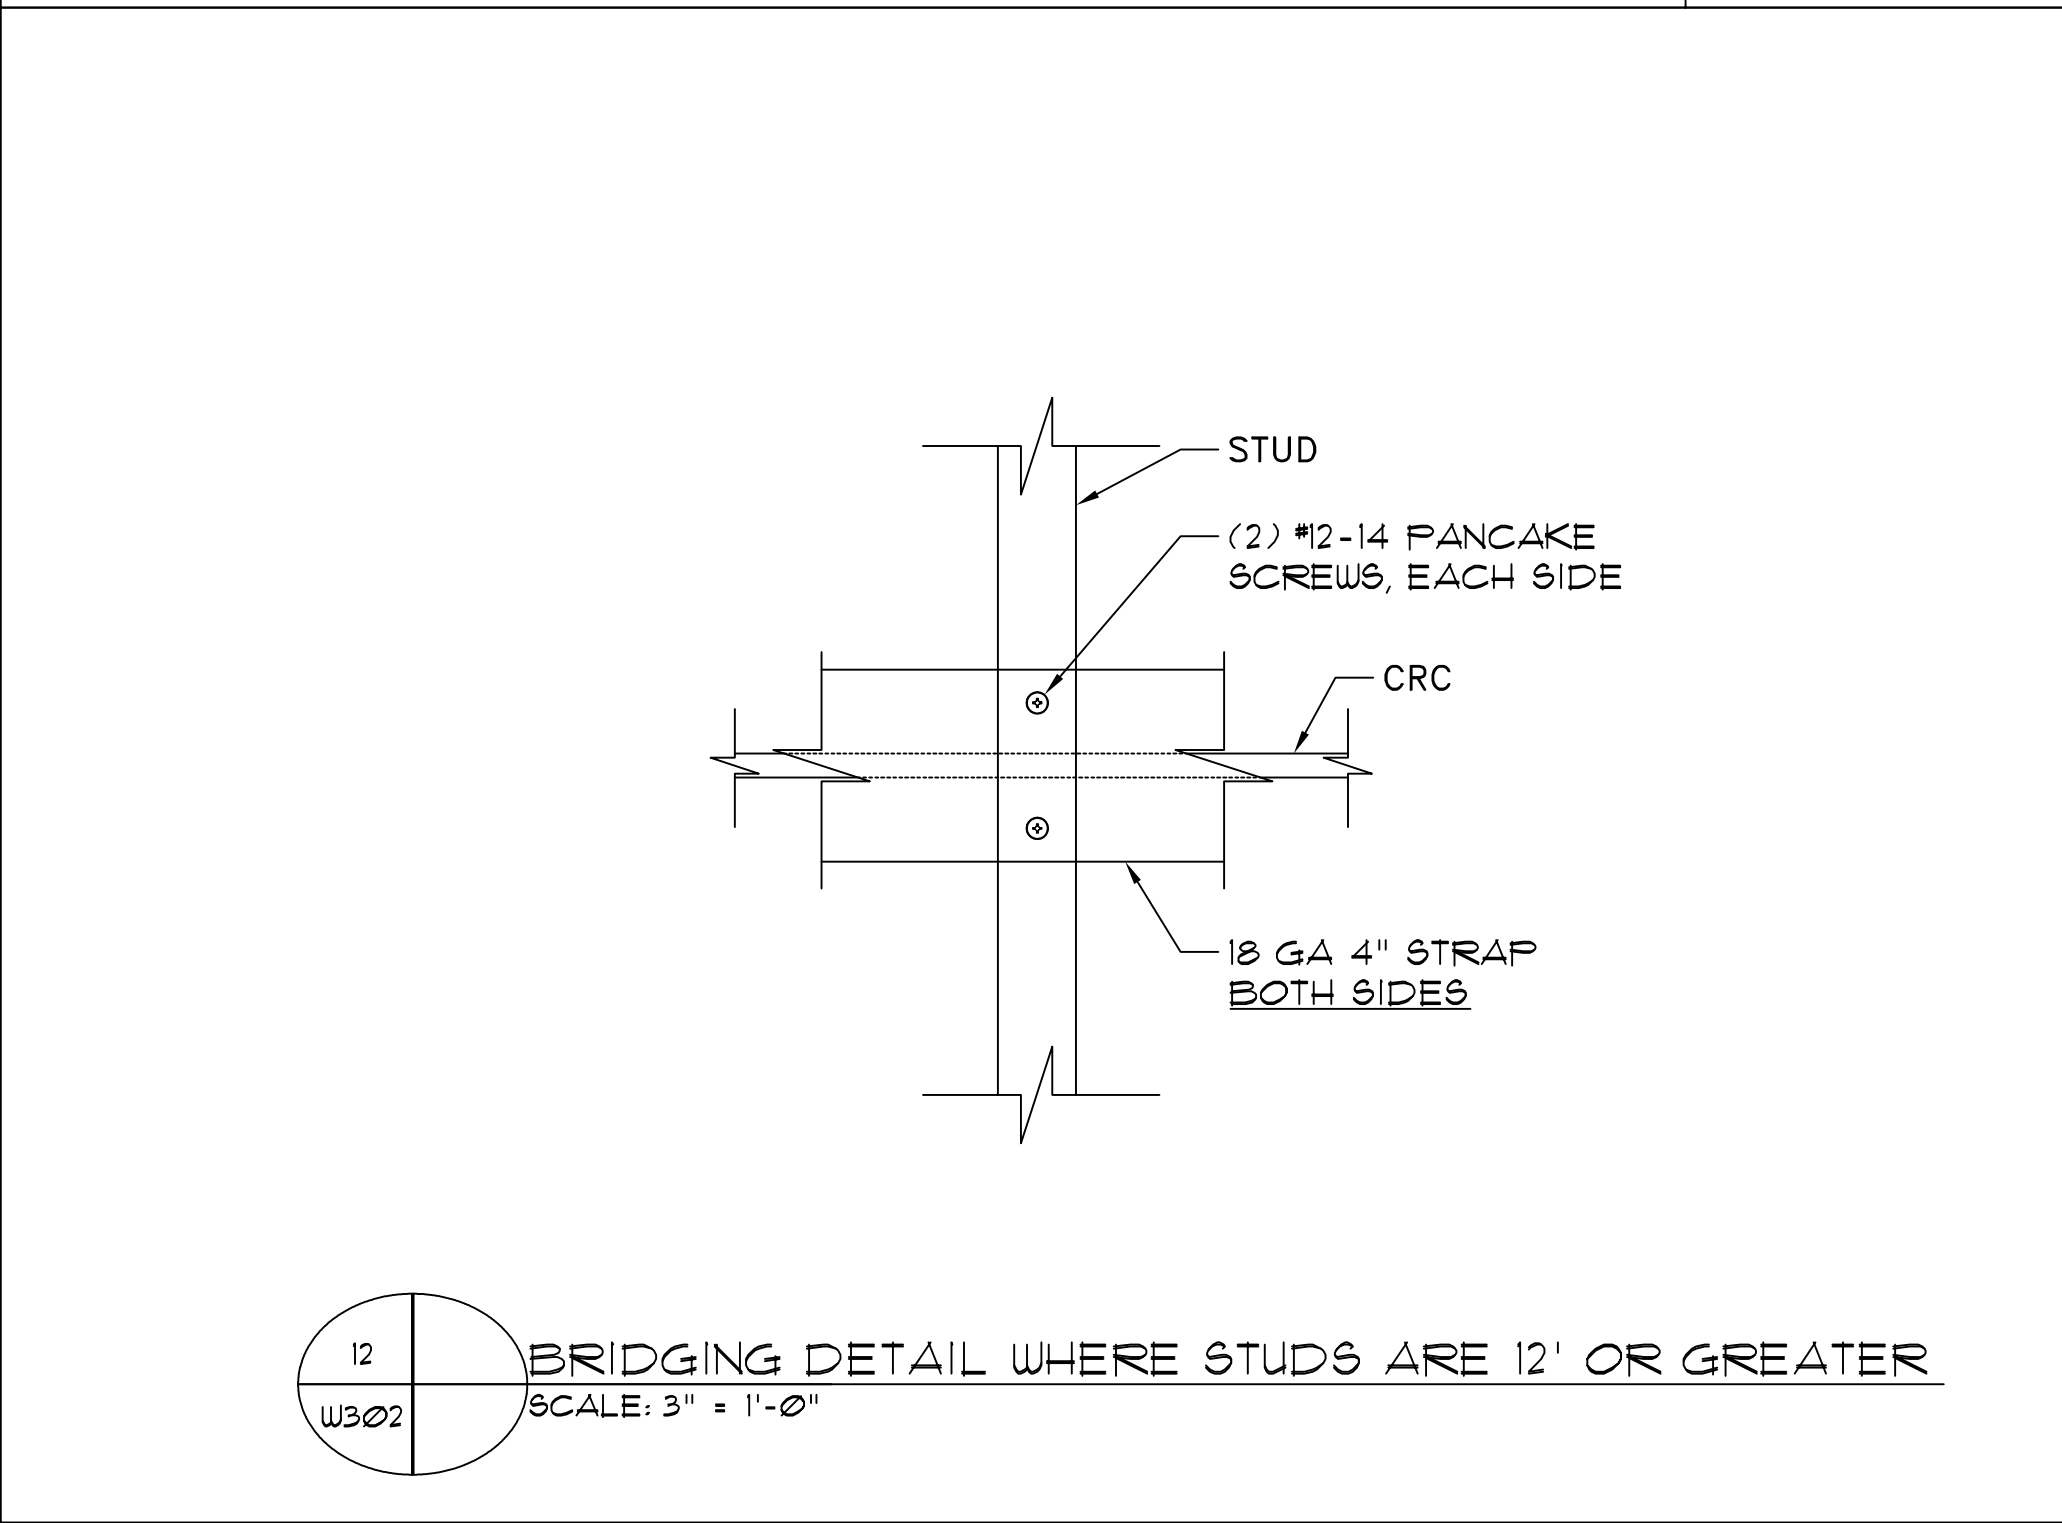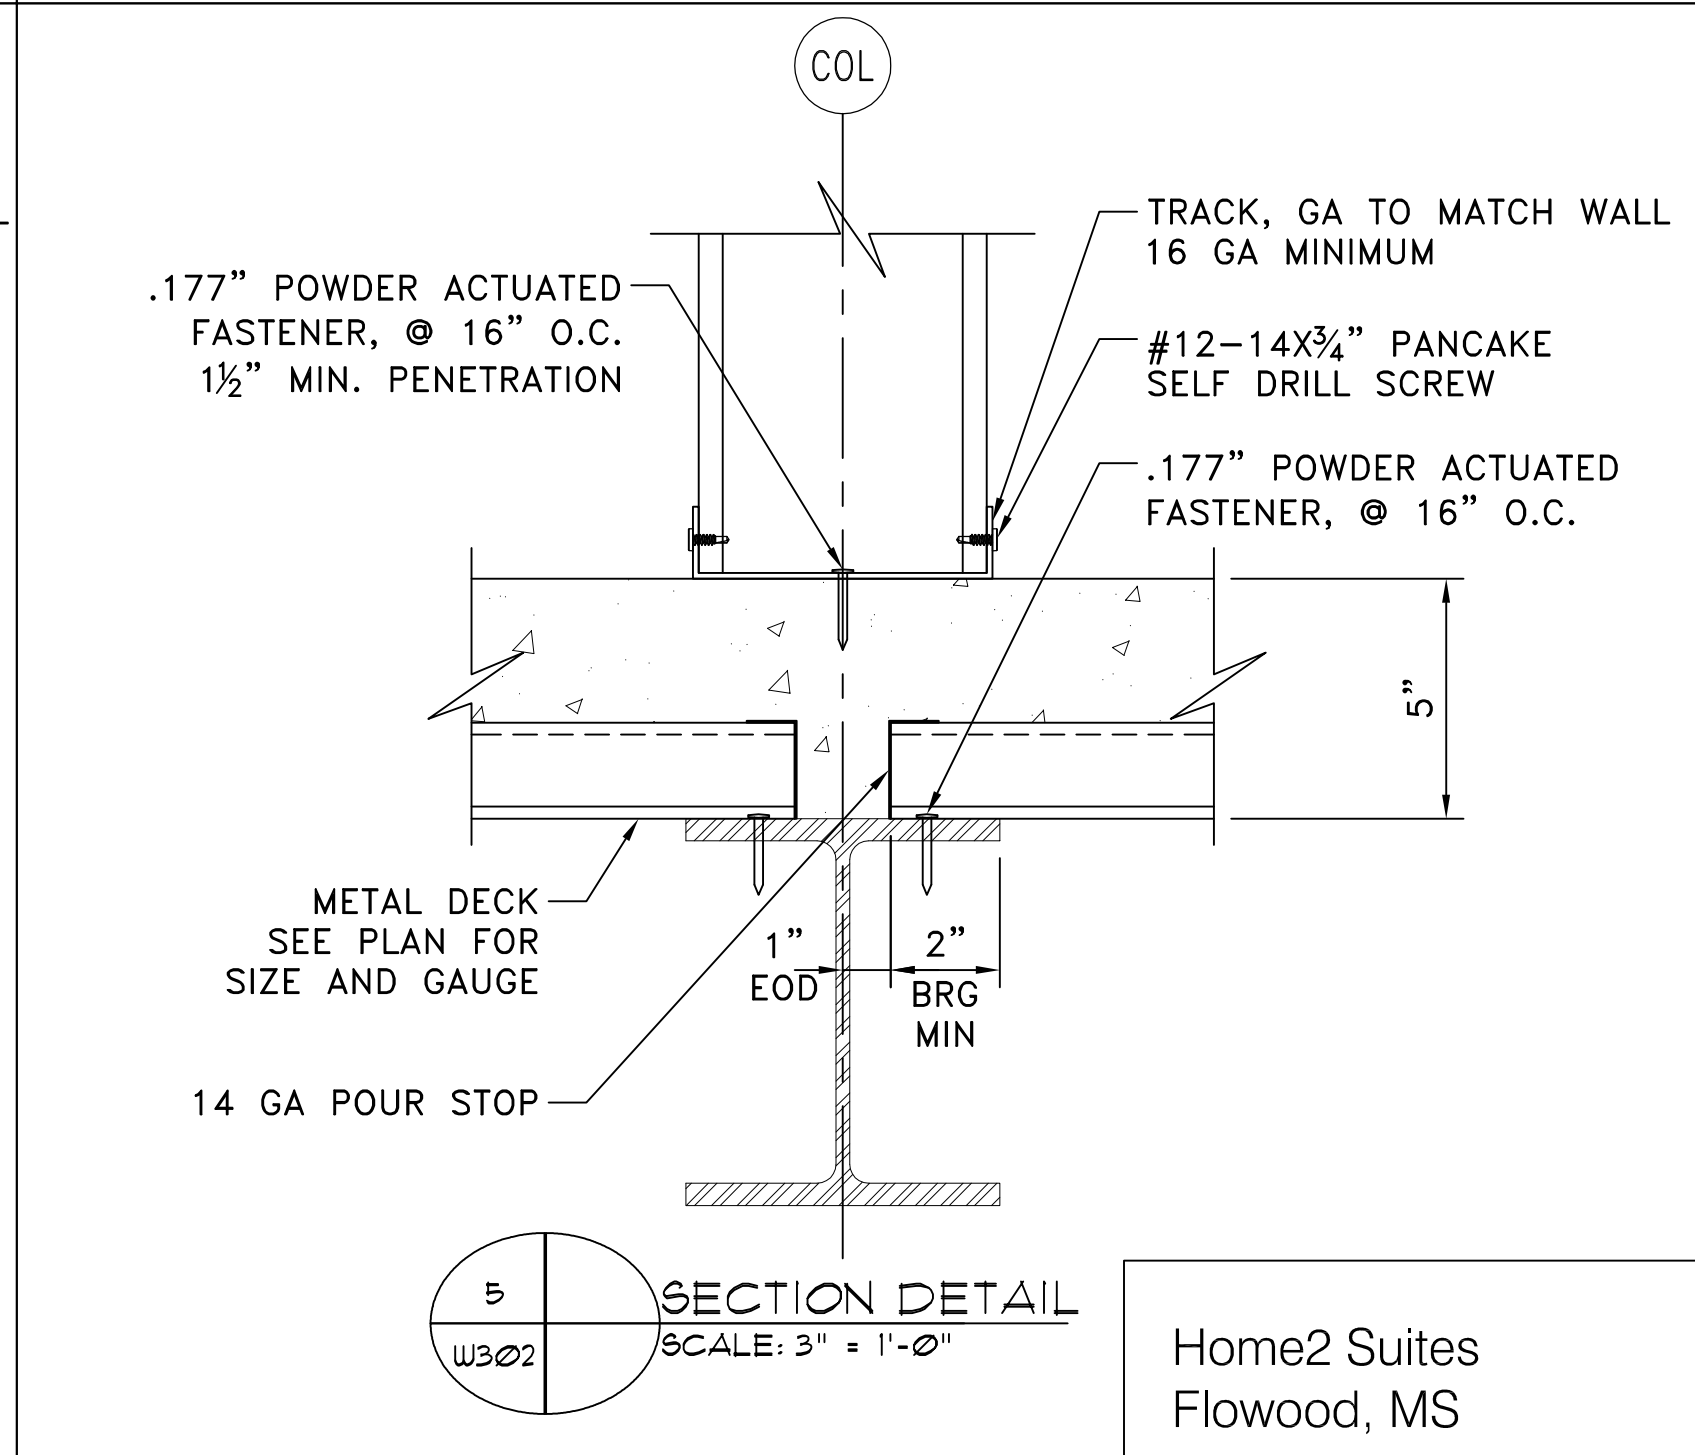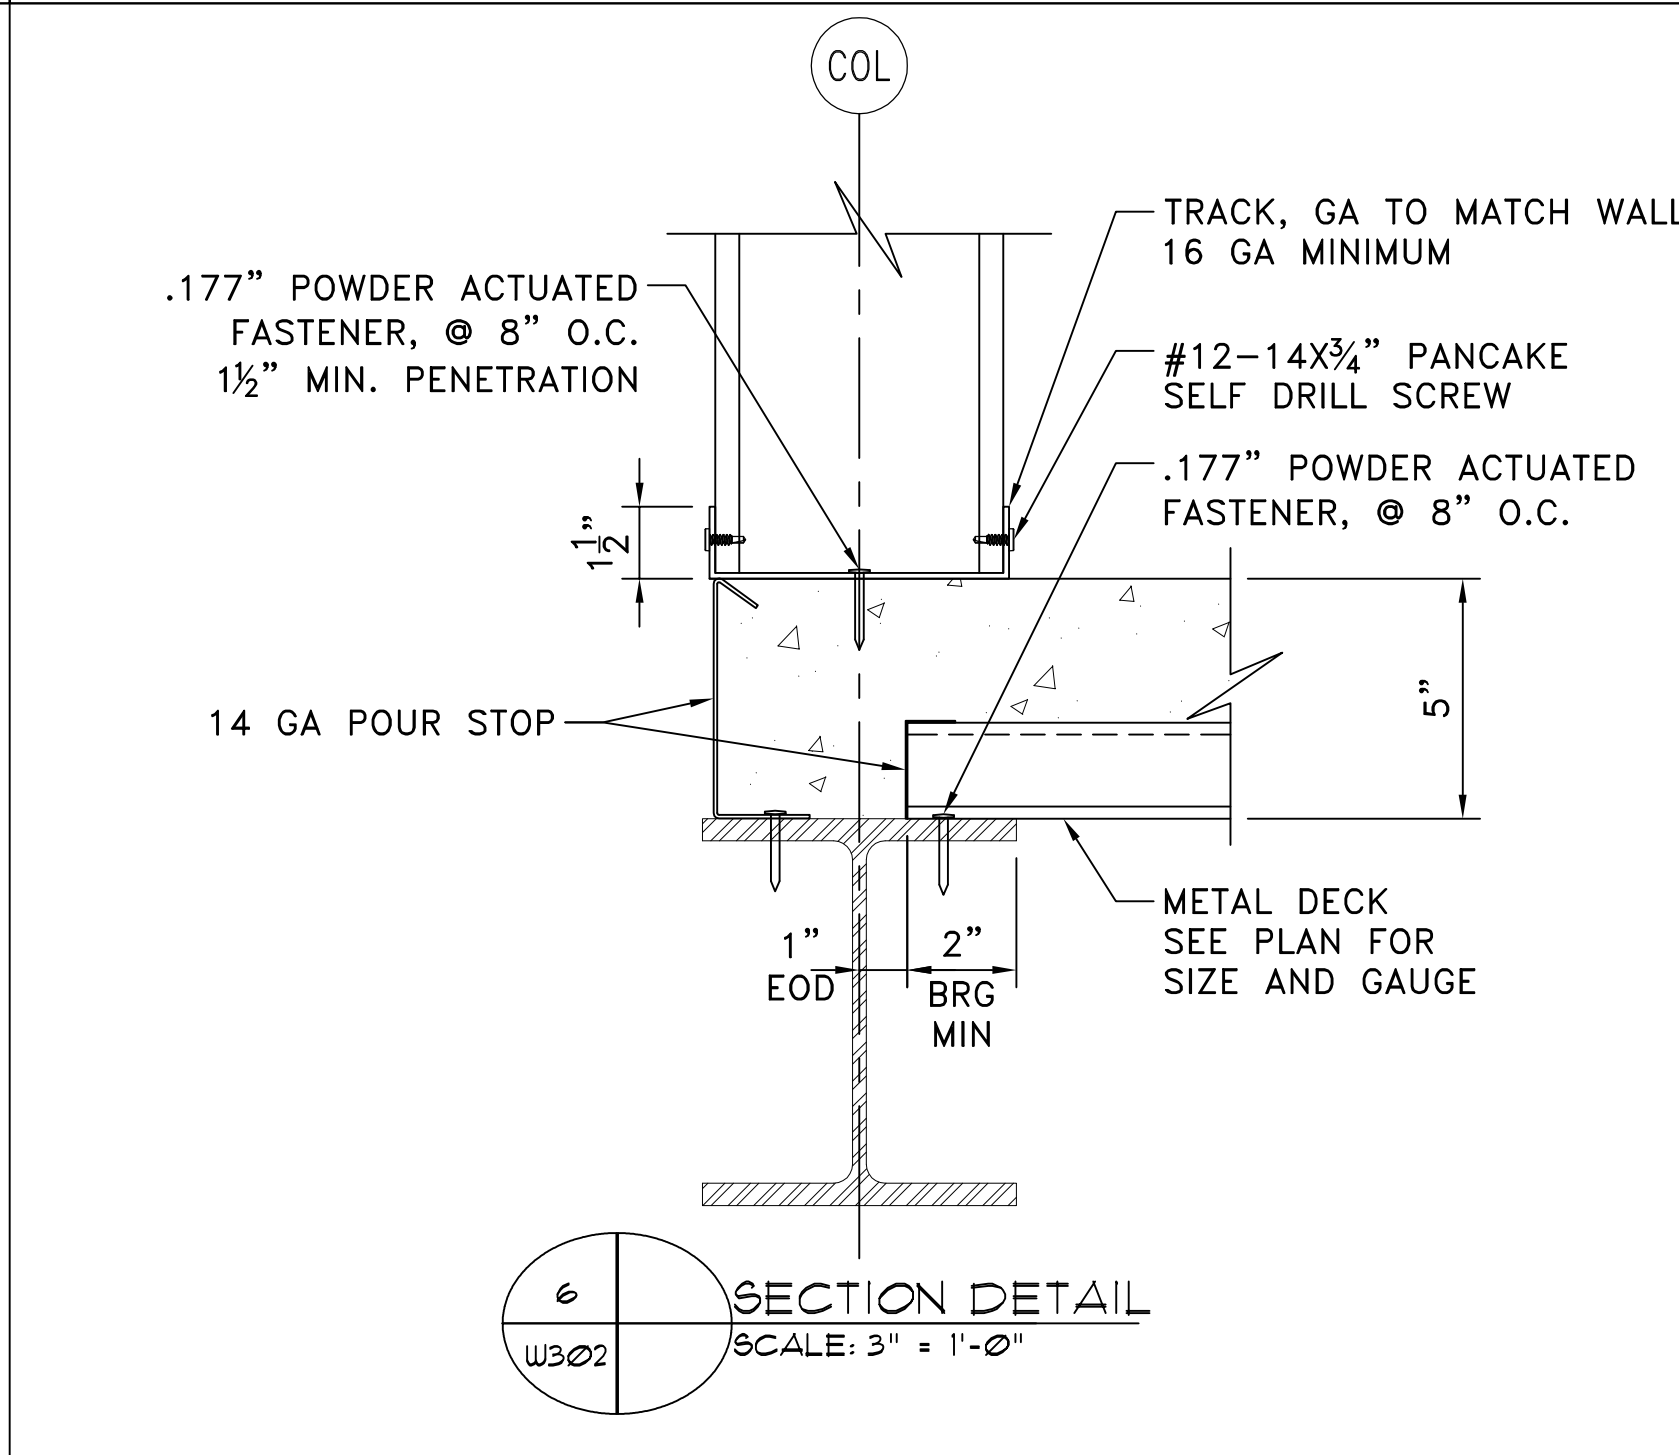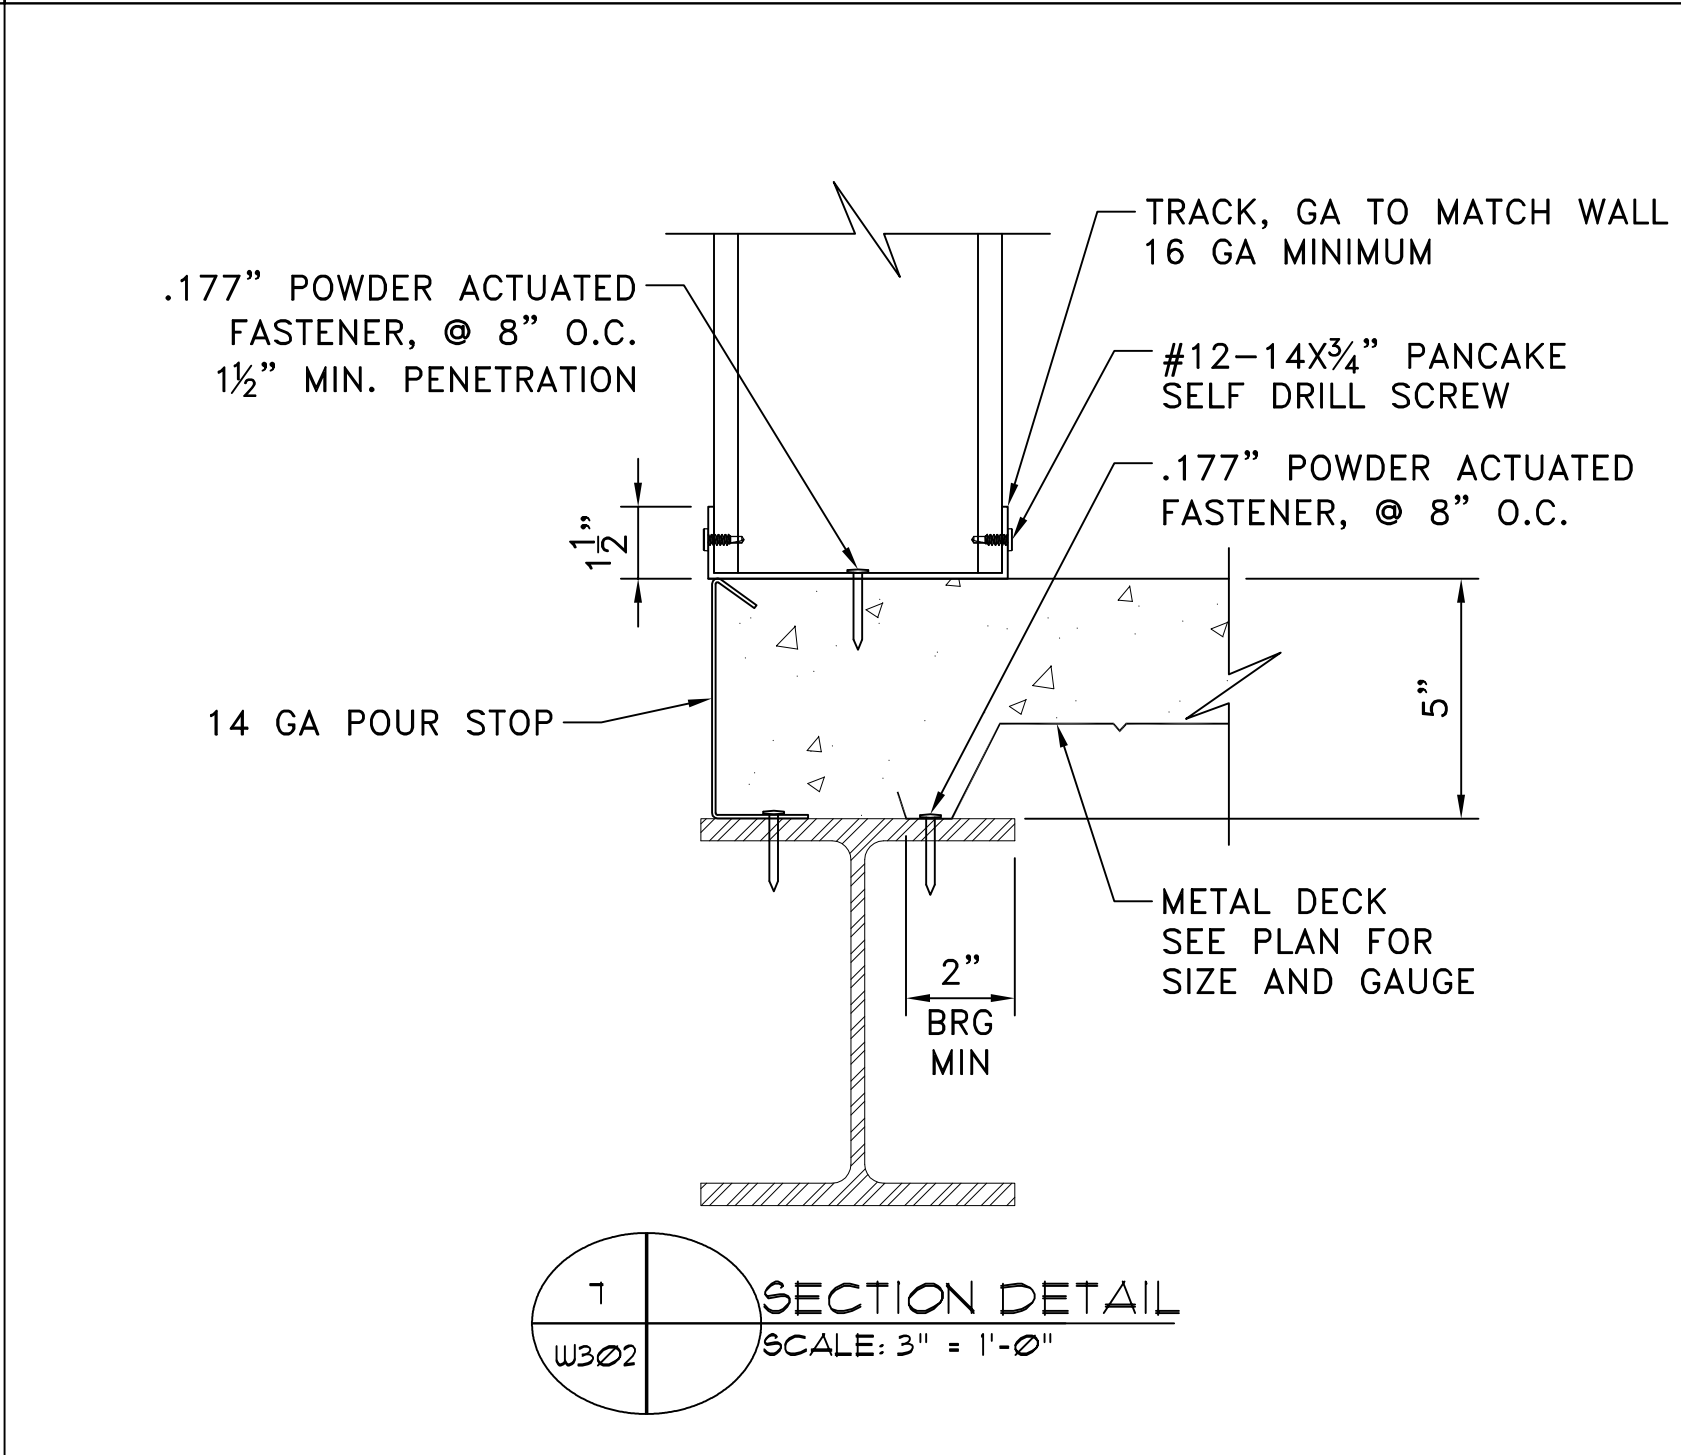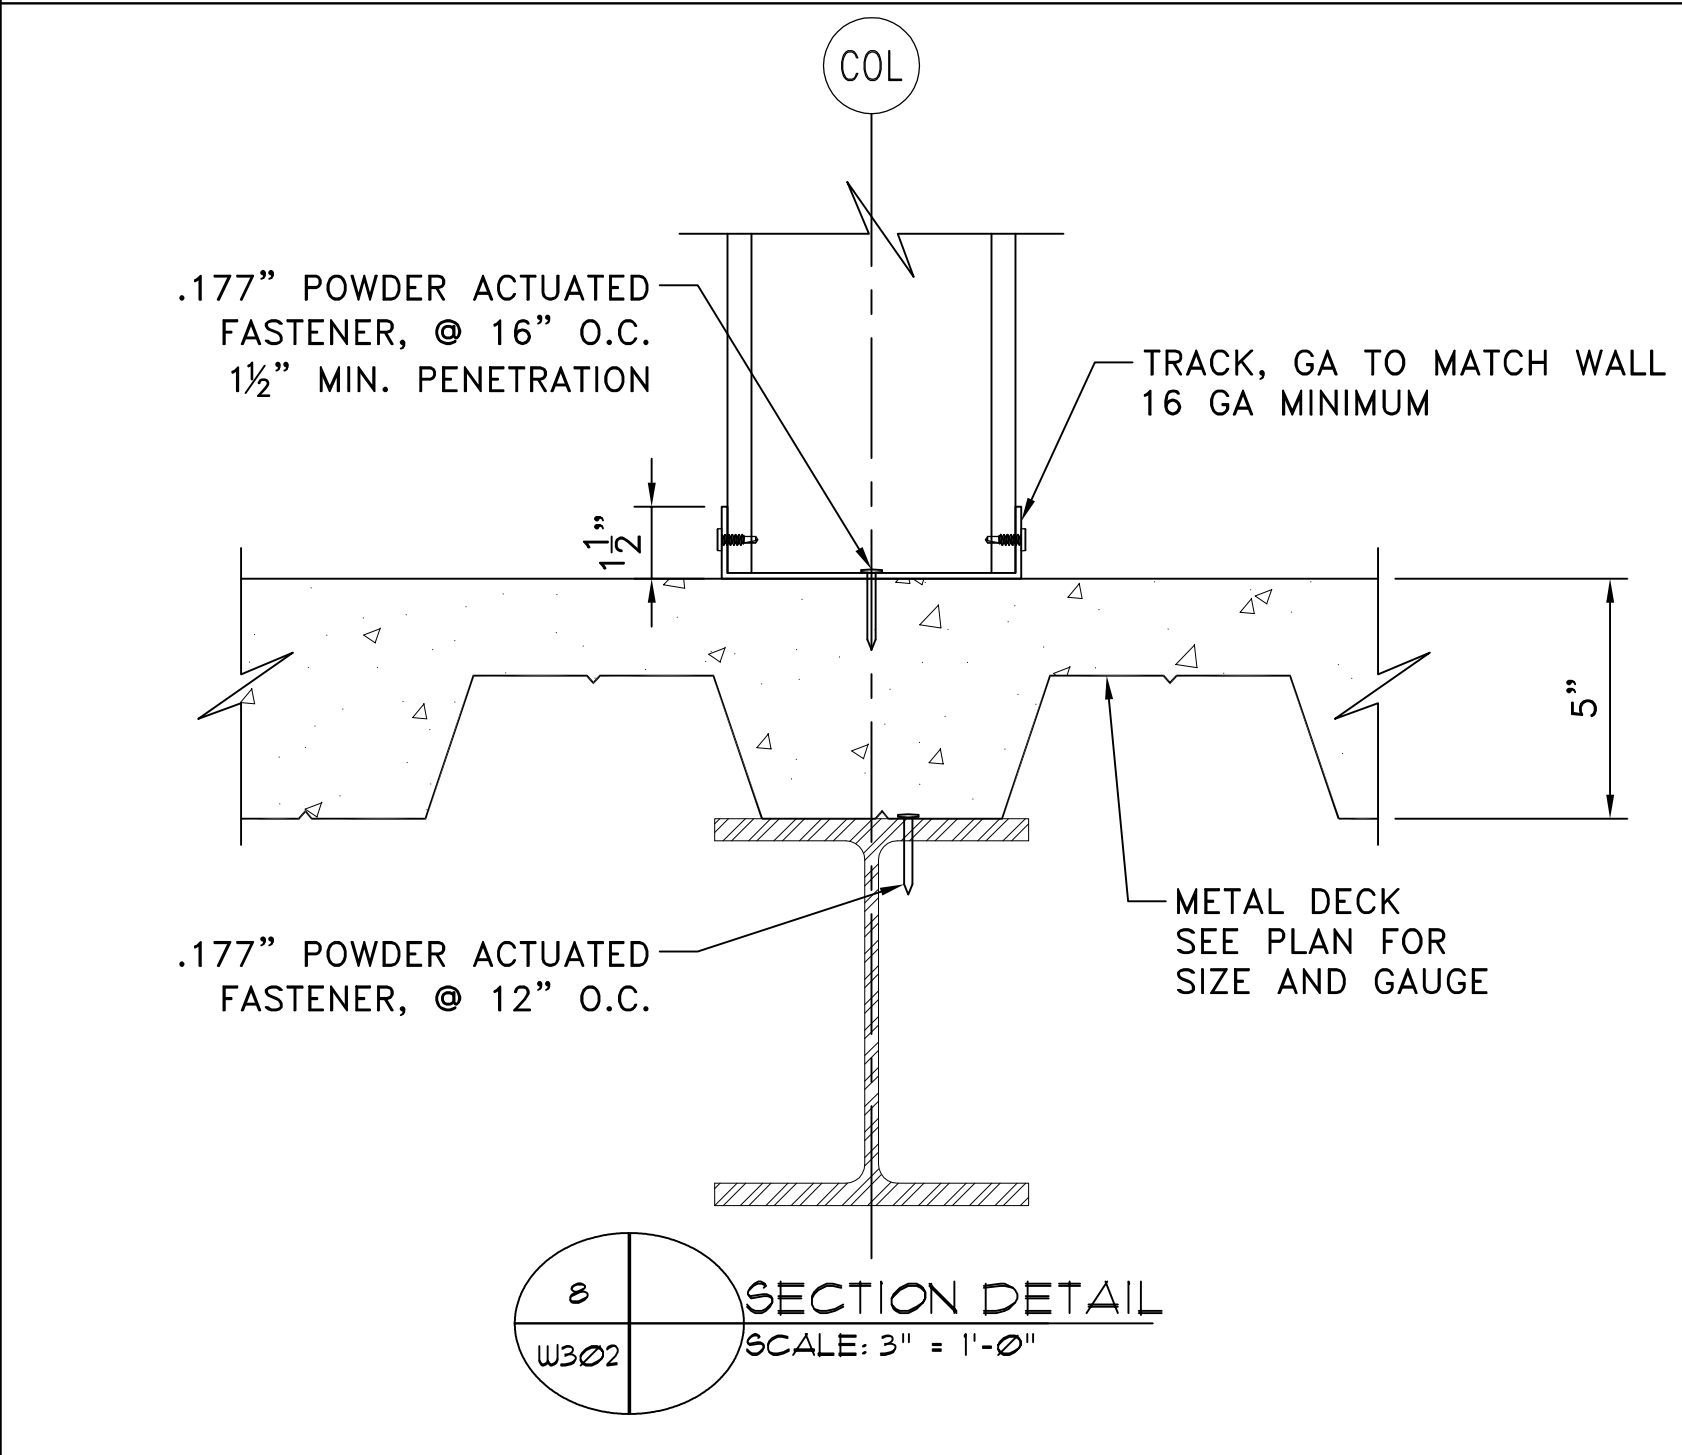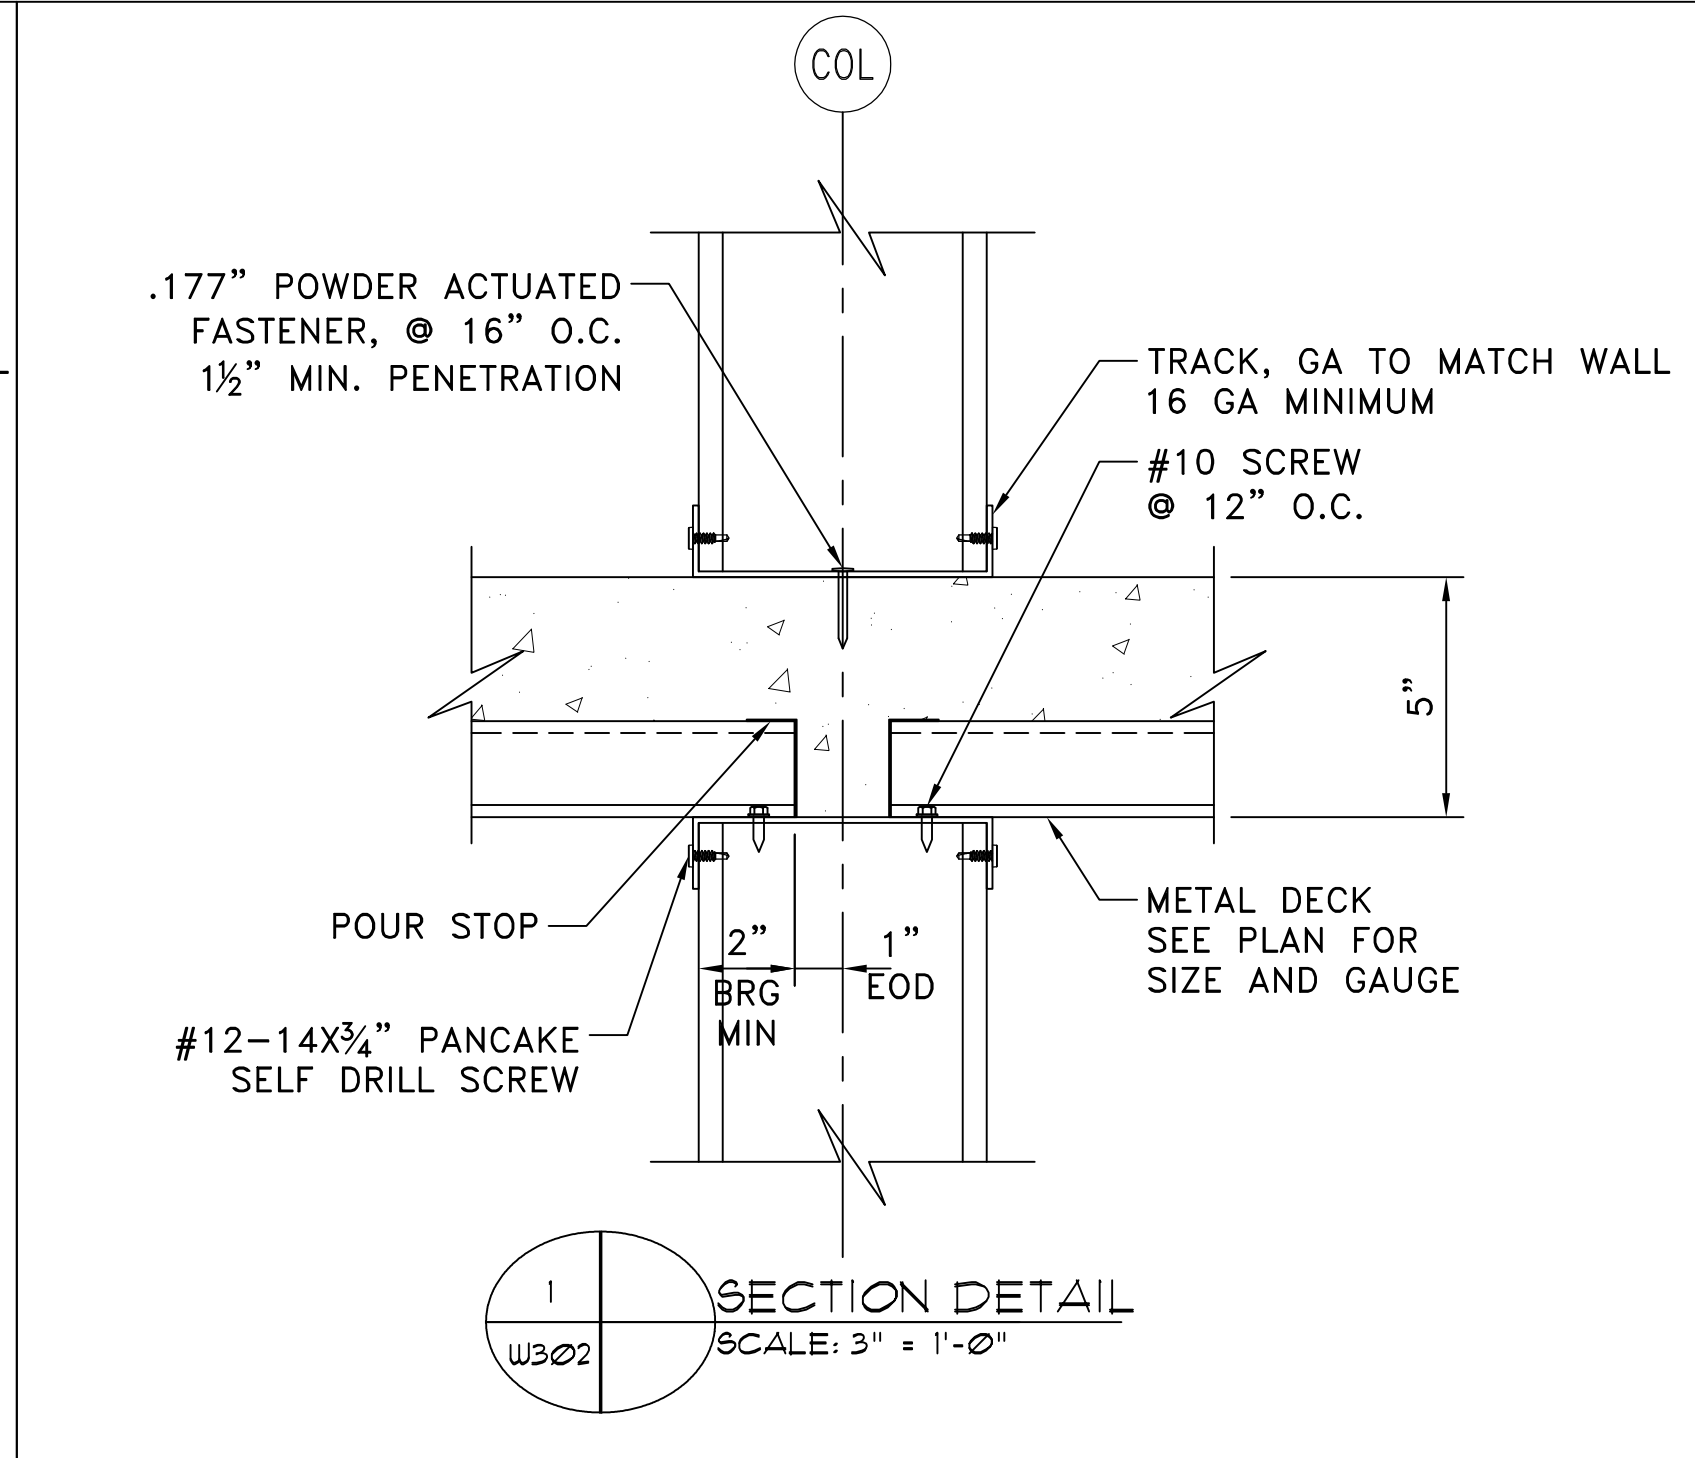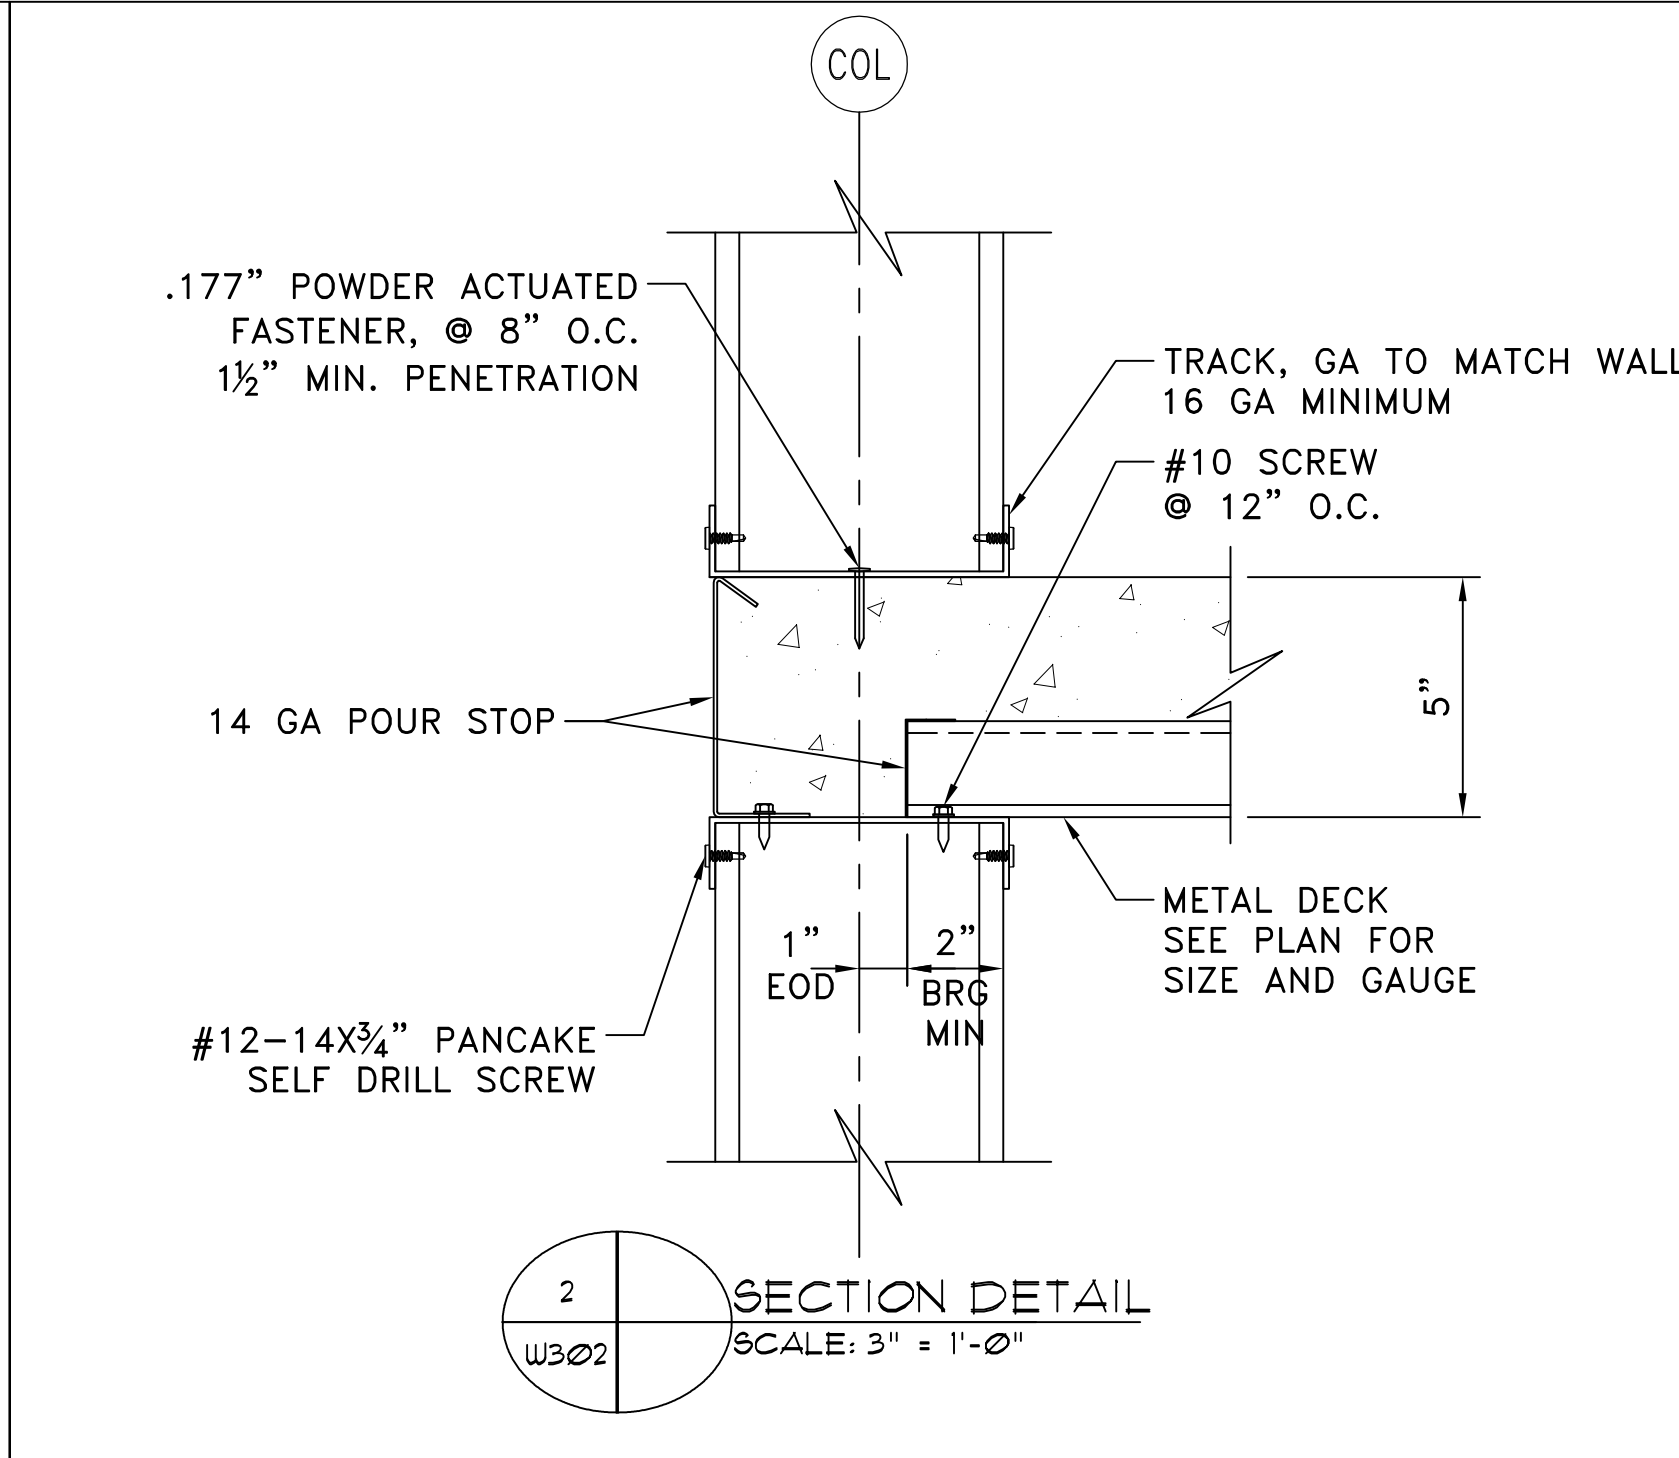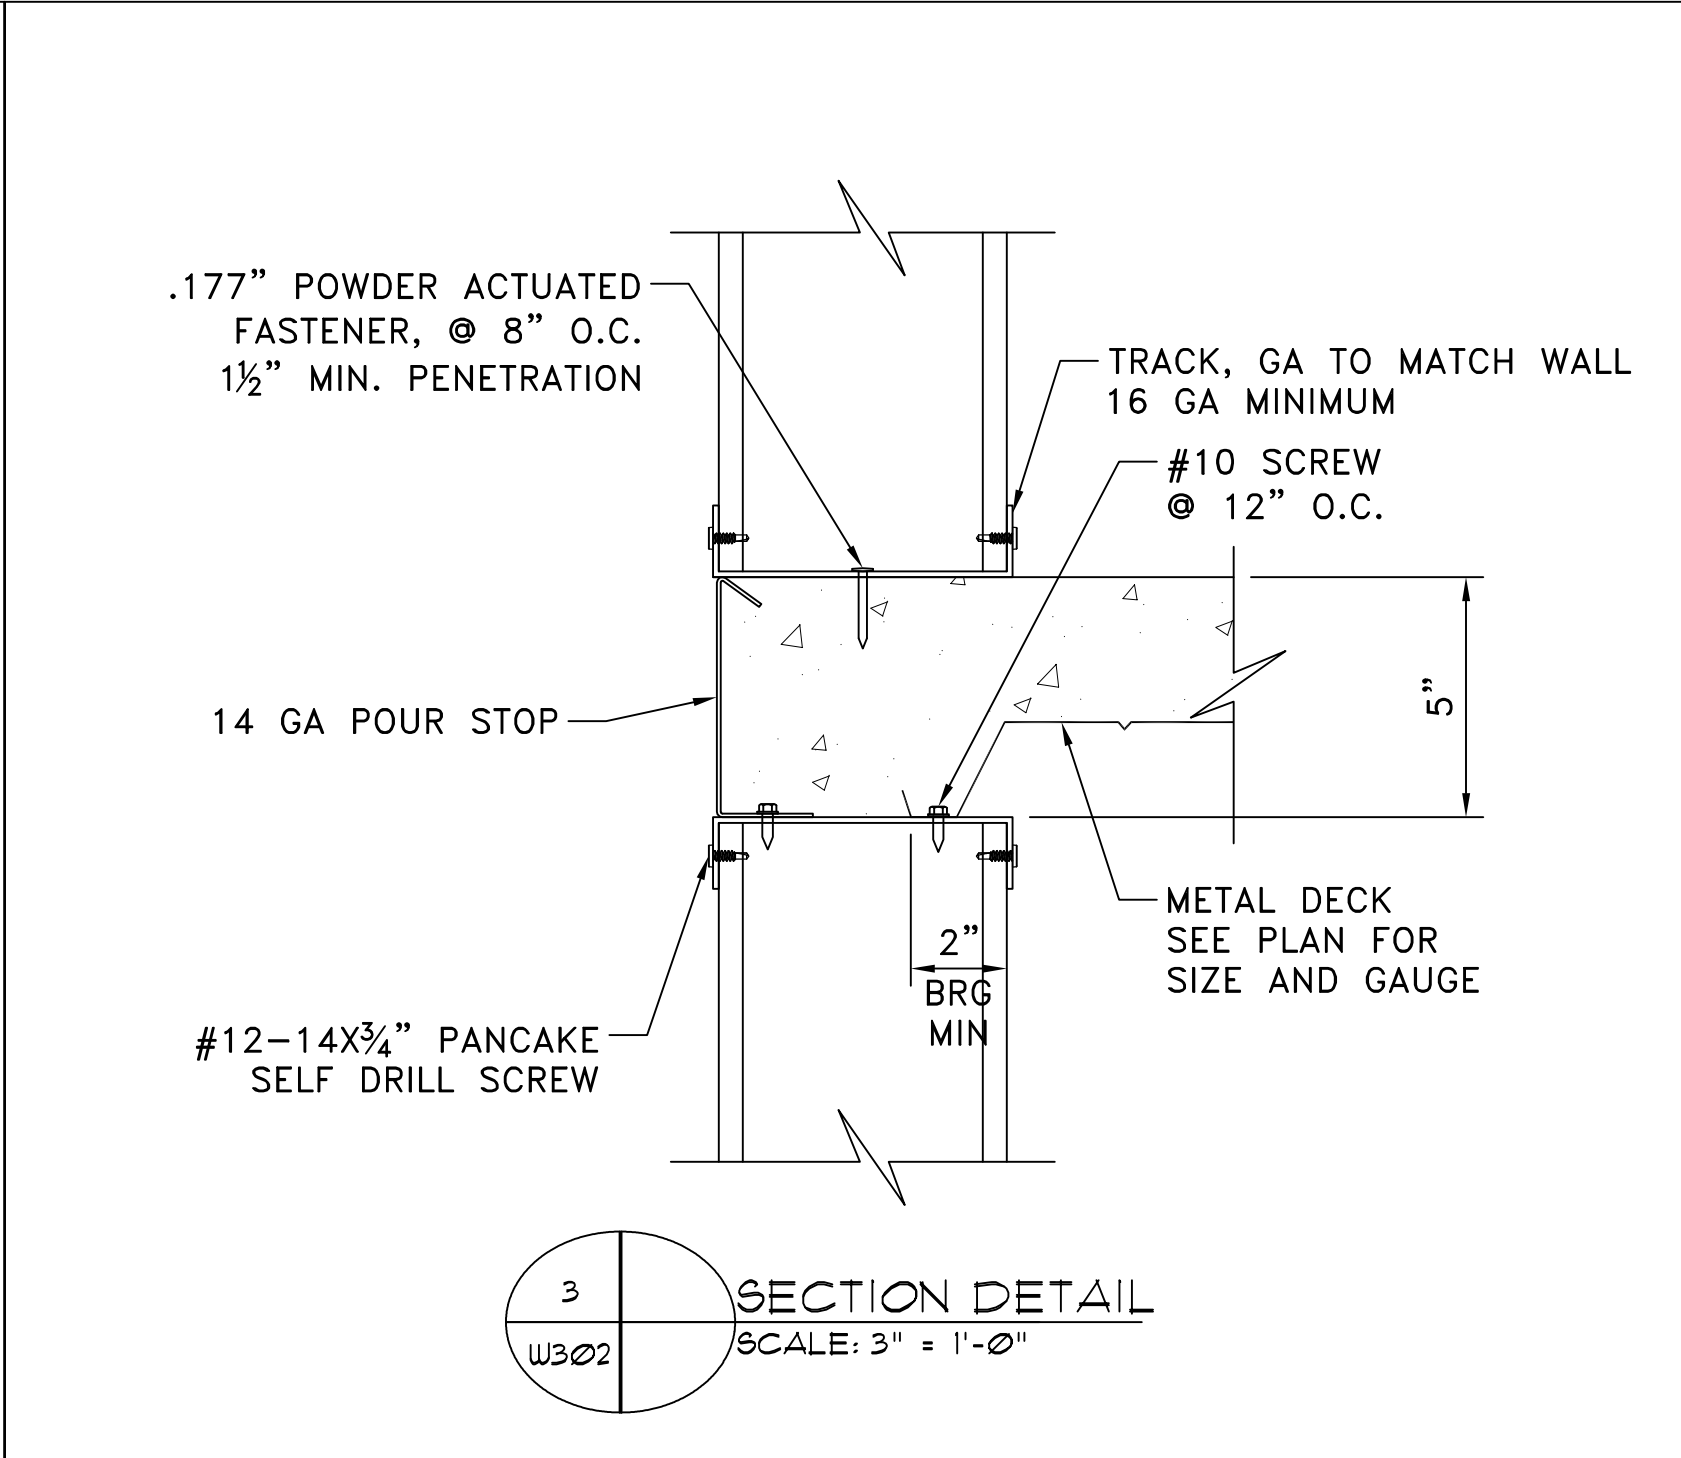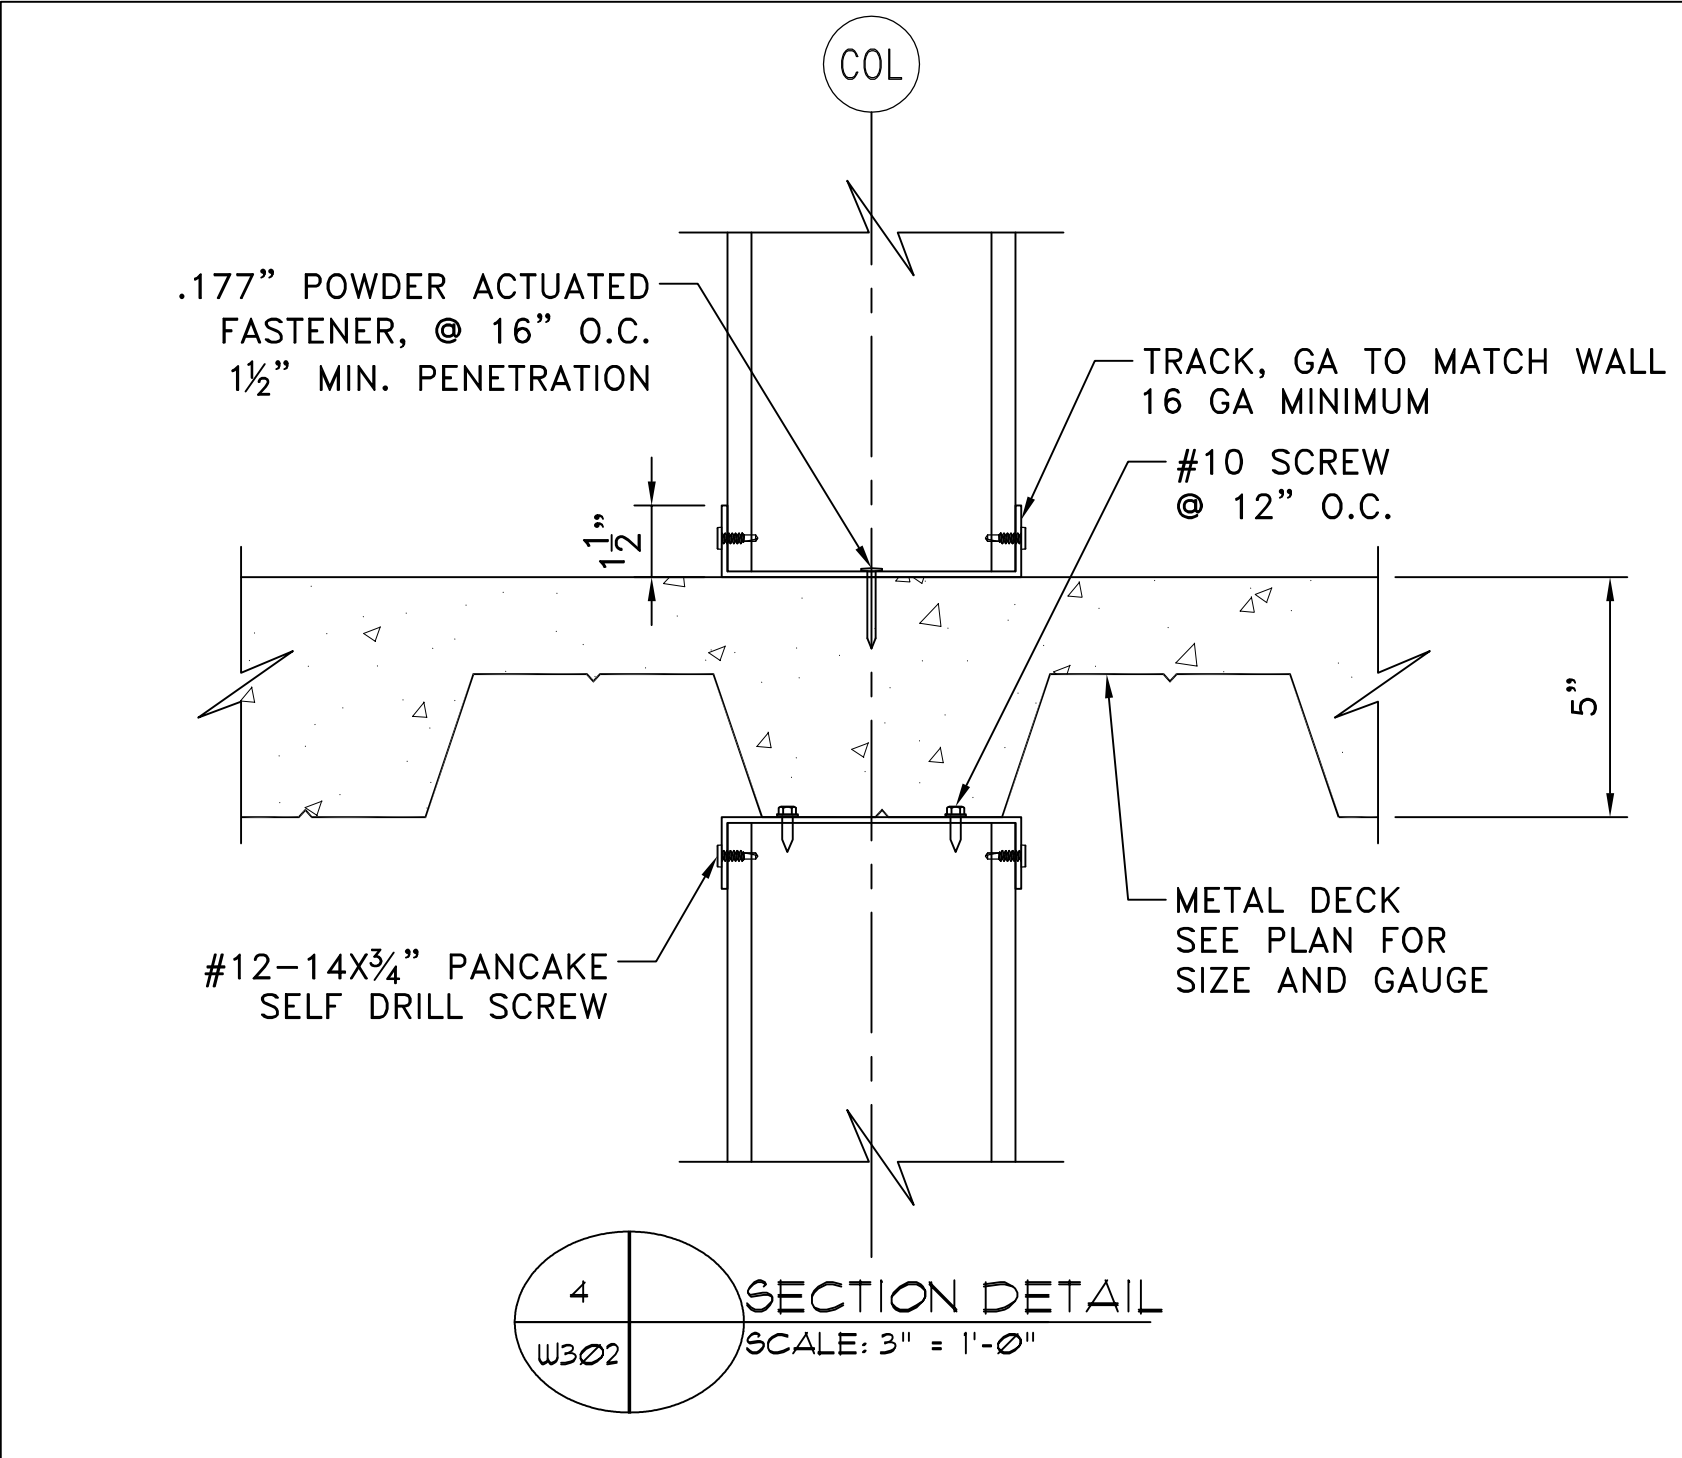

Home2 Suites
Flowood, MS


 





PANELIZERS, LLC
7695 HWY 161
WALLS, MS 38680
PHONE: (662) 936-5260
FAX: (662) 936-5262

Shop Drawings by:
HILLMAN ENTERPRISES, INC.
P.O. Box 106
Graham, AL 36033
PHONE: (256) 443-9261


Sheet Number:
W302

Job Number:
1605/1655

Date:
01/26/17

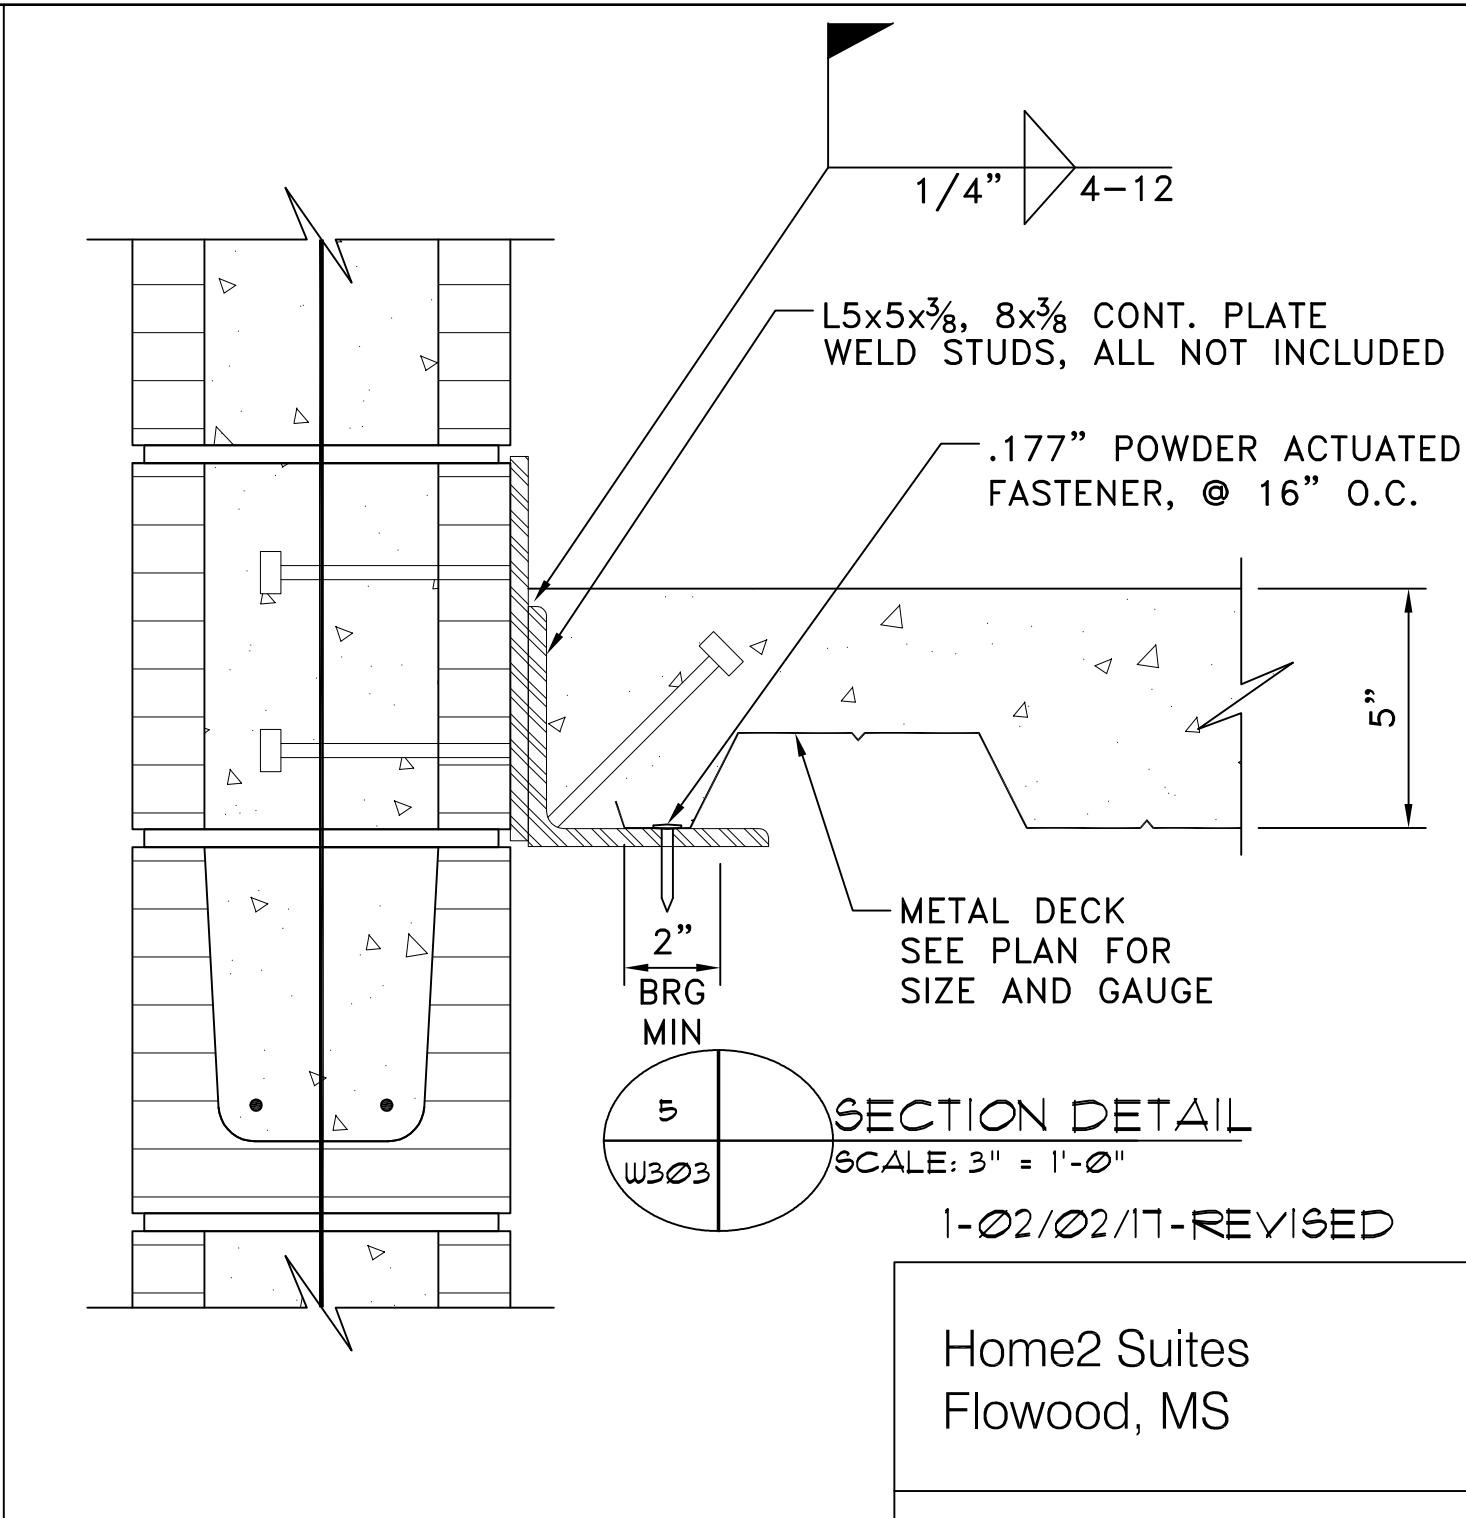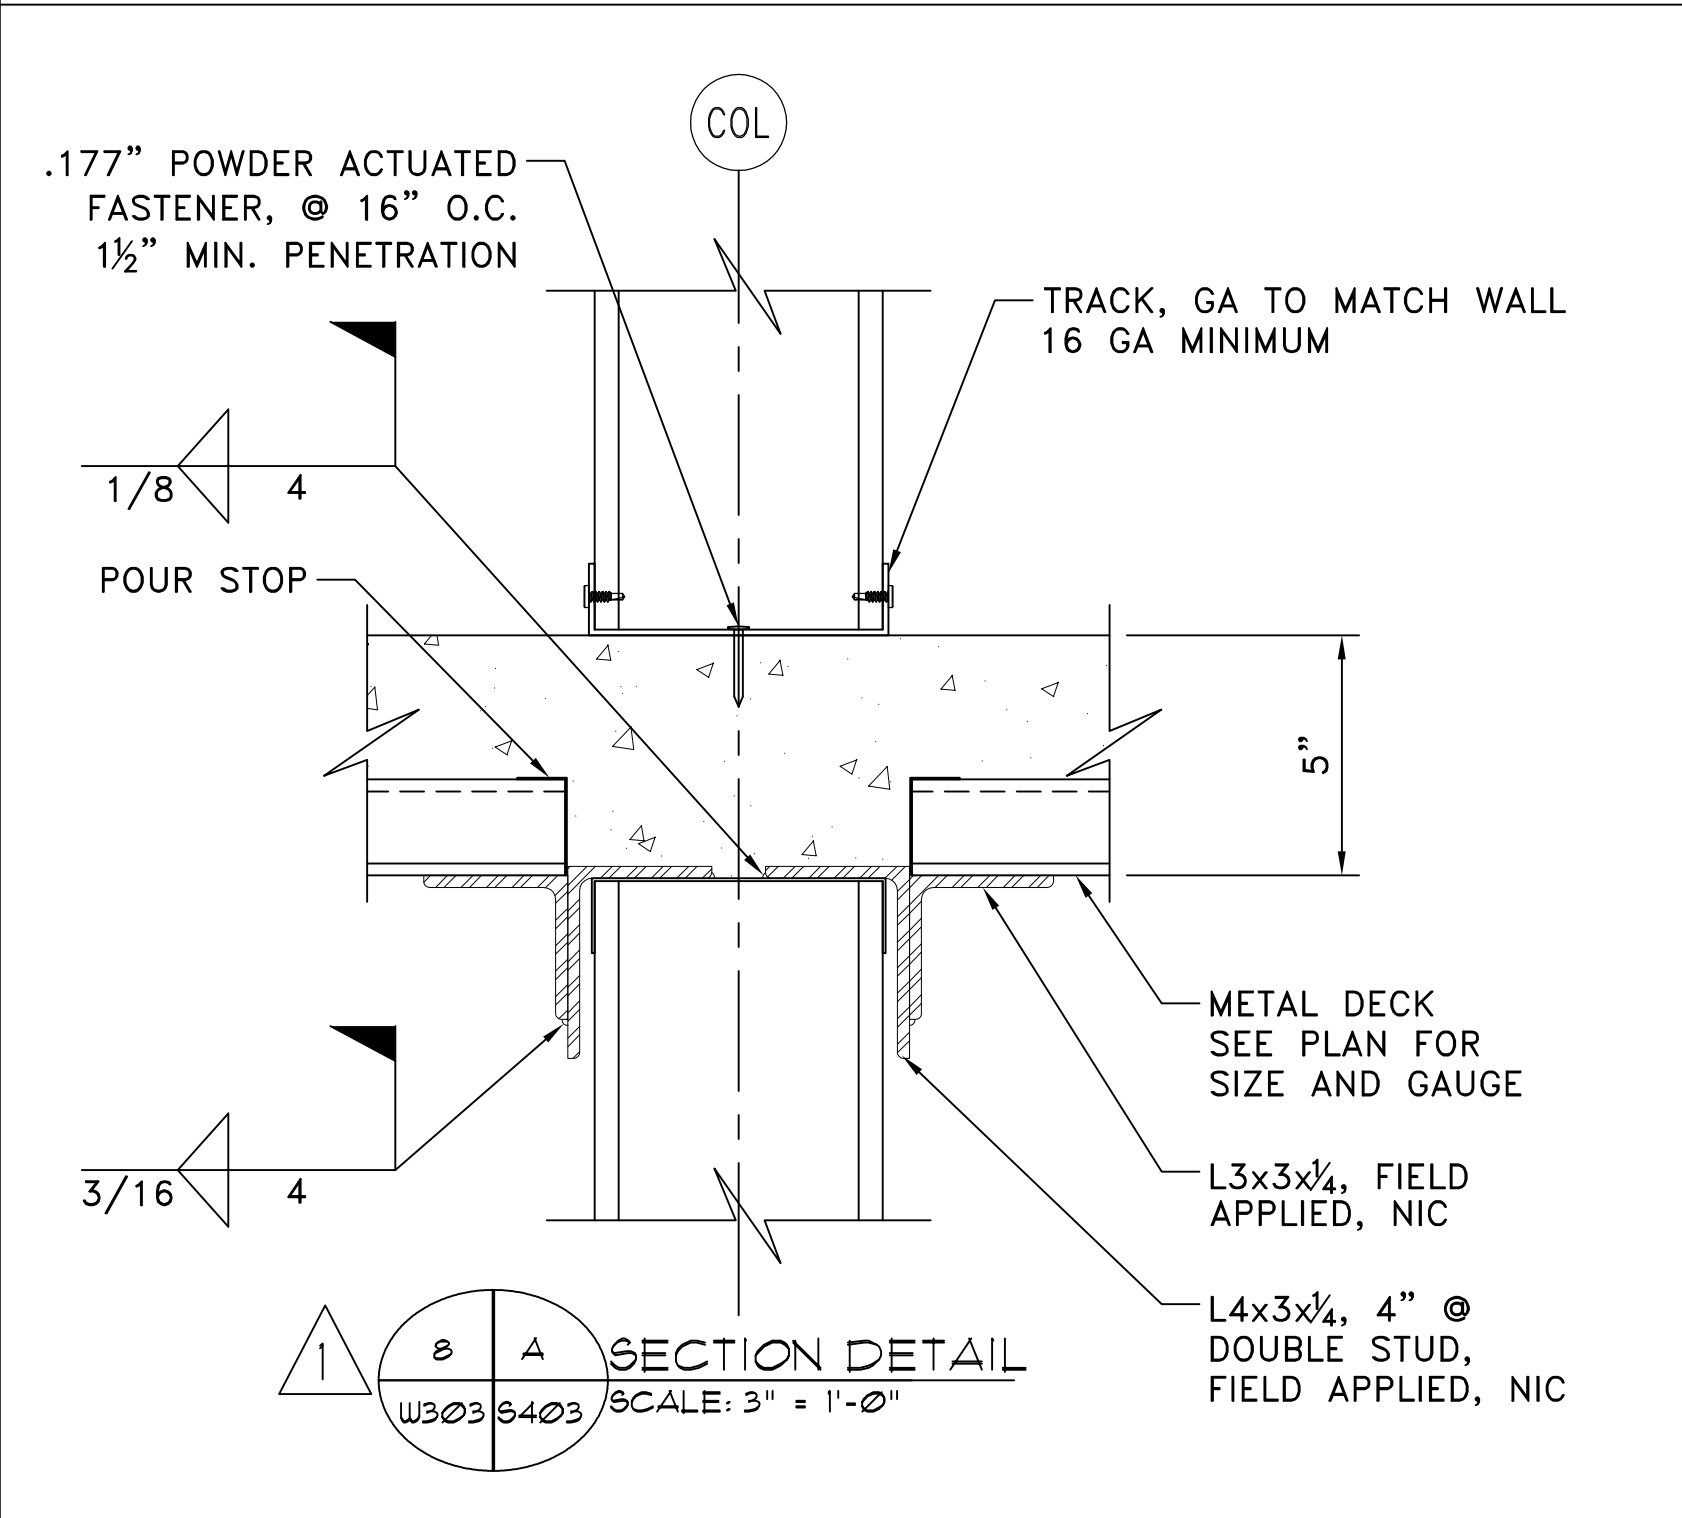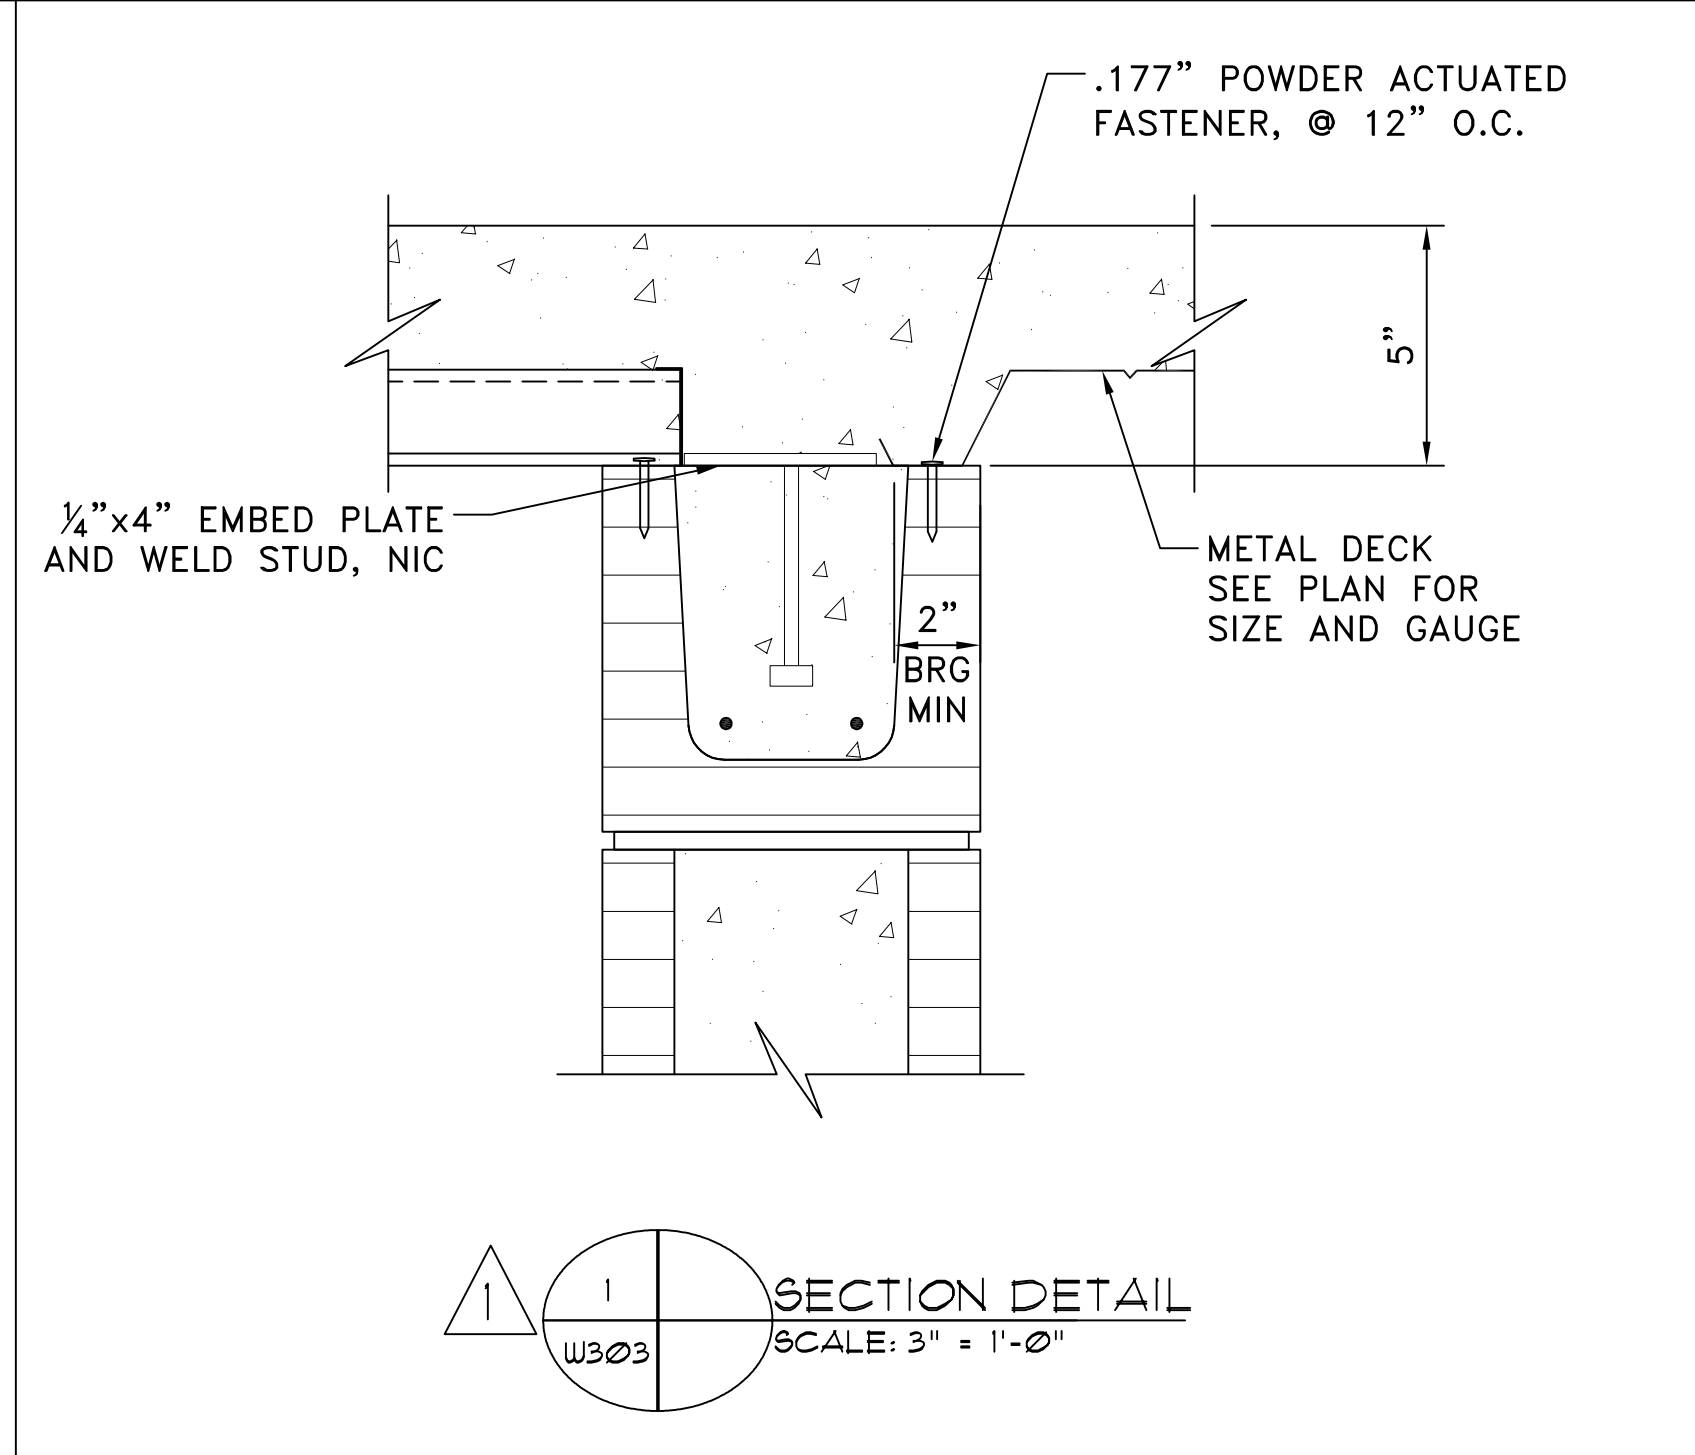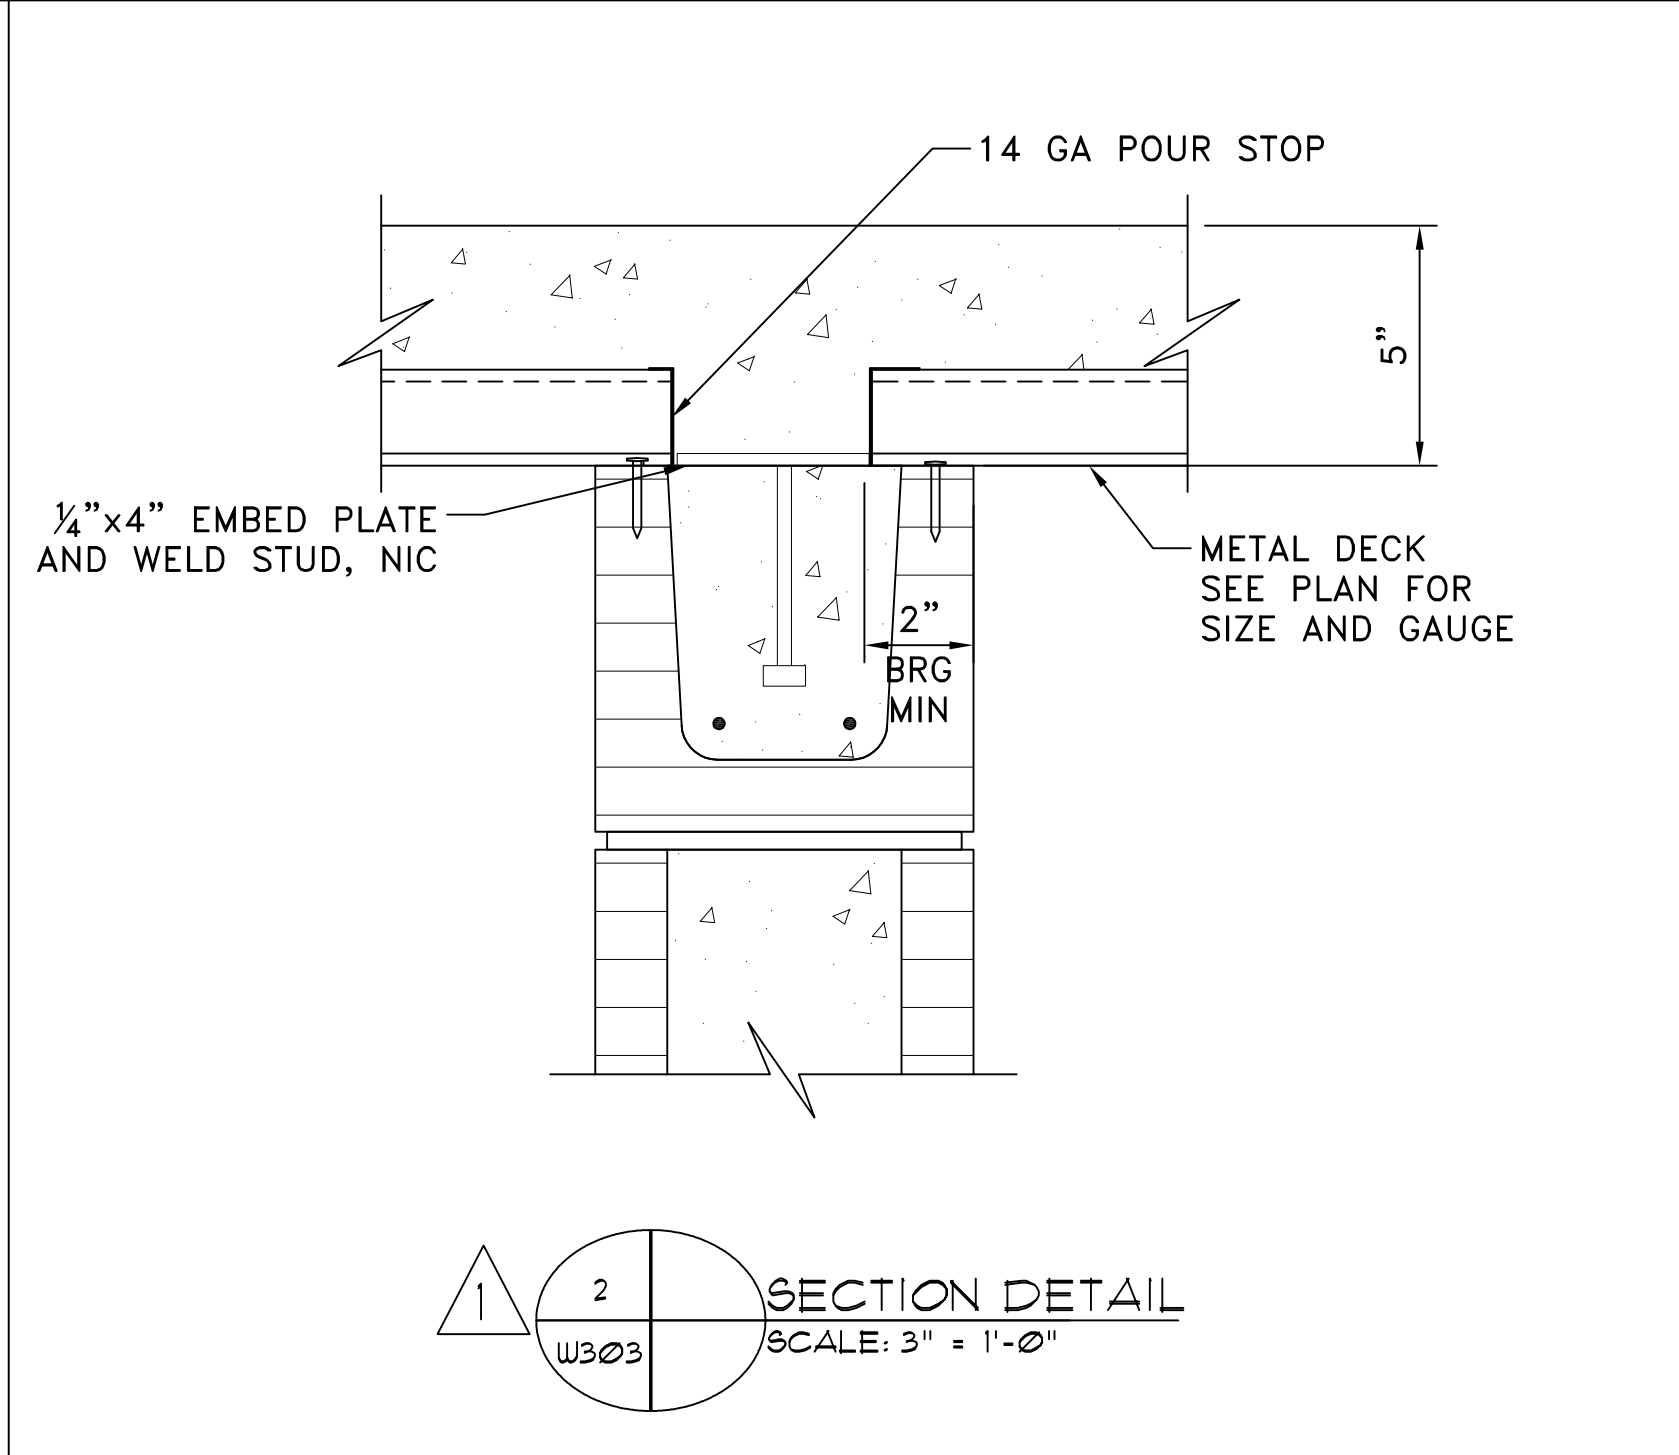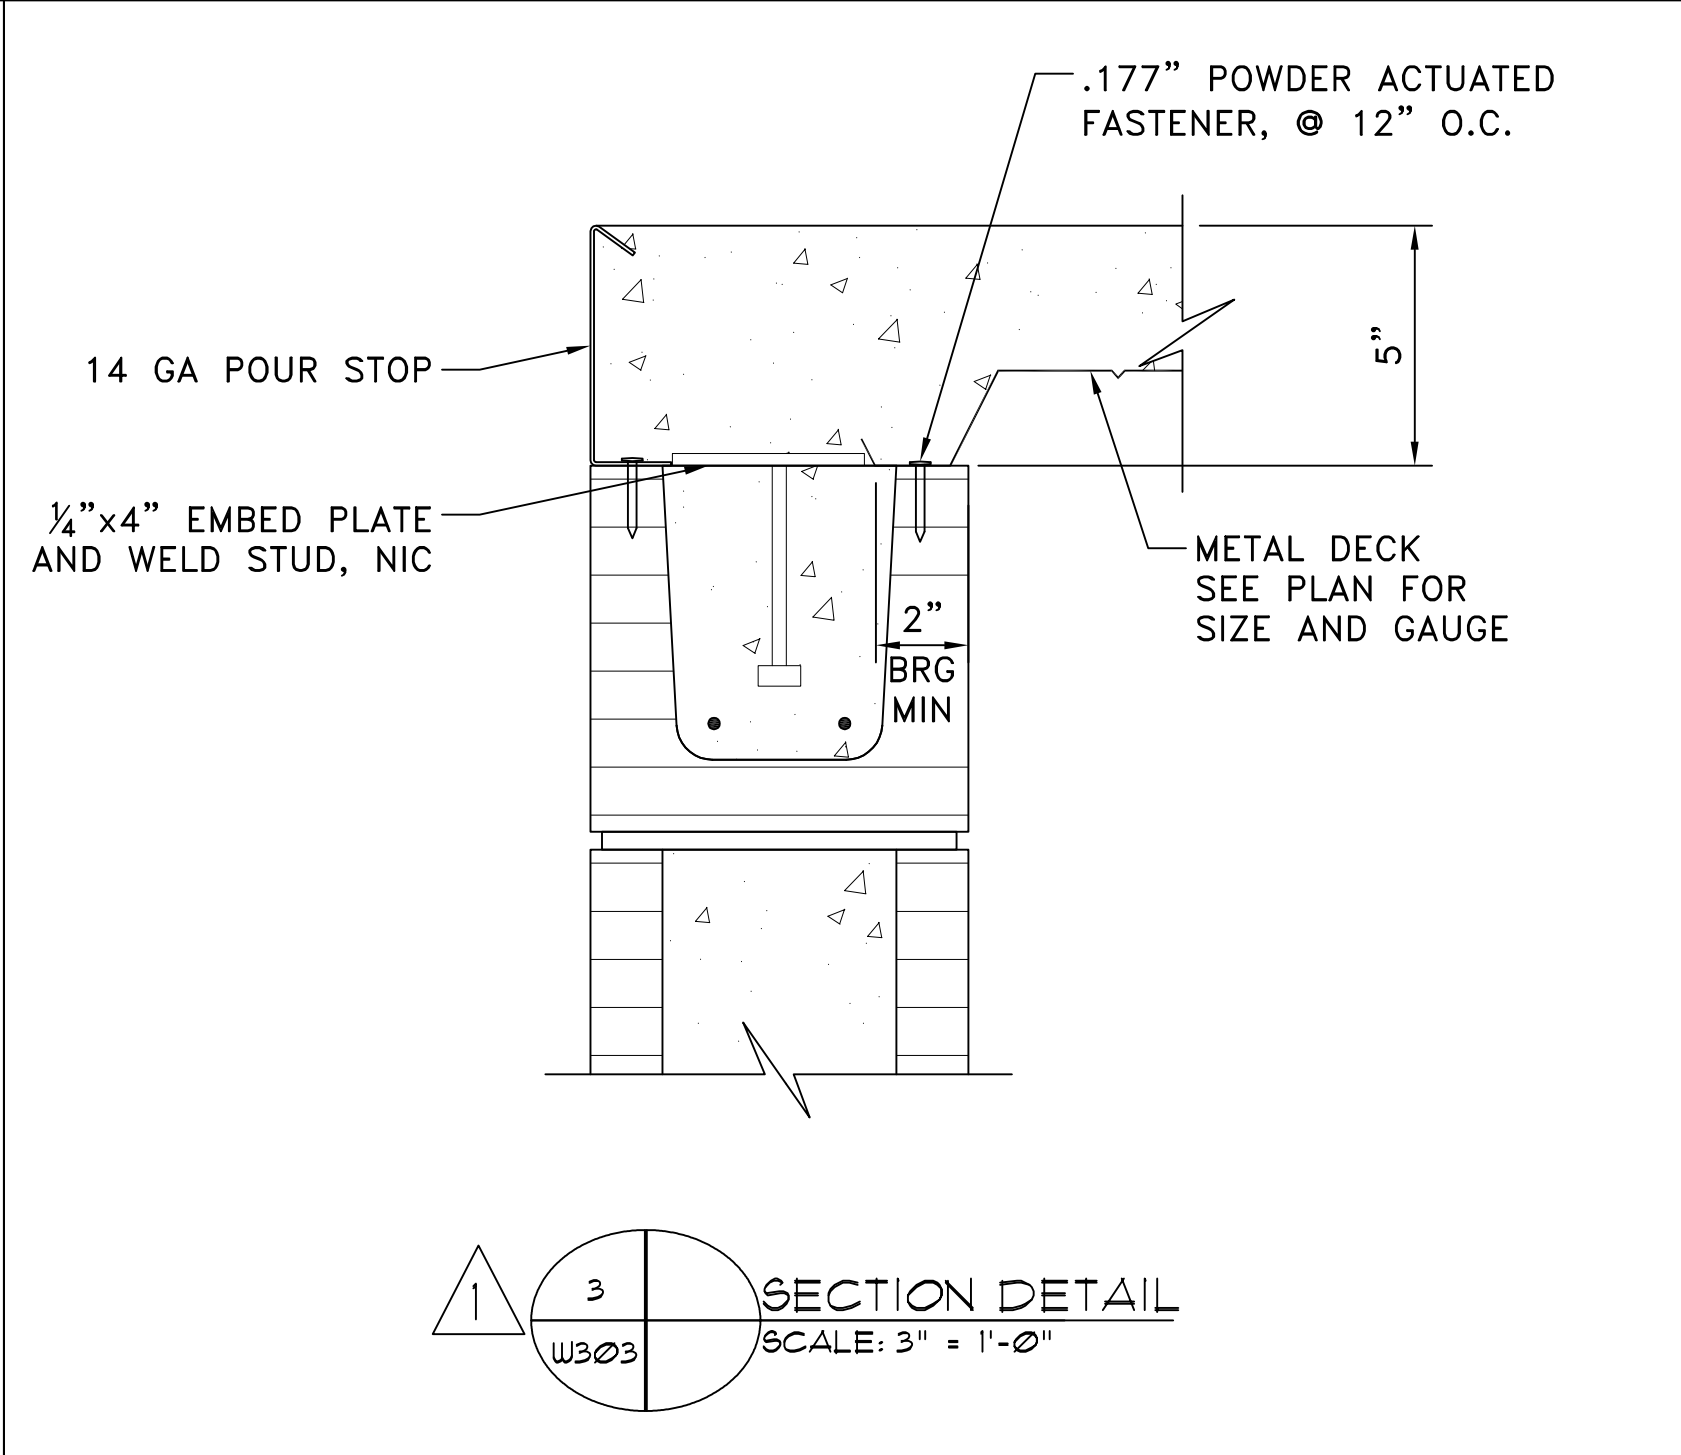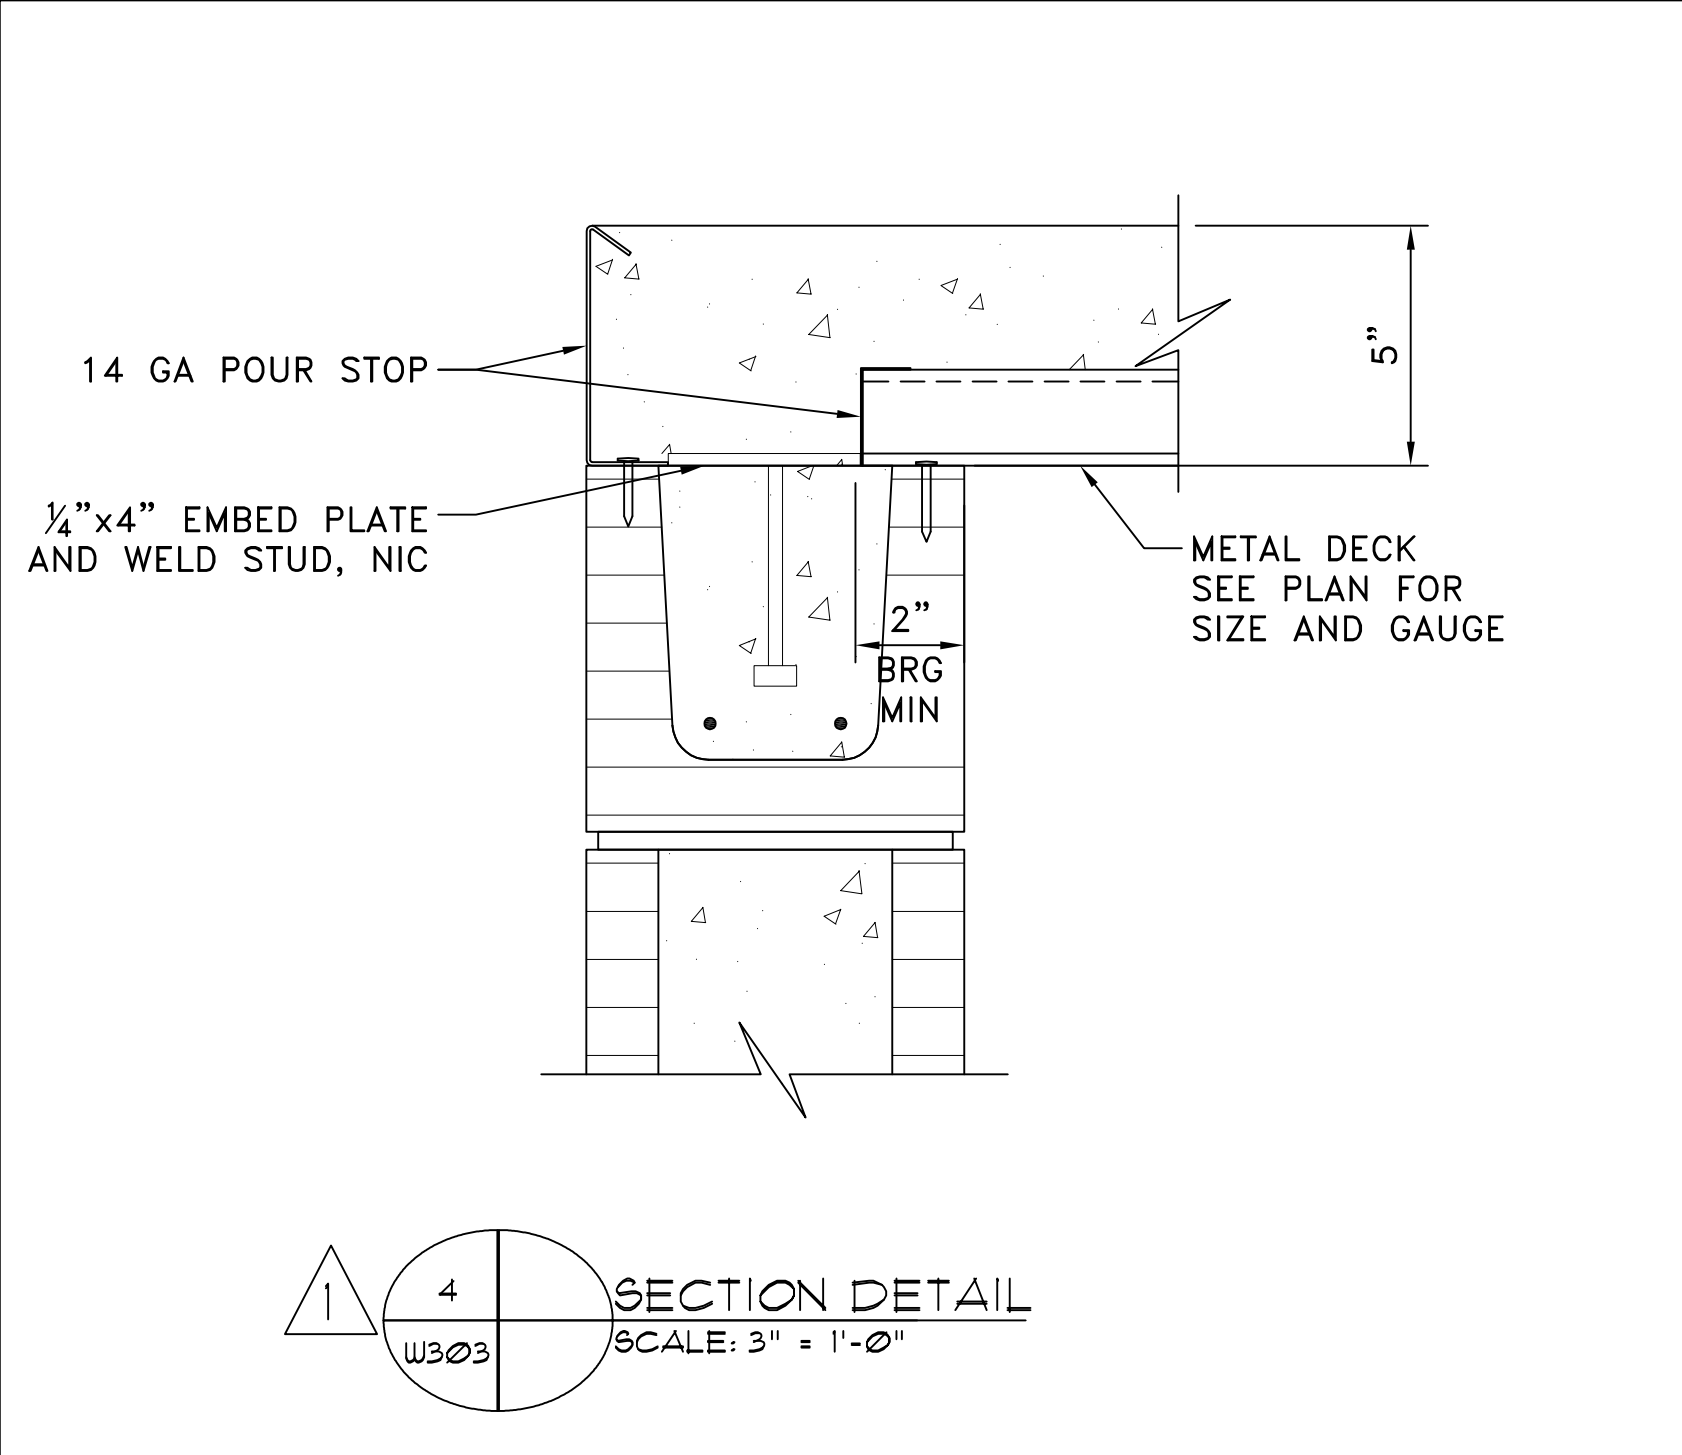

 SCALED DIMENSION. PLEASE VERIFY.

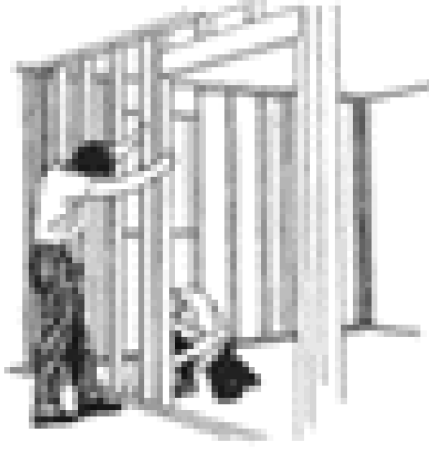



PANELIZERS, LLC
7695 HWY 161
WALLS, MS 38680
PHONE: (662) 936-5260
FAX: (662) 936-5262

Shop Drawings by:
HILLMAN ENTERPRISES, INC.
P.O. Box 106
Graham, AL 36263
PHONE: (256) 449-9261

Sheet Number:
W303


Job Number:
1605/1655

Date:
01/26/17

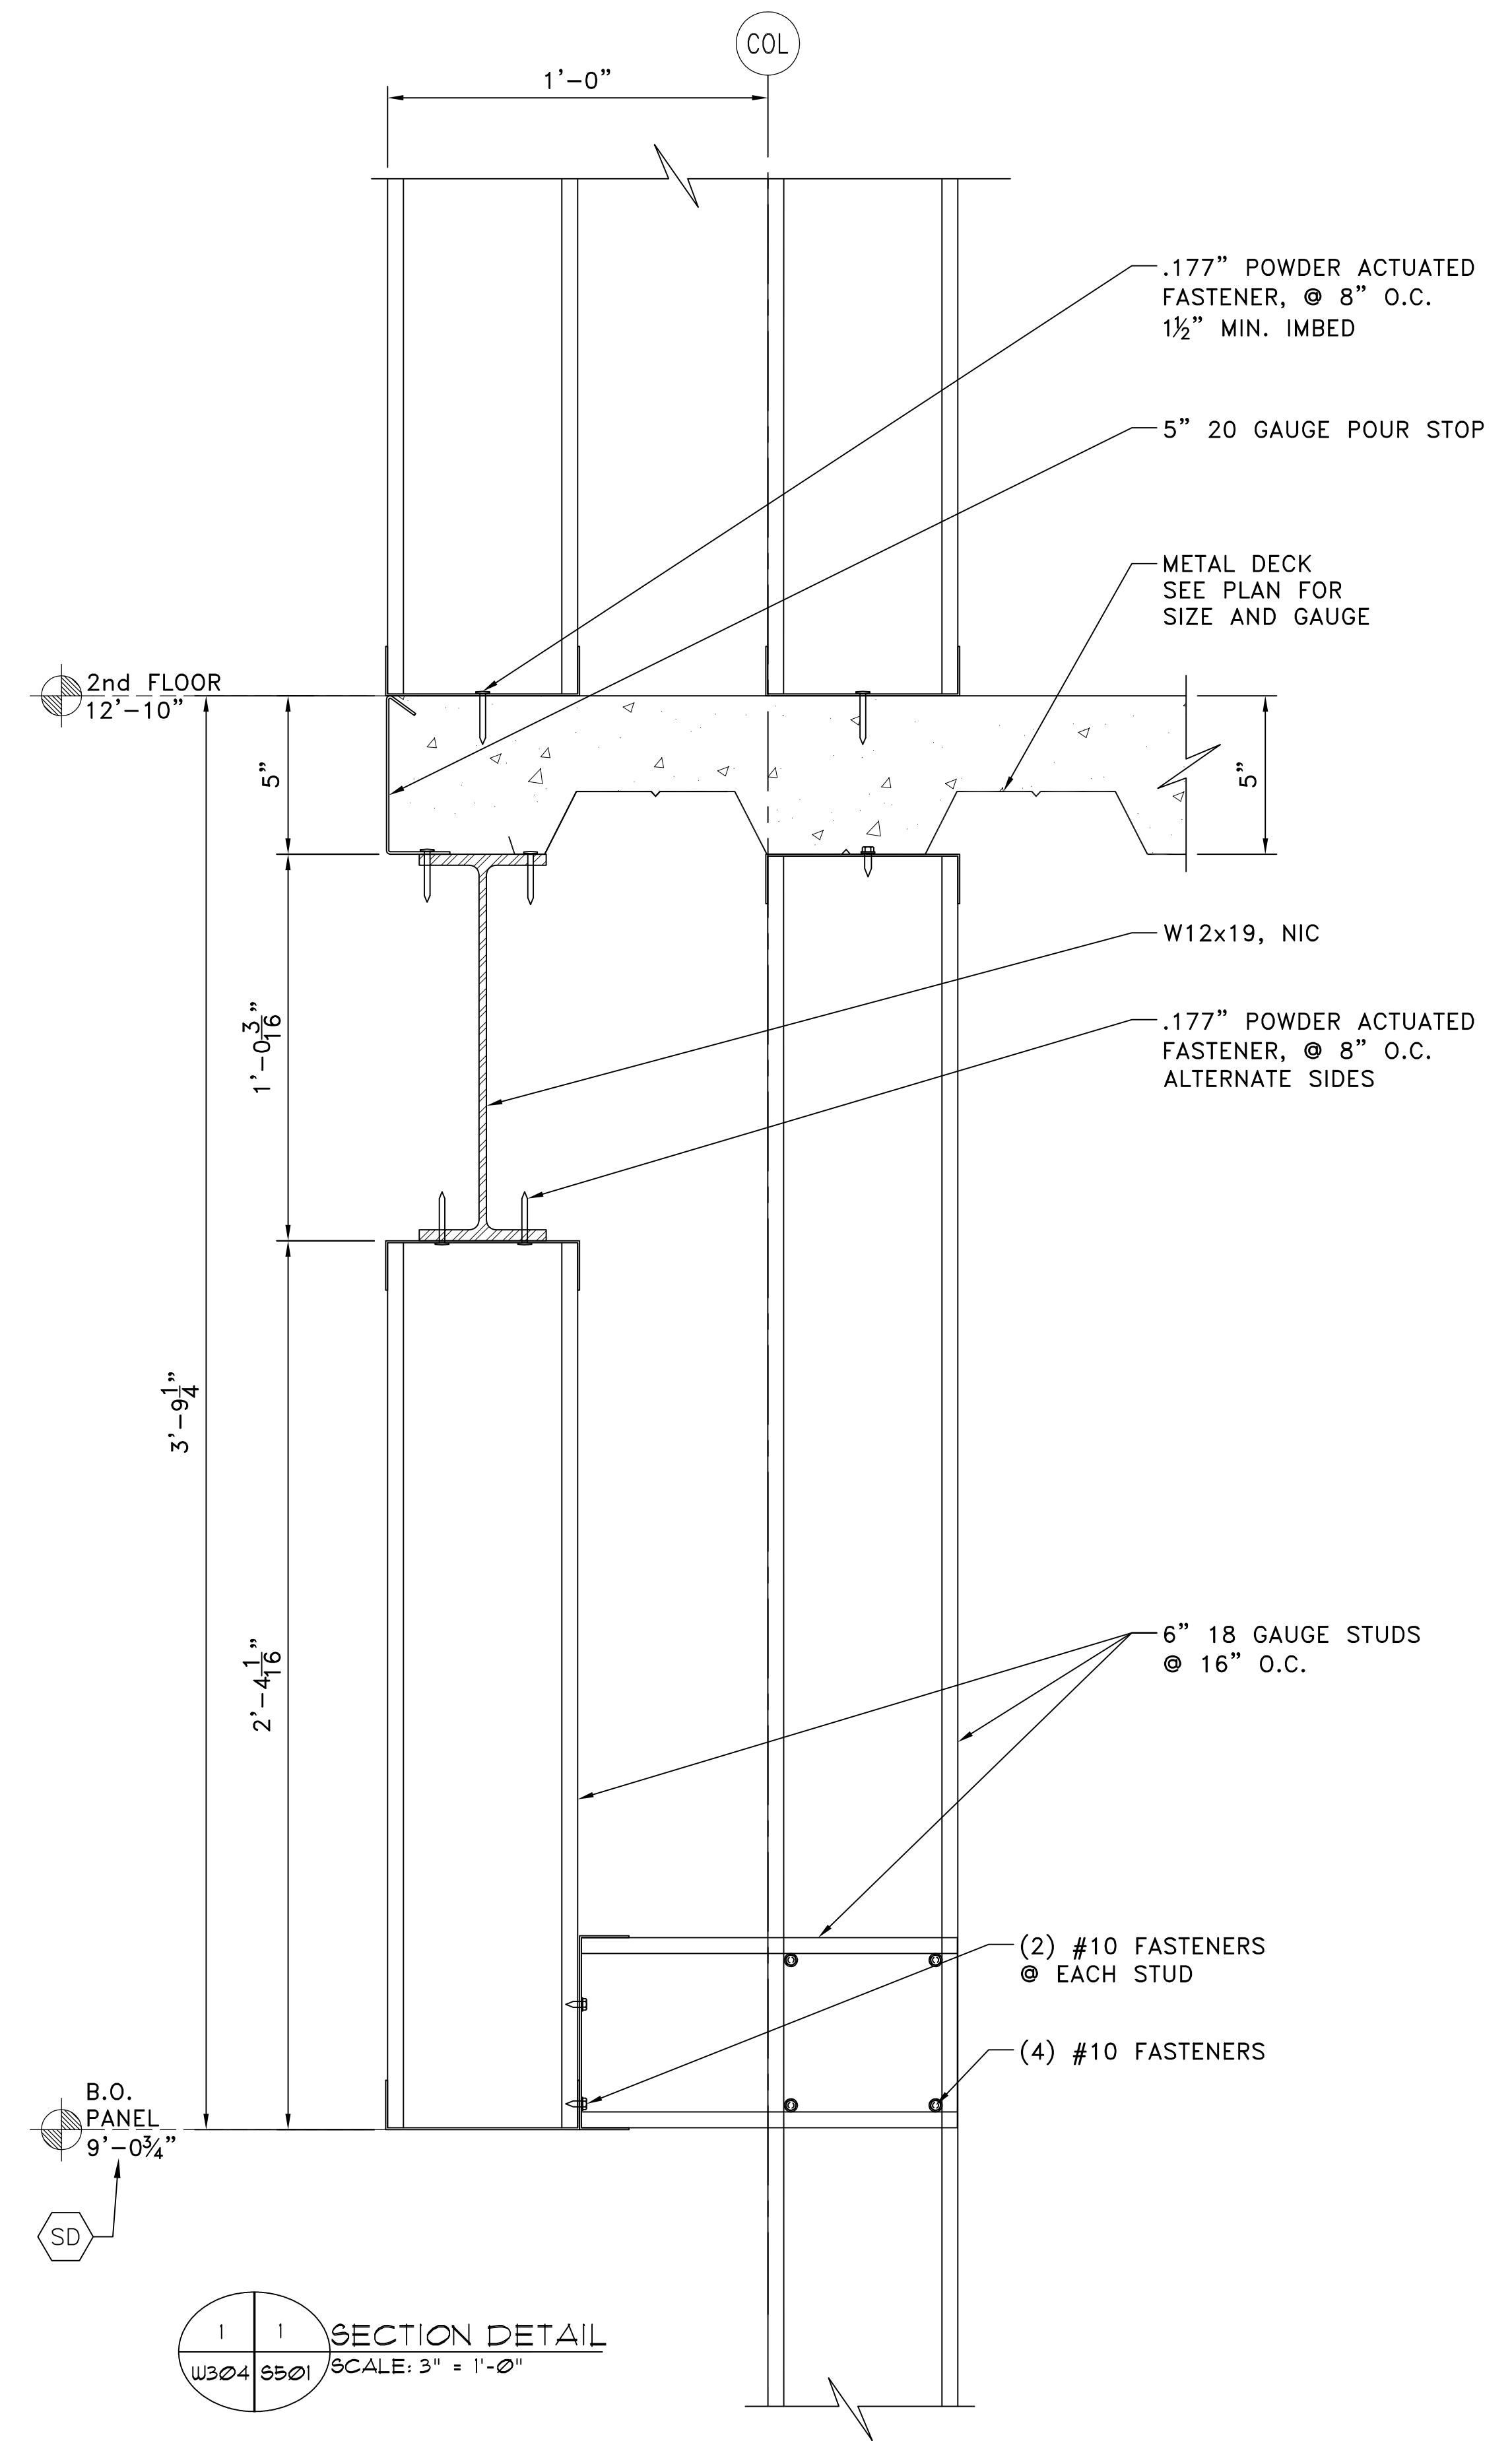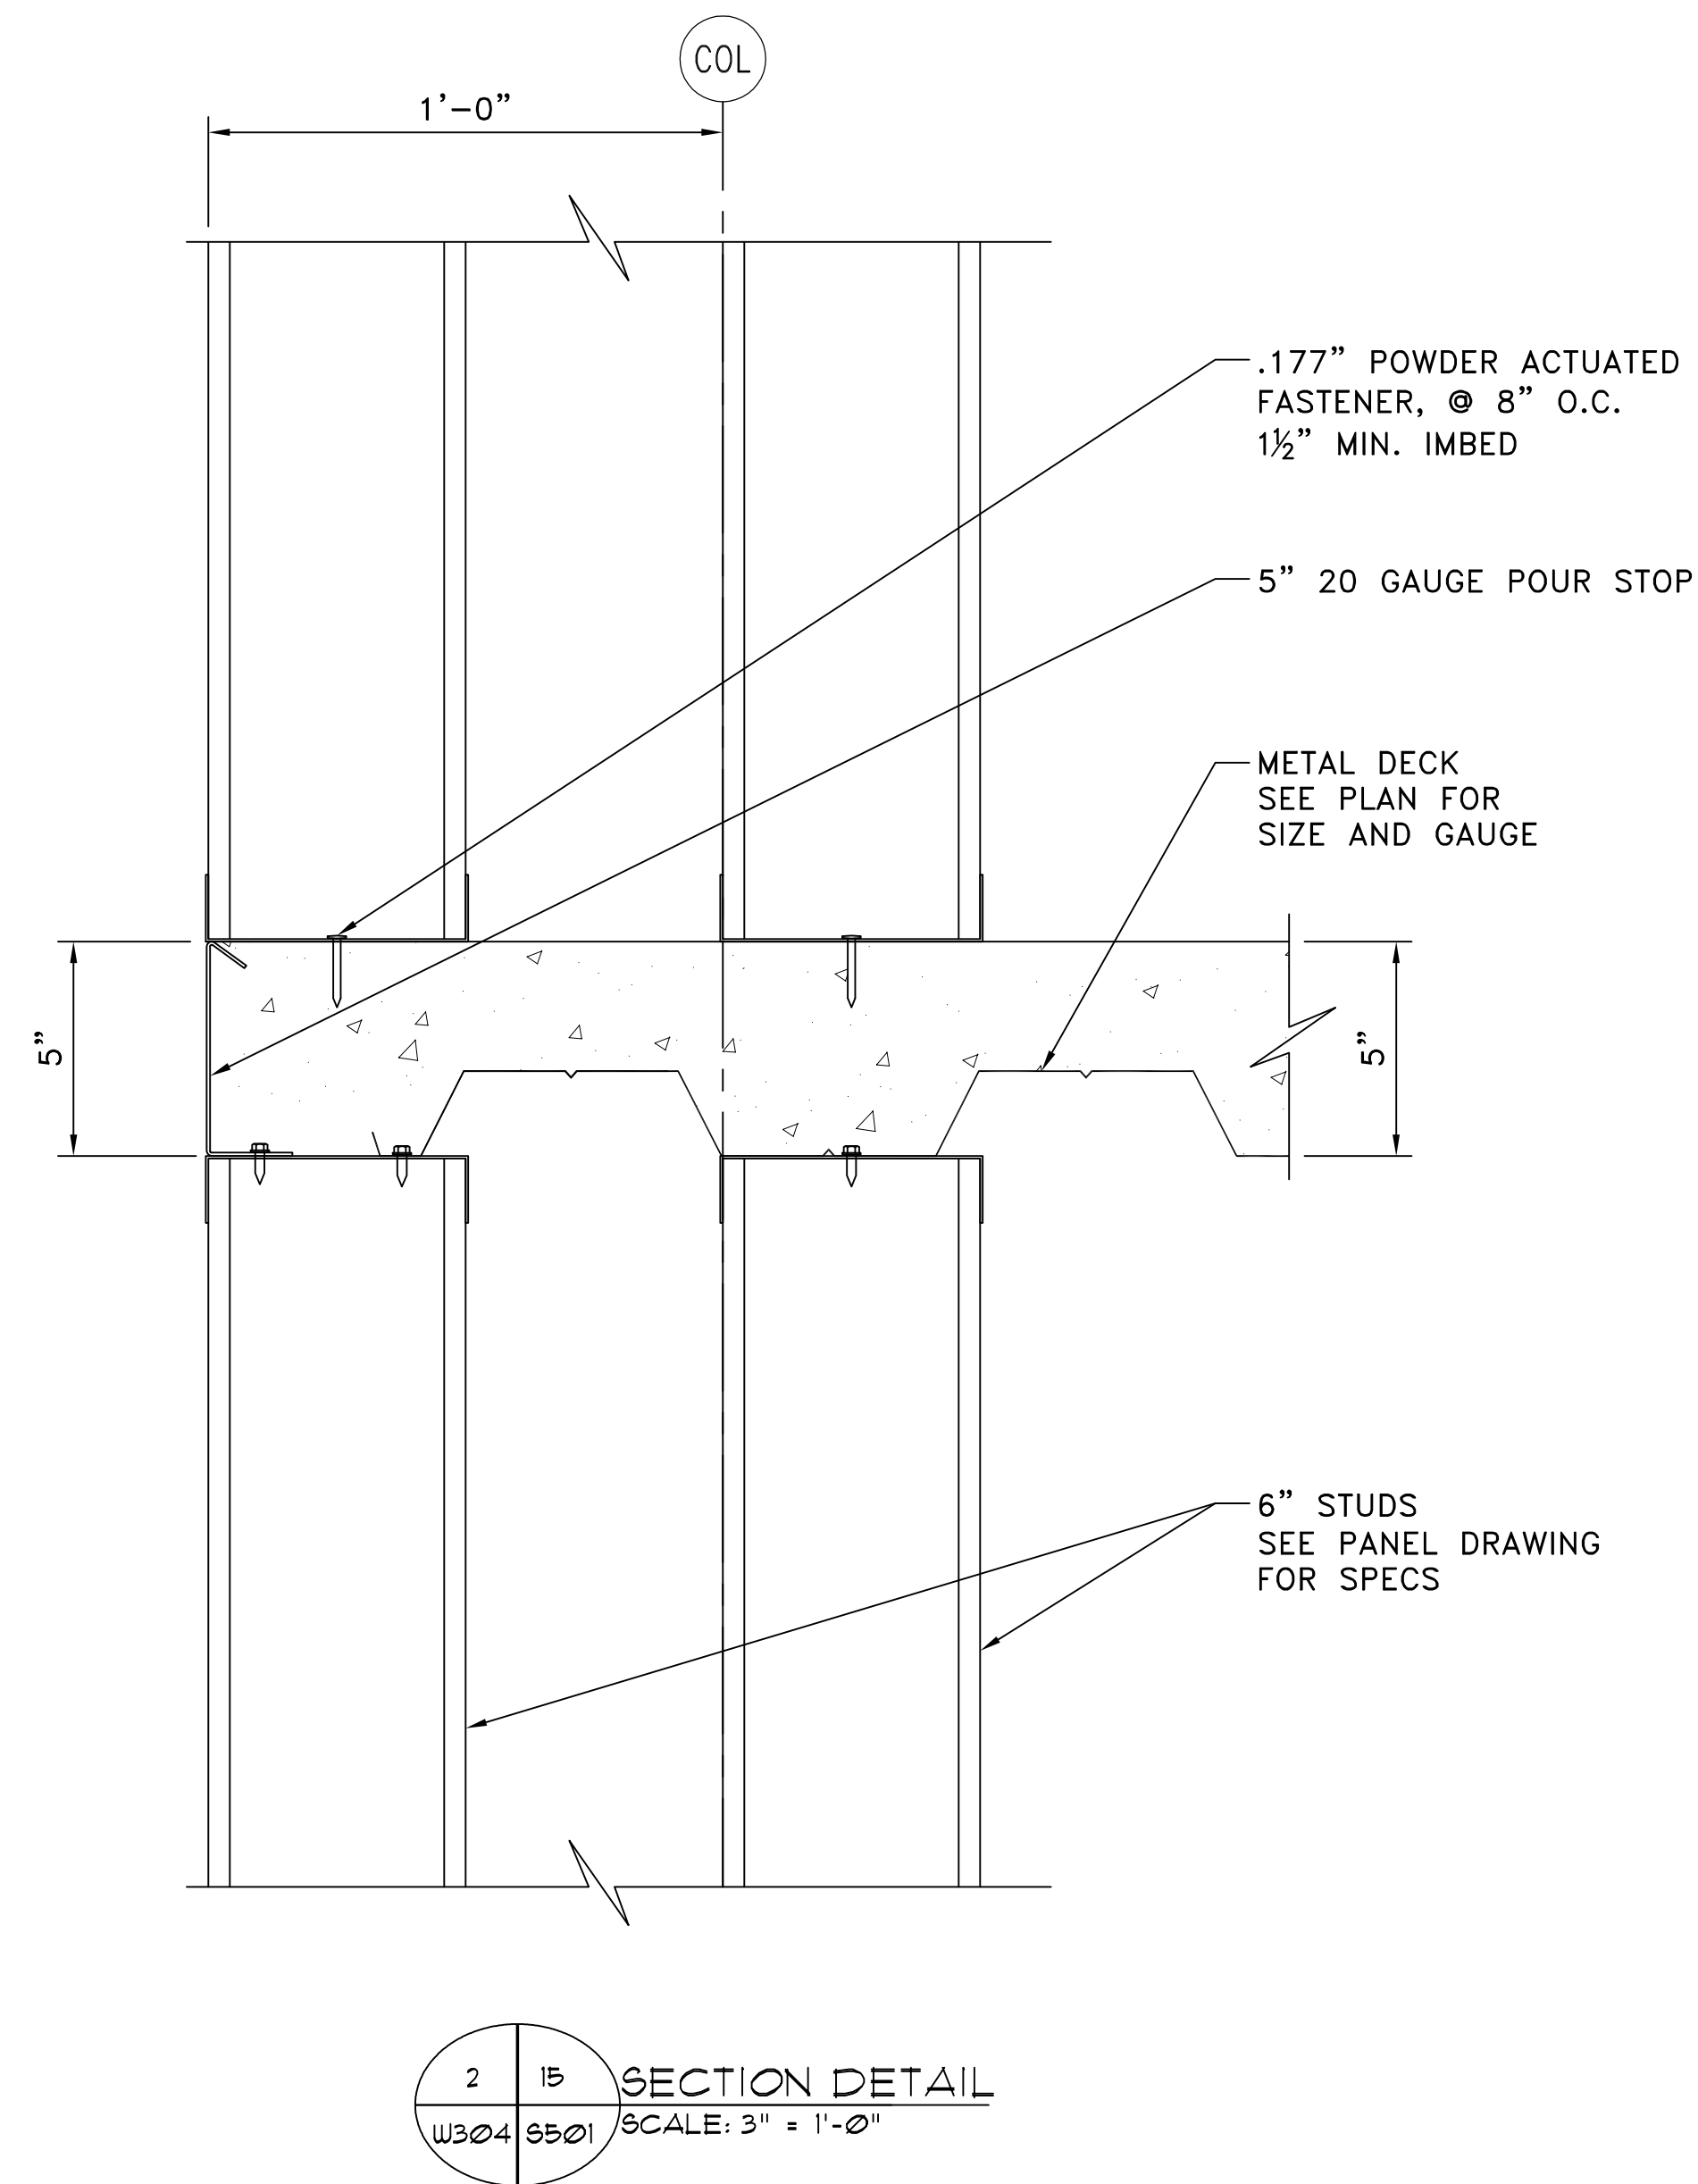

SD → SCALED DIMENSION. PLEASE VERIFY.

Home2 Suites
Flowood, MS

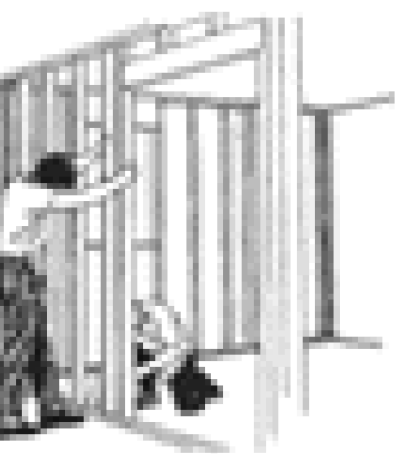






PANELIZERS, LLC
1695 HWY 161
WALLS, MS 38680
PHONE: (662) 996-5260
FAX: (662) 996-5262

Shop Drawings by:
HILLMAN ENTERPRISES, INC.
P.O. Box 106
Graham, AL 36263
PHONE: (256) 449-9261


Sheet Number:
W304

Job Number:
1605/1655

Date:
02/02/17

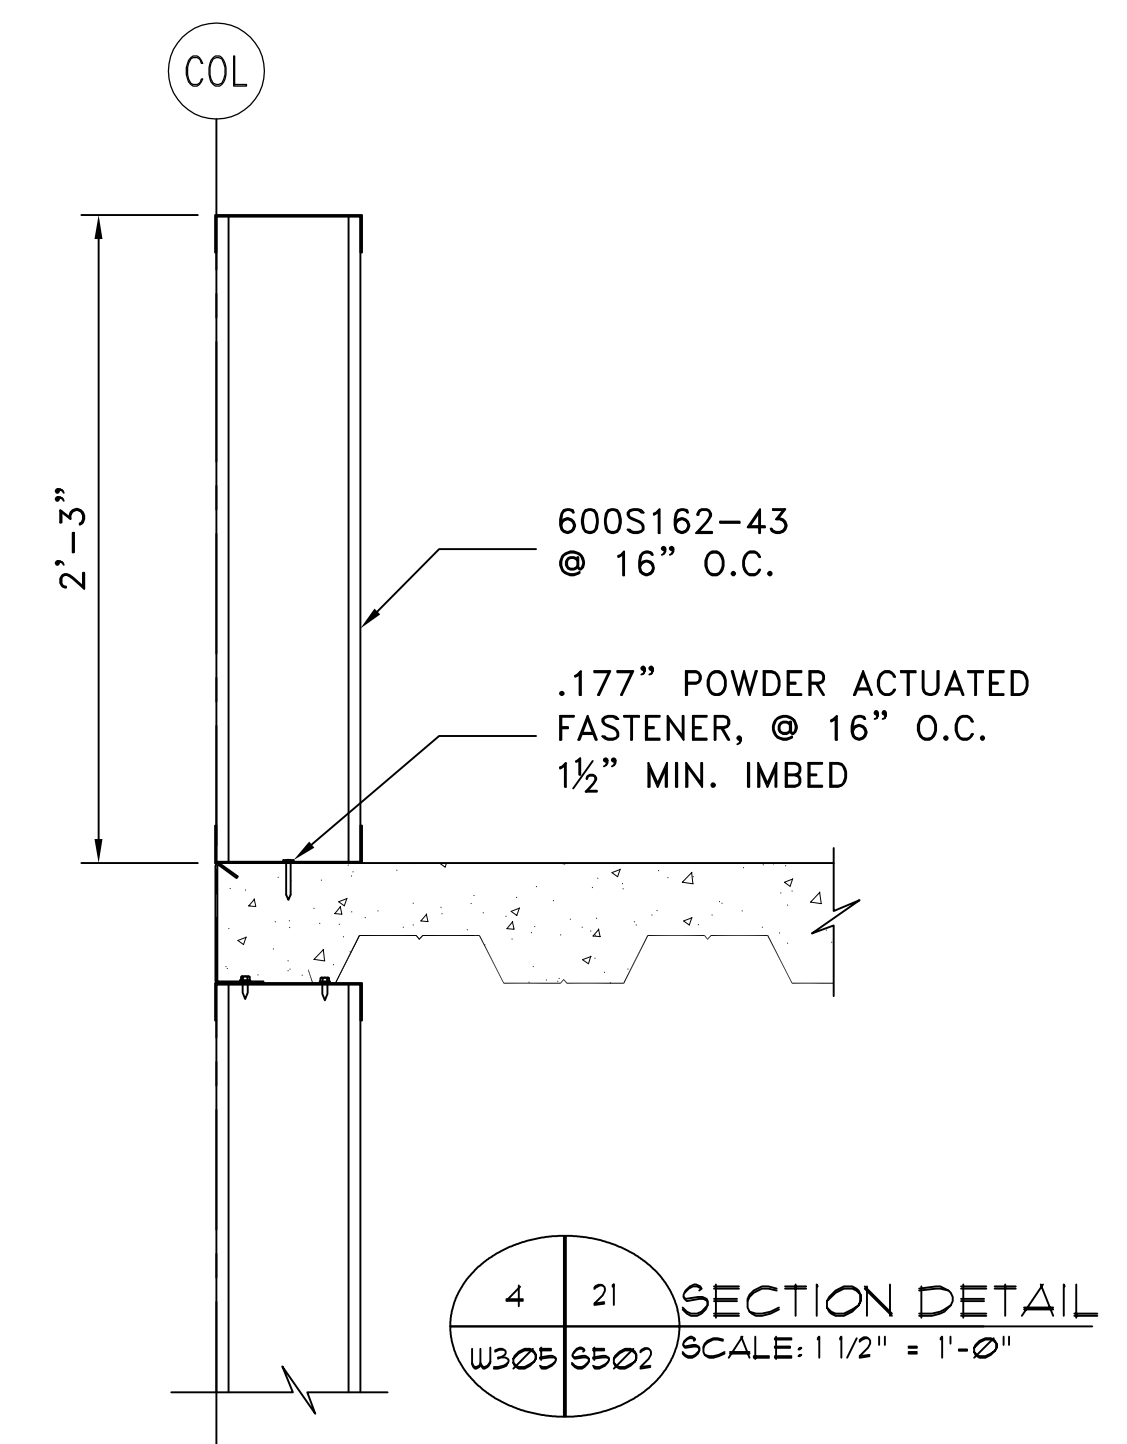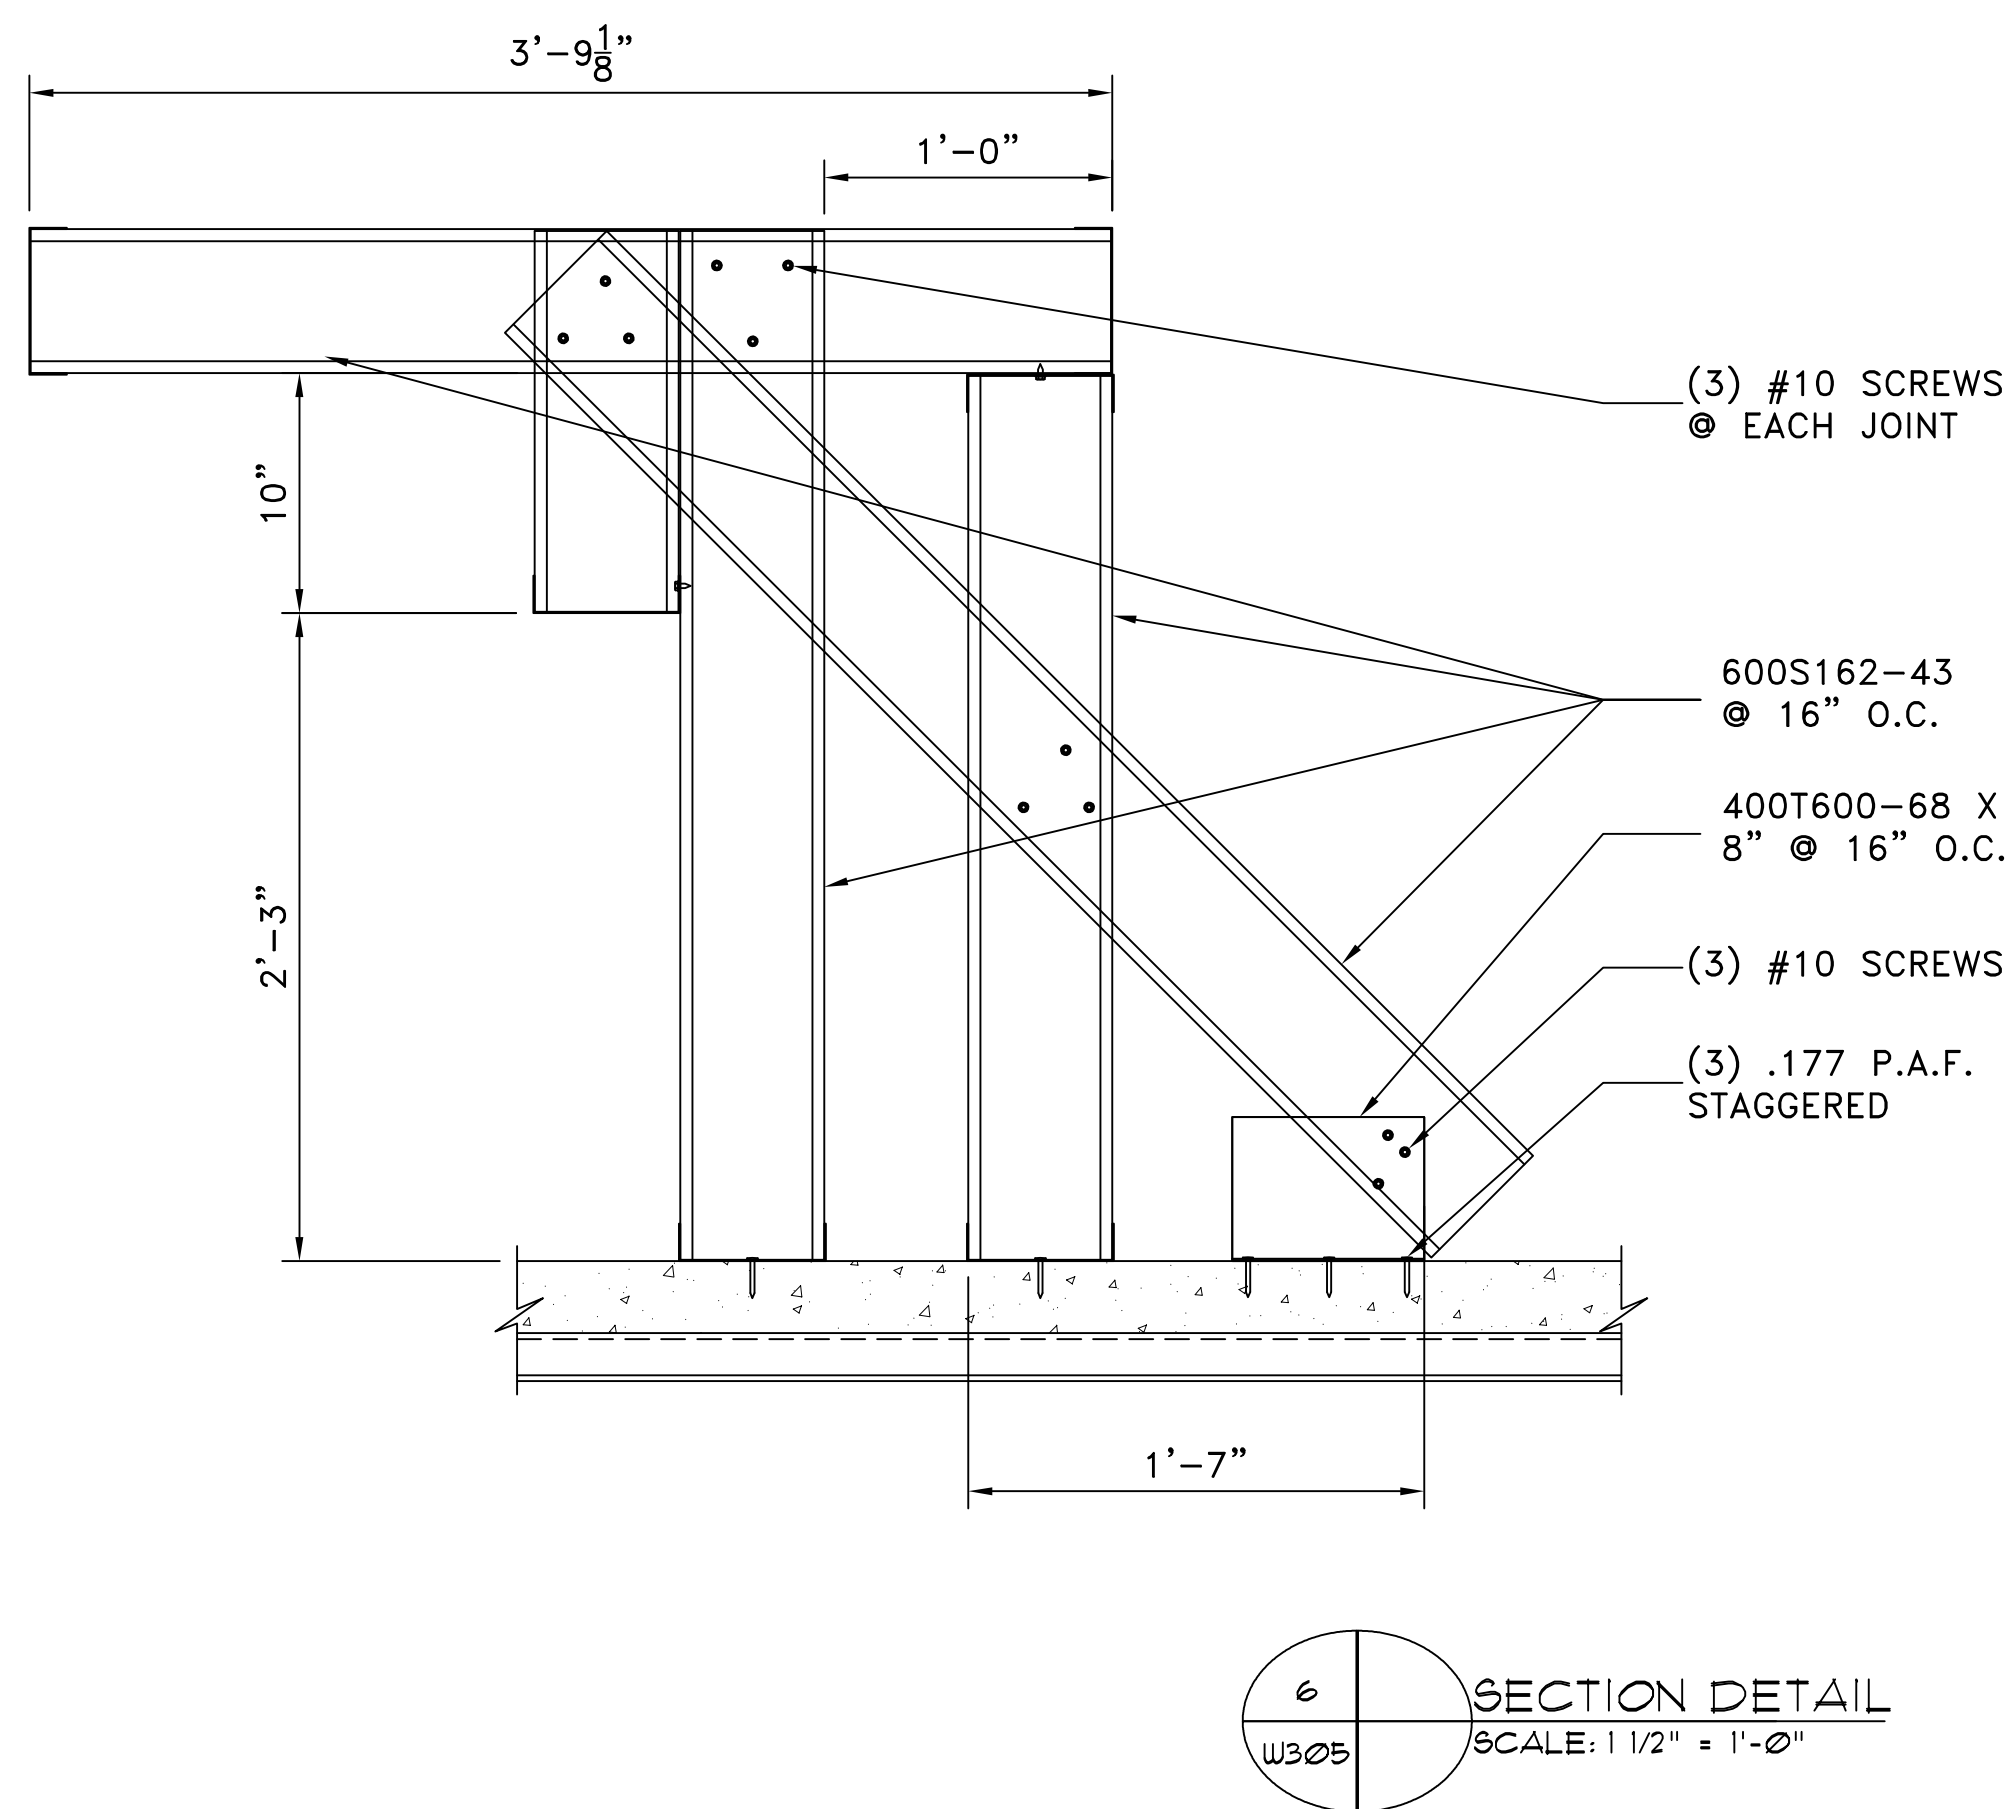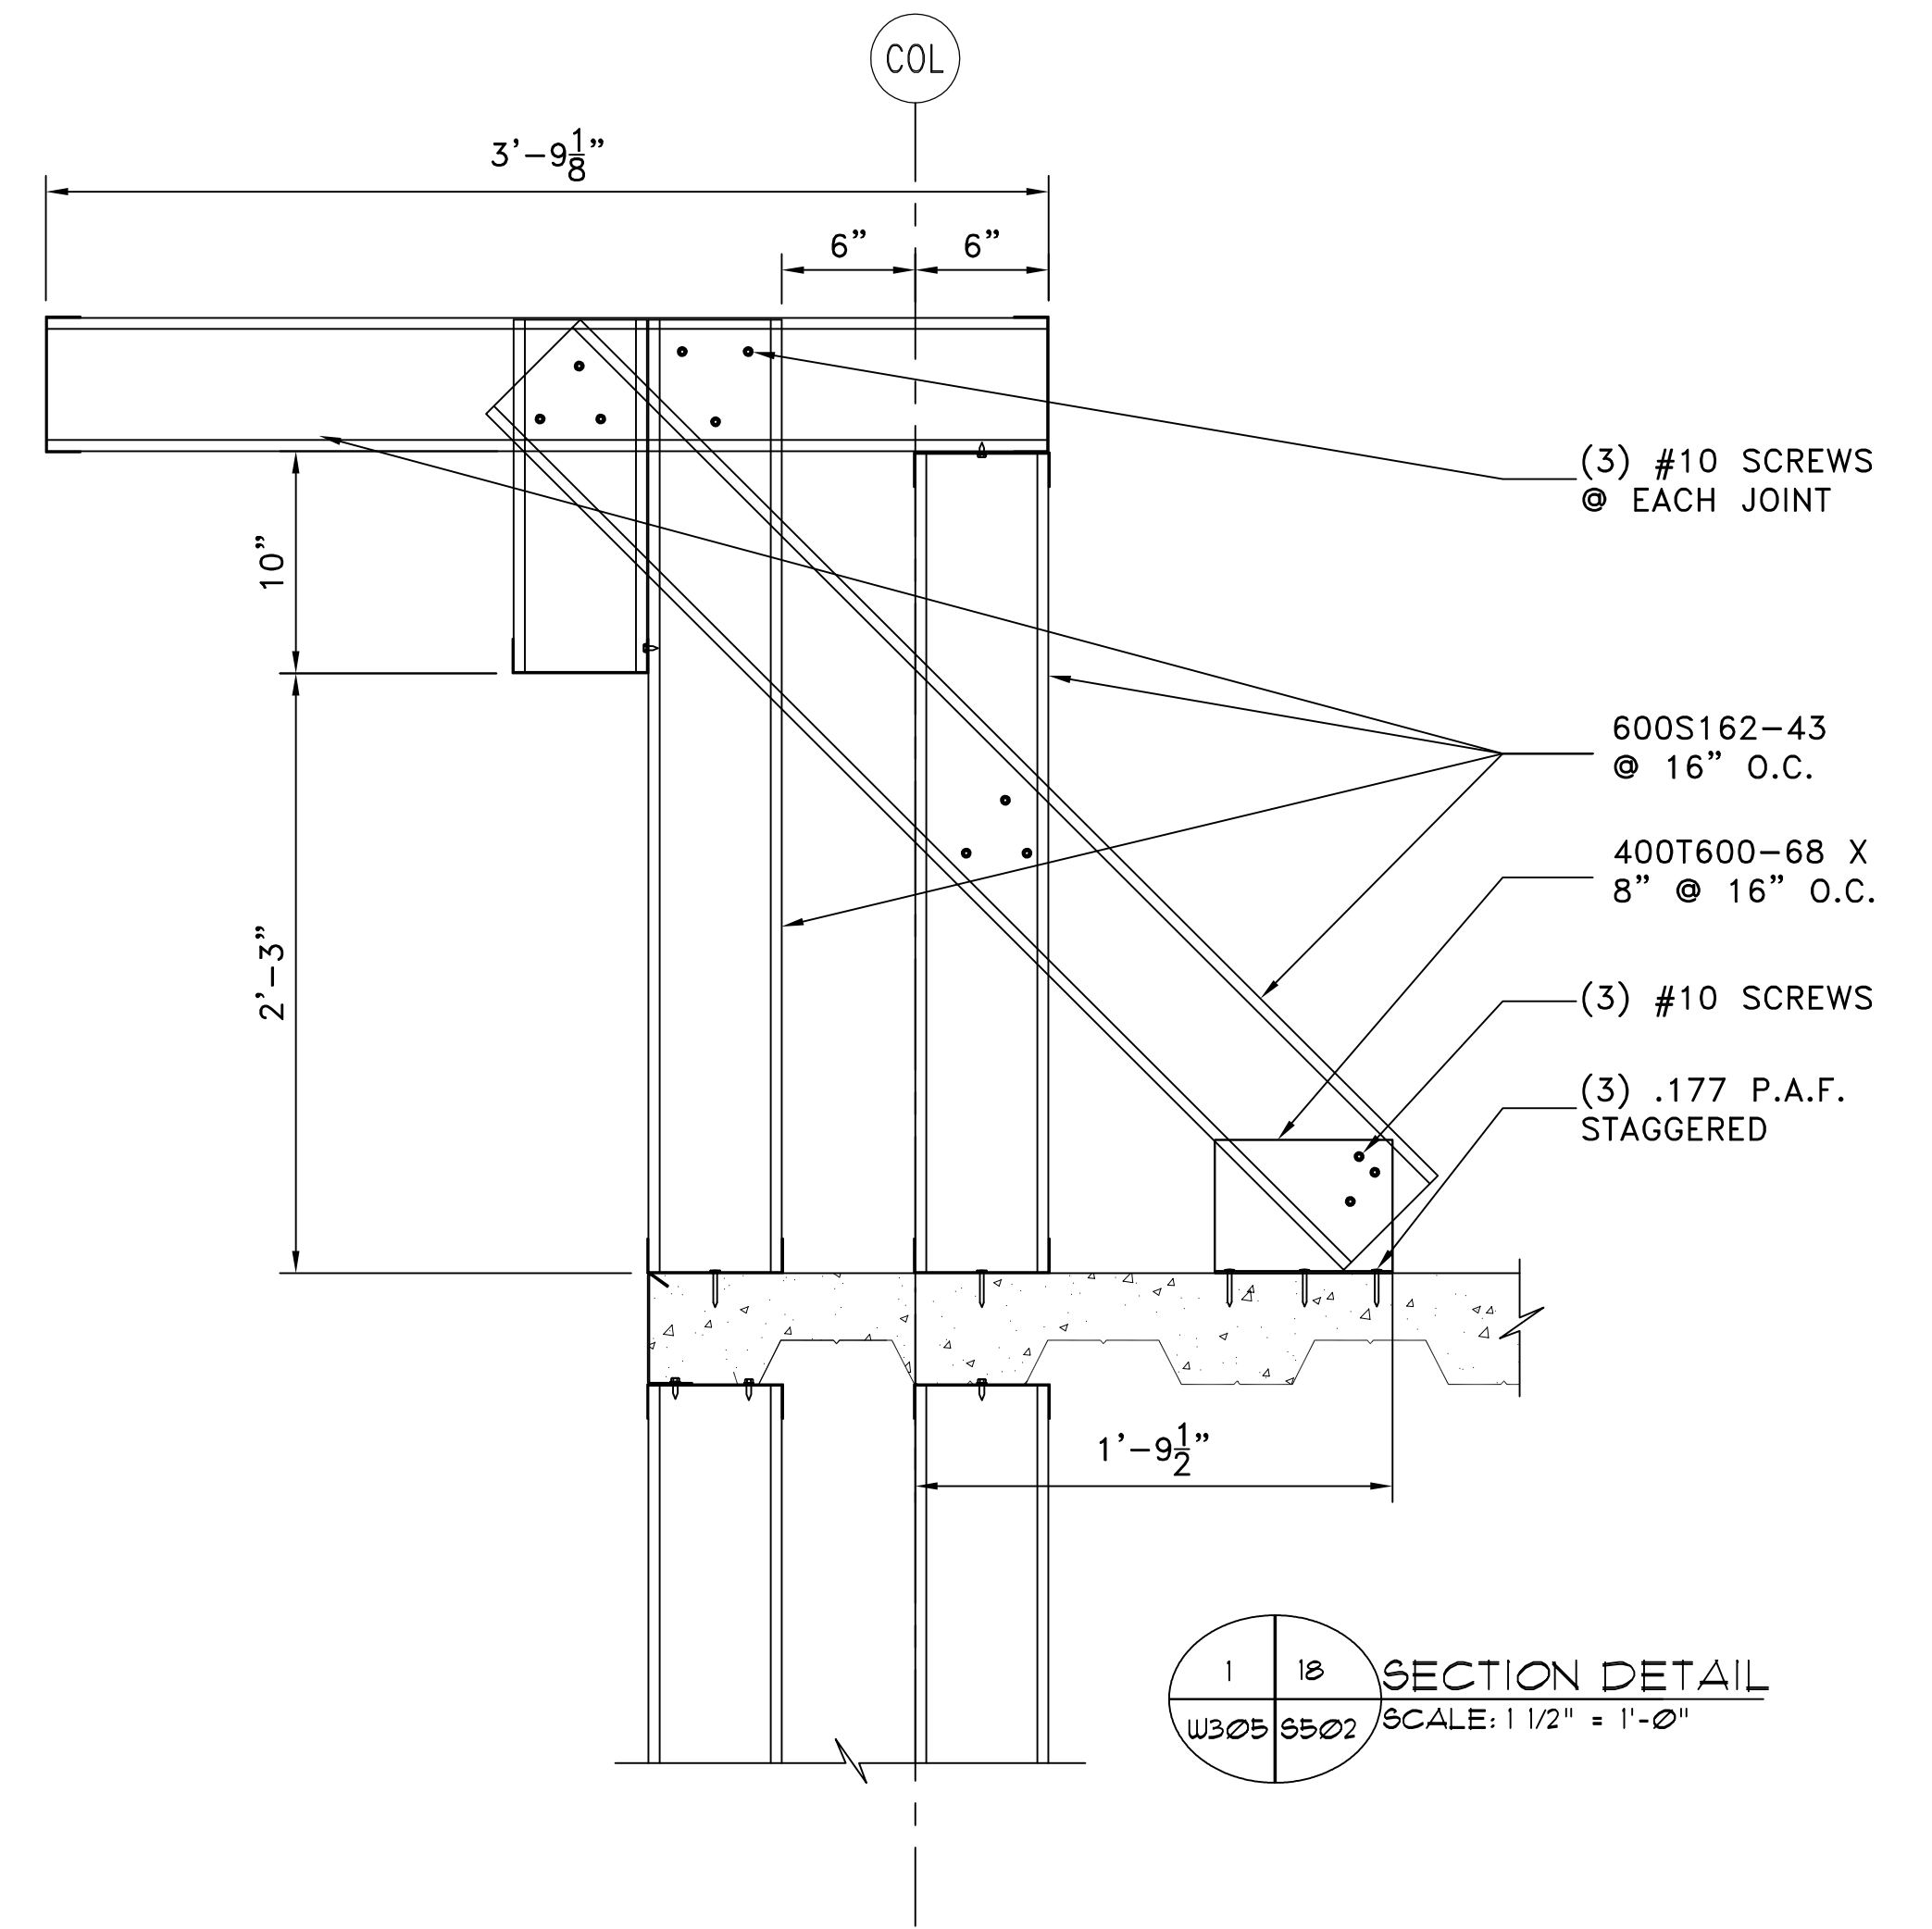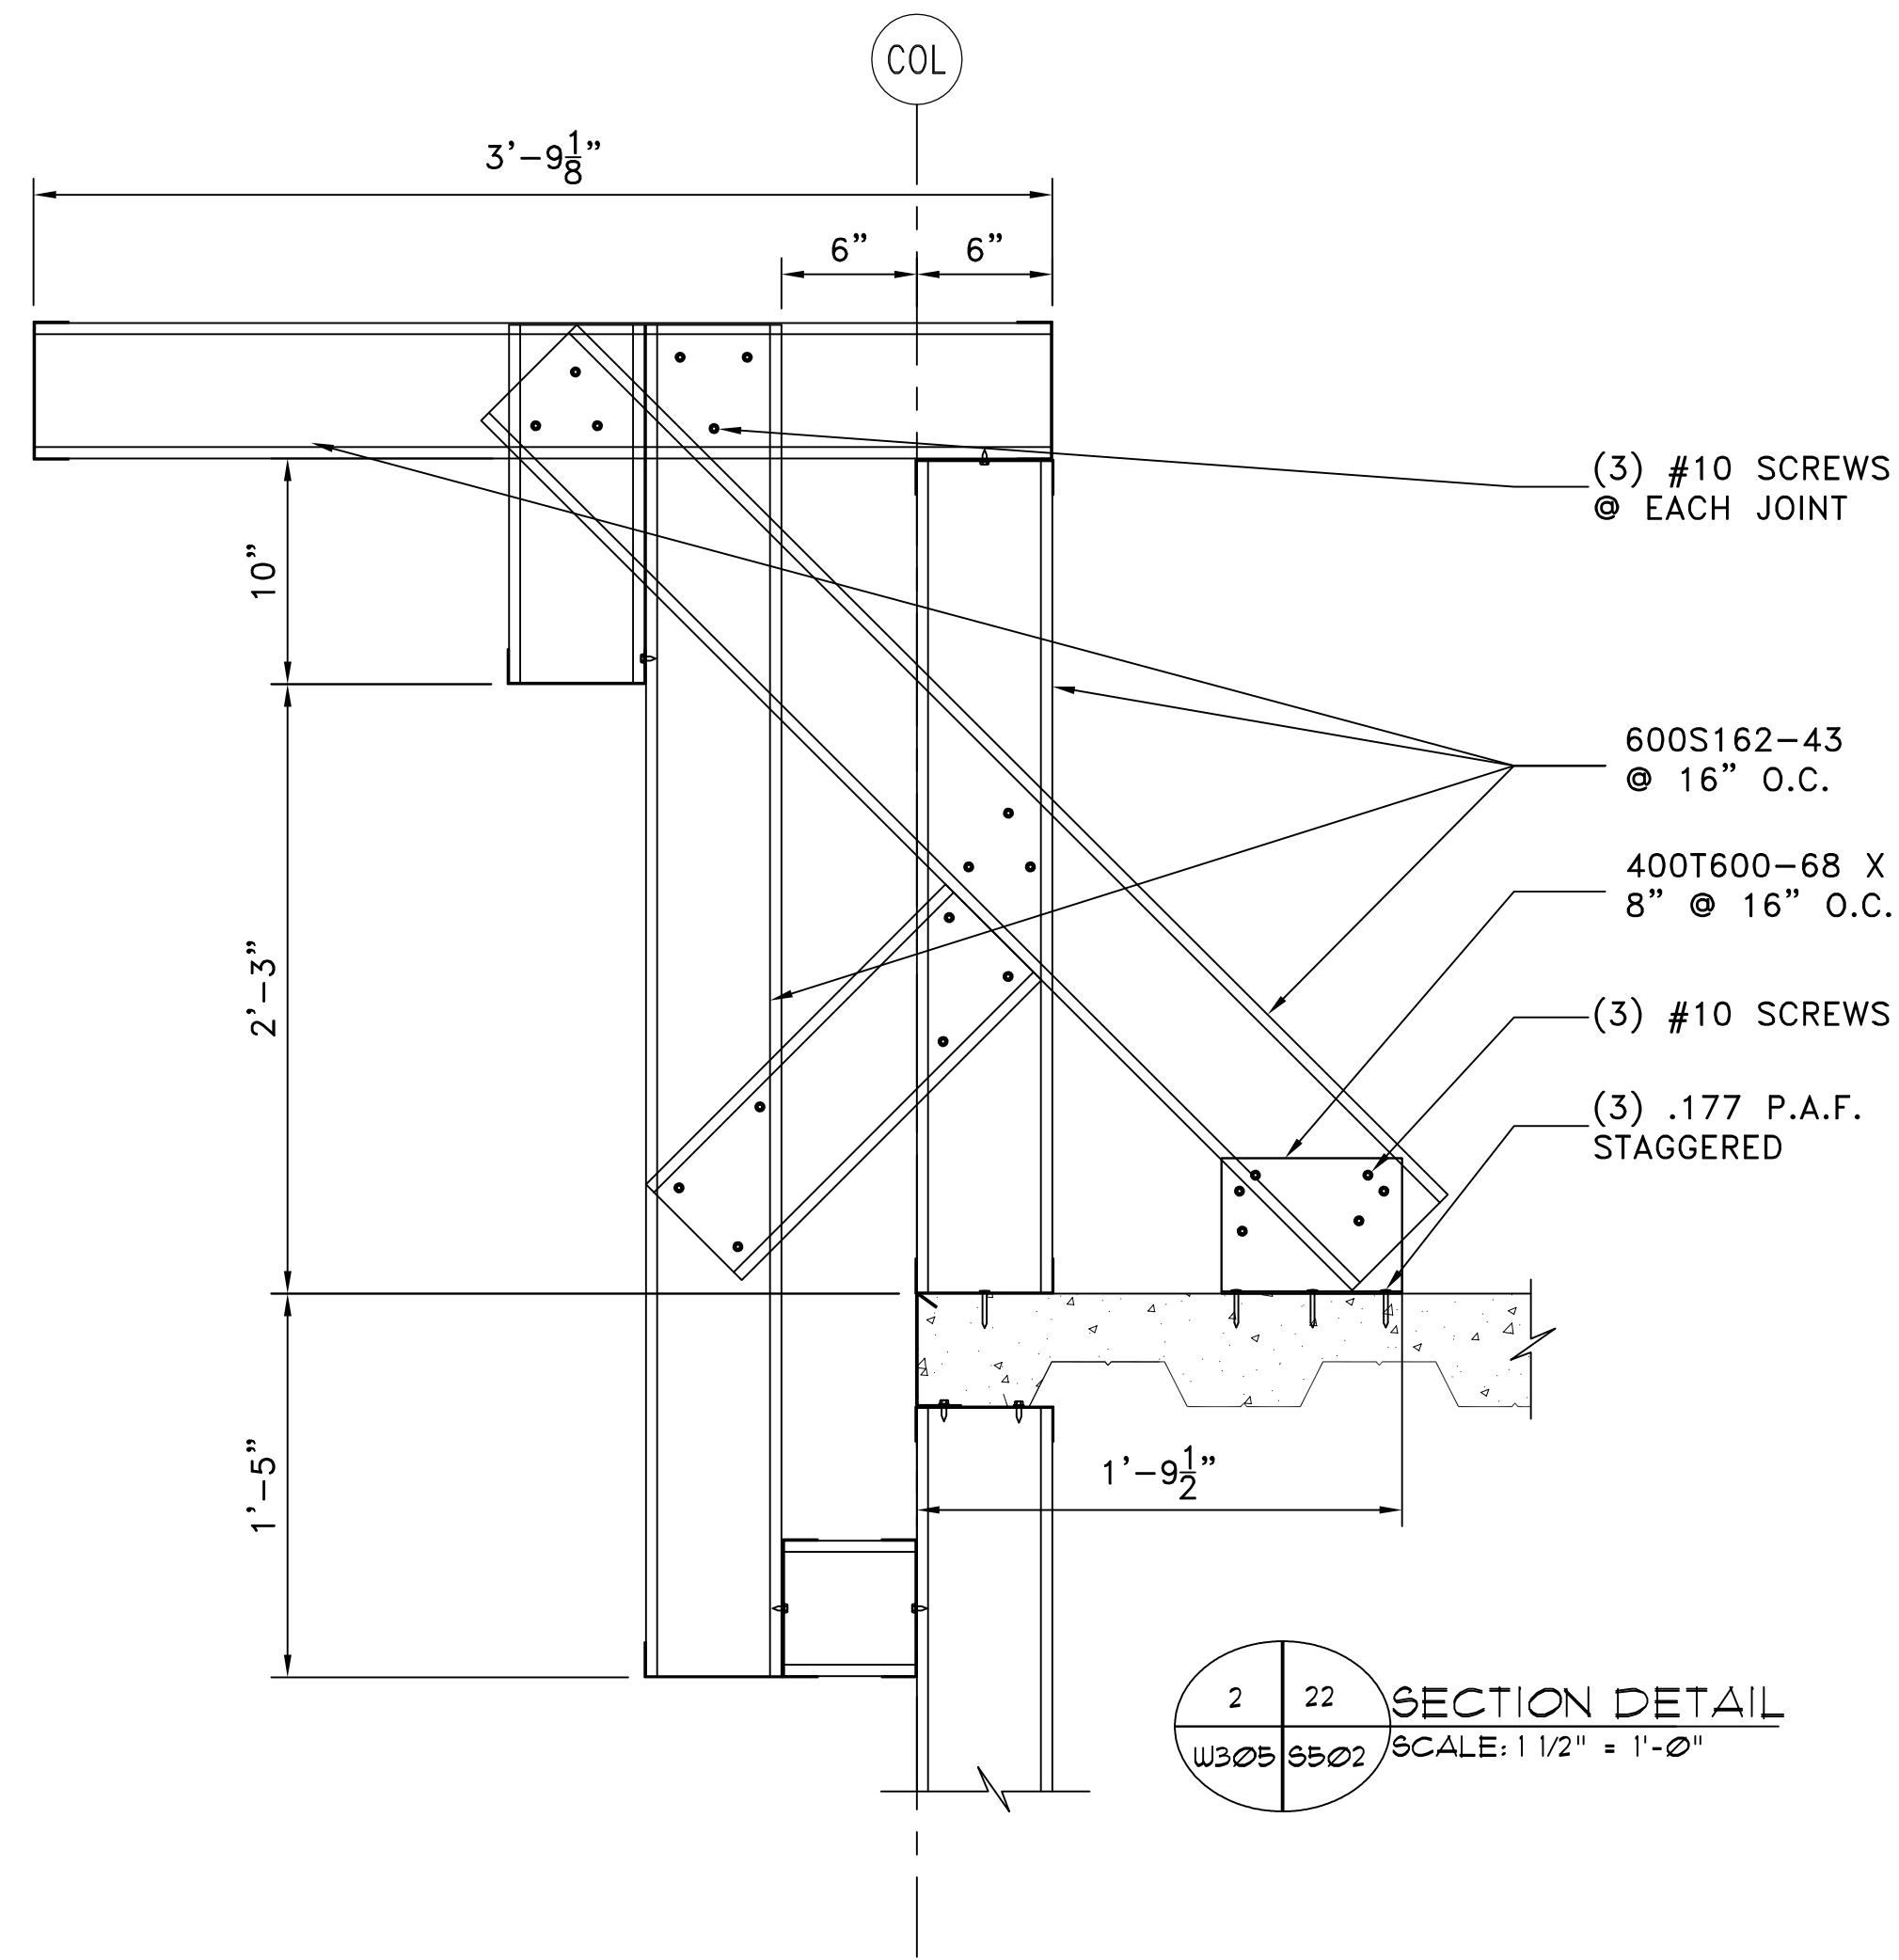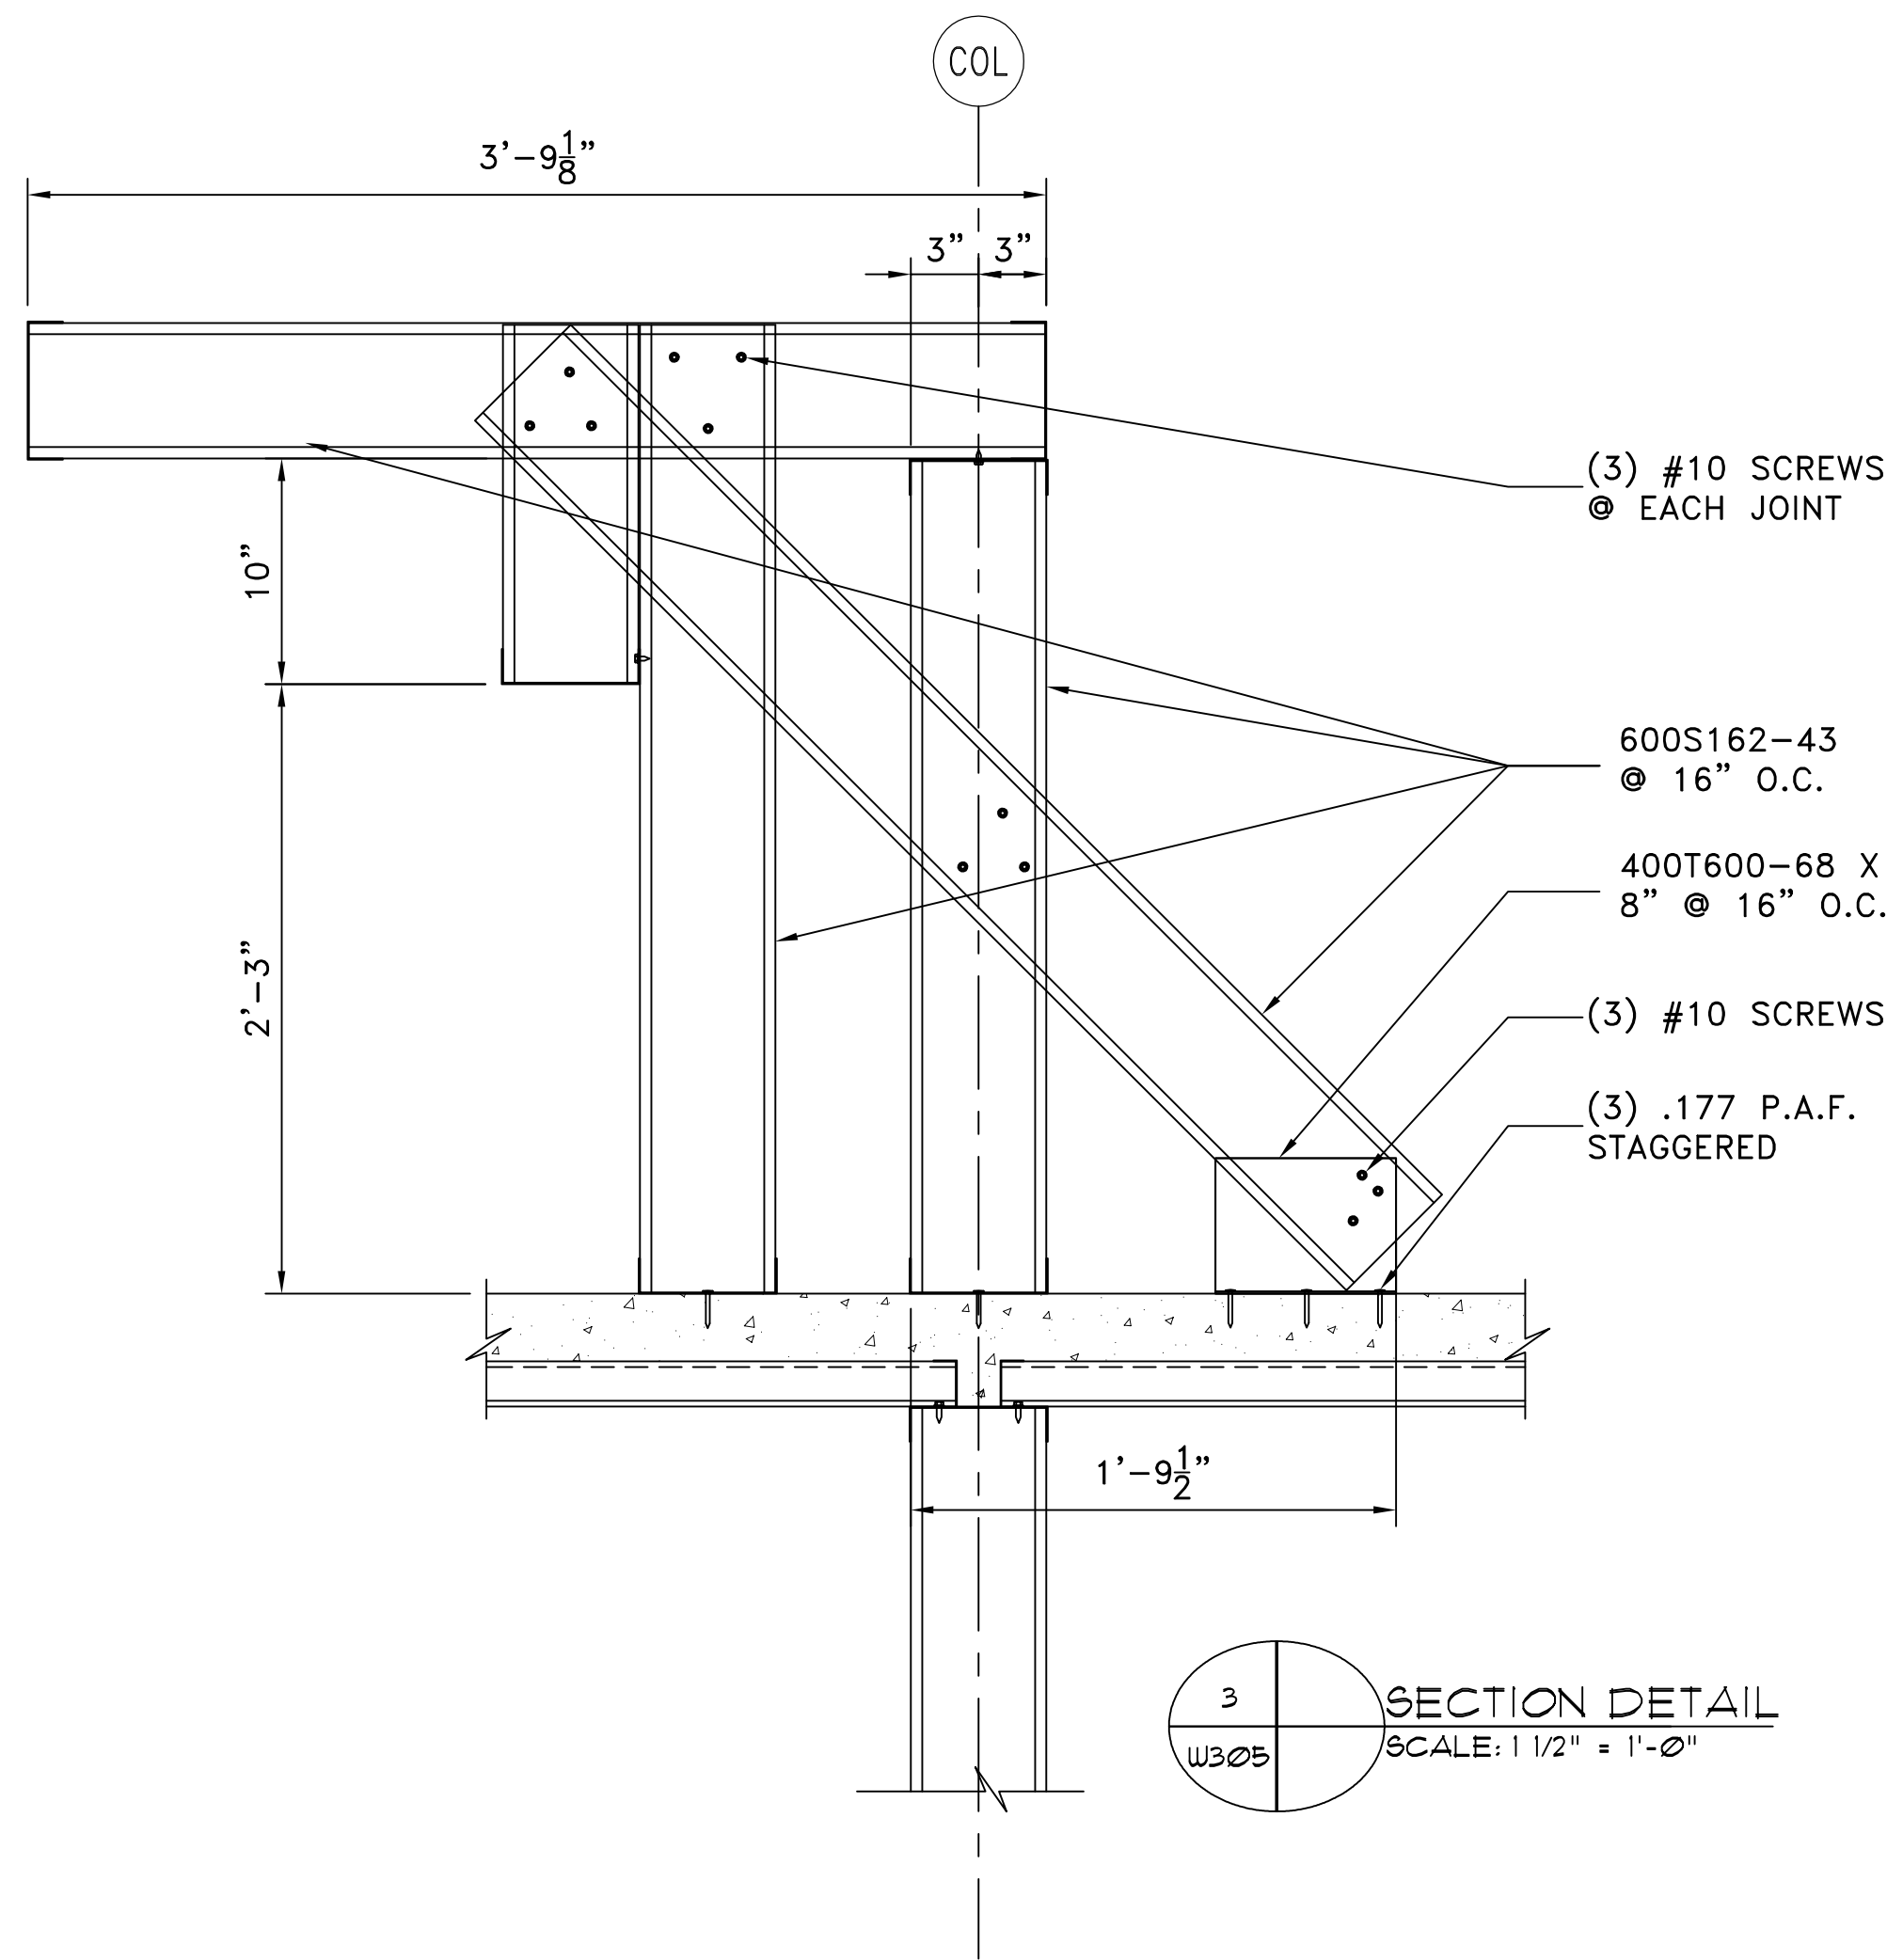

Home2 Suites
Flowood, MS

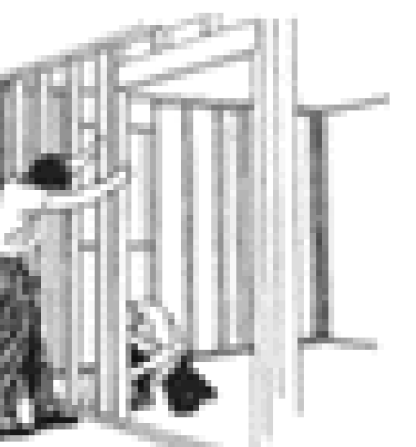




PANELIZERS, LLC
7695 HWY 161
WALLS, MS 38680
PHONE: (662) 936-5260
FAX: (662) 936-5262

Shop Drawings by:
HILLMAN ENTERPRISES, INC.
P.O. Box 106
Graham, AL 36263
PHONE: (256) 449-9261

Sheet Number:
W305


Job Number:
1605/1655

Date:
02/02/17

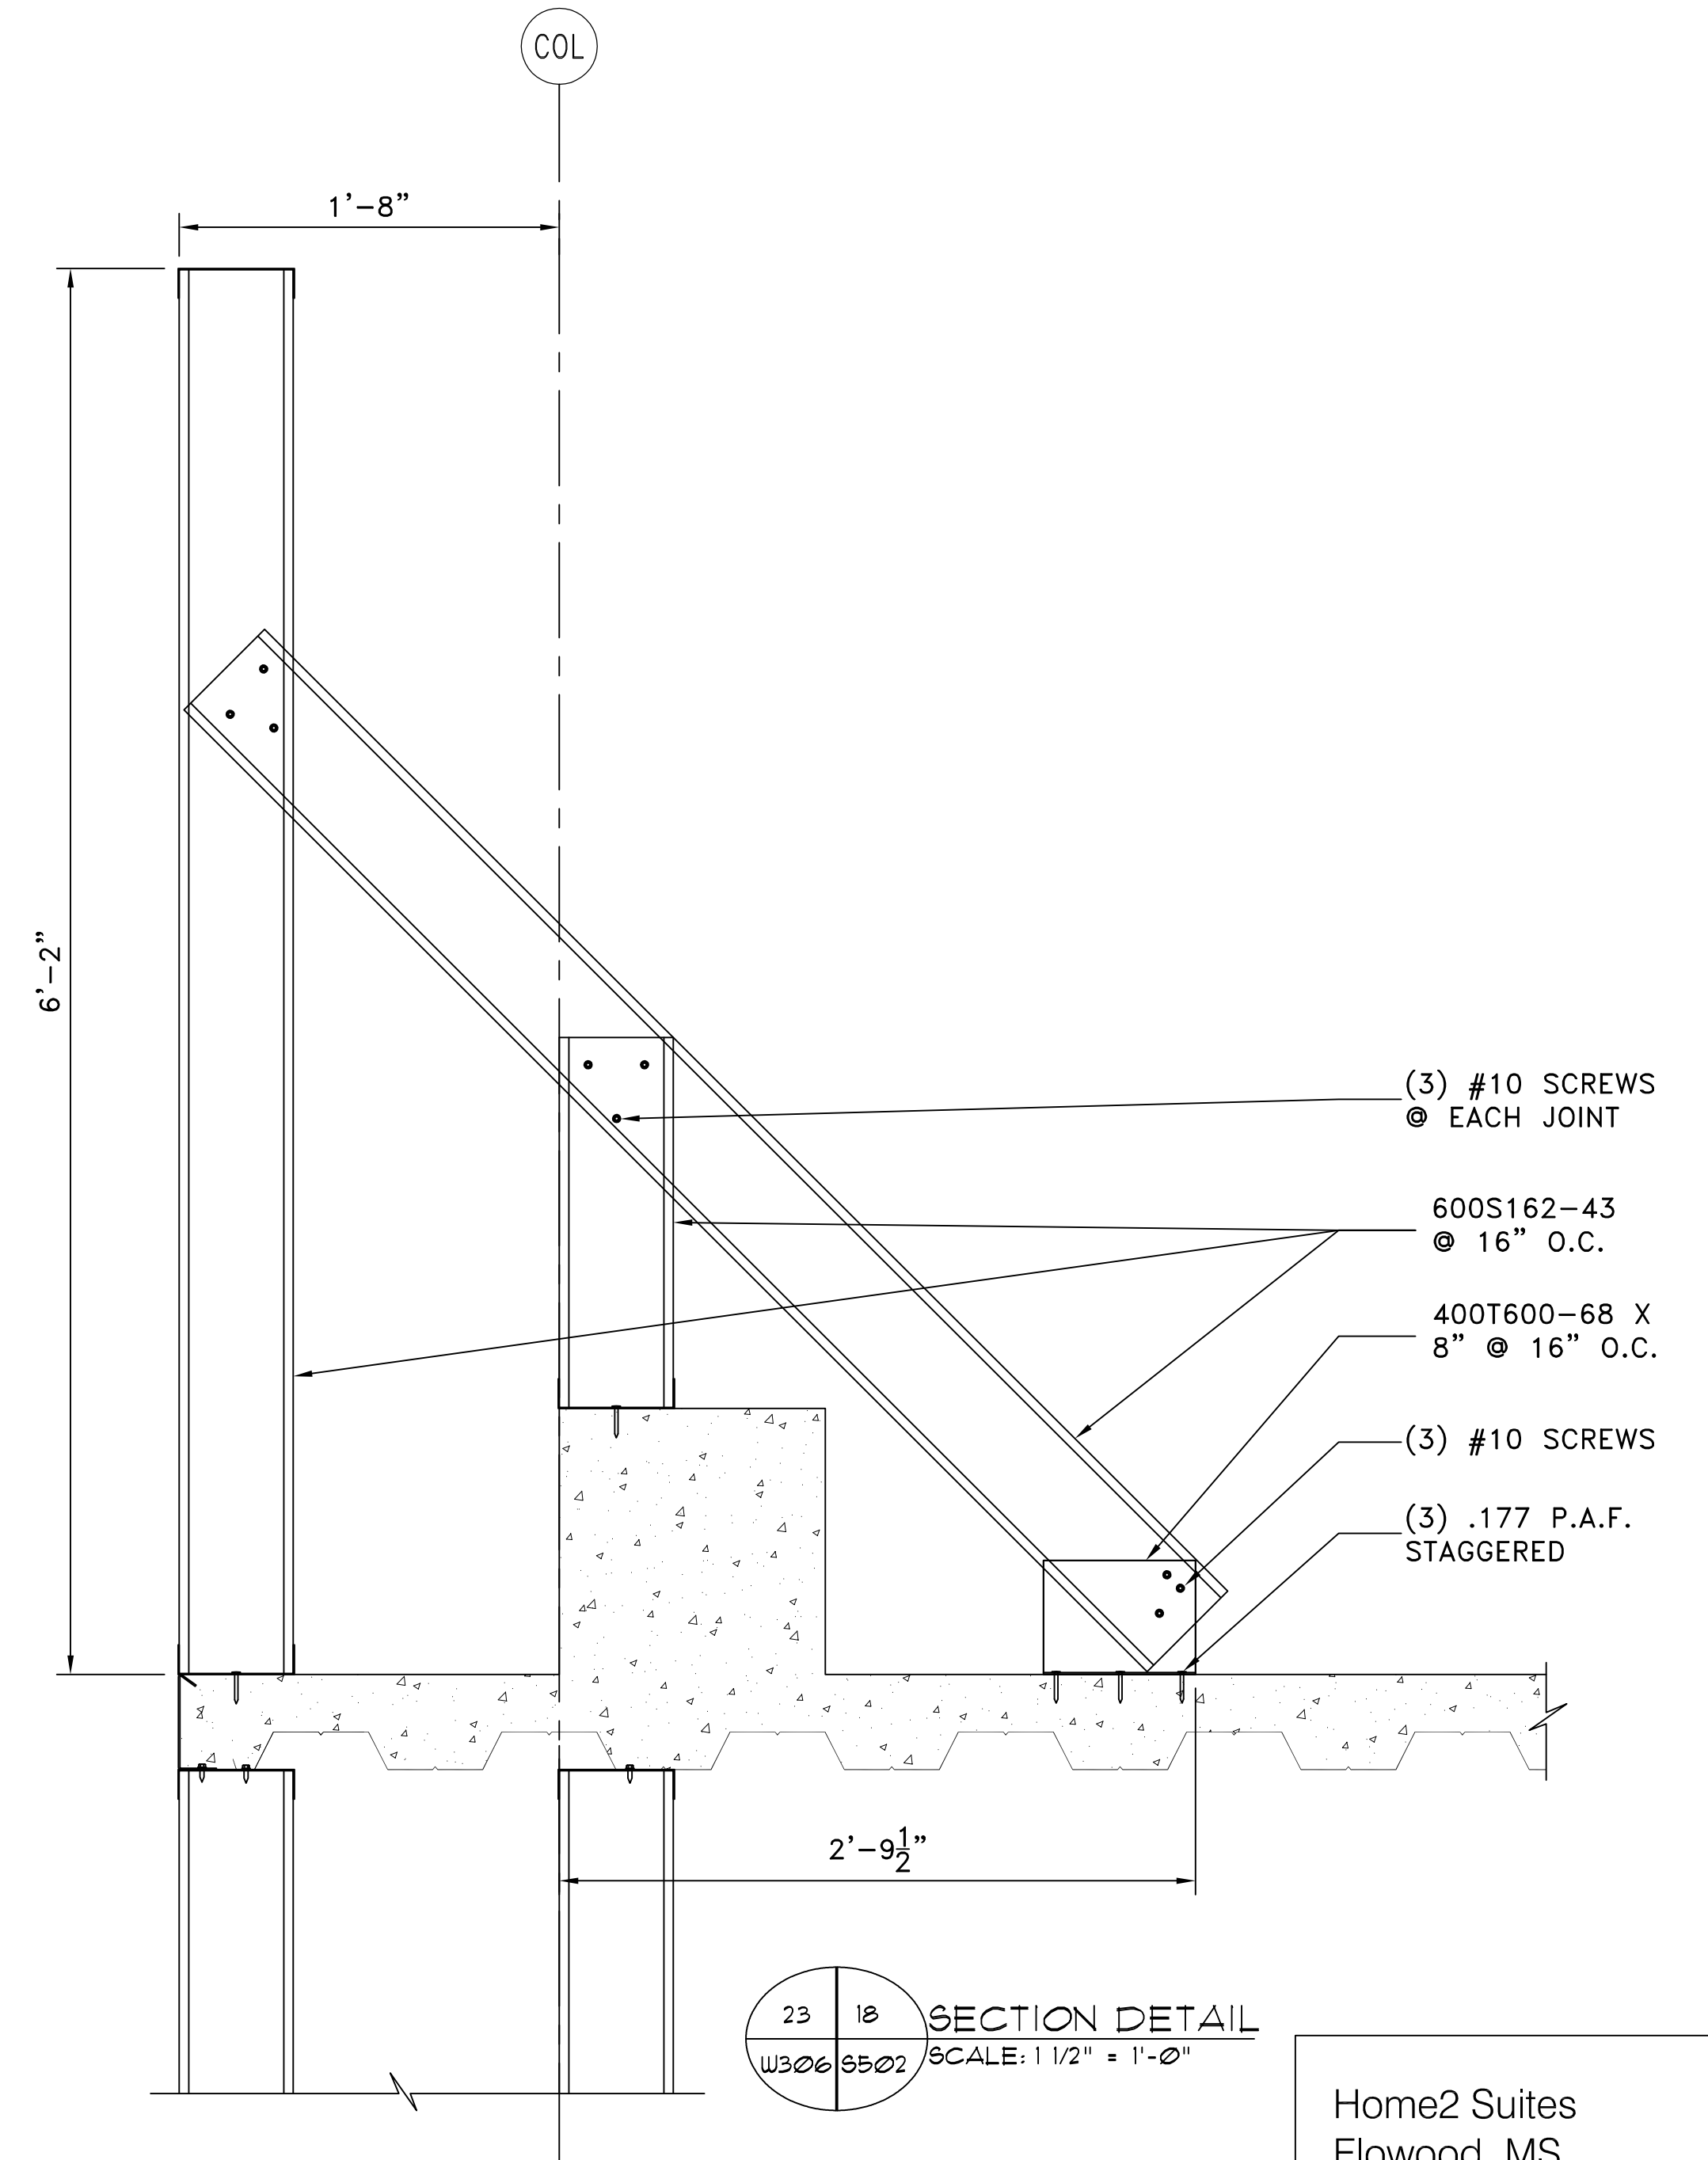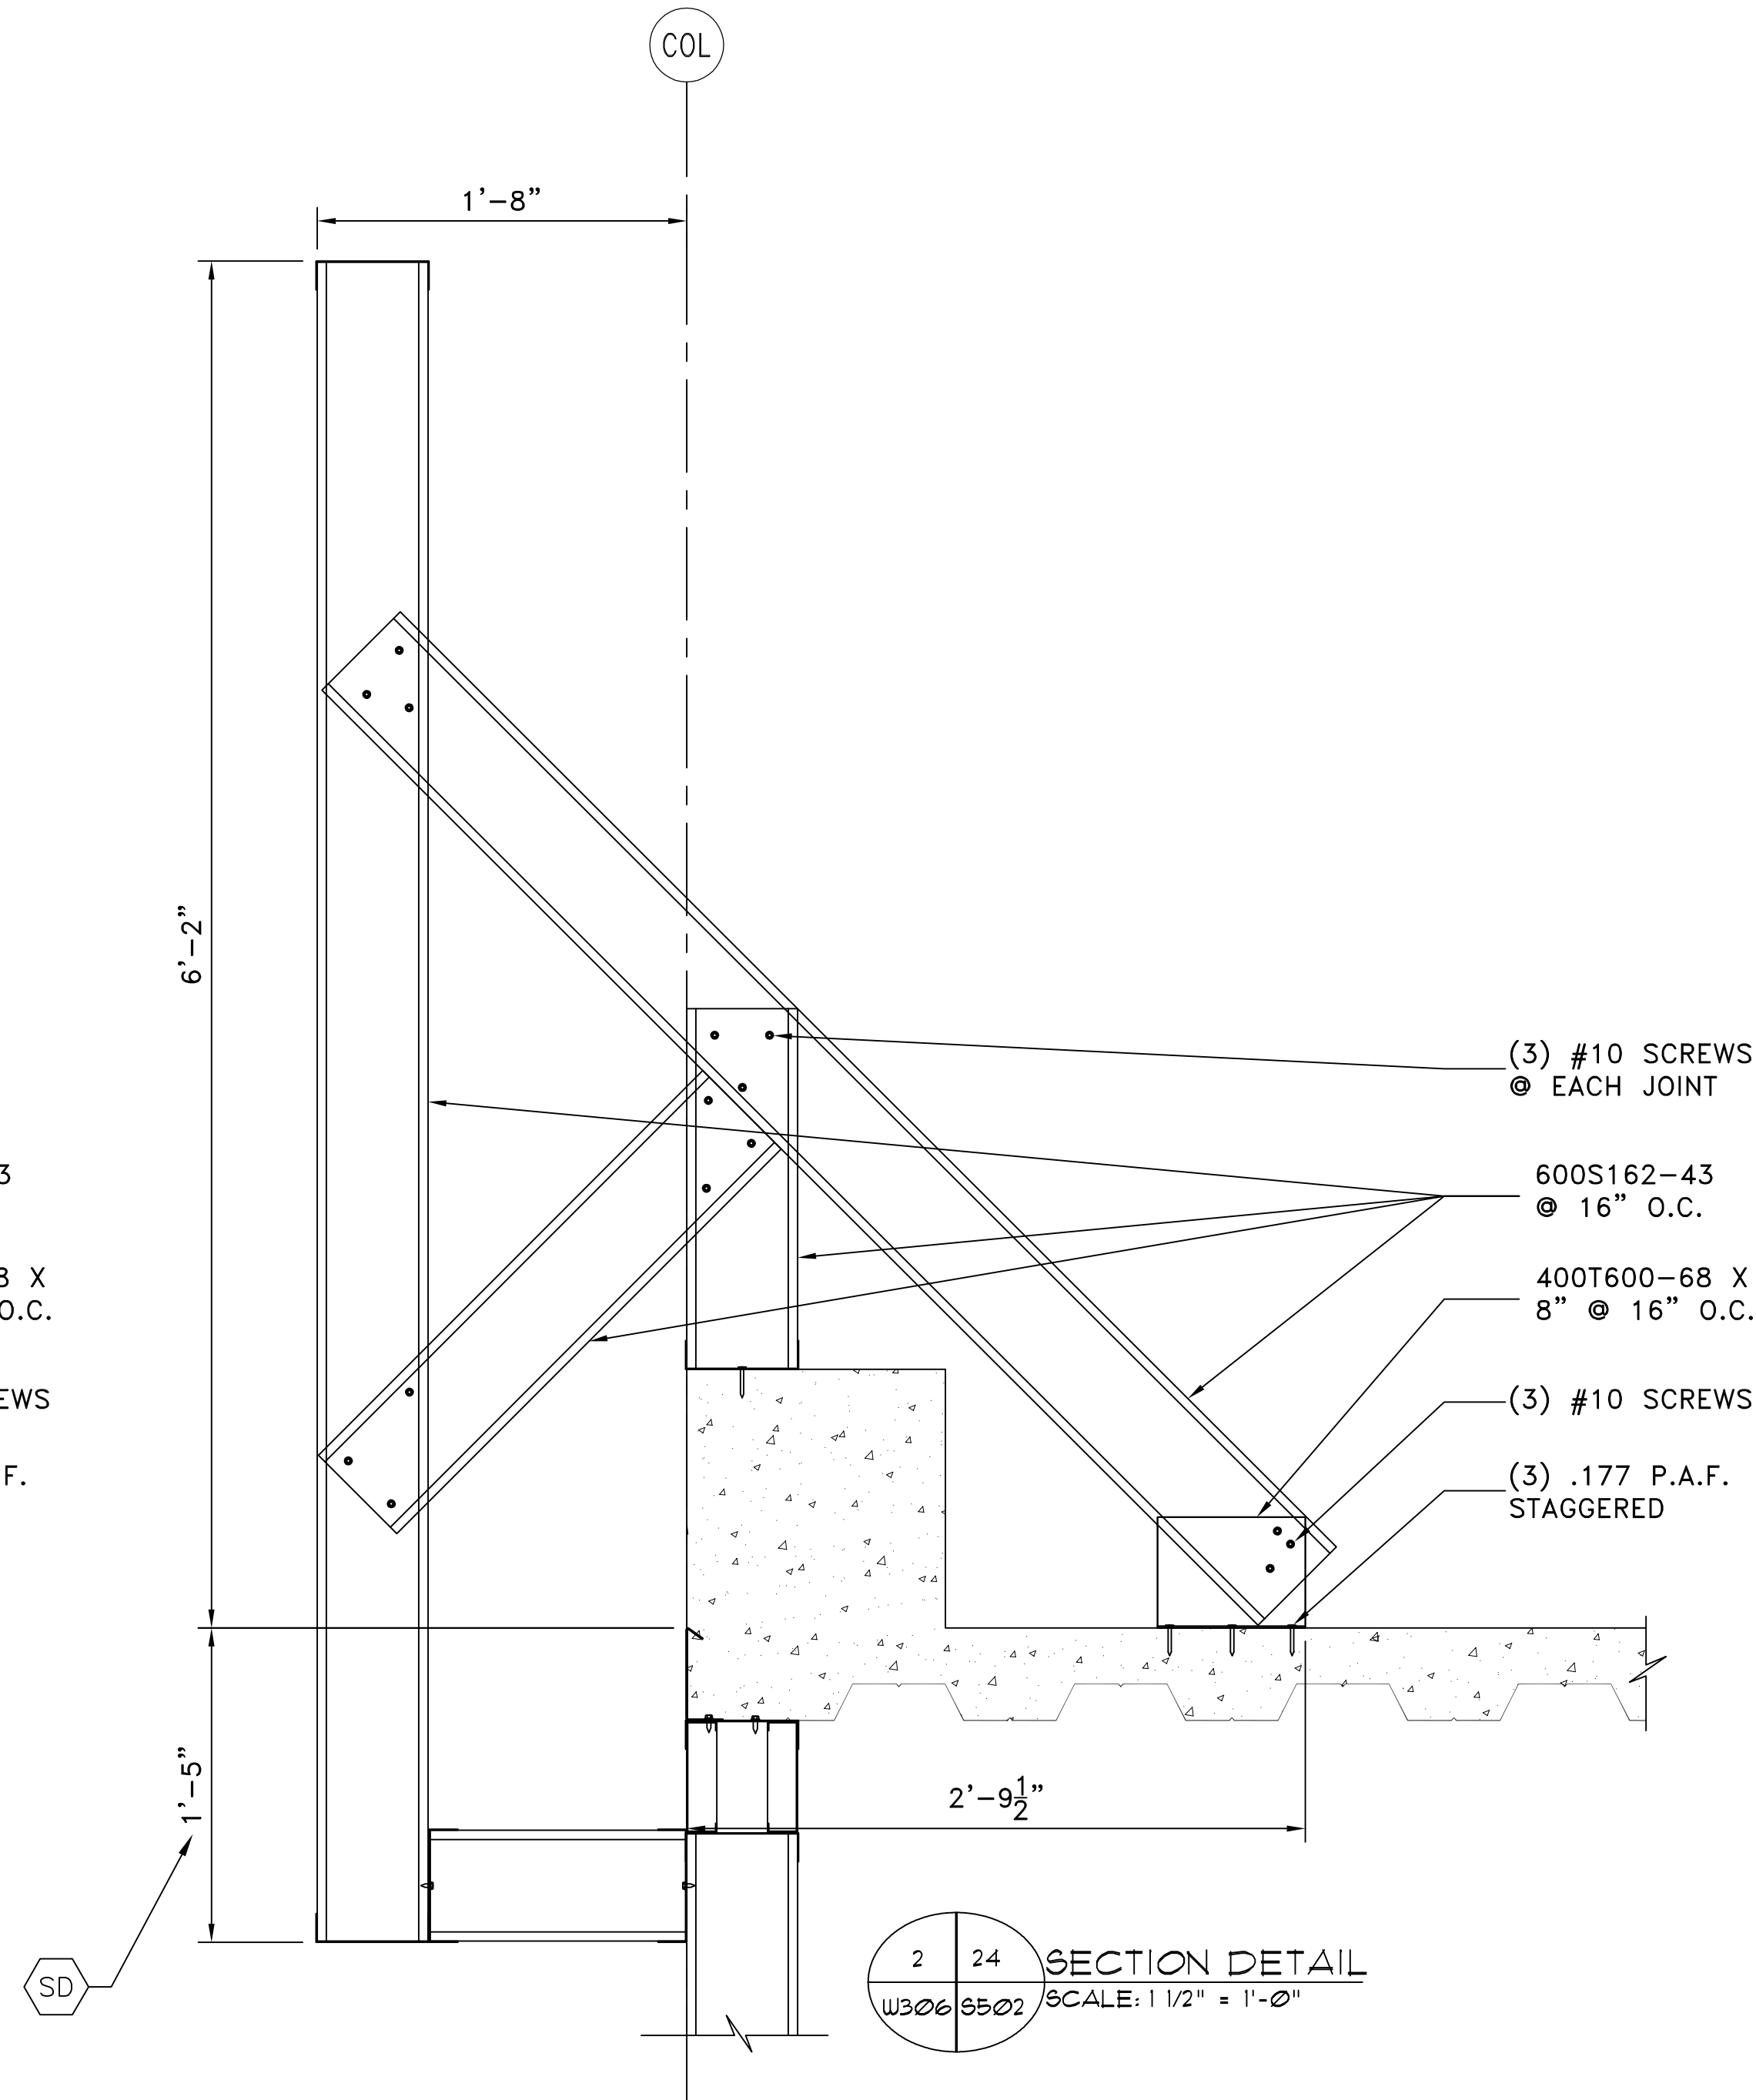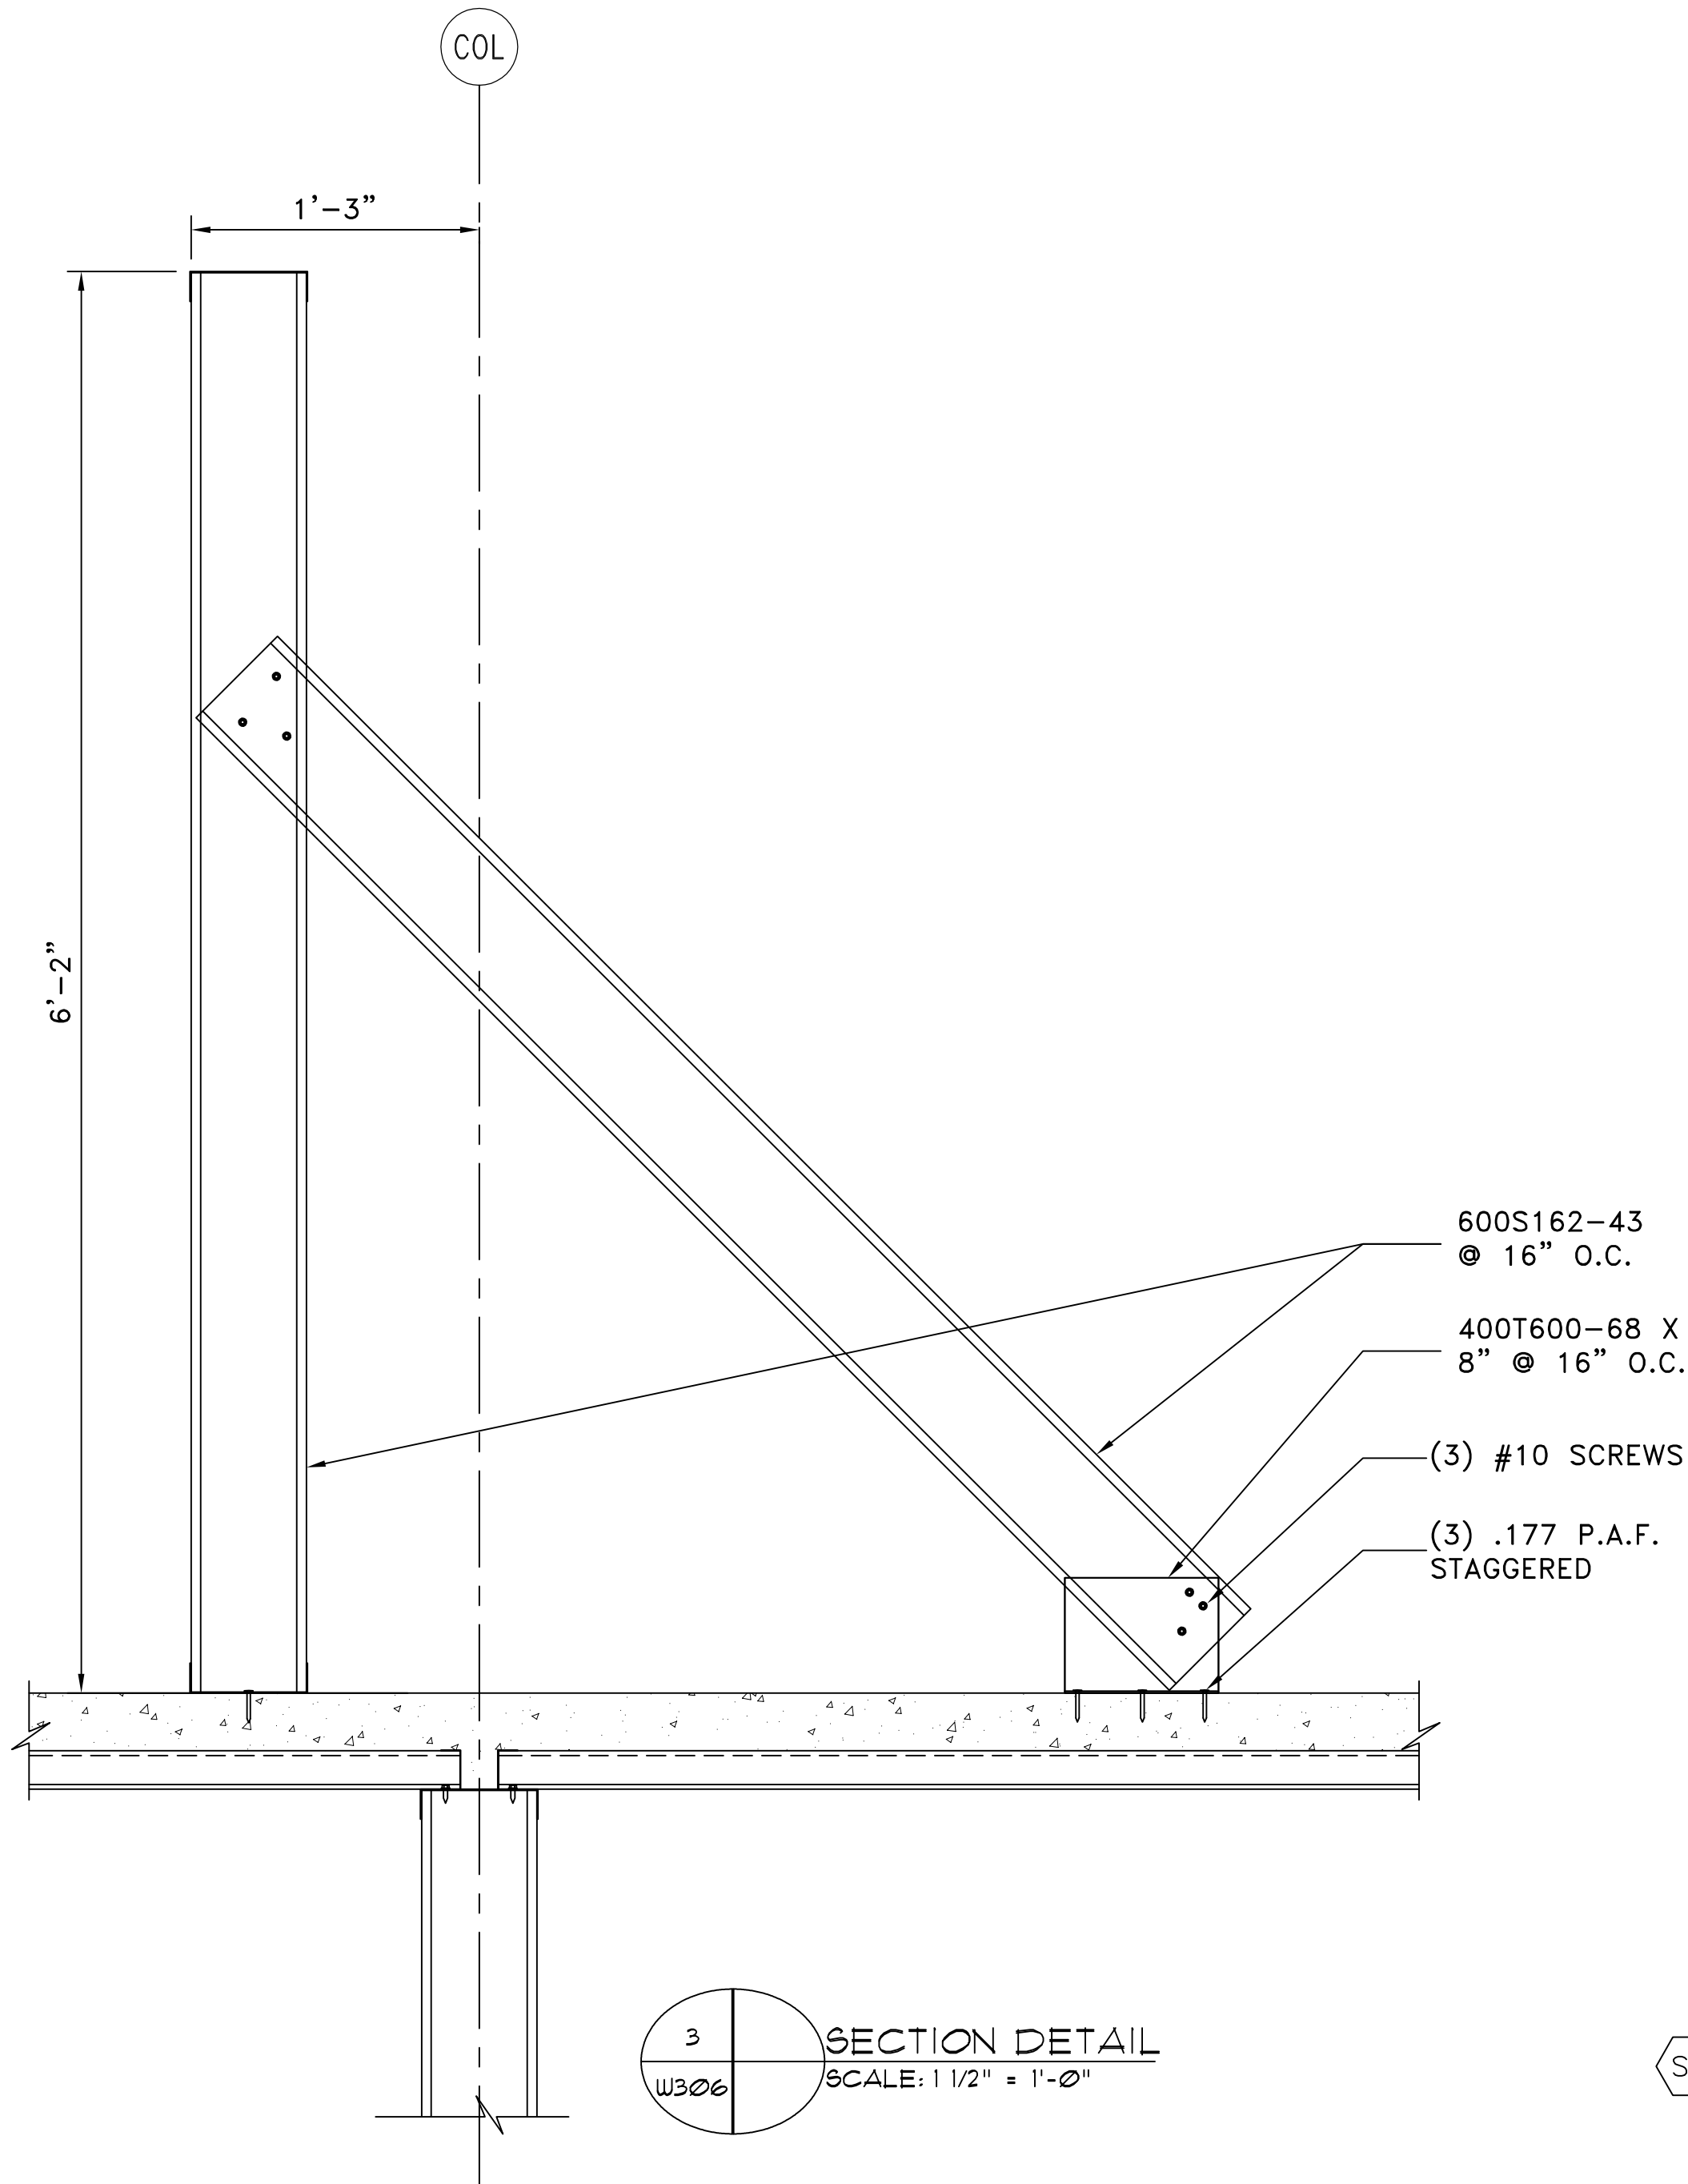

SD → SCALED DIMENSION. PLEASE VERIFY.

Home2 Suites
Flowood, MS

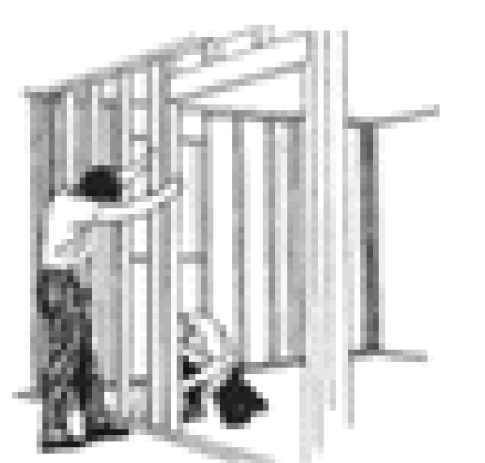


PANELIZERS, LLC
7695 HWY 161
WALLS, MS 38680
PHONE: (662) 996-5260
FAX: (662) 996-5262

Shop Drawings by:
HILLMAN ENTERPRISES, INC.
P.O. Box 106
Graham, AL 36033
PHONE: (256) 449-9261

Sheet Number:
W306

Job Number:
1605/1655


Date:
02/02/17

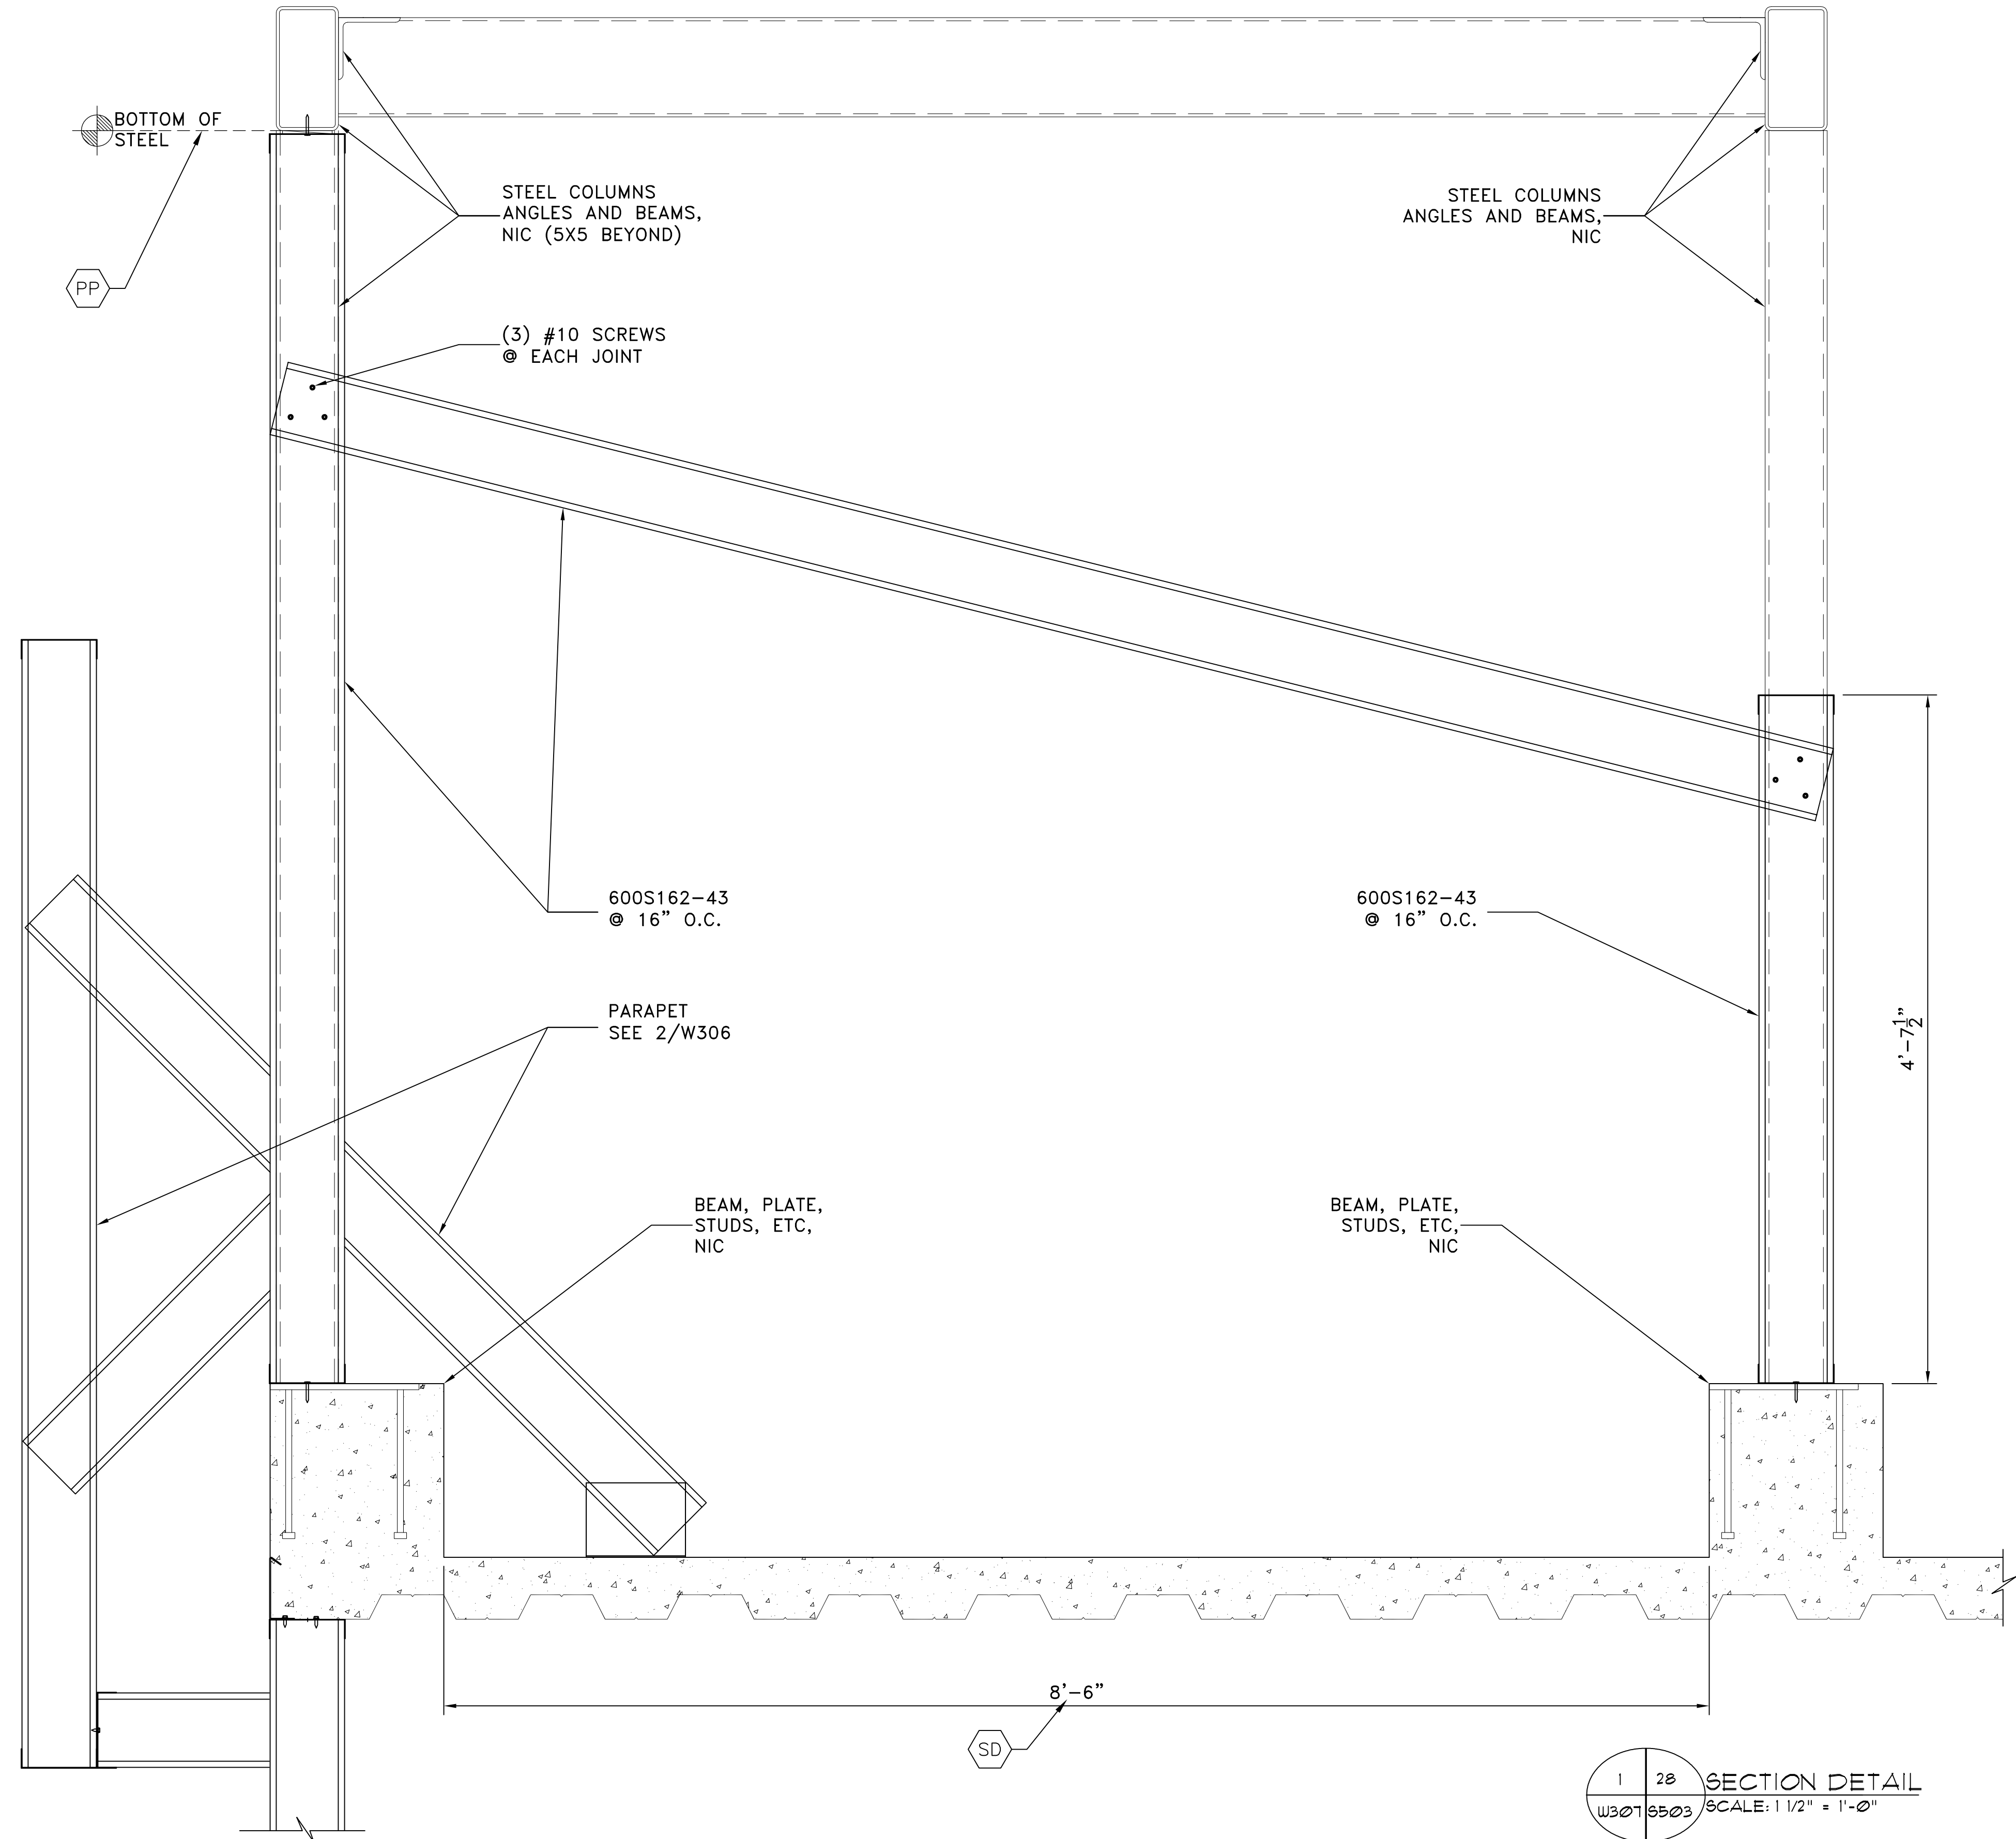

PP → PLEASE PROVIDE BOTTOM OF STEEL ELEVATION

SD → SCALED DIMENSION. PLEASE VERIFY.

Home2 Suites
Flowood, MS

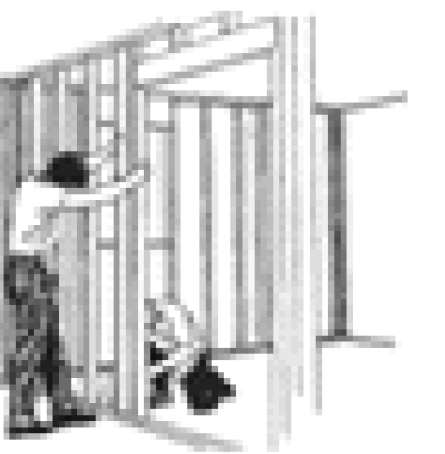


PANELIZERS, LLC
1695 HWY 161
WALLS, MS 38680
PHONE: (662) 996-5260
FAX: (662) 996-5262

Shop Drawings by:
HILLMAN ENTERPRISES, INC.
P.O. Box 106
Graham, AL 36263
PHONE: (256) 449-9261


Sheet Number:
W307

Job Number:
1605/1655

Date:
02/02/17

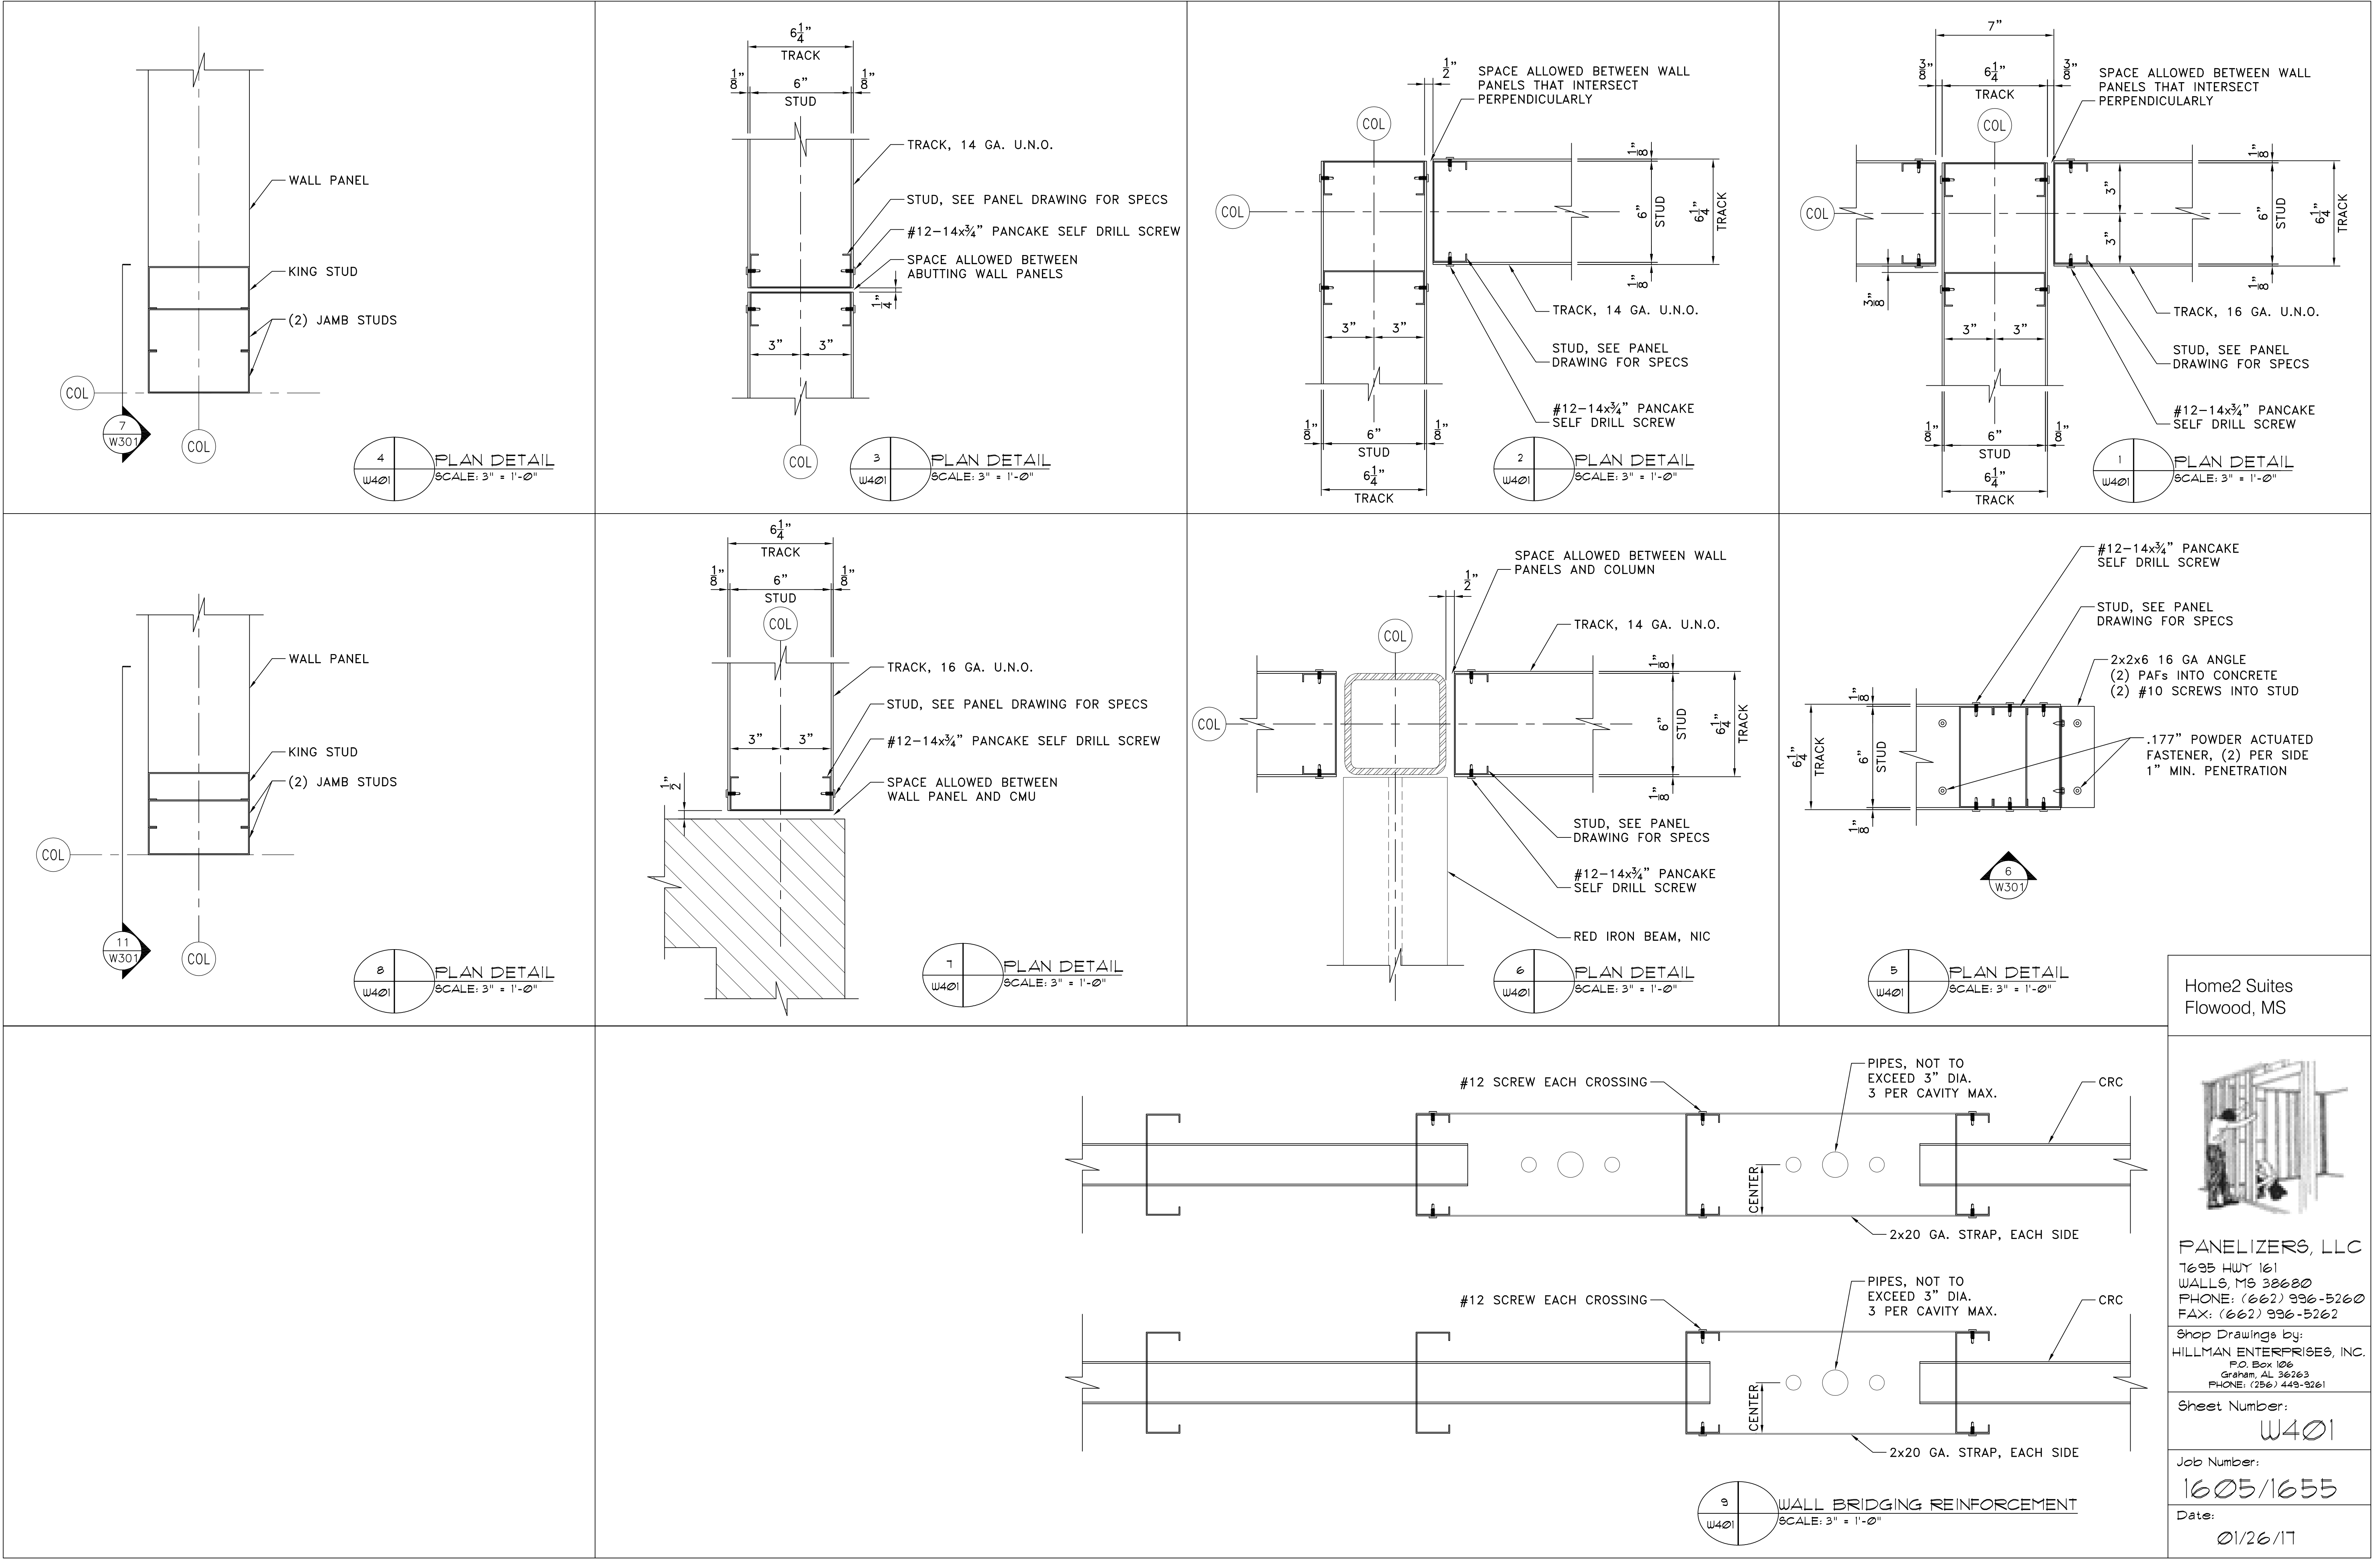

Home2 Suites
Flowood, MS

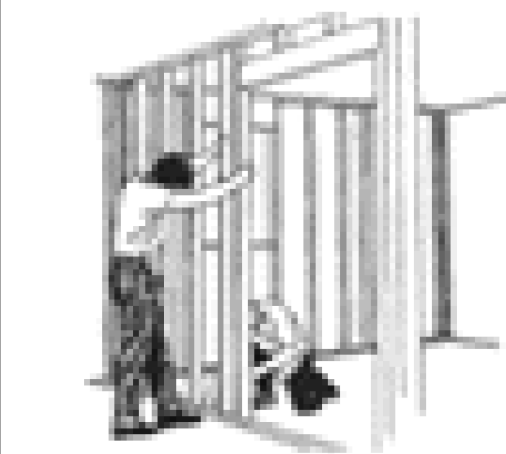

PANELIZERS, LLC
1695 HWY 161
WALLS, MS 38680
PHONE: (662) 996-5260
FAX: (662) 996-5262

Shop Drawings by:
HILLMAN ENTERPRISES, INC.
P.O. Box 106
Graham, AL 36263
PHONE: (256) 449-9261

Sheet Number:

W401

Job Number:

1605/1655

Date:

01/26/17