


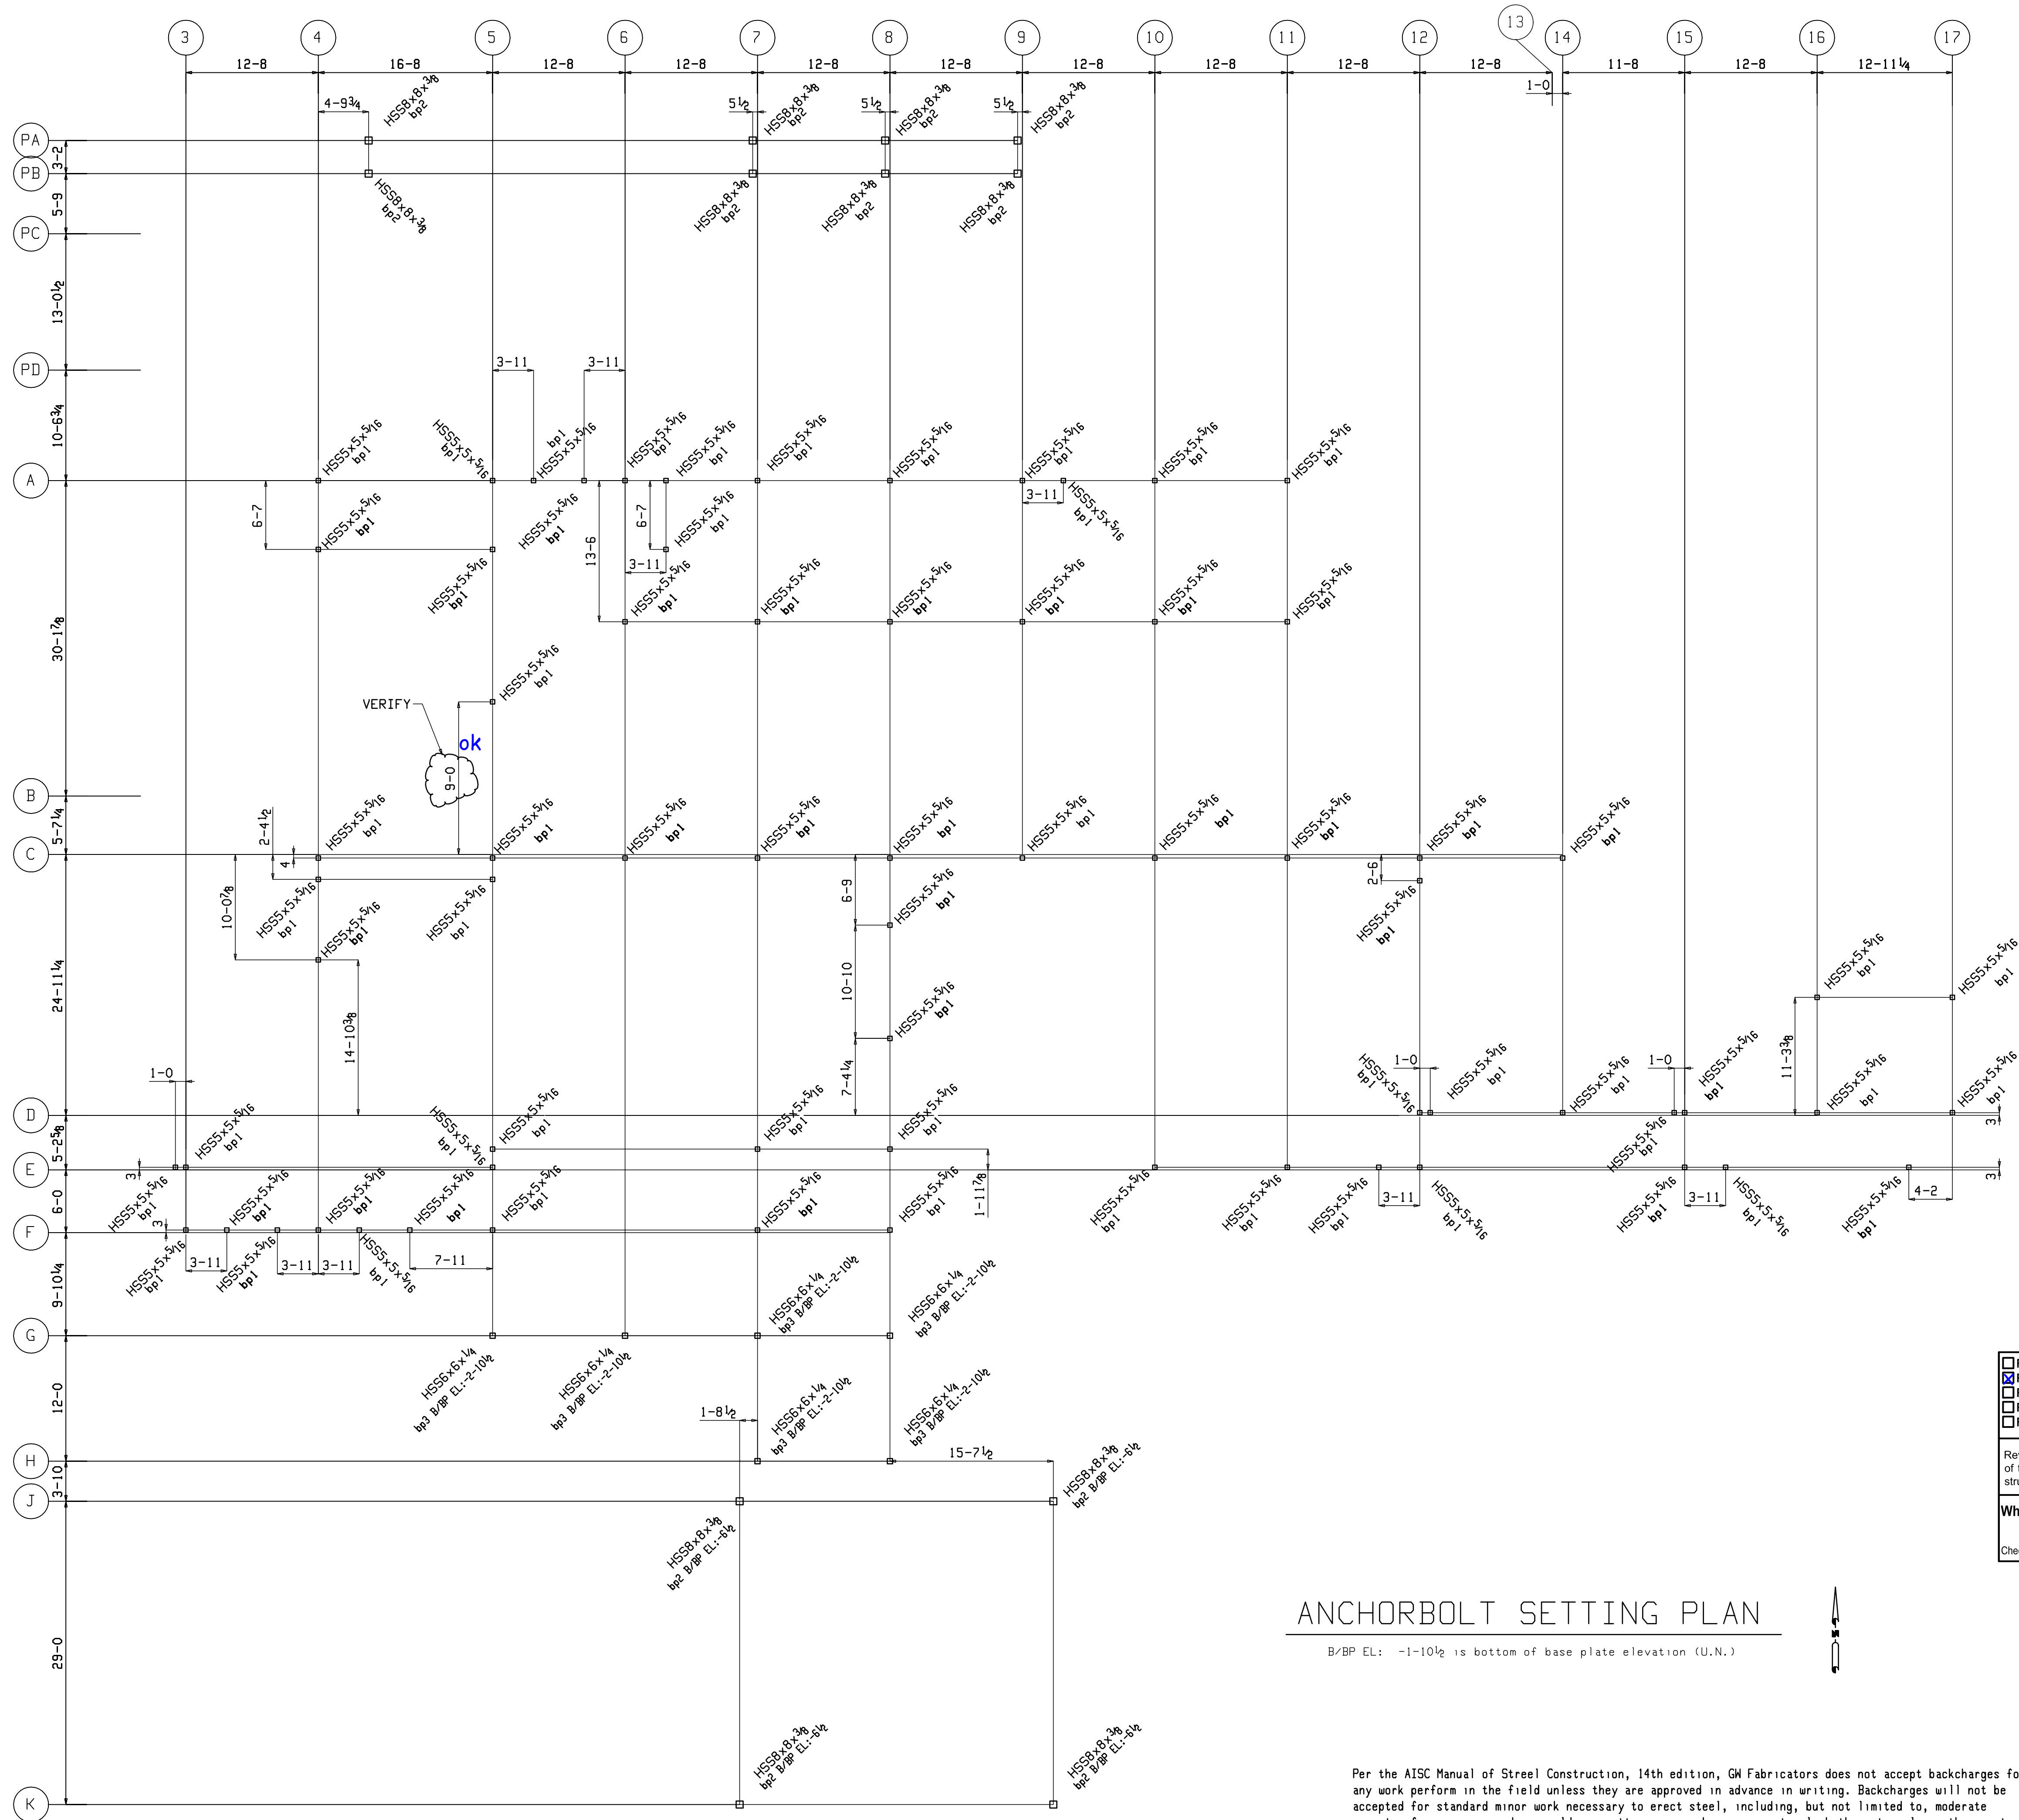

ANCHORBOLT SETTING PLAN

B/BP EL: -1-10 1/2 is bottom of base plate elevation (U.N.)

Per the AISC Manual of Steel Construction, 14th edition, GW Fabricators does not accept backcharges for any work perform in the field unless they are approved in advance in writing. Backcharges will not be accepted for standard minor work necessary to erect steel, including, but not limited to, moderate amounts of reaming, grinding, welding, cutting, or work necessary to plumb the material. In the event that field corrections are necessary, GW Fabricators must be given an opportunity to participate in the method of correction. this procedure must be followed before backcharges will be considered.



☐ REVIEWED	
☒ REVIEWED AND NOTED	
☐ REVISE AND RESUBMIT	
☐ REJECTED	
☐ RETURNED - SUBMITTAL NOT REQUIRED	
Review is in accordance with the provisions of the Project Manual and those listed in the structural notes under "SUBMITTALS".	
Whisonant Engineering Services, LLC	
Checked by <i>Ed Whisonant</i>	Date <u>12/13/16</u>

11-22-2016
FOR APPROVAL ONLY!
DO NOT USE FOR SETTING OF ANCHOR BOLTS, EMBEDDED ITEMS OR FOR ERECTION PURPOSES. GW FABRICATORS, ASSUMES NO RESPONSIBILITY FOR MISFITS INVOLVING THE USE OF THIS PRELIMINARY DWG. FILE AND FIELD DWGS WILL FOLLOW AT A LATER DATE



GW FABRICATORS
MERIDIAN, MISSISSIPPI 39302

PRINT RECORD		FOR		STRUCTURE		HOME2SUITES BY HILTON	
QUANT.	DATE			DETAIL	ANCHOTBOLT SETTING PLAN		
				CONT.	SOUTHERN HOSPITALITY SERVICES		
				LOCATION	FLOWOOD, MISSISSIPPI		
				ENG. OR ARCH'T.	WHISONANT ENGINEERING SERVICES		
				Copyright ©	Nov 22 2016		by GW FABRICATORS
				REVISIONS		SHOP ORDER	SHEET NO.
1	2	3	4			361	AB1
MADE		Robert.S		DATE		11-18-16	
CHKD				DATE			

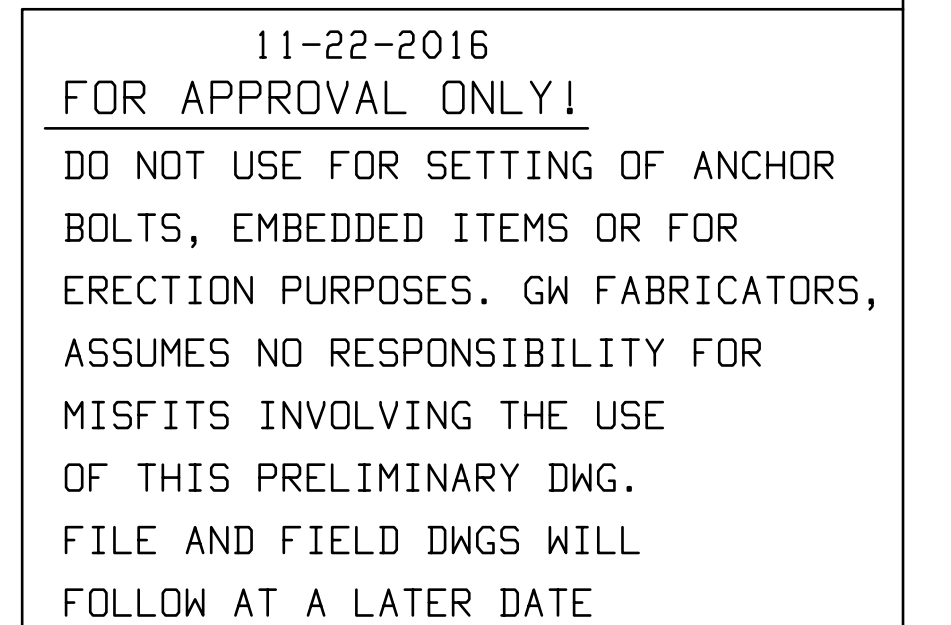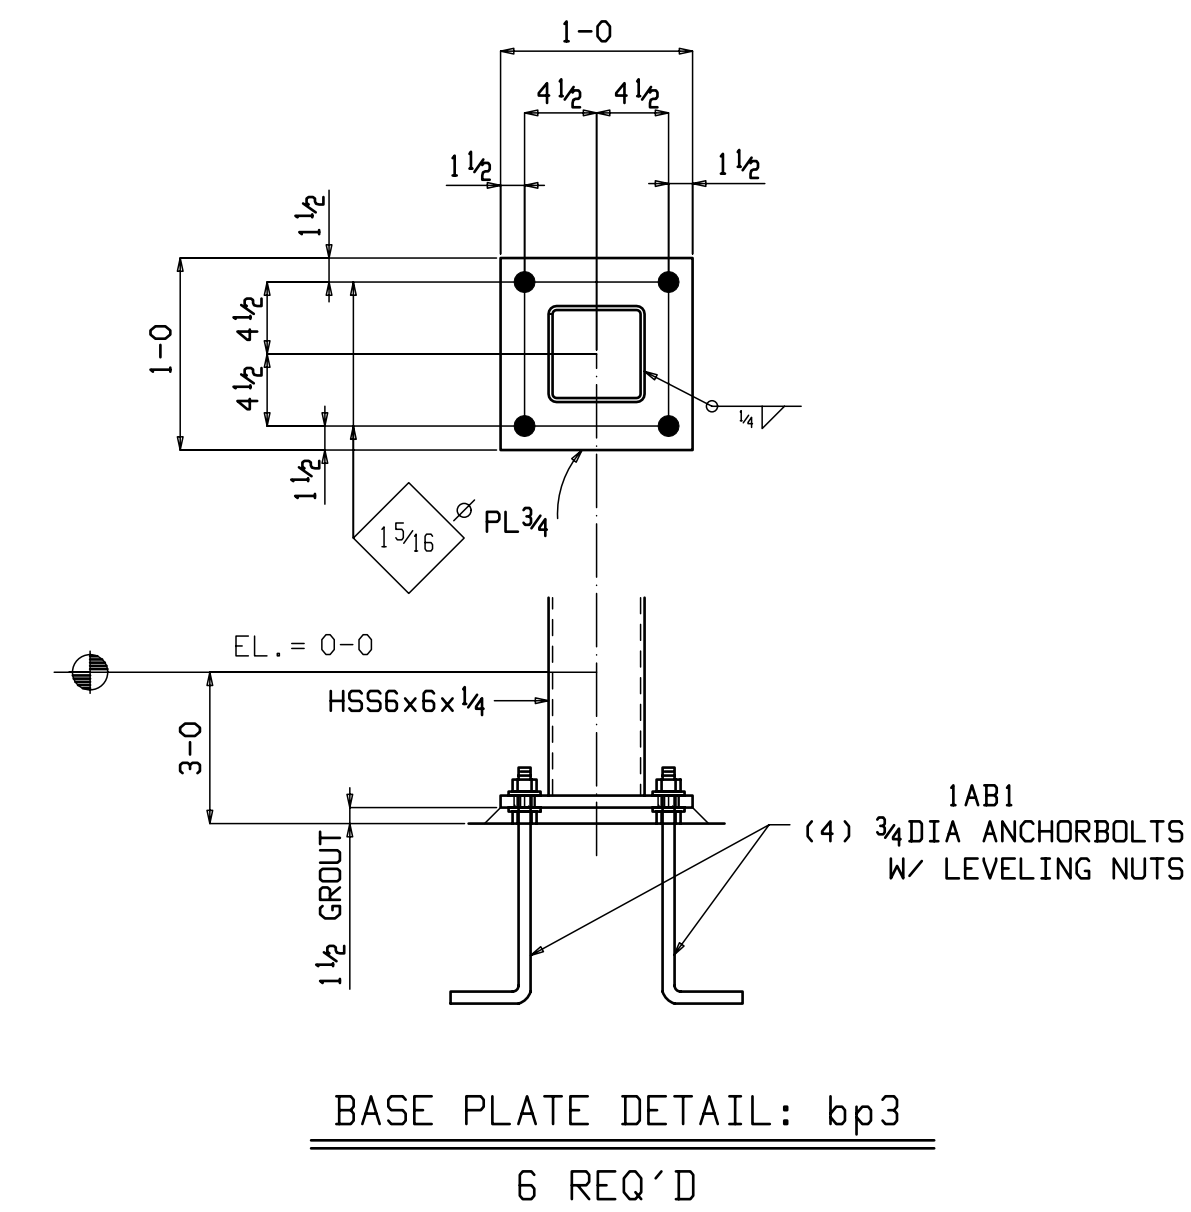

Per the AISC Manual of Steel Construction, 14th edition, GW Fabricators does not accept backcharges for any work performed in the field unless they are approved in advance in writing. Backcharges will not be accepted for standard minor work necessary to erect steel, including, but not limited to, moderate amounts of reaming, grinding, welding, cutting, or work necessary to plumb the material. In the event that field corrections are necessary, GW Fabricators must be given an opportunity to participate in the method of correction. This procedure must be followed before backcharges will be considered.

		GW FABRICATORS MERIDIAN, MISSISSIPPI 39302													
QUANT.	PRINT RECORD DATE	FOR	STRUCTURE HOME2SUITES BY HILTON DETAIL BASE PLATE DETAILS CONF. SOUTHERN HOSPITALITY SERVICES LOCATION FLOWOOD, MISSISSIPPI ENG. OR ARCH'T. WHISONANT ENGINEERING SERVICES Copyright © Nov 22 2015 by GW FABRICATORS												
			REVISIONS <table border="1" style="width: 100%; border-collapse: collapse;"> <tr> <td style="width: 20%;">1</td> <td style="width: 20%;">2</td> <td style="width: 20%;">3</td> <td style="width: 20%;">4</td> <td style="width: 20%;"></td> </tr> <tr> <td style="height: 40px;"></td> <td></td> <td></td> <td></td> <td></td> </tr> </table>			1	2	3	4						
1	2	3	4												
MADE	DATE	SHOP ORDER SHEET NO. Robert.S 11-18-16													
CHECK	DATE	361 AB2													