




CIVIL:
Benchmark Engineering and Surveying
101 Highpointe Court, Suite B
Brandon, MS 39042
Phone: (601) 591-1077
Fax: (601) 591-0177
Email:mikebes@bellsouth.net

STRUCTURAL:
Whisonant Engineering Services, LLC
122 Nut Tree Court
Lexington, SC 29074
Phone: (803) 957-4008
Email: bill@weslex.com

MEP:
INNOVATIVE ENGINEERING SERVICES
2787 Stage Center Dr.
Suite 101
Bartlett, Tennessee 38134
Phone: (662) 890-4220
Email: www.innovativees-llc.com

[illegible]

Information contained on this drawing and in all digital files associated is authorized for use on the project named herein only and is the property of MISHRA ARCHITECTURE PLLC and may not be reproduced in any manner without express written or verbal permission from authorized individuals. Original drawing is 24"x36" and scales are as indicated.^o
2011 MISHRA ARCHITECTURE PLLC

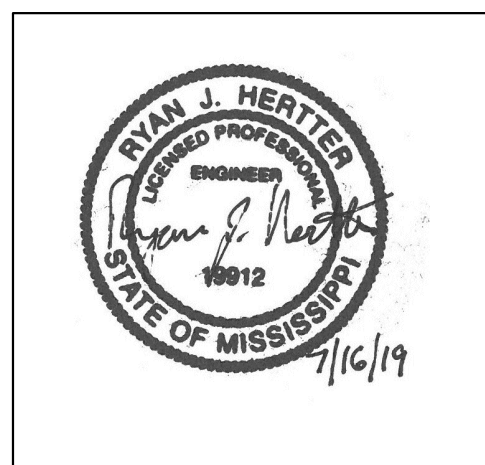

KEY PLAN

Pramukh Vicksburg,
LLC

Home2Suites
Vicksburg

Berryman Road
Vicksburg, MS 39180


Drawing Title

First Floor Plan

Phase
Construction Documentss

Project No.	17-051	Sheet No.
Prepared by	RHP	
Checked by	RJH	
Date	MAR. 28, 2019	
		M101

Released from

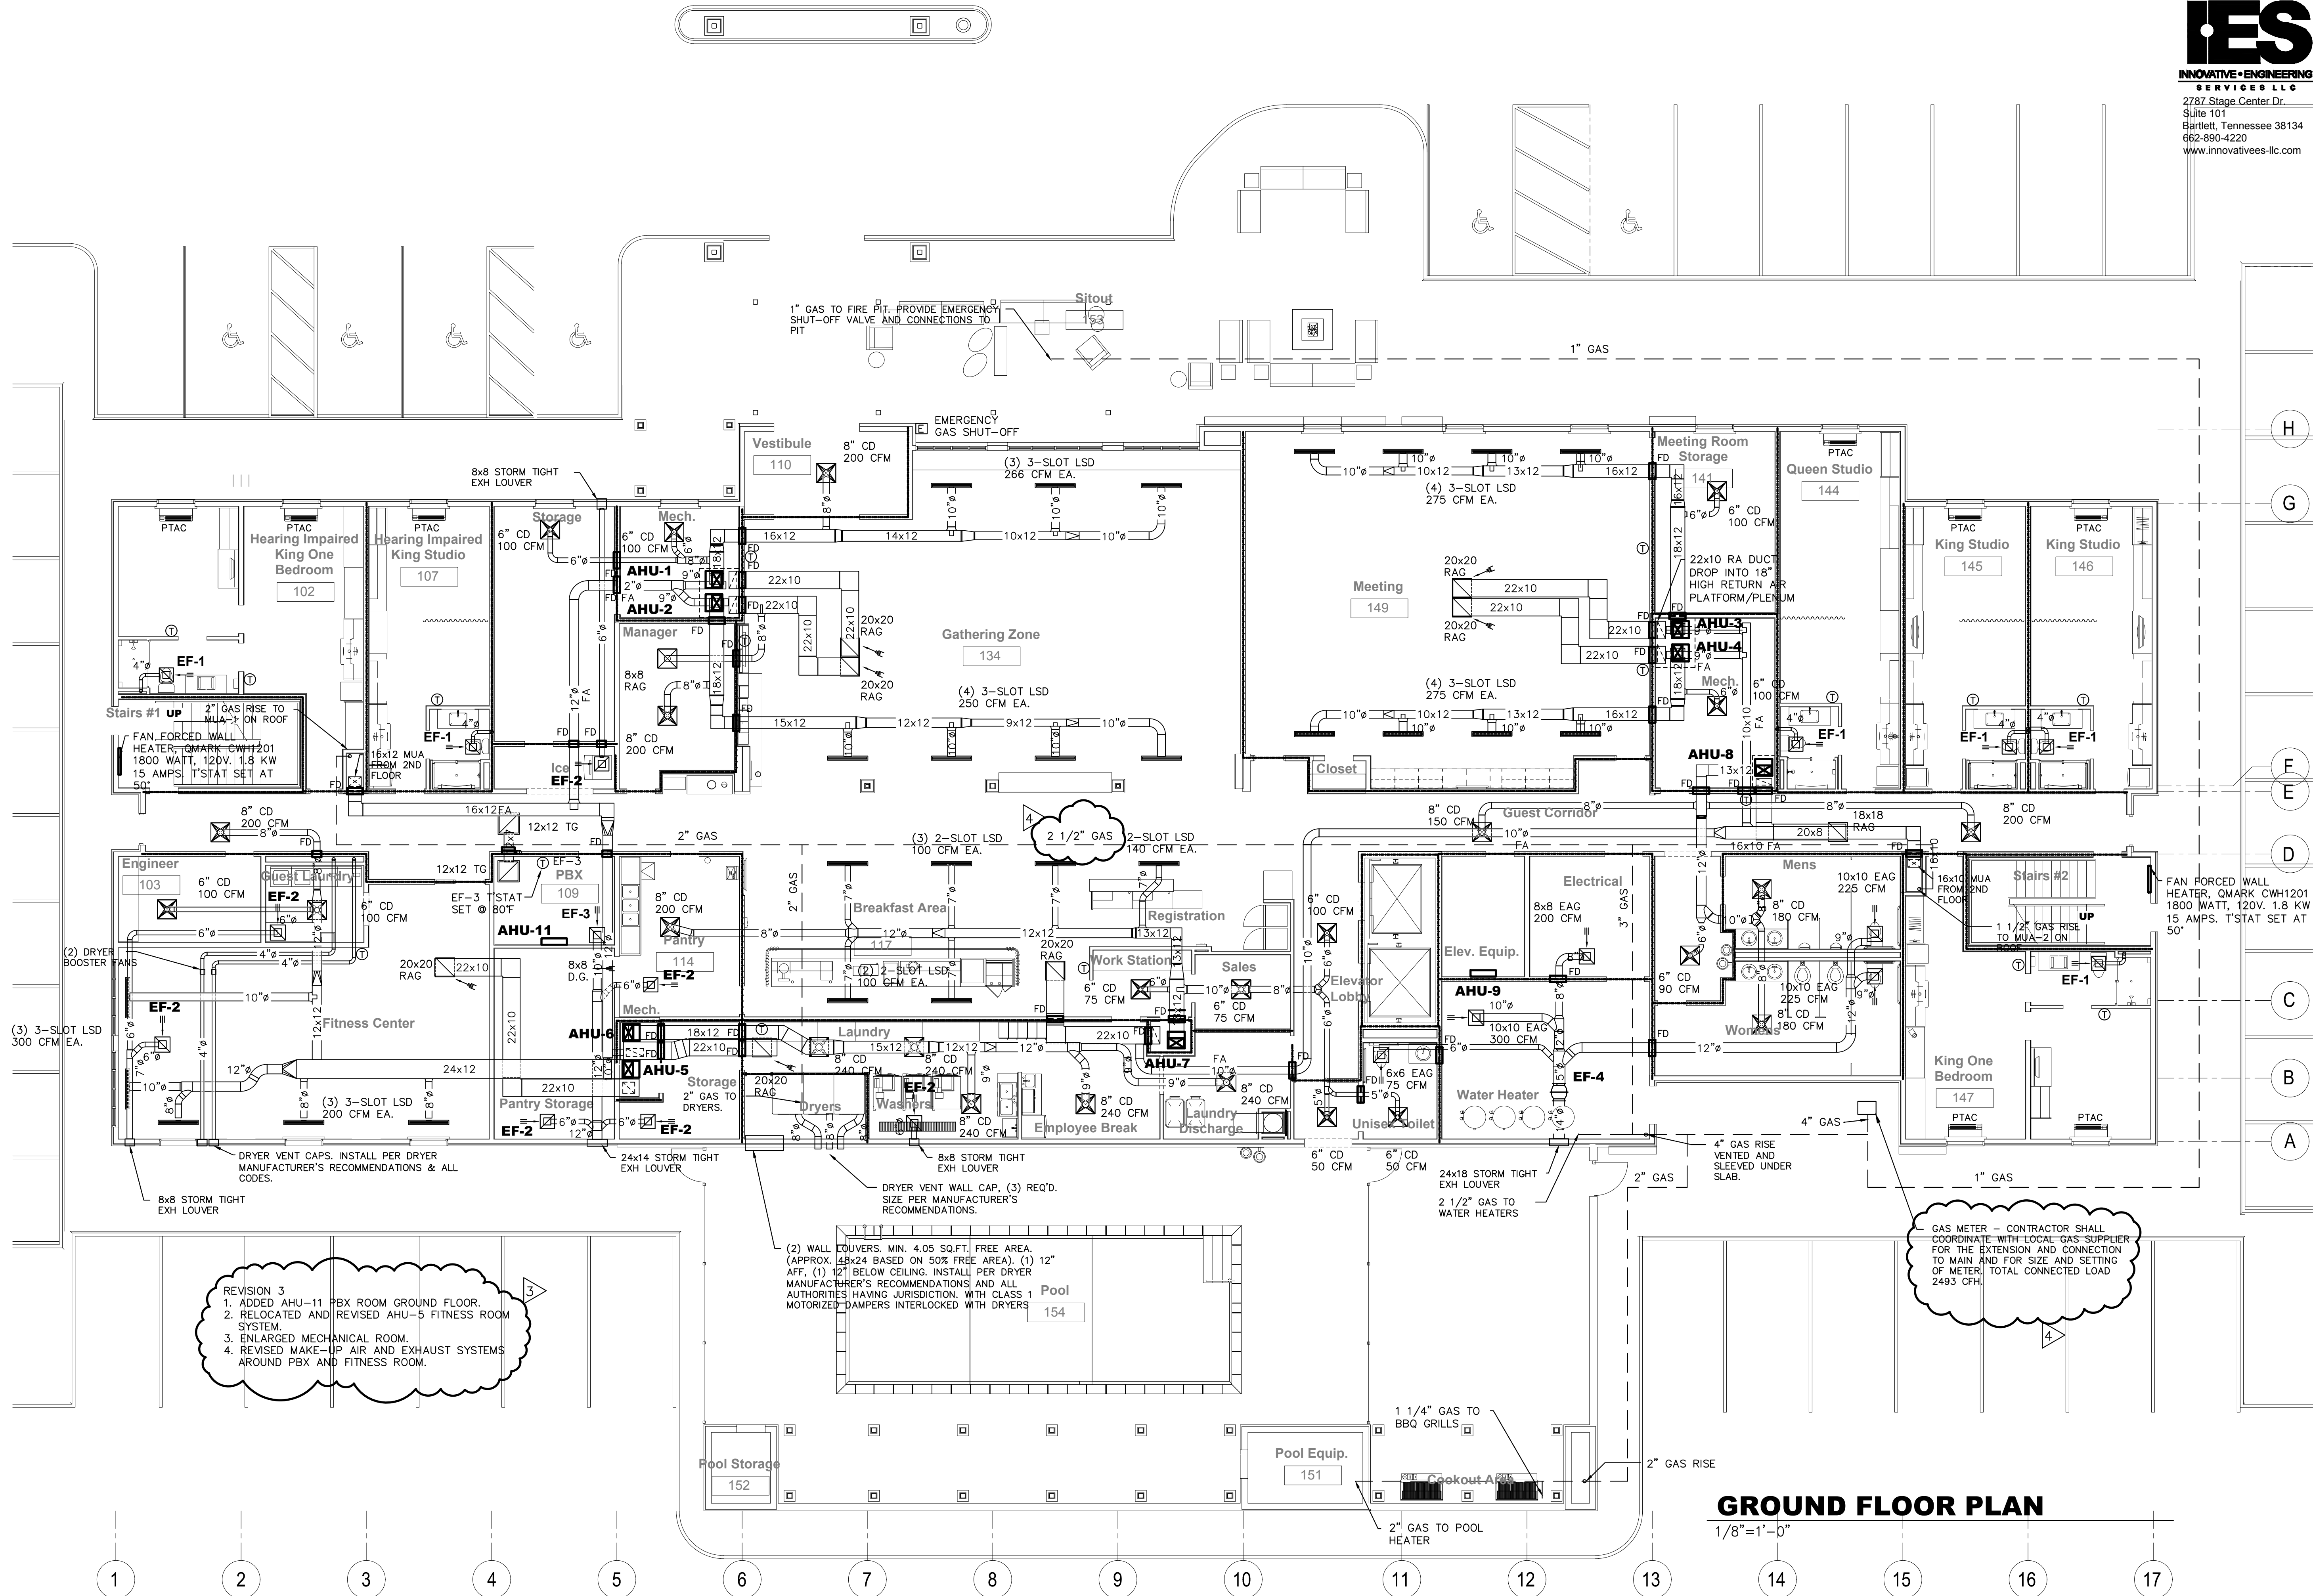

GROUND FLOOR PLAN

1/8"	= 1' - 0"
------	-----------




CIVIL:
Benchmark Engineering and Surveying
101 Highpointe Court, Suite B
Brandon, MS 39042
Phone: (601) 591-1077
Fax: (601) 591-0177
Email: mikebes@bellsouth.net

STRUCTURAL:
Whisonant Engineering Services, LLC
122 Nut Tree Court
Lexington, SC 29074
Phone: (803) 957-4008
Email: bill@weslex.com

MEP:
INNOVATIVE ENGINEERING SERVICES
2787 Stage Center Dr.
Suite 101
Bartlett, Tennessee 38134
Phone: (662) 890-4220
Email: www.innovativees-llc.com

[illegible]

Information contained on this drawing and in all digital files associated is authorized for use on the project named herein only and is the property of MISHRA ARCHITECTURE PLLC and may not be reproduced in any manner without express written or verbal permission from authorized individuals. Original drawing is 24"x36" and scales are as indicated.[©]
2011 MISHRA ARCHITECTURE PLLC

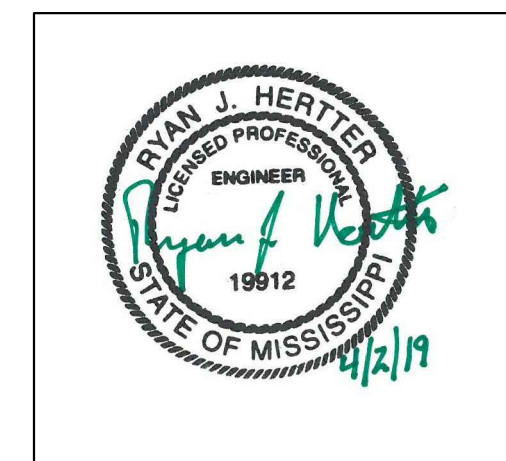

KEY PLAN

Pramukh Vicksburg,
LLC

Home2Suites
Vicksburg

Berryman Road
Vicksburg, MS 39180


Drawing Title

Second Floor Plan

Phase
Construction Documentss

Project No. 17-051
 Prepared by RHP
 Checked by RJH
 Date MAR. 28, 2019

Released from

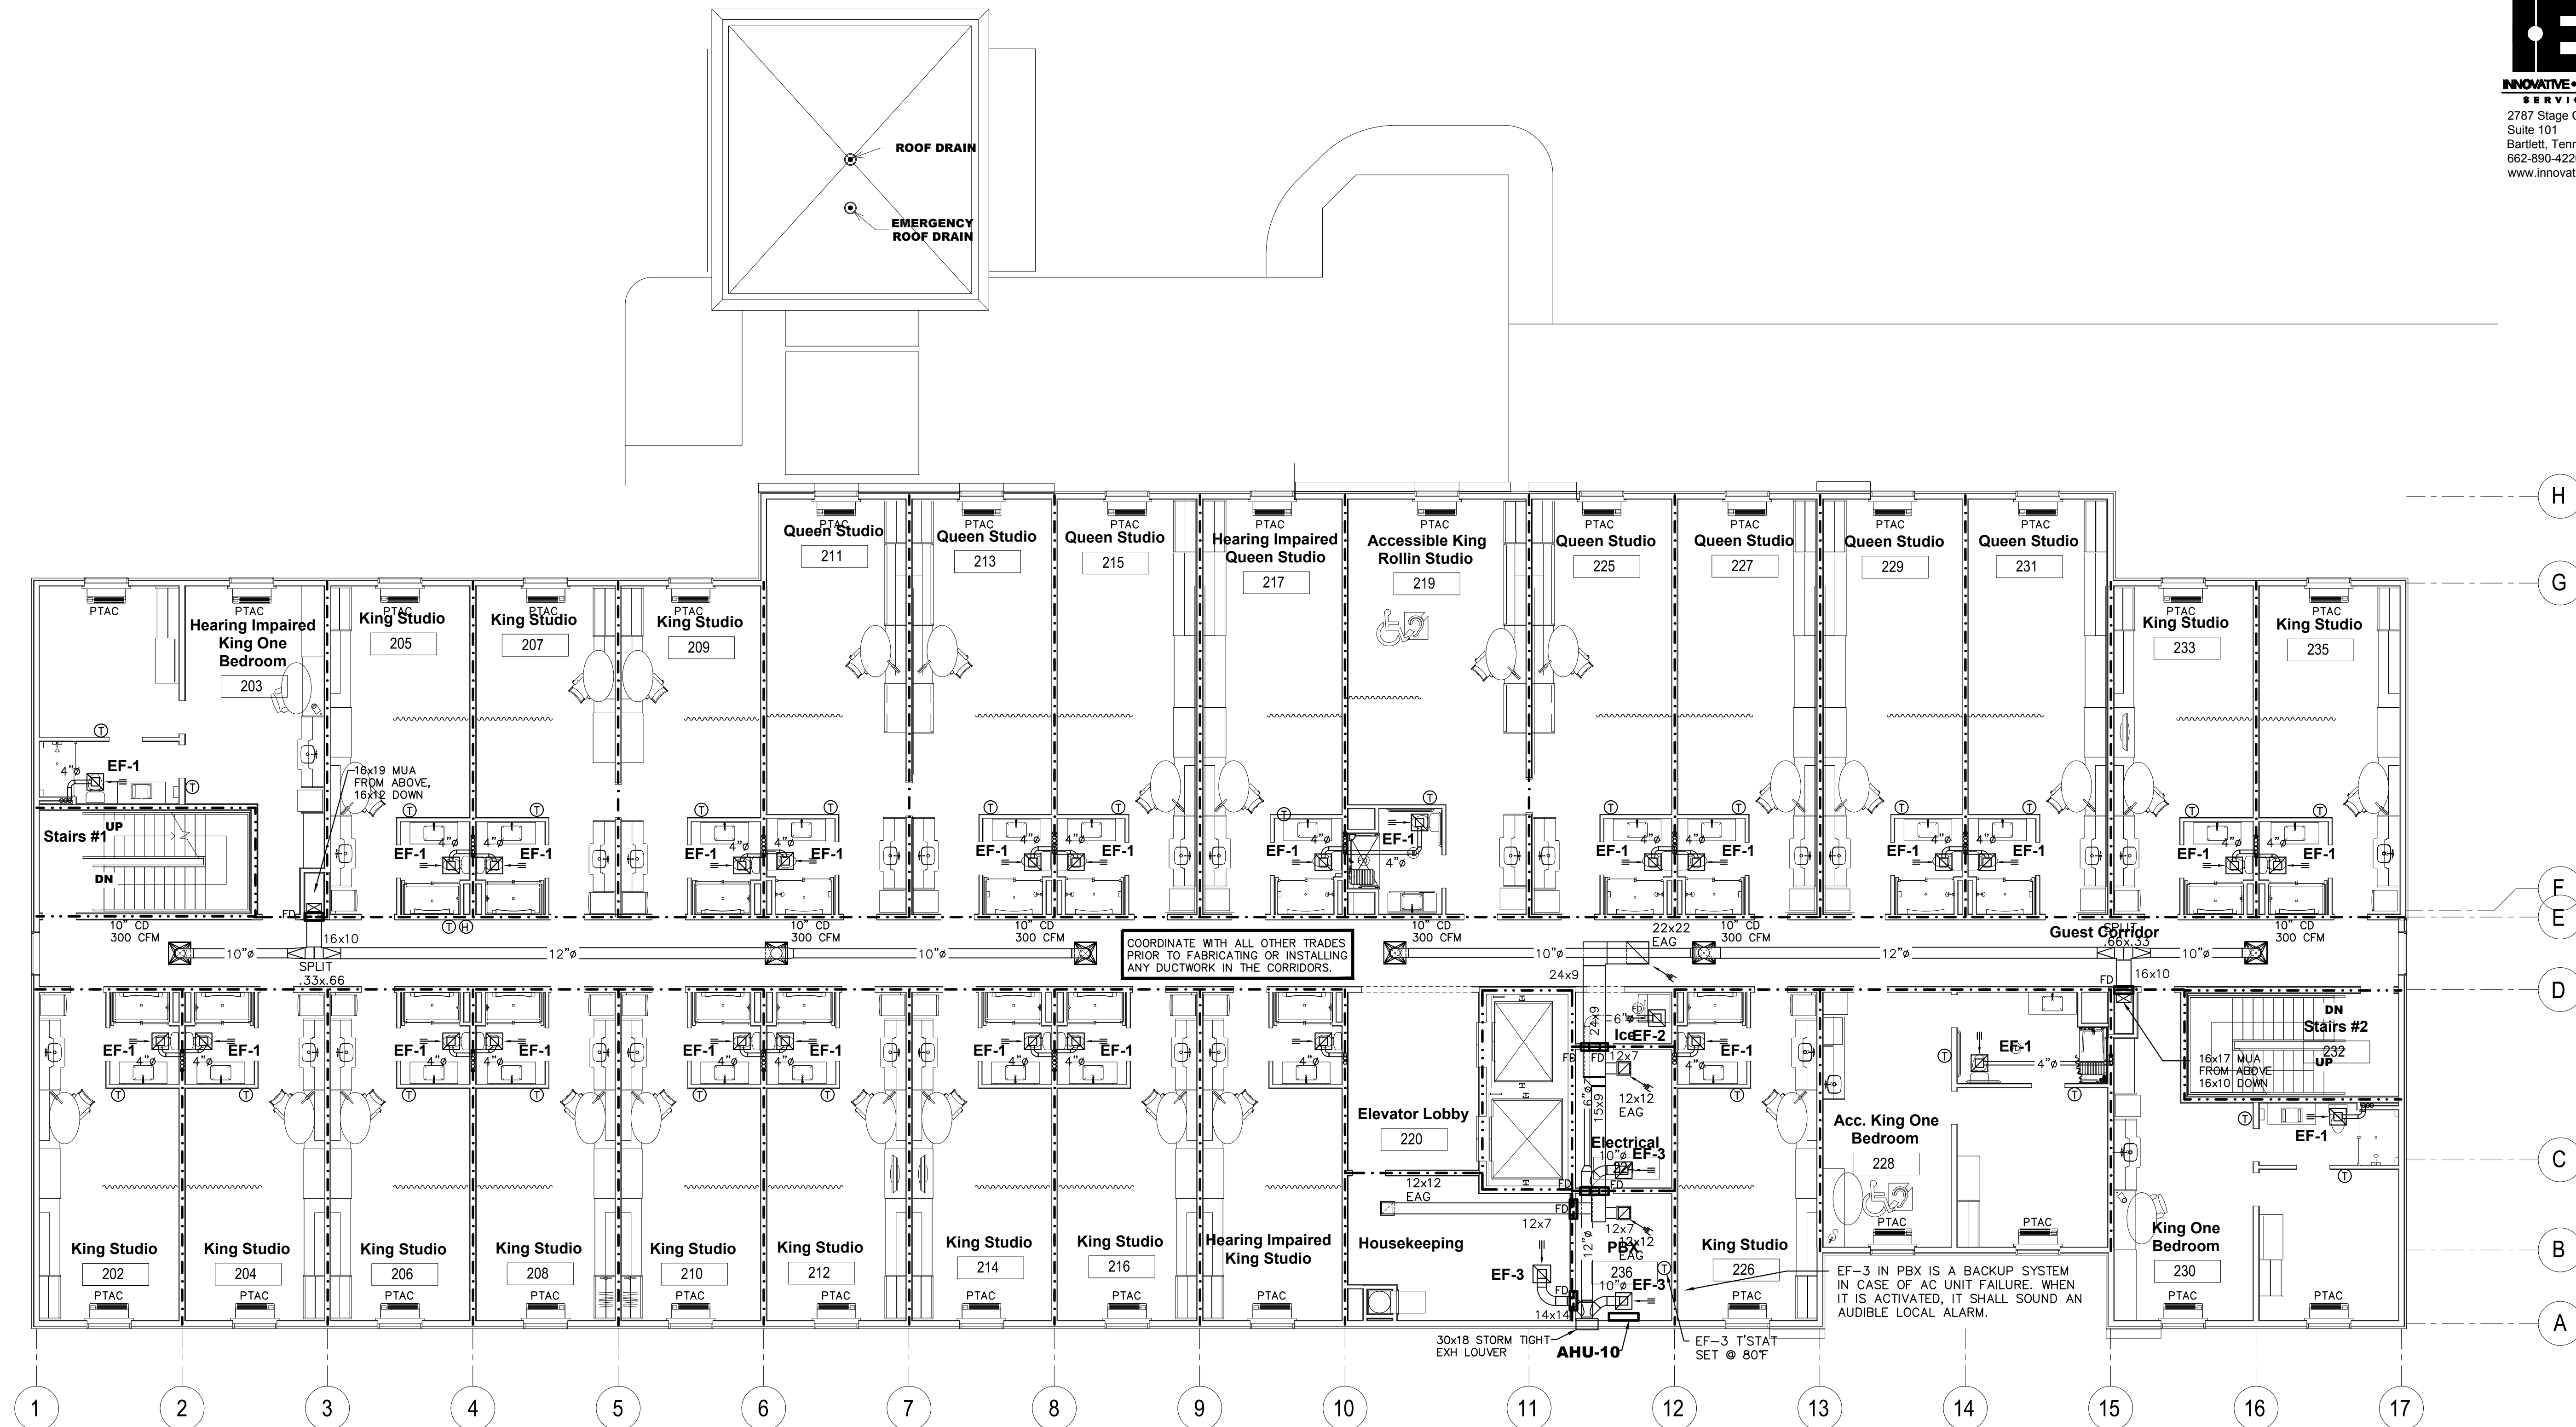

SECOND FLOOR PLAN

$$1/8'' = 1' - 0''$$

Released from




CIVIL:
Benchmark Engineering and Surveying
101 Highpointe Court, Suite B
Brandon, MS 39042
Phone: (601) 591-1077
Fax: (601) 591-0177
Email: mikebes@bellsouth.net

STRUCTURAL:
Whisonant Engineering Services, LLC
122 Nut Tree Court
Lexington, SC 29074
Phone: (803) 957-4008
Email: bill@weslex.com

MEP:
INNOVATIVE ENGINEERING SERVICES
2787 Stage Center Dr.
Suite 101
Bartlett, Tennessee 38134
Phone: (662) 890-4220
Email: www.innovativees-llc.com

[illegible]

Information contained on this drawing and in all digital files associated is authorized for use on the project named herein only and is the property of MISHRA ARCHITECTURE PLLC and may not be reproduced in any manner without express written or verbal permission from authorized individuals. Original drawing is 24"x36" and scales are as indicated.[©]
2011 MISHRA ARCHITECTURE PLLC

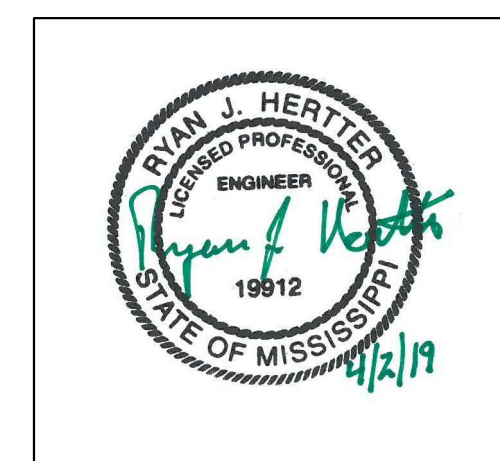

KEY PLAN

Pramukh Vicksburg,
LLC

Home2Suites
Vicksburg

Berryman Road
Vicksburg, MS 39180

Drawing Title

Third Floor Plan


Phase
Construction Documentss

Project No.	17-051
Prepared by	RHP
Checked by	RJH
Date	MAR. 28, 2019

Sheet No.

M103

Released for

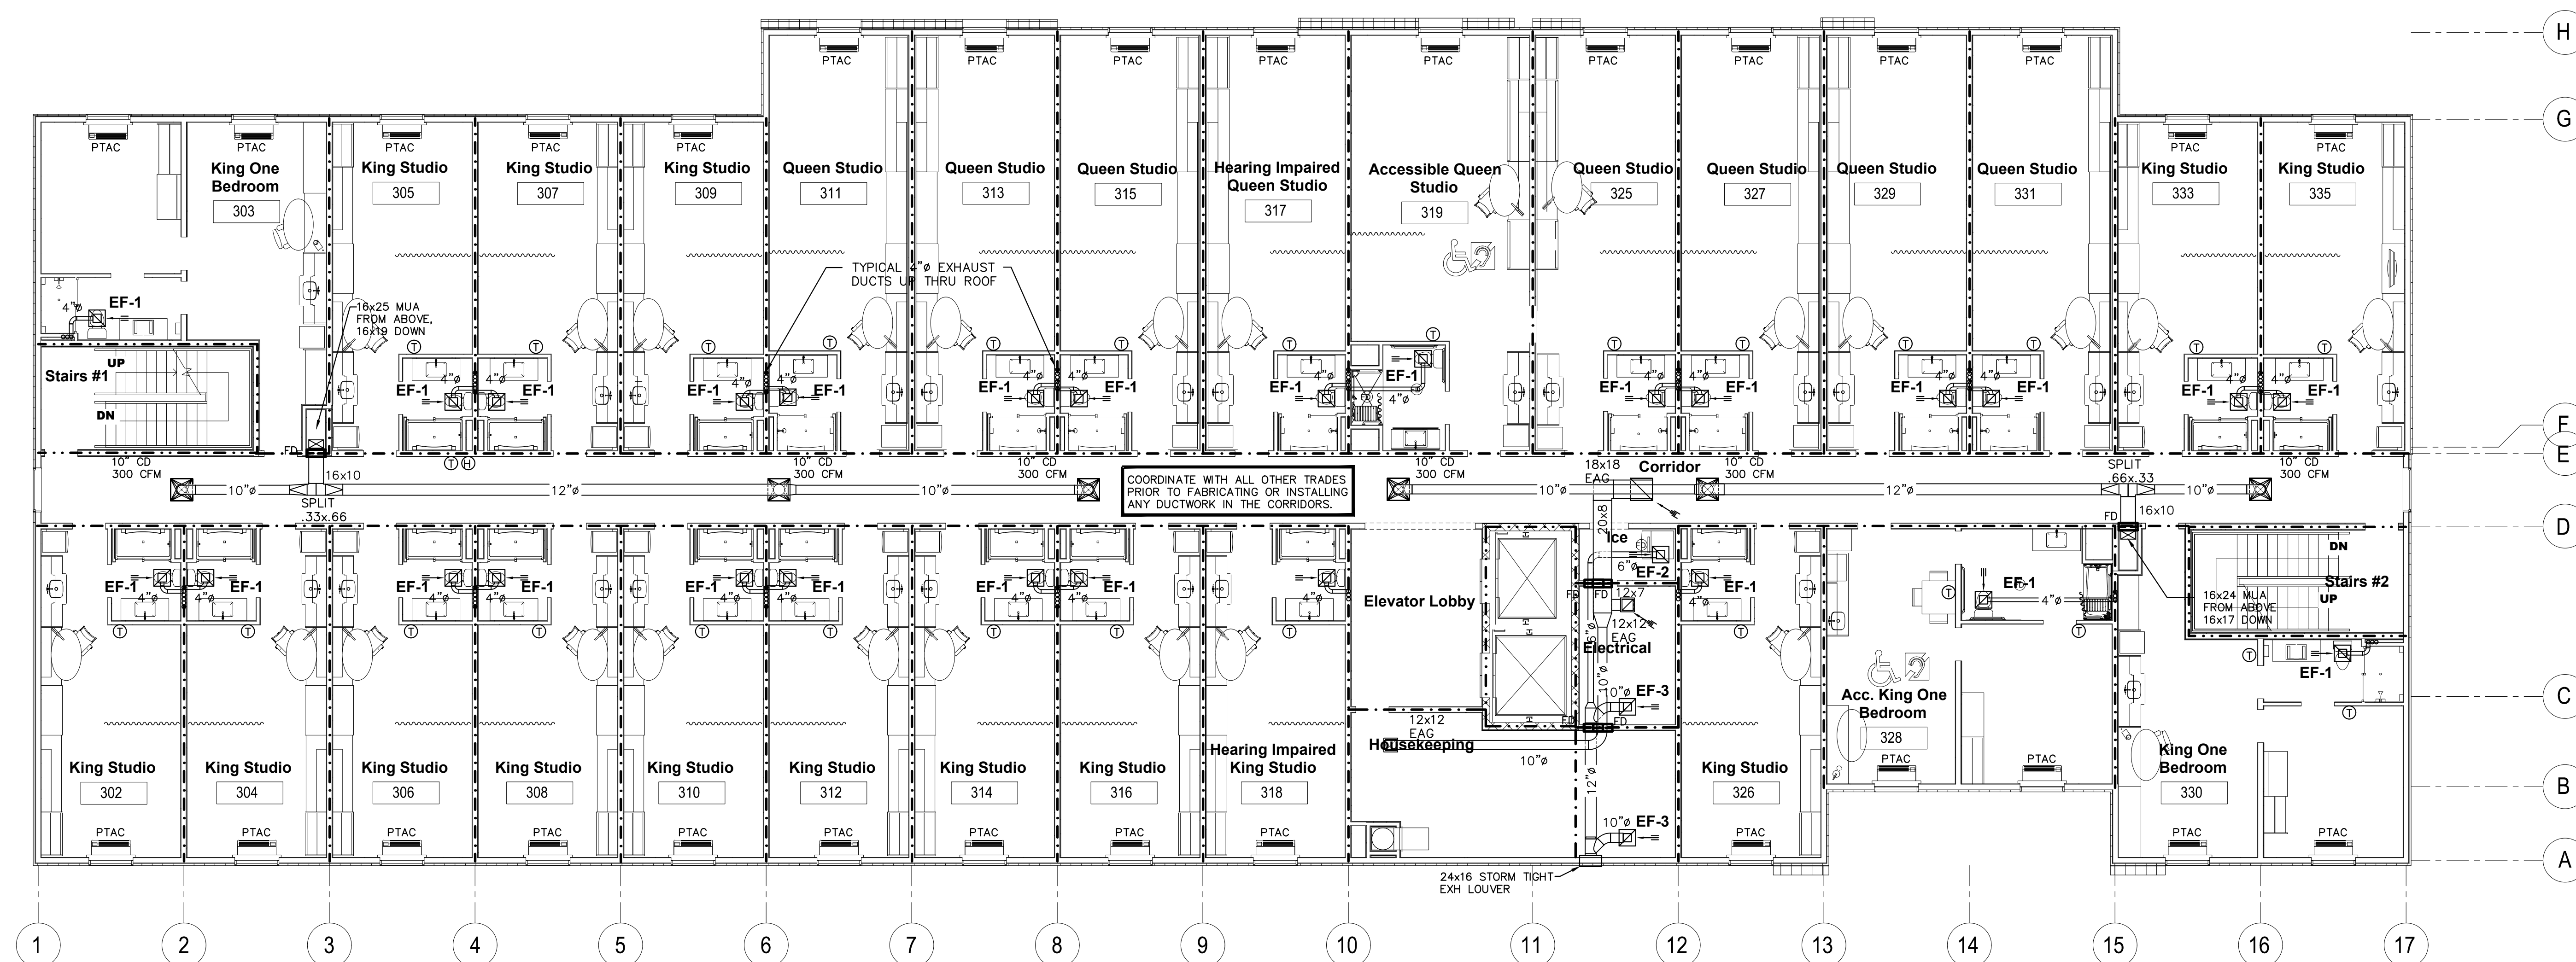

THIRD FLOOR PLAN

$$\overline{1/8'' = 1' - 0''}$$




CIVIL:
Benchmark Engineering and Surveying
101 Highpointe Court, Suite B
Brandon, MS 39042
Phone: (601) 591-1077
Fax: (601) 591-0177
Email: mikebes@bellsouth.net

STRUCTURAL:
Whisonant Engineering Services, LLC
122 Nut Tree Court
Lexington, SC 29074
Phone: (803) 957-4008
Email: bill@weslex.com

MEP:
INNOVATIVE ENGINEERING SERVICES
2787 Stage Center Dr.
Suite 101
Bartlett, Tennessee 38134
Phone: (662) 890-4220
Email: www.innovativees-llc.com

[illegible]

Information contained on this drawing and in all digital files associated is authorized for use on the project named herein only and is the property of MISHRA ARCHITECTURE PLLC and may not be reproduced in any manner without express written or verbal permission from authorized individuals. Original drawing is 24"x36" and scales are as indicated. © 2011 MISHRA ARCHITECTURE PLLC

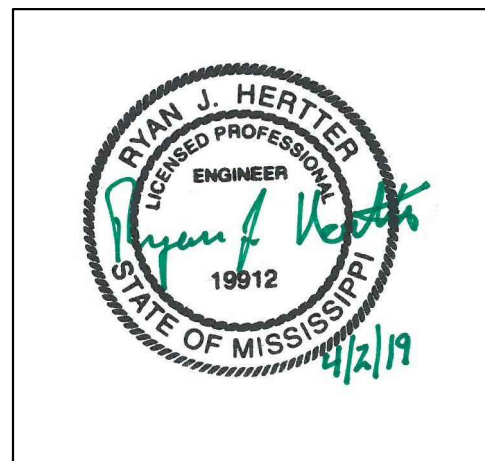

KEY PLAN

Pramukh Vicksburg,
LLC

Home2Suites
Vicksburg

Berryman Road
Vicksburg, MS 39180


Drawing Title

Fourth Floor Plan

Phase
Construction Documentss

Project No.	17-051	Sheet No.
Prepared by	RHP	
Checked by	RJH	
Date	MAR. 28, 2019	
		M104

Released from

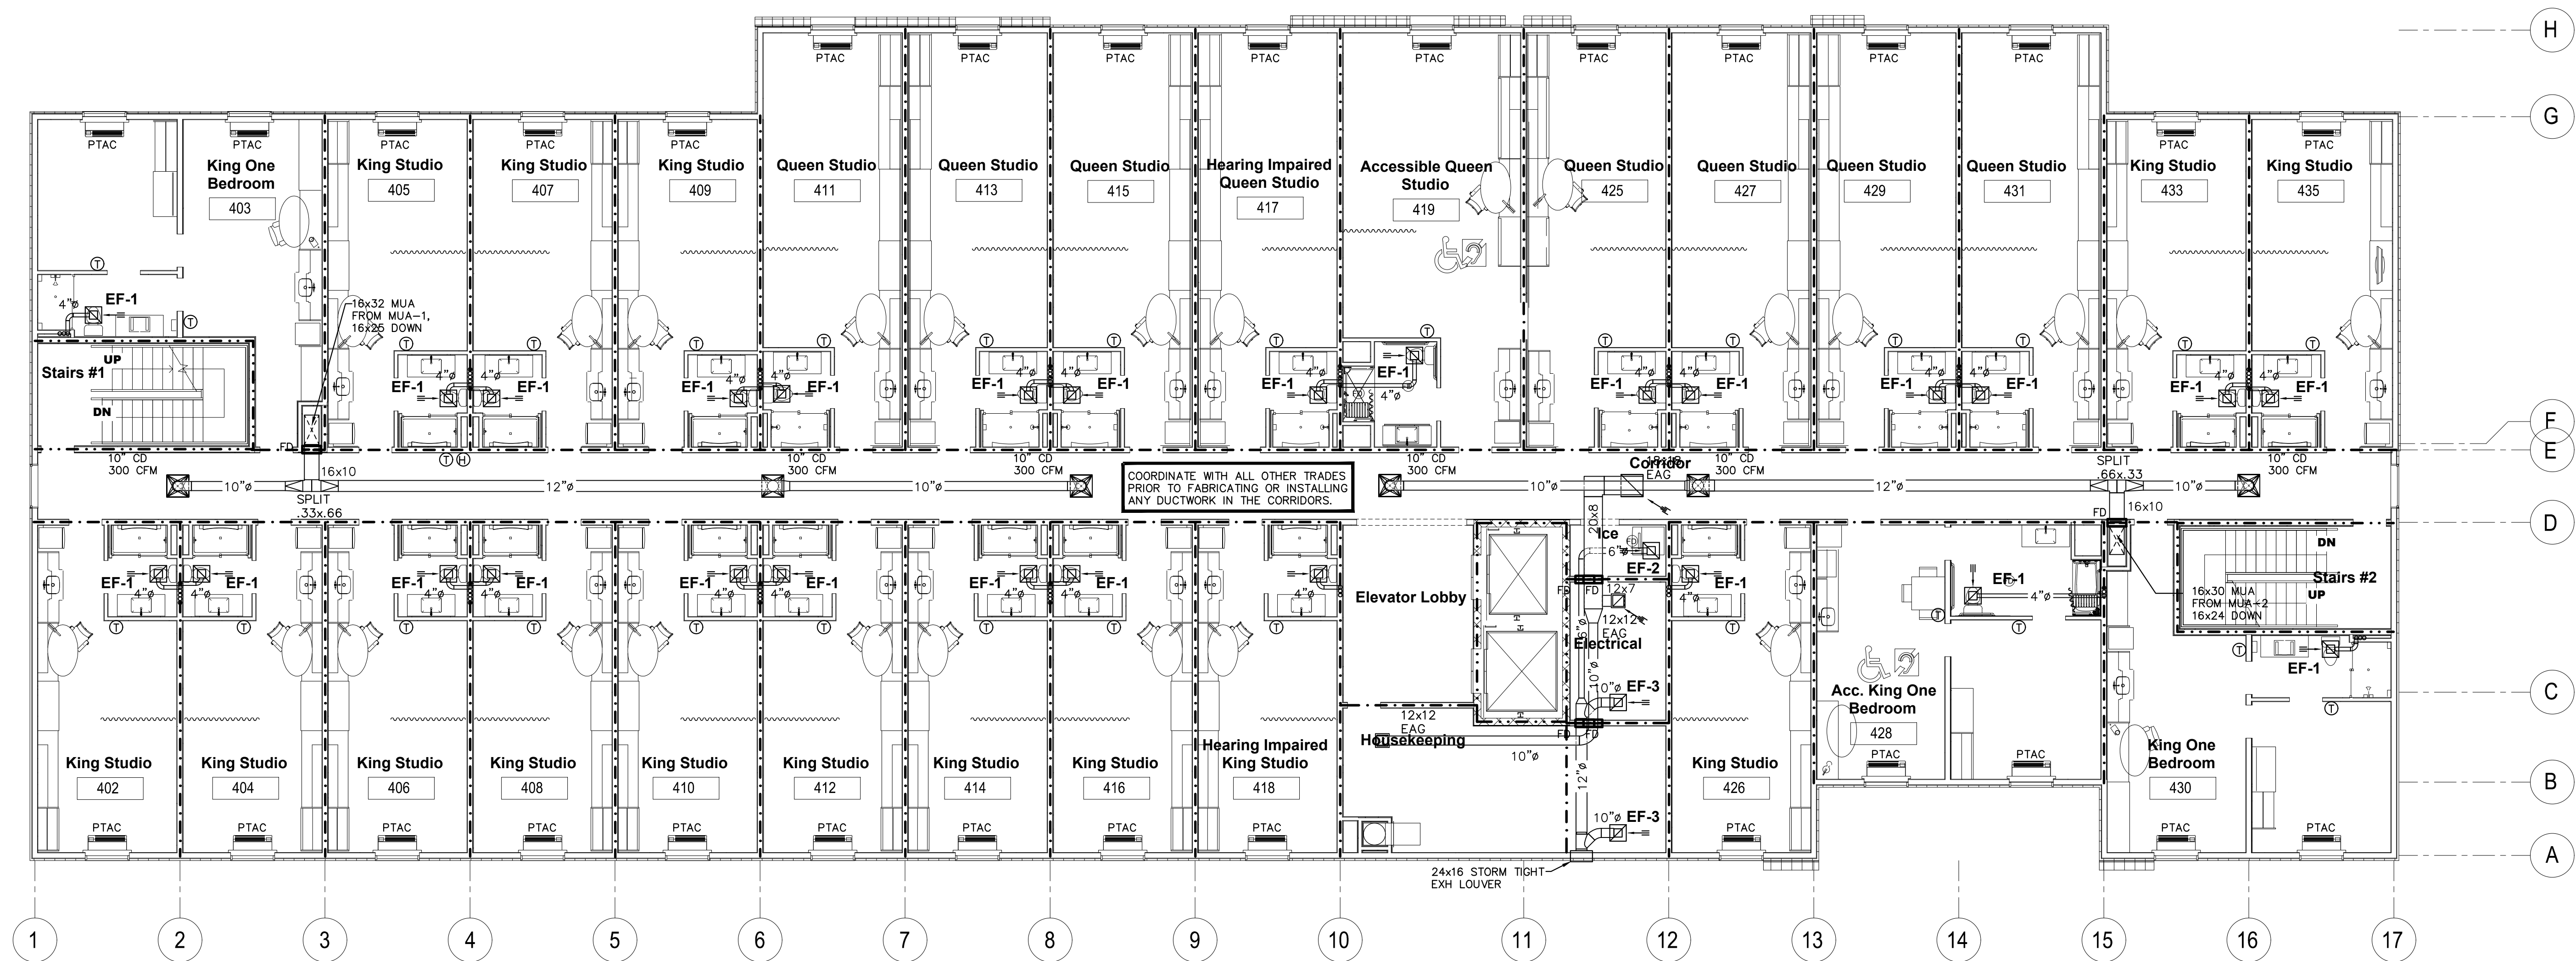
$$\overline{1/8'' = 1' - 0''}$$




CIVIL:
Benchmark Engineering and Surveying
101 Highpointe Court, Suite B
Brandon, MS 39042
Phone: (601) 591-1077
Fax: (601) 591-0177
Email:mikebes@bellsouth.net

STRUCTURAL:
Whisonant Engineering Services, LLC
122 Nut Tree Court
Lexington, SC 29074
Phone: (803) 957-4008
Email: bill@weslex.com

MEP:
INNOVATIVE ENGINEERING SERVICES
2787 Stage Center Dr.
Suite 101
Bartlett, Tennessee 38134
Phone: (662) 890-4220
Email: www.innovativees-llc.com

[illegible]

Information contained on this drawing and in all digital files associated is authorized for use on the project named herein only and is the property of MISHRA ARCHITECTURE PLLC and may not be reproduced in any manner without express written or verbal permission from authorized individuals. Original drawing is 24"x36" and scales are as indicated.^o
2011 MISHRA ARCHITECTURE PLLC

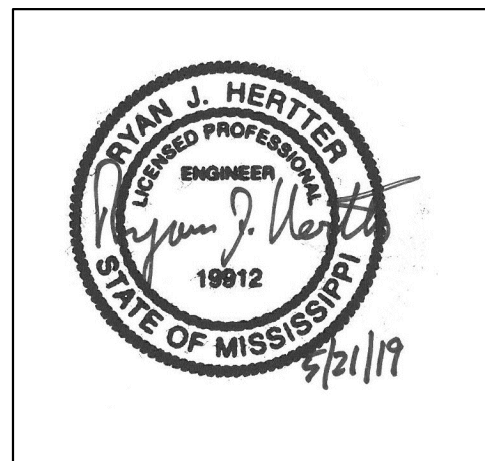

KEY PLAN

Pramukh Vicksburg,
LLC

Home2Suites
Vicksburg

Berryman Road
Vicksburg, MS 39180


Drawing Title

Roof Plan

Phase
Construction Documentss


Project No. 17-051
 Prepared by RHP
 Checked by RJH
 Date MAR. 28, 2019

Released for

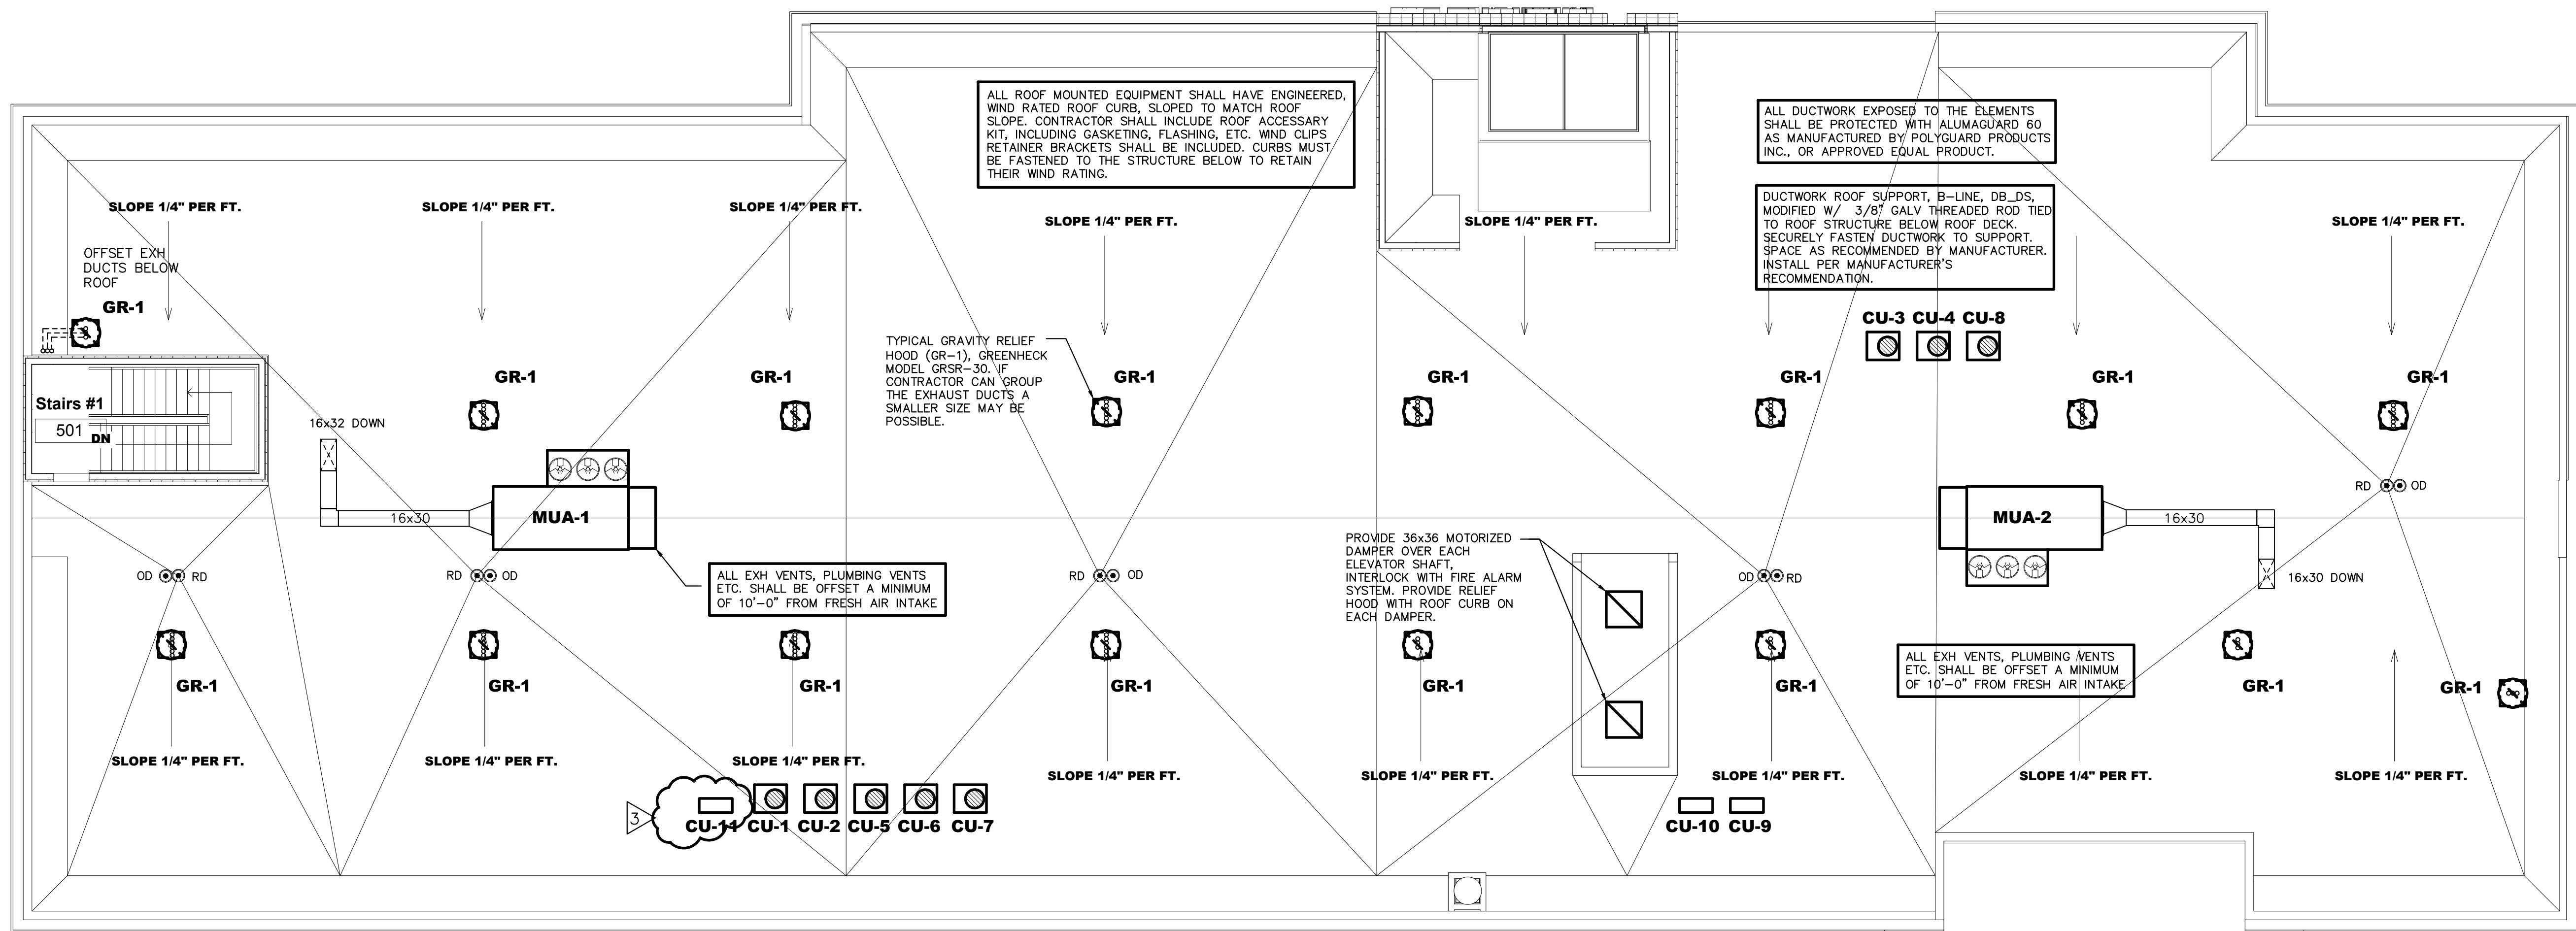


ROOF PLAN


$$1/8'' = 1' - 0''$$

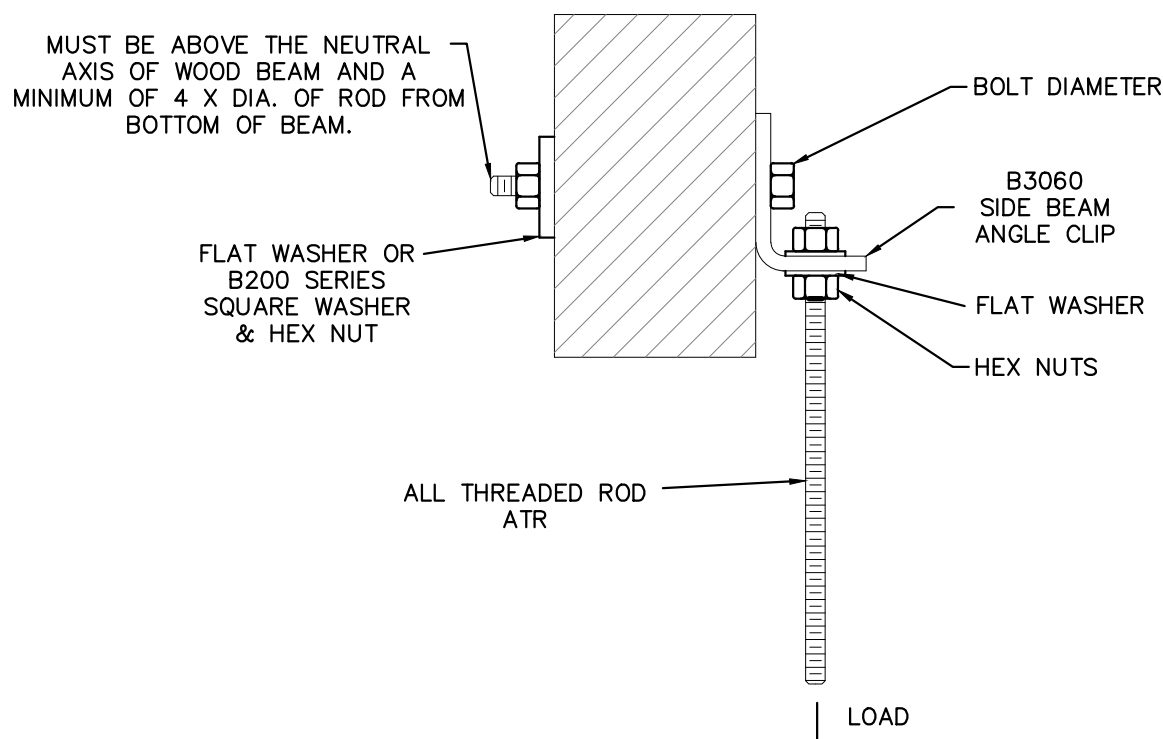


WOOD ATTACHMENTS
NO SCALE

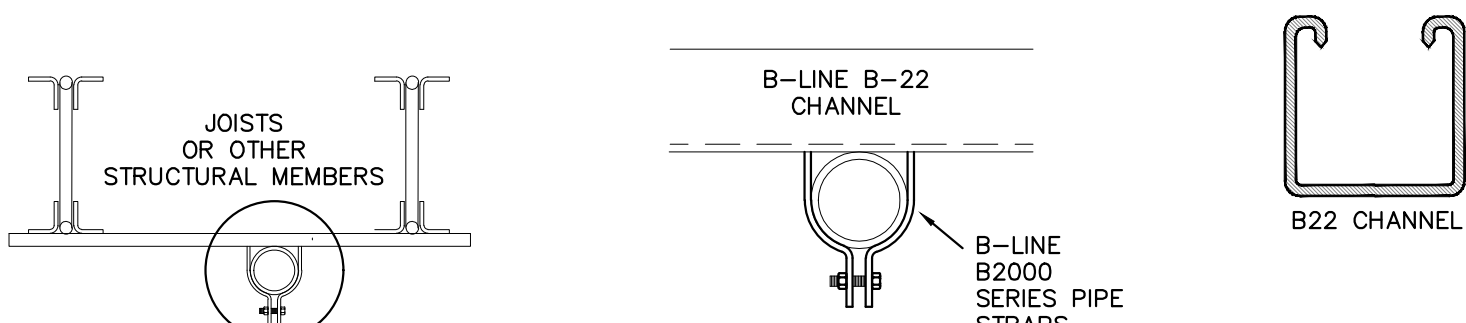


SEISMIC GAS PIPE SUPPORT DETAILS
NO SCALE

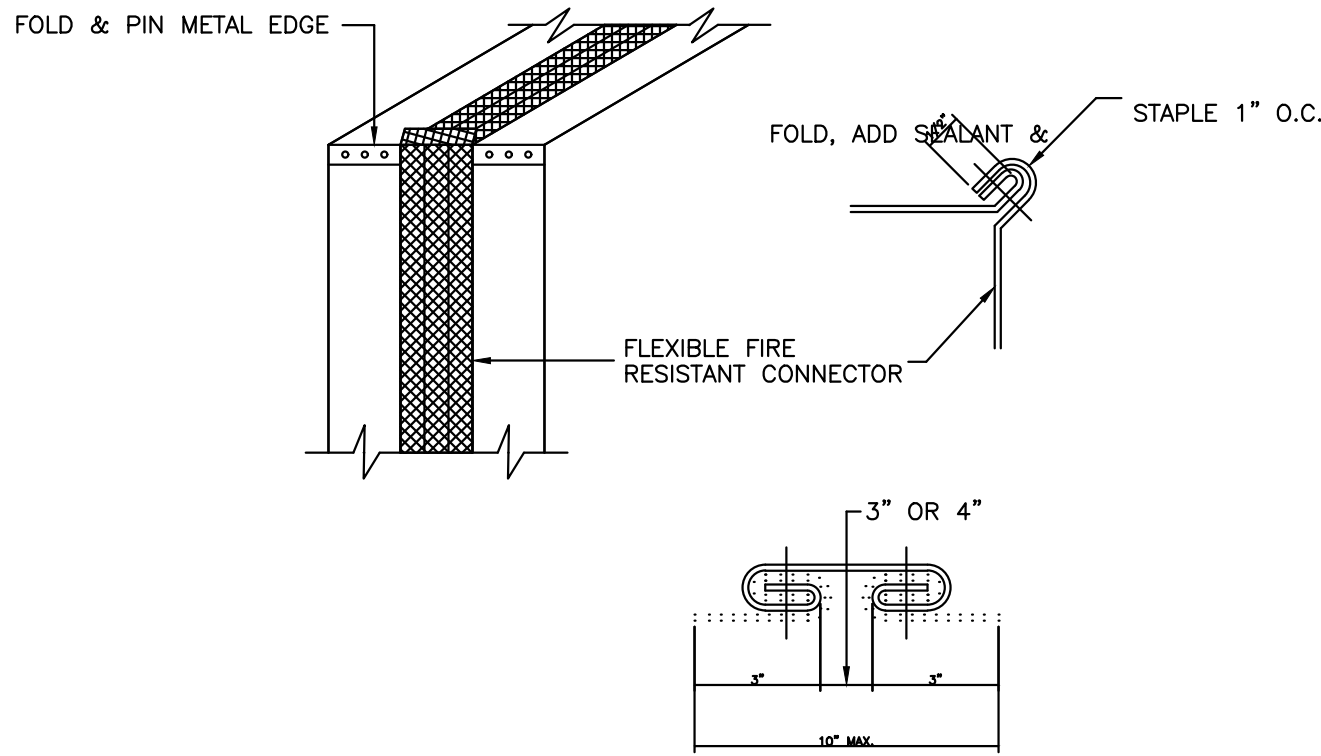

FLEXIBLE CONNECTION DETAIL
NO SCALE

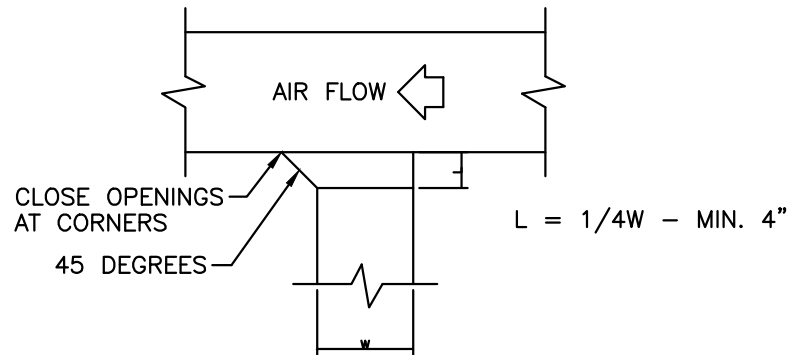


RETURN OR EXHAUST DUCT TAP DETAILS
NO SCALE

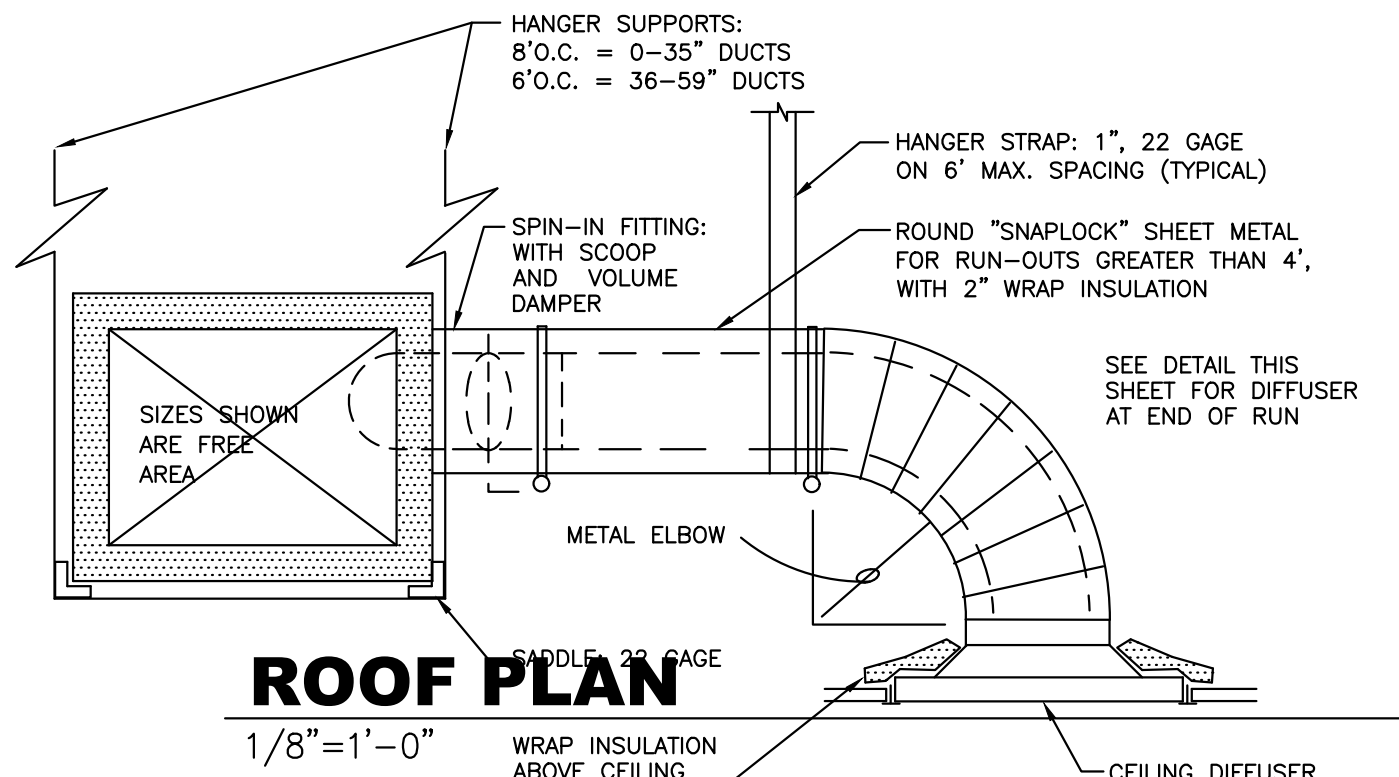


ROOF PLAN
1/8"=1'-0"
DUCT DETAIL
NO SCALE


- NOTES:
- HANGER SUPPORTS SHALL BE AS NOTED ABOVE FOR DUCTS UP TO 24", AND WITH TRAPEZE HANGERS FOR DUCTS 25" AND ABOVE.
 - ELBOWS SHALL BE SQUARE NECK (SAME IN AND OUT DIMENSION) WITH 2" DOUBLE THICKNESS TURNING VANES.
 - OFFSETS SHALL NOT EXCEED 30 DEGREE ANGLE, AND SHALL NOT REDUCE THE FREE AREA OF THE DUCT.
 - TRANSITIONS SHALL NOT EXCEED 1:3 RATIO (4" TRANSITION PER FOOT SINGLE SIDED TRANSITION, AND 8" PER FOOT DOUBLE SIDED TRANSITION).
 - RECTANGULAR BRANCH CONNECTIONS SHALL BE 45 DEGREE ENTRY TYPE, WITH METAL SLEEVE AND CLINCH LOCK CONNECTION. ENTRY LENGTH SHALL BE 25% OF BRANCH DUCT WIDTH.
 - ROUND BRANCH DUCT CONNECTIONS SHALL BE WITH "FLEXMASTER" FLD E SPIN-IN FITTINGS, WITH SCOOP, DAMPER AND HANDLE WHERE ROUND BRANCH DIA. EQUALS VERTICAL DIM. OF DUCT USE FLEXMASTER STO OR STOCK FITTING.
 - FLEXIBLE ROUND DUCT SHALL INCLUDE: HELIX COIL FLEXIBLE DUCTING, A 1-1/2" BLANKET INSULATION WITH MINIMUM 6.0 R VALUE, AND A ALUMINUM FOIL OUTER VAPOR BARRIER, AND BE UL-181 APPROVED, 25 OR LESS FLAME SPREAD AND 50 OR LESS SMOKE DEVELOPED. EQUAL TO "FLEXMASTER" TYPE 3M.

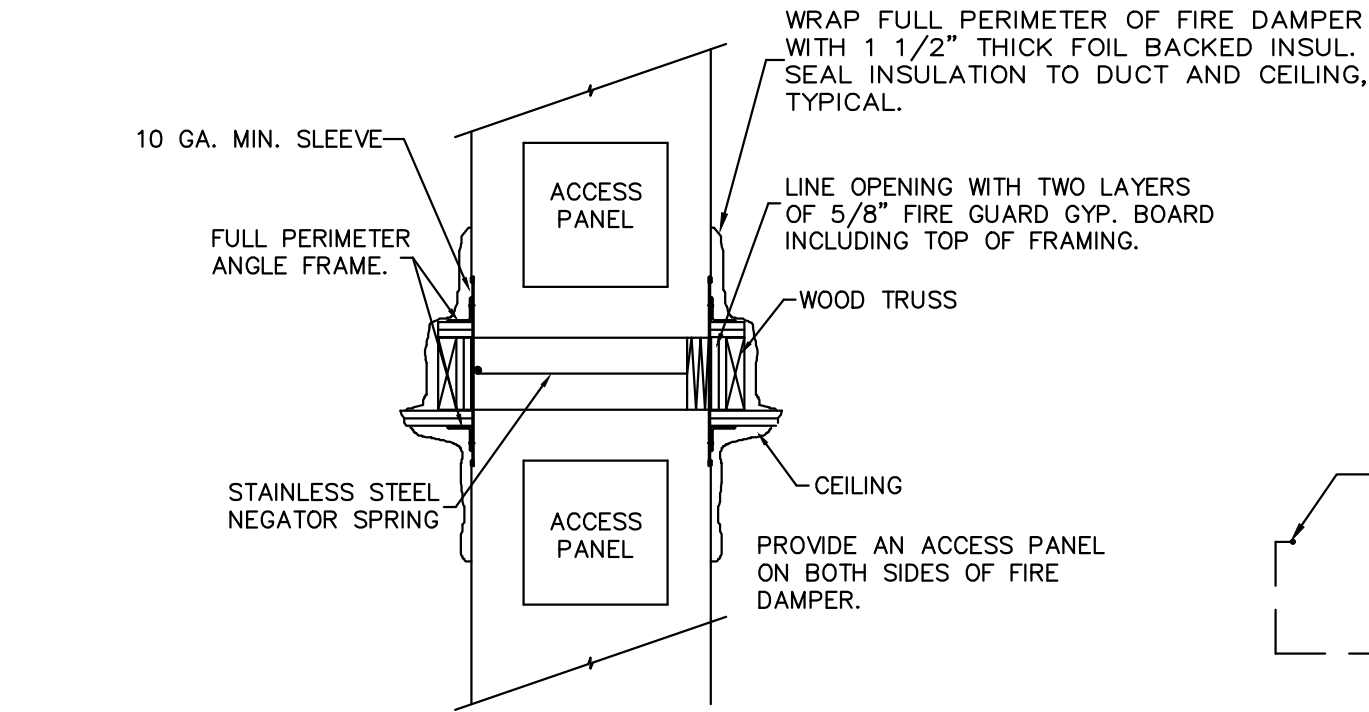

HORIZONTAL FIRE DAMPER DETAIL

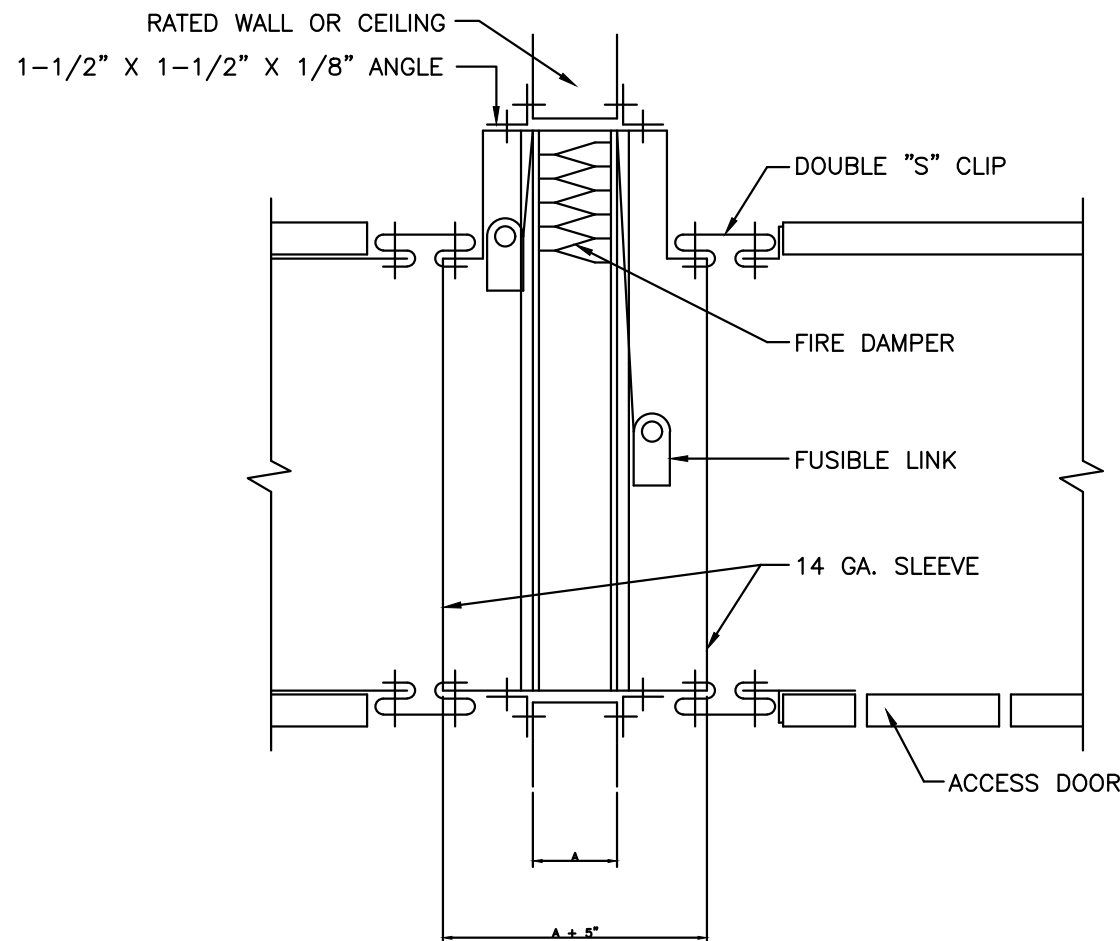

FIRE DAMPER DETAIL
NO SCALE

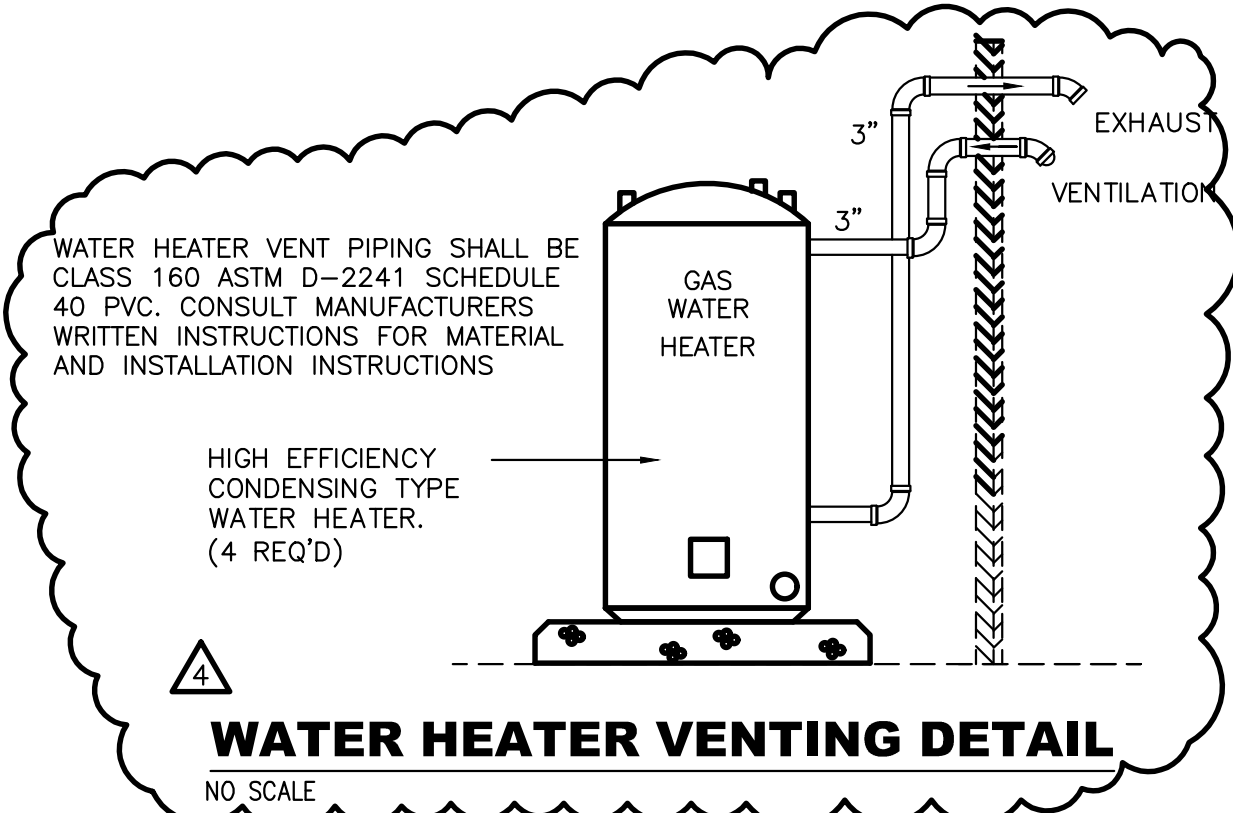


WATER HEATER VENTING DETAIL
NO SCALE

GAS PIPING SCHEMATIC
1/16" = 1'-0"


TOTAL PENETRATIONS SHALL NOT EXCEED 100 SQ.IN. IN 100 SQ.FT. (6) 4" DIA. PENETRATIONS

MAXIMUM OF 3 FLOORS PENETRATED W/O SHAFT OR DAMPERS *

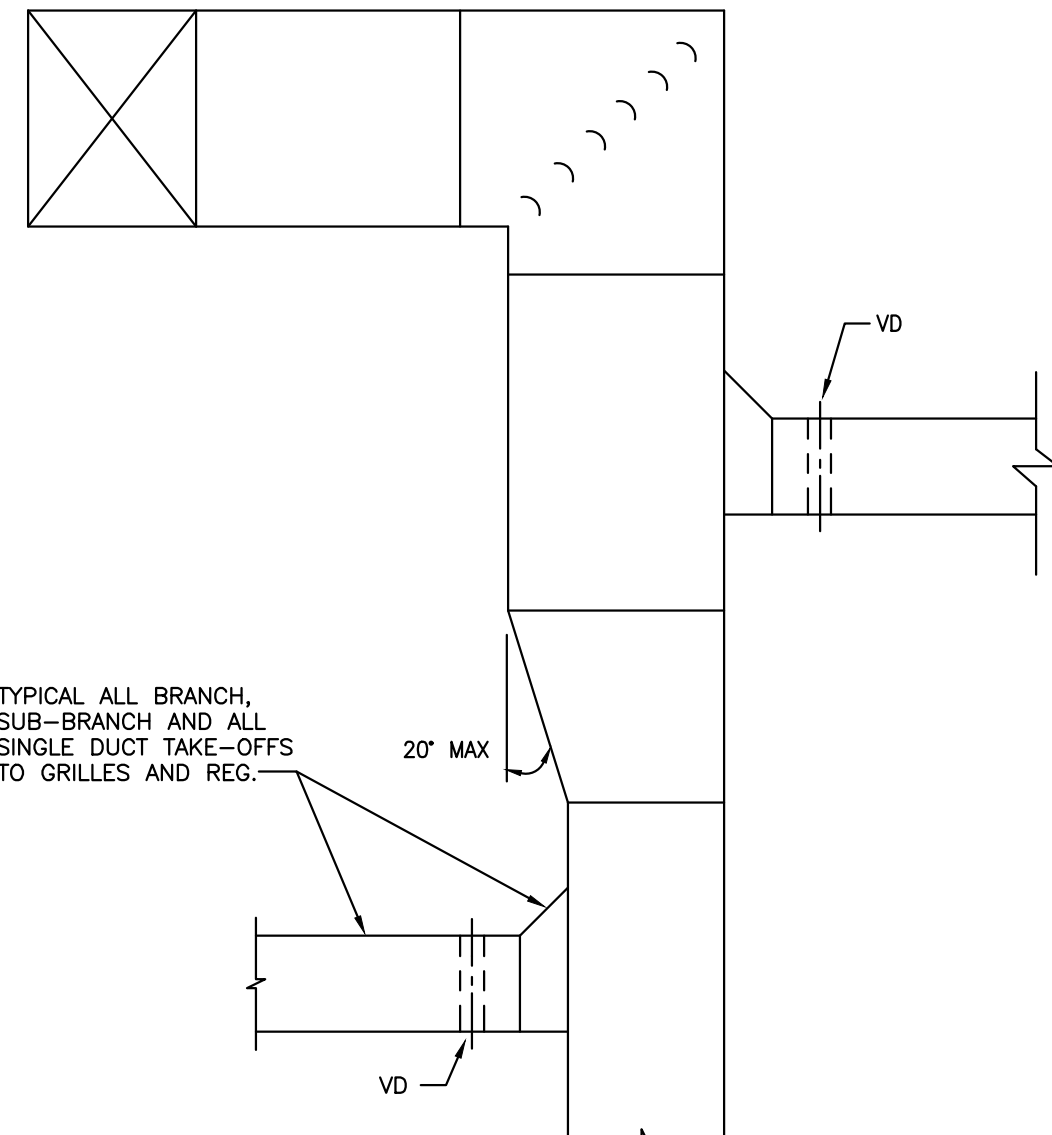

TYPICAL DUCT
NO SCALE

TYPICAL ROOM EXHAUST DUCT RISER DETAIL

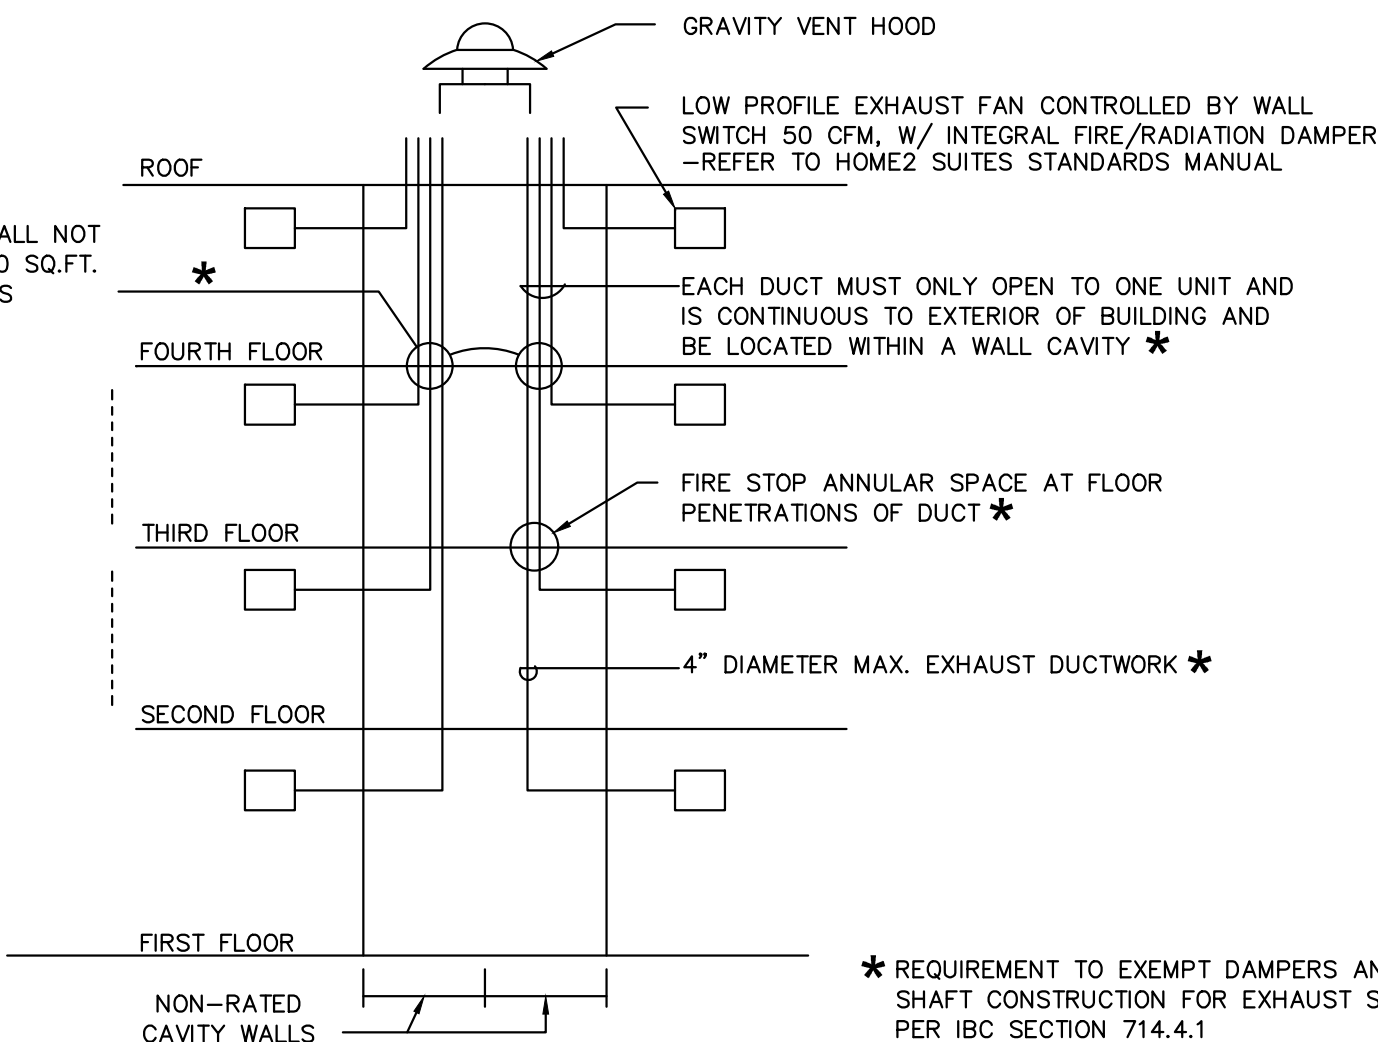

NO SCALE

IES
INNOVATIVE ENGINEERING
SERVICES LLC
2787 Stage Center Dr.
Suite 101
Bartlett, Tennessee 38134
Ph:(704) 625-6554 Fax:(704) 919-5822
EMAIL:ashish@mishraarch.com
www.innovativees-llc.com

MISHRA
ARCHITECTURE PLLC
6800 S Creek Rd. Charlotte, NC. 28277
Ph:(704) 625-6554 Fax:(704) 919-5822
EMAIL:ashish@mishraarch.com
WEB: www.mishraarch.com


CIVIL:
Benchmark Engineering and Surveying
101 Highpointe Court, Suite B
Brandon, MS 39042
Phone: (601) 591-1077
Fax: (601) 591-0177
Email:mikebes@bellsouth.net

STRUCTURAL:
Whisonant Engineering Services, LLC
122 Nut Tree Court
Lexington, SC 29074
Phone: (803) 957-4008
Email: bill@weslex.com

MEP:
INNOVATIVE ENGINEERING SERVICES
2787 Stage Center Dr.
Suite 101
Bartlett, Tennessee 38134
Phone: (662) 890-4220
Email: www.innovativees-llc.com

REVISIONS		
No.	Date	Description
4	7/01/19	CITY PLAN REVIEW

Information contained on this drawing and in all digital files associated is authorized for use on the project named herein only and is the property of MISHRA ARCHITECTURE PLLC and may not be reproduced in any manner without express written or verbal permission from authorized individuals. Original drawing is 24"x36" and scales are as indicated. 2011 MISHRA ARCHITECTURE PLLC

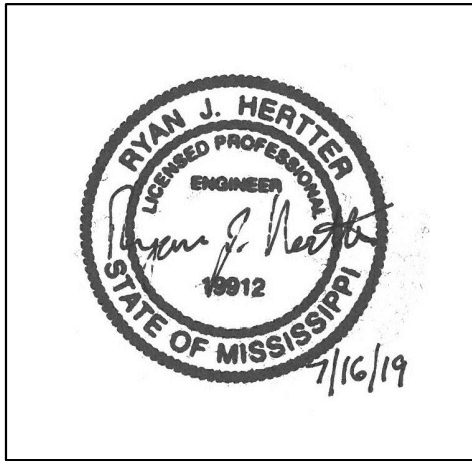

KEY PLAN

Pramukh Vicksburg, LLC

Home2Suites Vicksburg

Berryman Road Vicksburg, MS 39180

Drawing Title

Roof Plan

Phase Construction Documentss

Project No. 17-051
Prepared by RHP
Checked by RJH
Date MAR. 28, 2019

Sheet No. M200

Released for

Released from


CIVIL:
Benchmark Engineering and Surveying
101 Highpointe Court, Suite B
Brandon, MS 39042
Phone: (601) 591-1077
Fax: (601) 591-0177
Email: mikes@bellsouth.net

STRUCTURAL:
Whisonant Engineering Services, LLC
122 Nut Tree Court
Lexington, SC 29074
Phone: (803) 957-4008
Email: bill@weslex.com

MEP:
INNOVATIVE ENGINEERING SERVICES
2787 Stage Center Dr.
Suite 101
Bartlett, Tennessee 38134
Phone: (662) 890-4220
Email: www.innovativees-llc.com

REVISIONS		
No.	Date	Description
1	7/01/19	CITY PLAN REVIEW

Information contained on this drawing and in all digital files associated is authorized for use on the project named herein only and is the property of MISHRA ARCHITECTURE PLLC and may not be reproduced in any manner without express written or verbal permission from authorized individuals. Original drawing is 24"x36" and scales are as indicated.
2011 MISHRA ARCHITECTURE PLLC

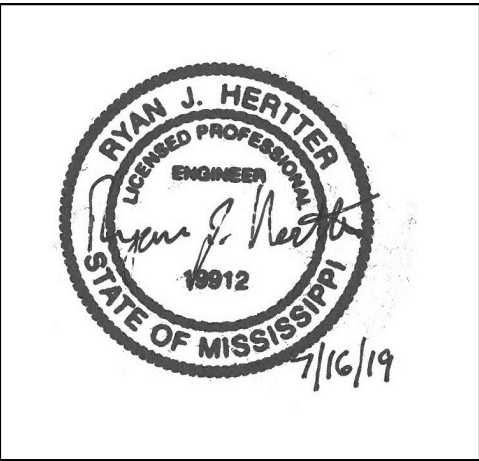

KEY PLAN

Pramukh Vicksburg, LLC

Home2Suites Vicksburg


Berryman Road Vicksburg, MS 39180

Drawing Title
First Floor Plan


Phase
Construction Documents

Project No.	17-051	Sheet No.	P101
Prepared by	RHP		
Checked by	RJH		
Date	MAR. 28, 2019		

Released for

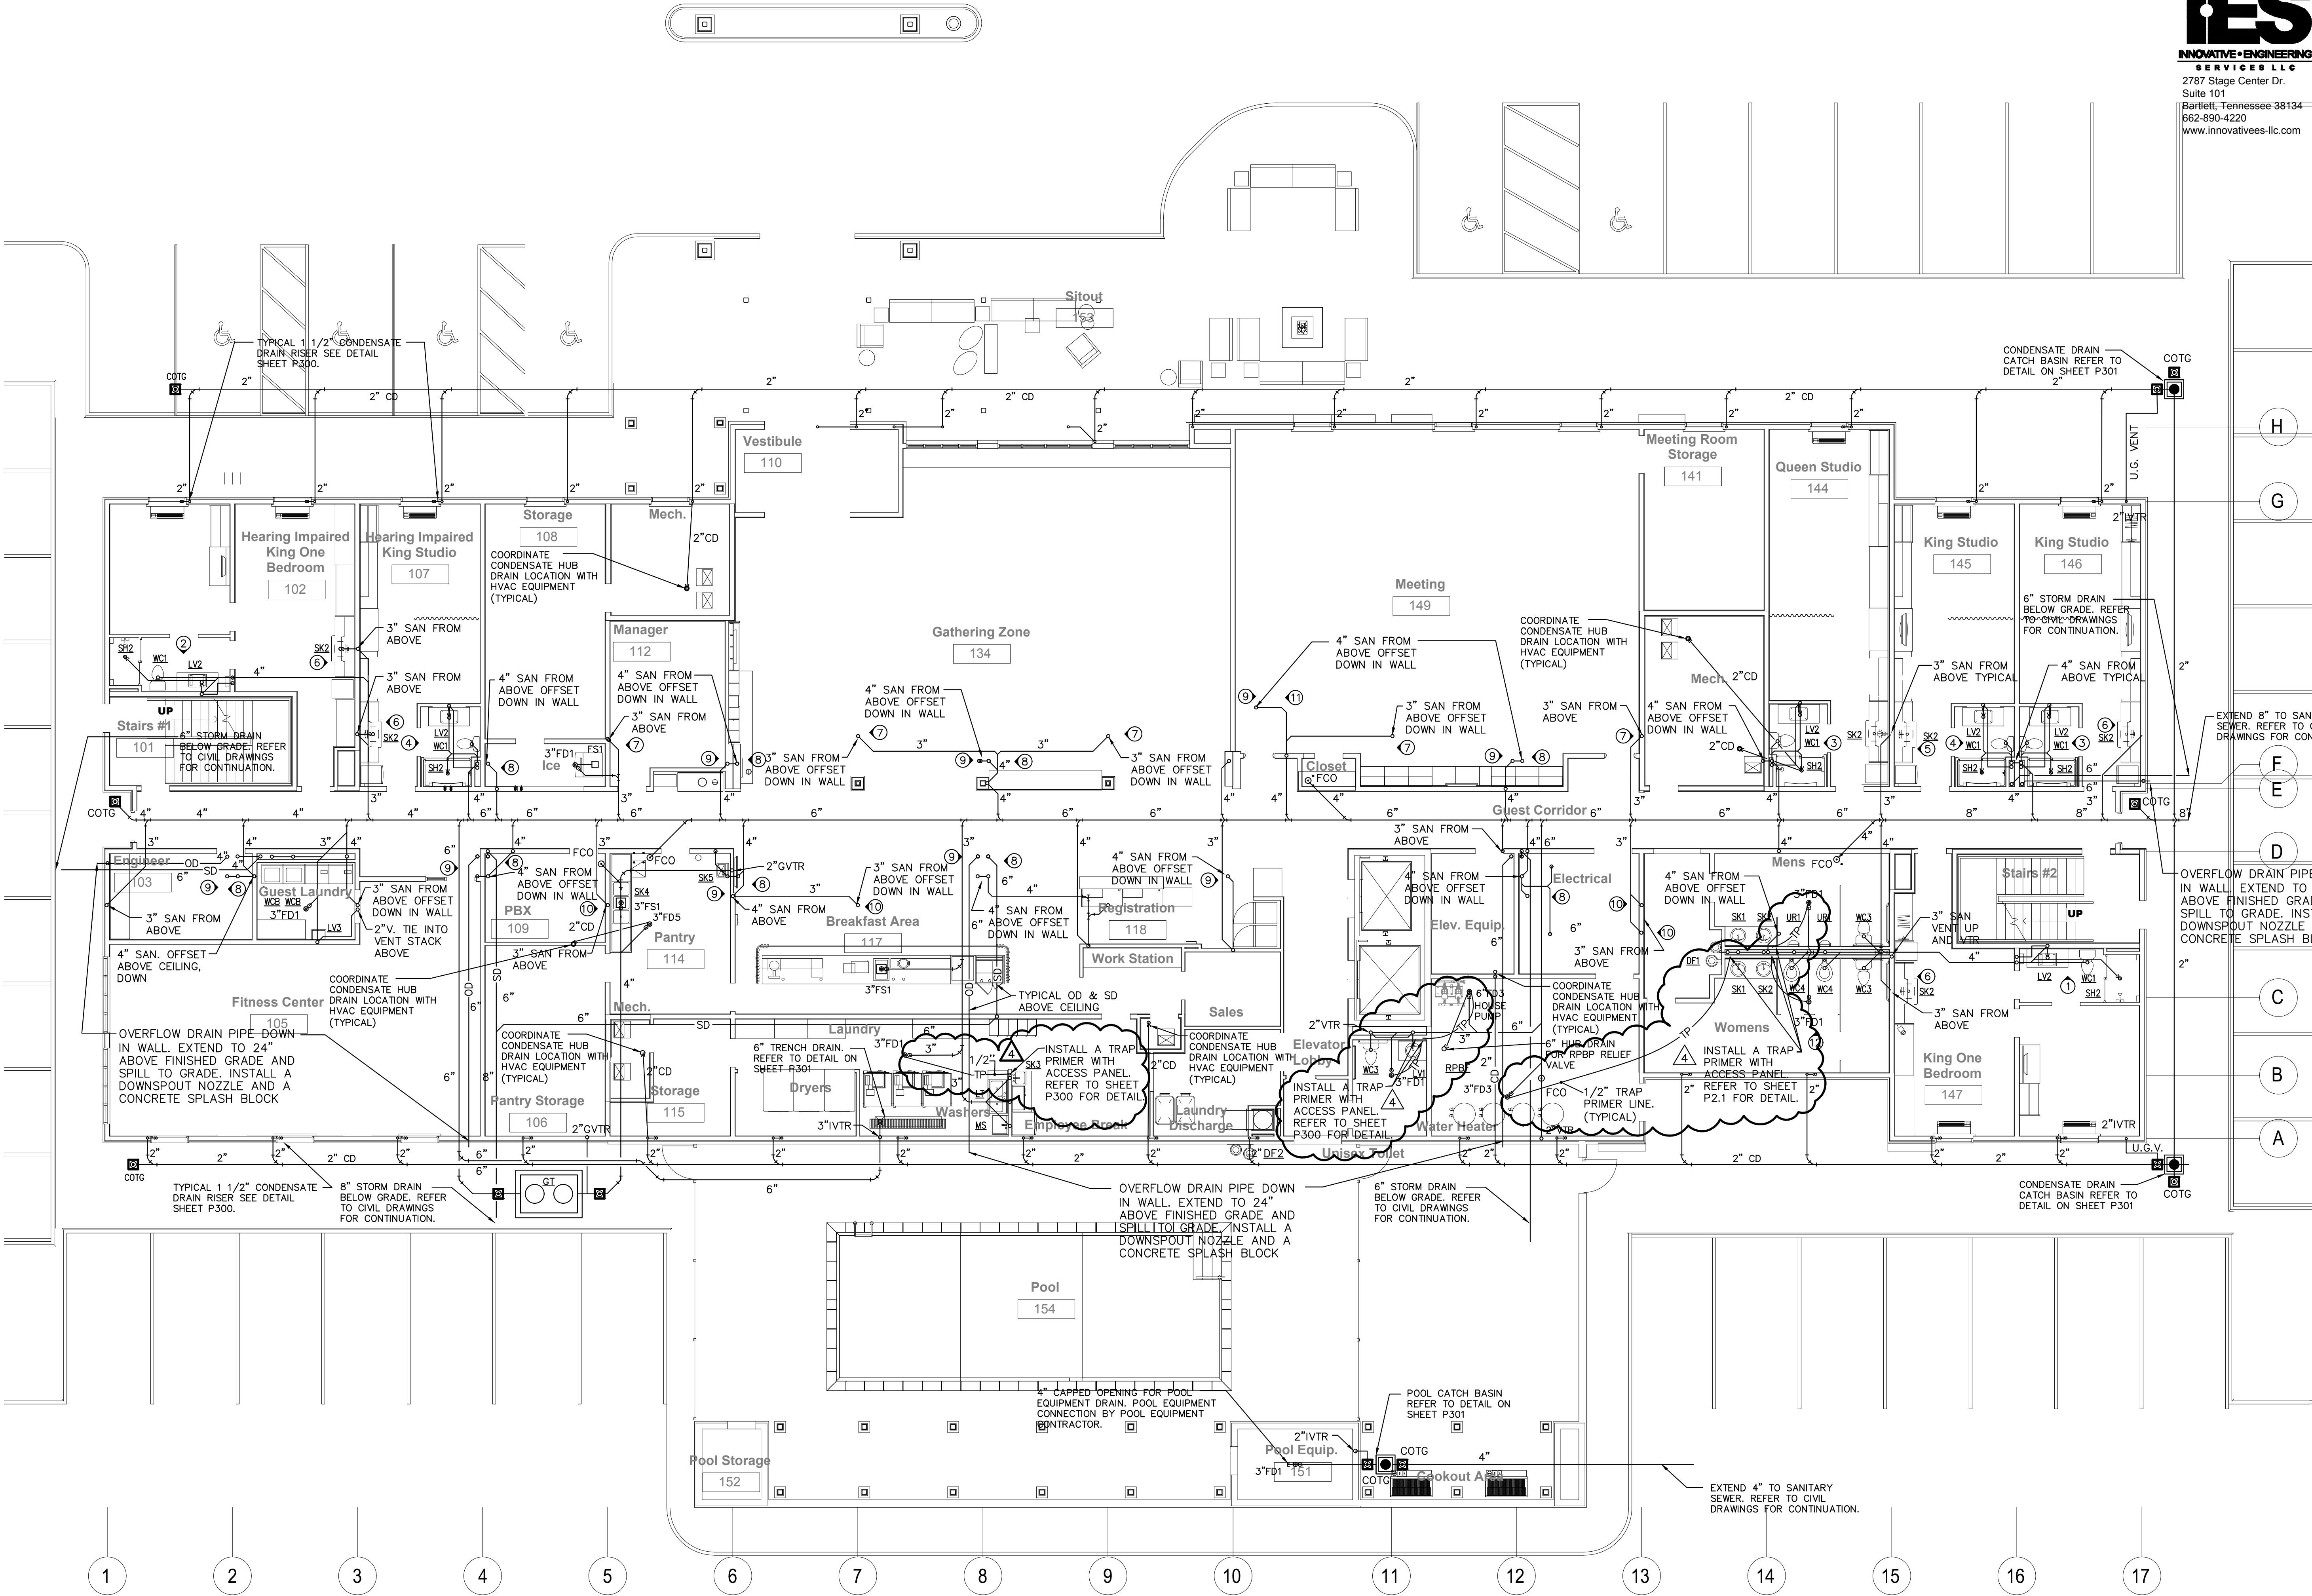

14/2019 7:45:21 AM

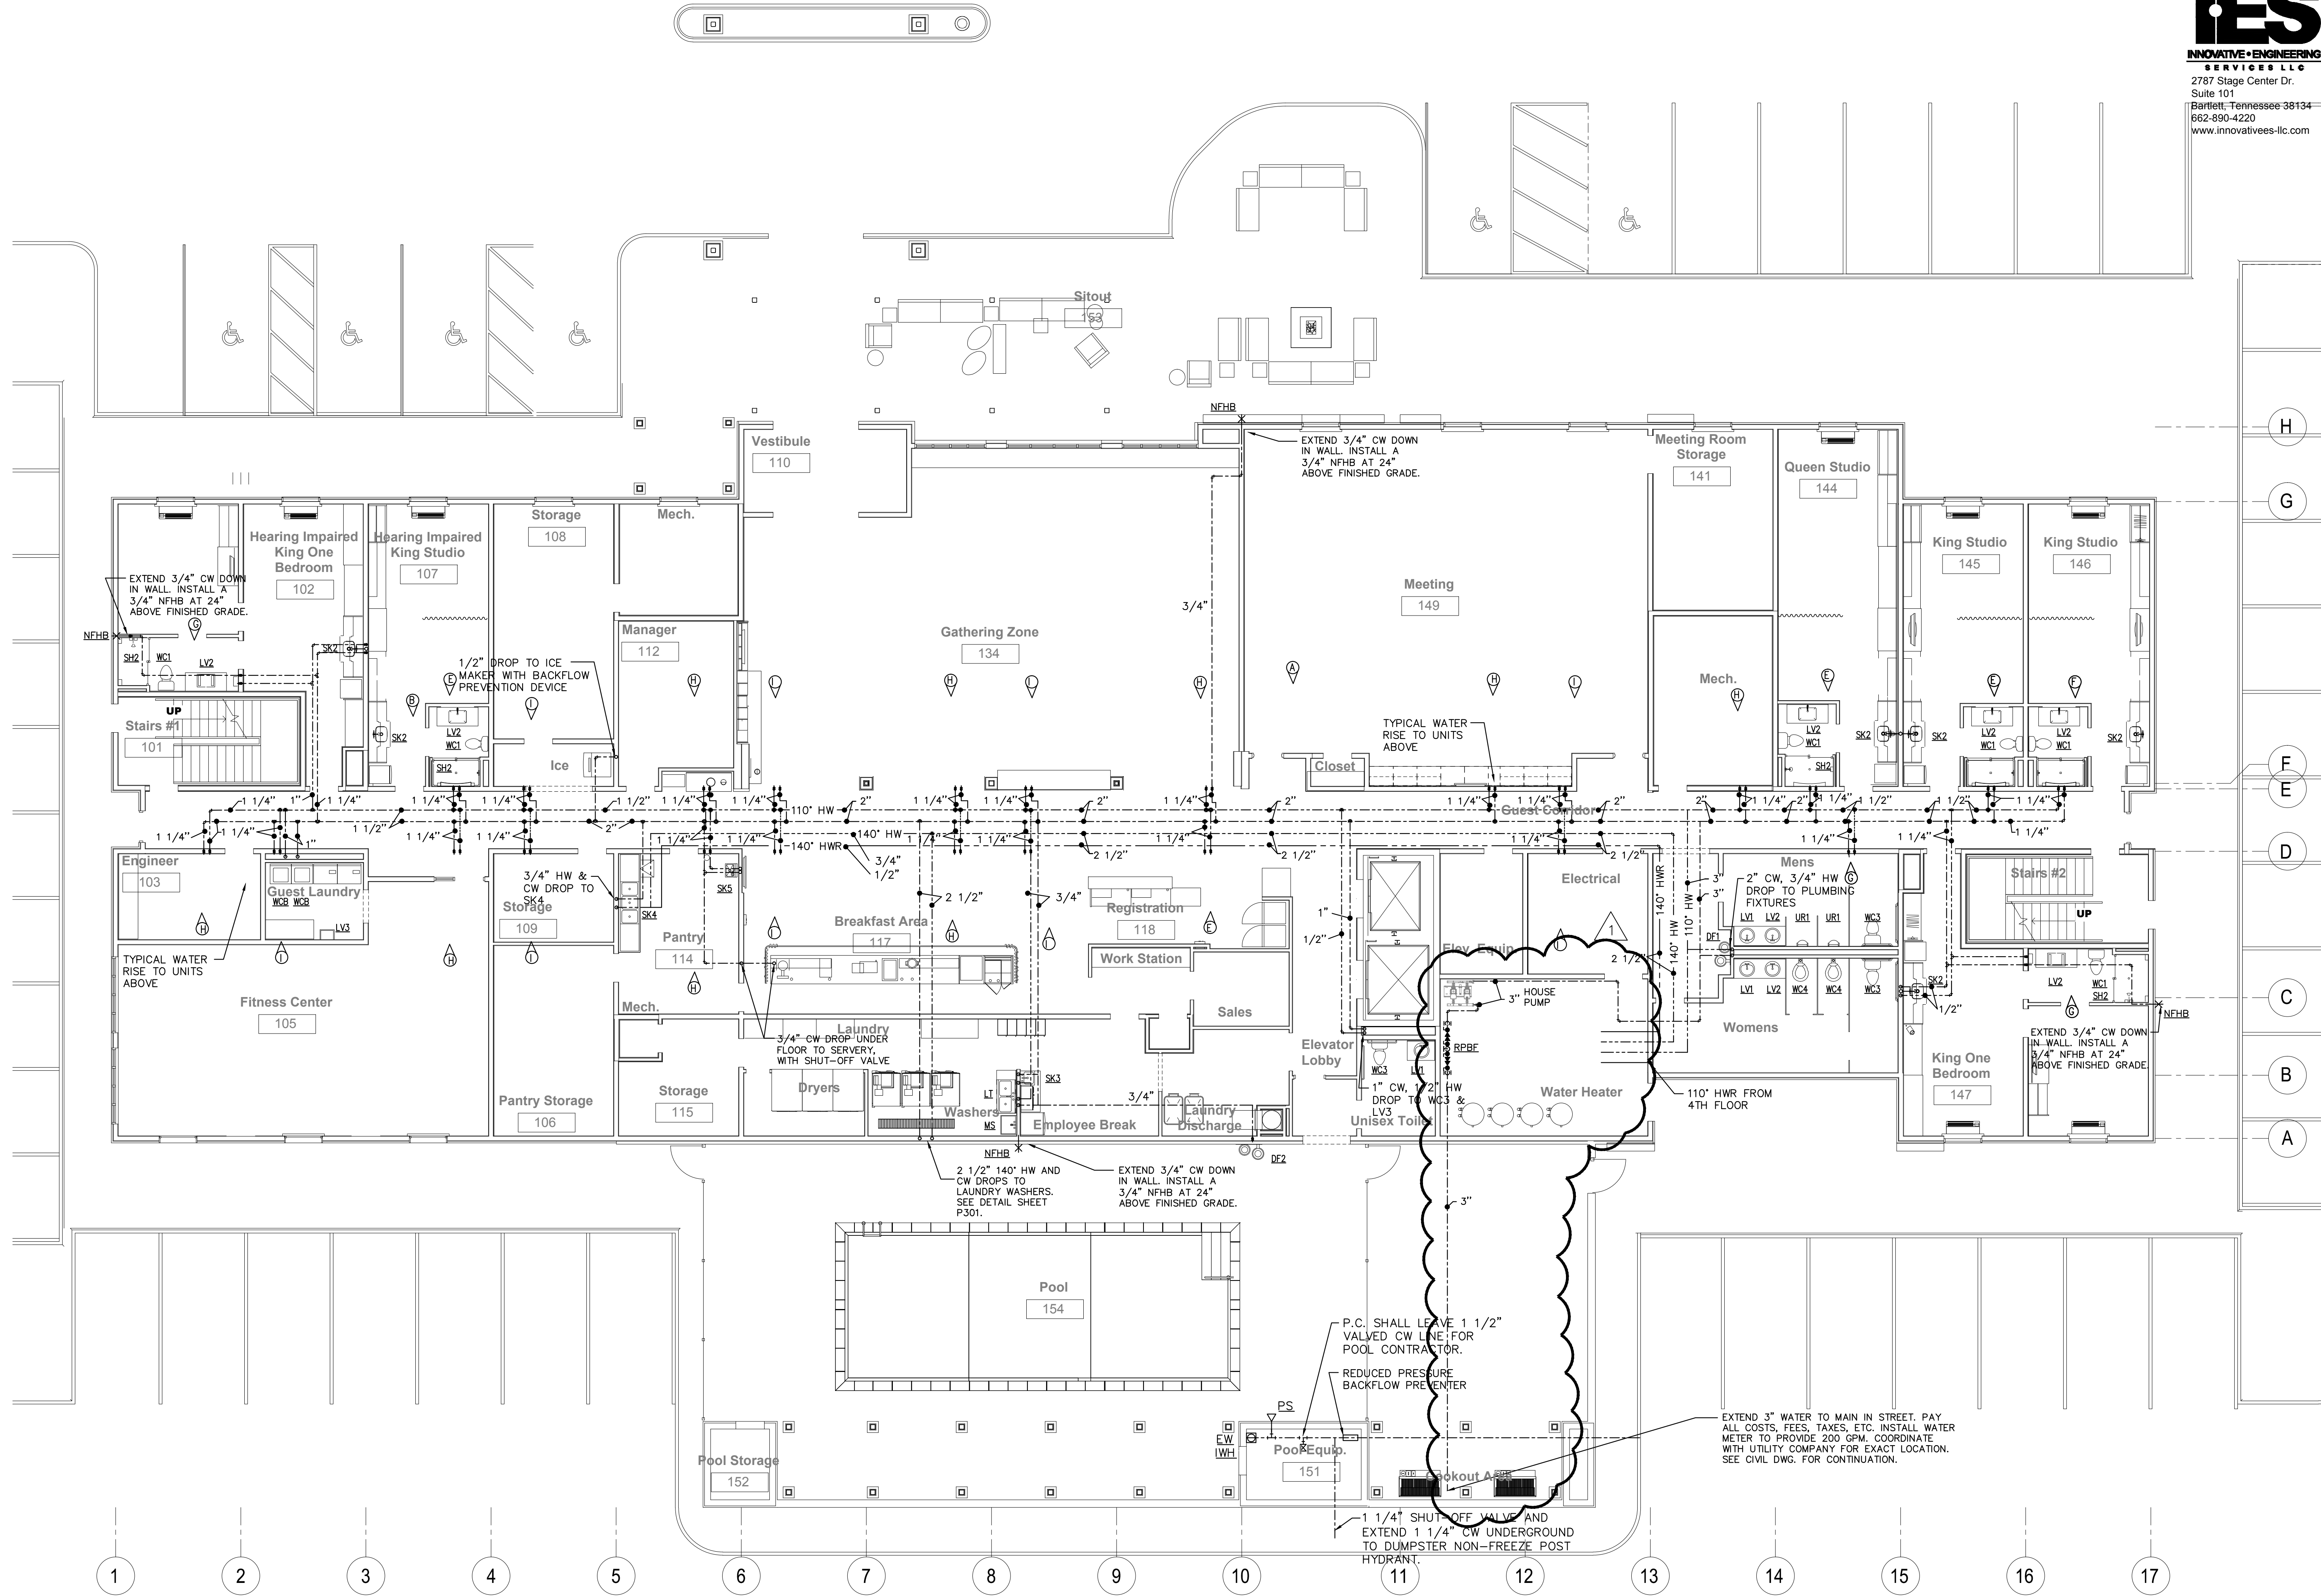

IES
INNOVATIVE ENGINEERING
SERVICES LLC
2787 Stage Center Dr.
Suite 101
Bartlett, Tennessee 38134
662-890-4220
www.innovativees-llc.com

MISHRA
ARCHITECTURE PLLC
6800 S Creek Rd. Charlotte, NC. 28277
Ph: (704) 625-6554 Fax: (704) 919-5822
EMAIL: ashish@mishraarch.com
WEB: www.mishraarch.com


CIVIL:
Benchmark Engineering and Surveying
101 Highpointe Court, Suite B
Brandon, MS 39042
Phone: (601) 591-1077
Fax: (601) 591-0177
Email: mikebes@bellsouth.net

STRUCTURAL:
Whisonant Engineering Services, LLC
122 Nut Tree Court
Lexington, SC 29074
Phone: (803) 957-4008
Email: bill@weslex.com

MEP:
INNOVATIVE ENGINEERING SERVICES
2787 Stage Center Dr.
Suite 101
Bartlett, Tennessee 38134
Phone: (662) 890-4220
Email: www.innovativees-llc.com

REVISIONS		
No.	Date	Description
1	4/22/19	Owner Request

Information contained on this drawing and in all digital files associated is authorized for use on the project named herein only and is the property of MISHRA ARCHITECTURE PLLC and may not be reproduced in any manner without express written or verbal permission from authorized individuals. Original drawing is 24"x36" and scales are as indicated. 2011 MISHRA ARCHITECTURE PLLC

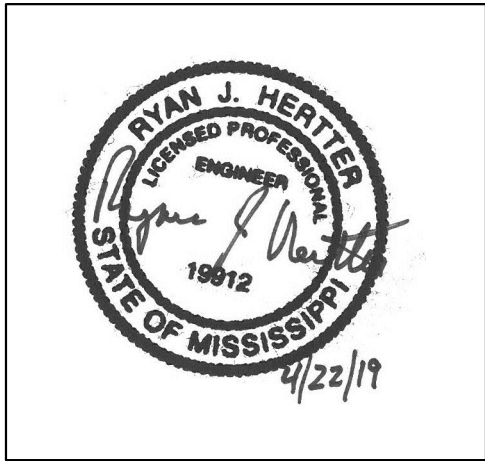

KEY PLAN

Pramukh Vicksburg, LLC

Home2Suites Vicksburg

Berryman Road Vicksburg, MS 39180
Drawing Title
First Floor Plan

Phase
Construction Documents

Project No.	17-051	Sheet No.	P101A
Prepared by	RHP		
Checked by	RJH		
Date	MAR. 28, 2019		

Released for




CIVIL:
Benchmark Engineering and Surveying
101 Highpointe Court, Suite B
Brandon, MS 39042
Phone: (601) 591-1077
Fax: (601) 591-0177
Email:mikebes@bellsouth.net

STRUCTURAL:
Whisonant Engineering Services, LLC
122 Nut Tree Court
Lexington, SC 29074
Phone: (803) 957-4008
Email: bill@weslex.com

MEP:
INNOVATIVE ENGINEERING SERVICES
2787 Stage Center Dr.
Suite 101
Bartlett, Tennessee 38134
Phone: (662) 890-4220
Email: www.innovativees-llc.com

[illegible]

Information contained on this drawing and in all digital files associated is authorized for use on the project named herein only and is the property of MISHRA ARCHITECTURE PLLC and may not be reproduced in any manner without express written or verbal permission from authorized individuals. Original drawing is 24"x36" and scales are as indicated.^o
2011 MISHRA ARCHITECTURE PLLC

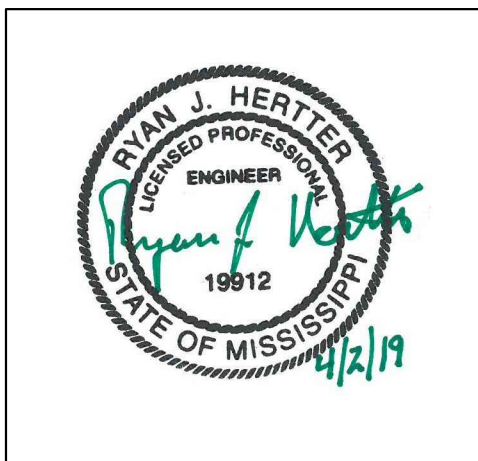

KEY PLAN

Pramukh Vicksburg,
LLC

Home2Suites
Vicksburg

Berryman Road
Vicksburg, MS 39180


Drawing Title

Second Floor Plan

Phase
Construction Documentss

Project No.	17-051	Sheet No. P102
Prepared by	RHP	
Checked by	RJH	
Date	MAR. 28, 2019	

Released from

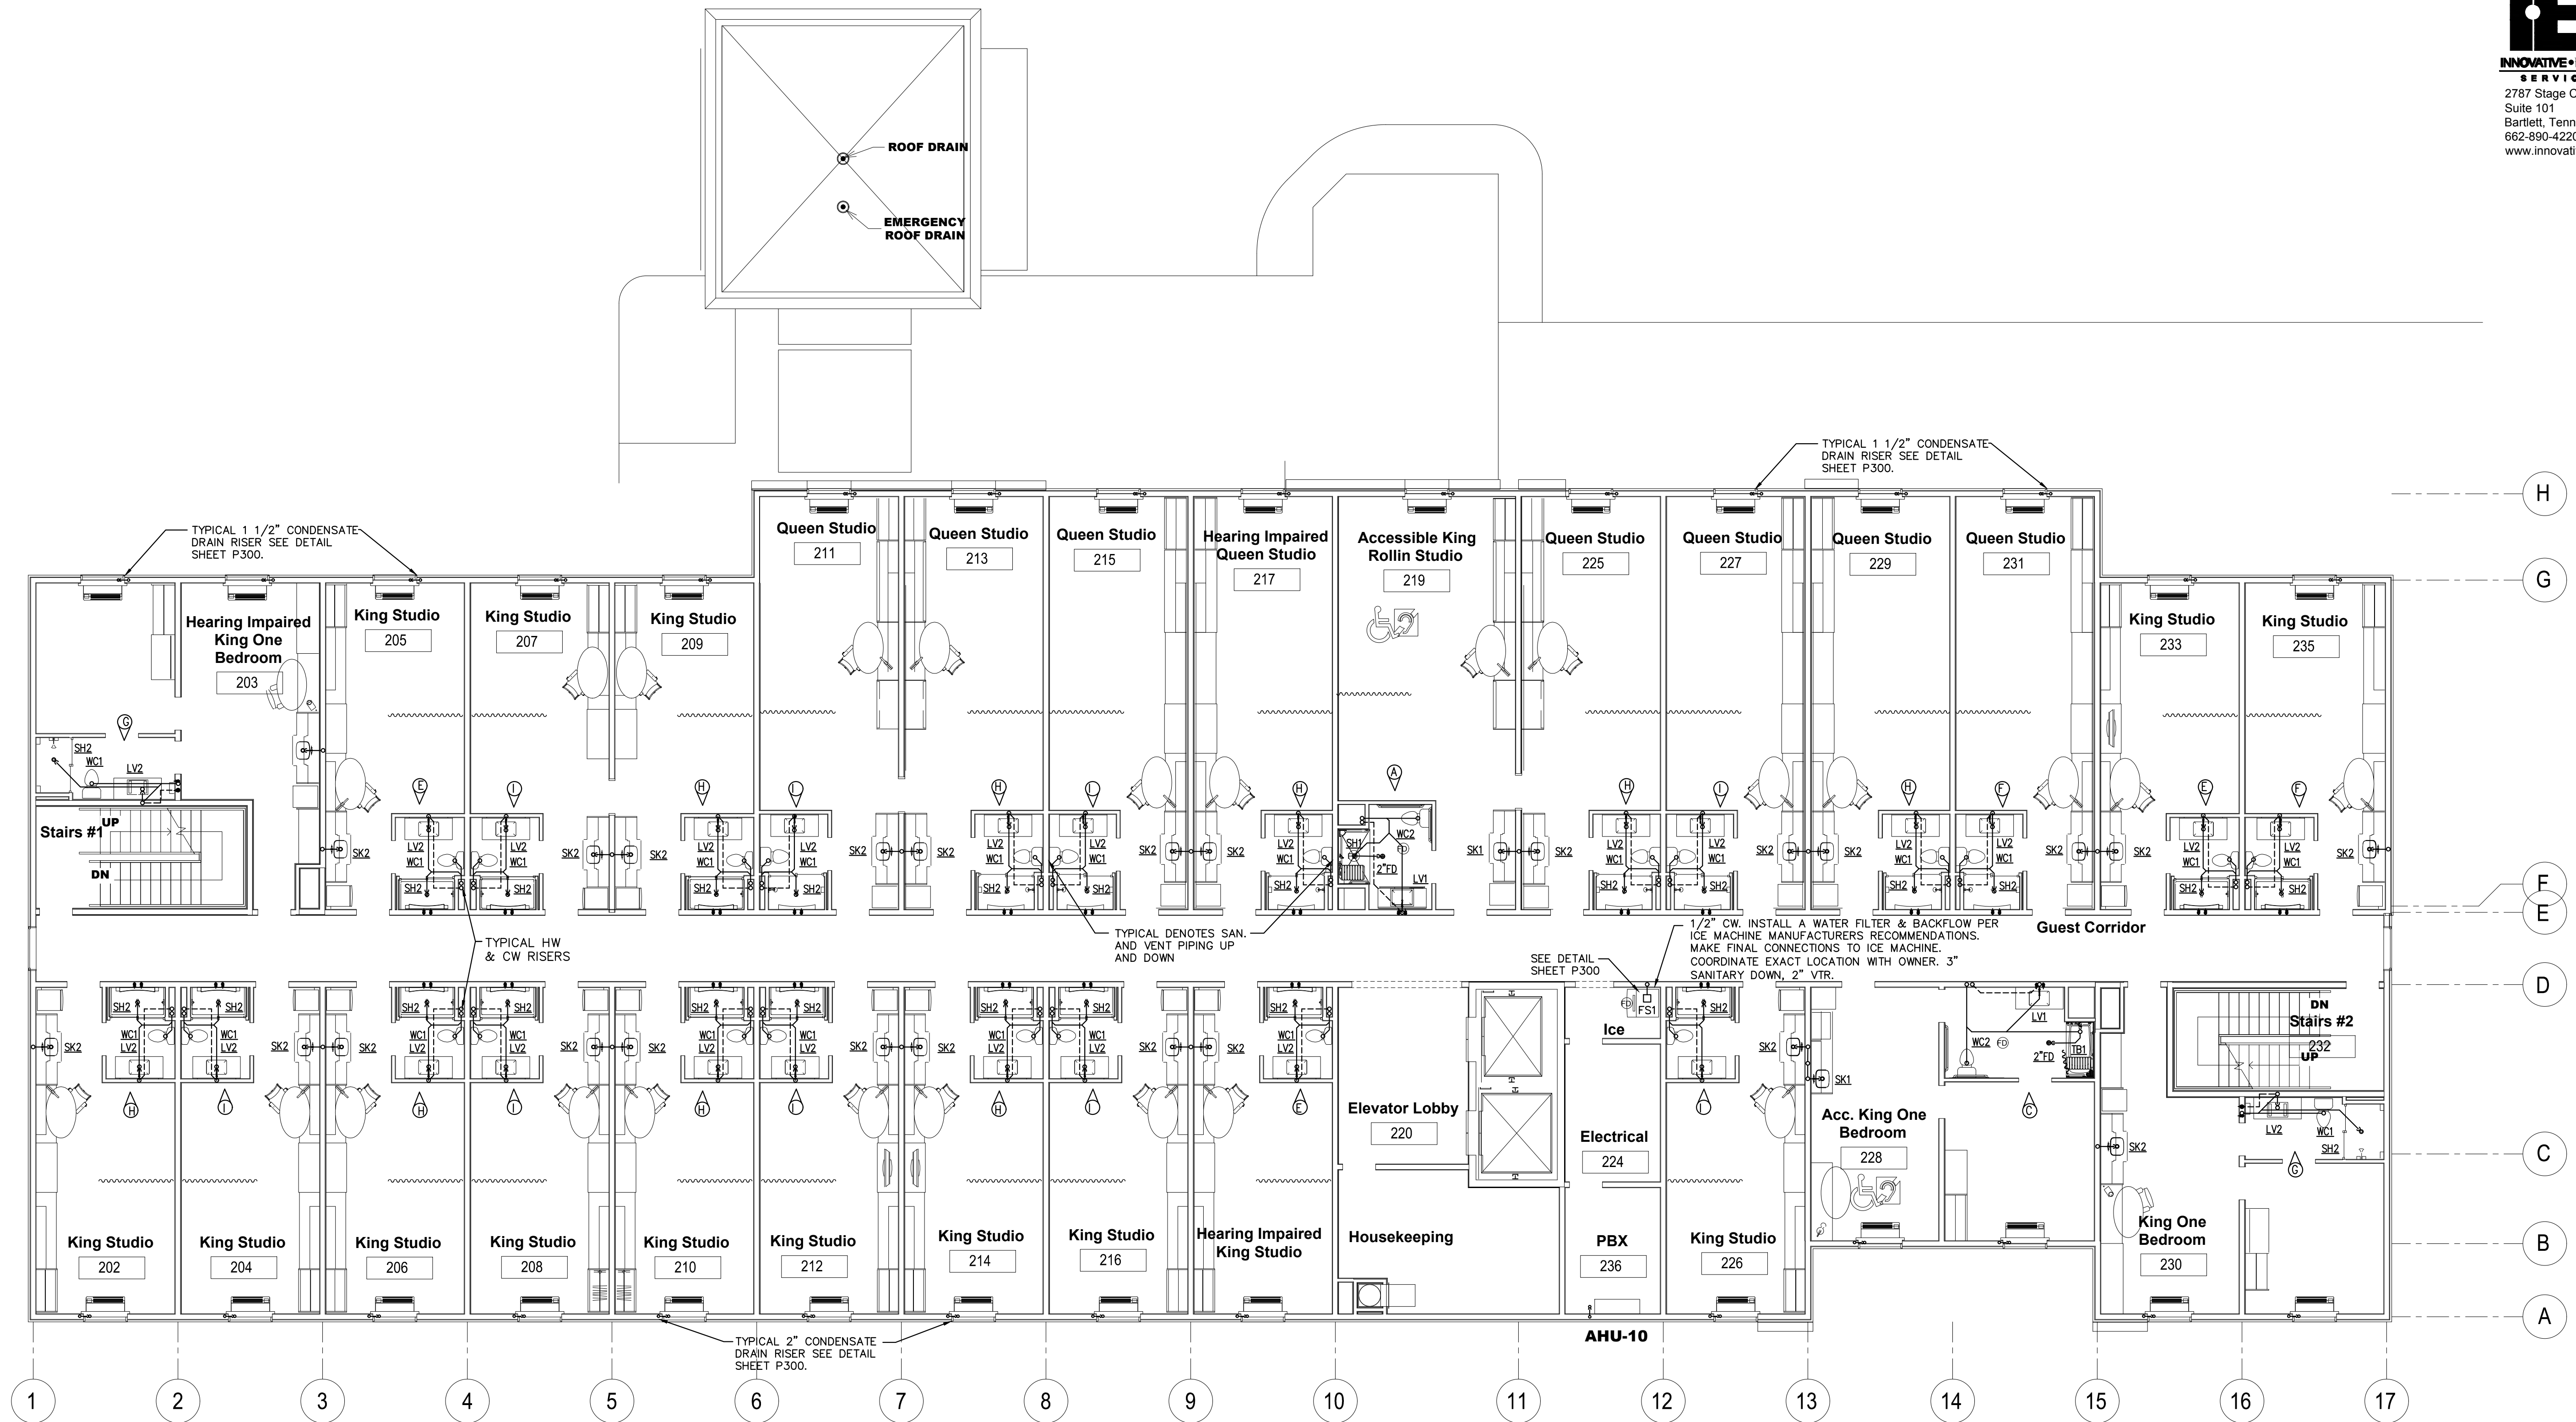




CIVIL:
Benchmark Engineering and Surveying
101 Highpointe Court, Suite B
Brandon, MS 39042
Phone: (601) 591-1077
Fax: (601) 591-0177
Email: mikebes@bellsouth.net

STRUCTURAL:
Whisonant Engineering Services, LLC
122 Nut Tree Court
Lexington, SC 29074
Phone: (803) 957-4008
Email: bill@weslex.com

MEP:
INNOVATIVE ENGINEERING SERVICES
2787 Stage Center Dr.
Suite 101
Bartlett, Tennessee 38134
Phone: (662) 890-4220
Email: www.innovativees-llc.com

[illegible]

Information contained on this drawing and in all digital files associated is authorized for use on the project named herein only and is the property of MISHRA ARCHITECTURE PLLC and may not be reproduced in any manner without express written or verbal permission from authorized individuals. Original drawing is 24"x36" and scales are as indicated.^o
2011 MISHRA ARCHITECTURE PLLC

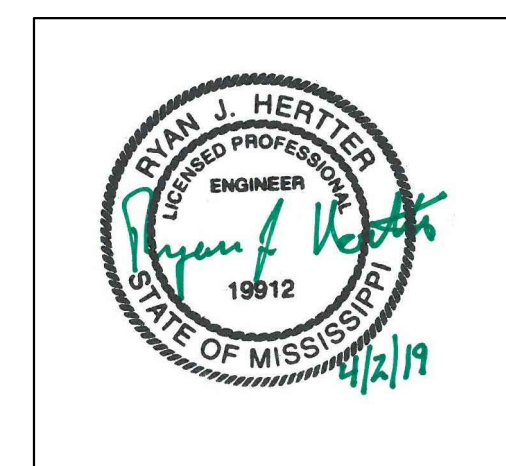

KEY PLAN

Pramukh Vicksburg,
LLC

Home2Suites
Vicksburg

Berryman Road
Vicksburg, MS 39180


Drawing Title

Third Floor Plan

Phase
Construction Documentss

Project No. 17-051
 Prepared by RHP
 Checked by RJH
 Date MAR. 28, 2019

Released from

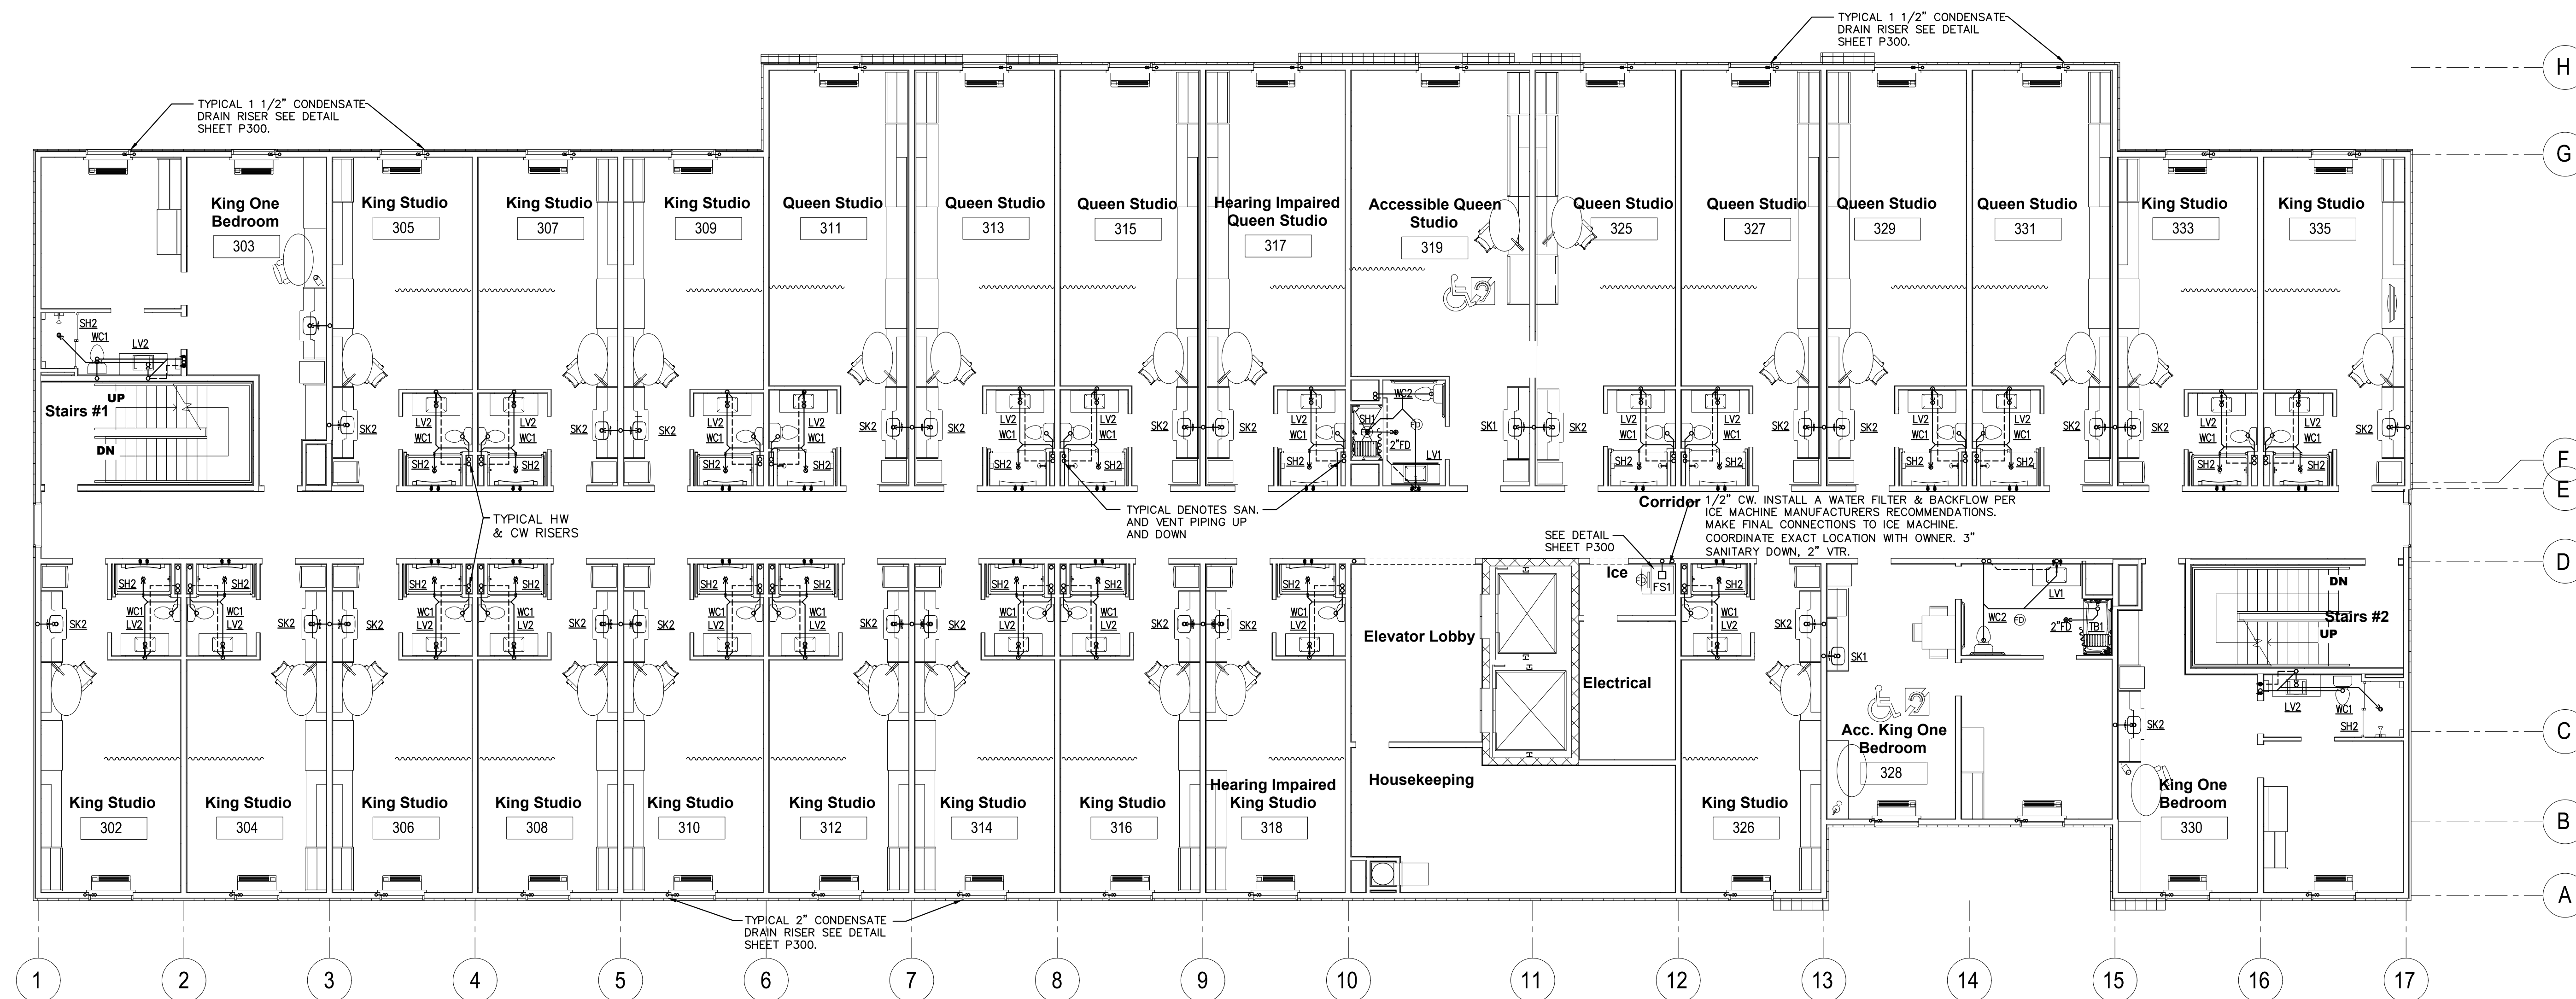



CIVIL:
Benchmark Engineering and Surveying
101 Highpointe Court, Suite B
Brandon, MS 39042
Phone: (601) 591-1077
Fax: (601) 591-0177
Email:mikebes@bellsouth.net

STRUCTURAL:
Whisonant Engineering Services, LLC
122 Nut Tree Court
Lexington, SC 29074
Phone: (803) 957-4008
Email: bill@weslex.com

MEP:
INNOVATIVE ENGINEERING SERVICES
2787 Stage Center Dr.
Suite 101
Bartlett, Tennessee 38134
Phone: (662) 890-4220
Email: www.innovativees-llc.com

[illegible]

Information contained on this drawing and in all digital files associated is authorized for use on the project named herein only and is the property of MISHRA ARCHITECTURE PLLC and may not be reproduced in any manner without express written or verbal permission from authorized individuals. Original drawing is 24"x36" and scales are as indicated.^o
2011 MISHRA ARCHITECTURE PLLC



KEY PLAN

Pramukh Vicksburg,
LLC

Home2Suites
Vicksburg

Berryman Road
Vicksburg, MS 39180


Drawing Title

Fourth Floor Plan

Phase
Construction Documentss

Project No.	17-051	Sheet No. P104
Prepared by	RHP	
Checked by	RJH	
Date	MAR. 28, 2019	

Released for

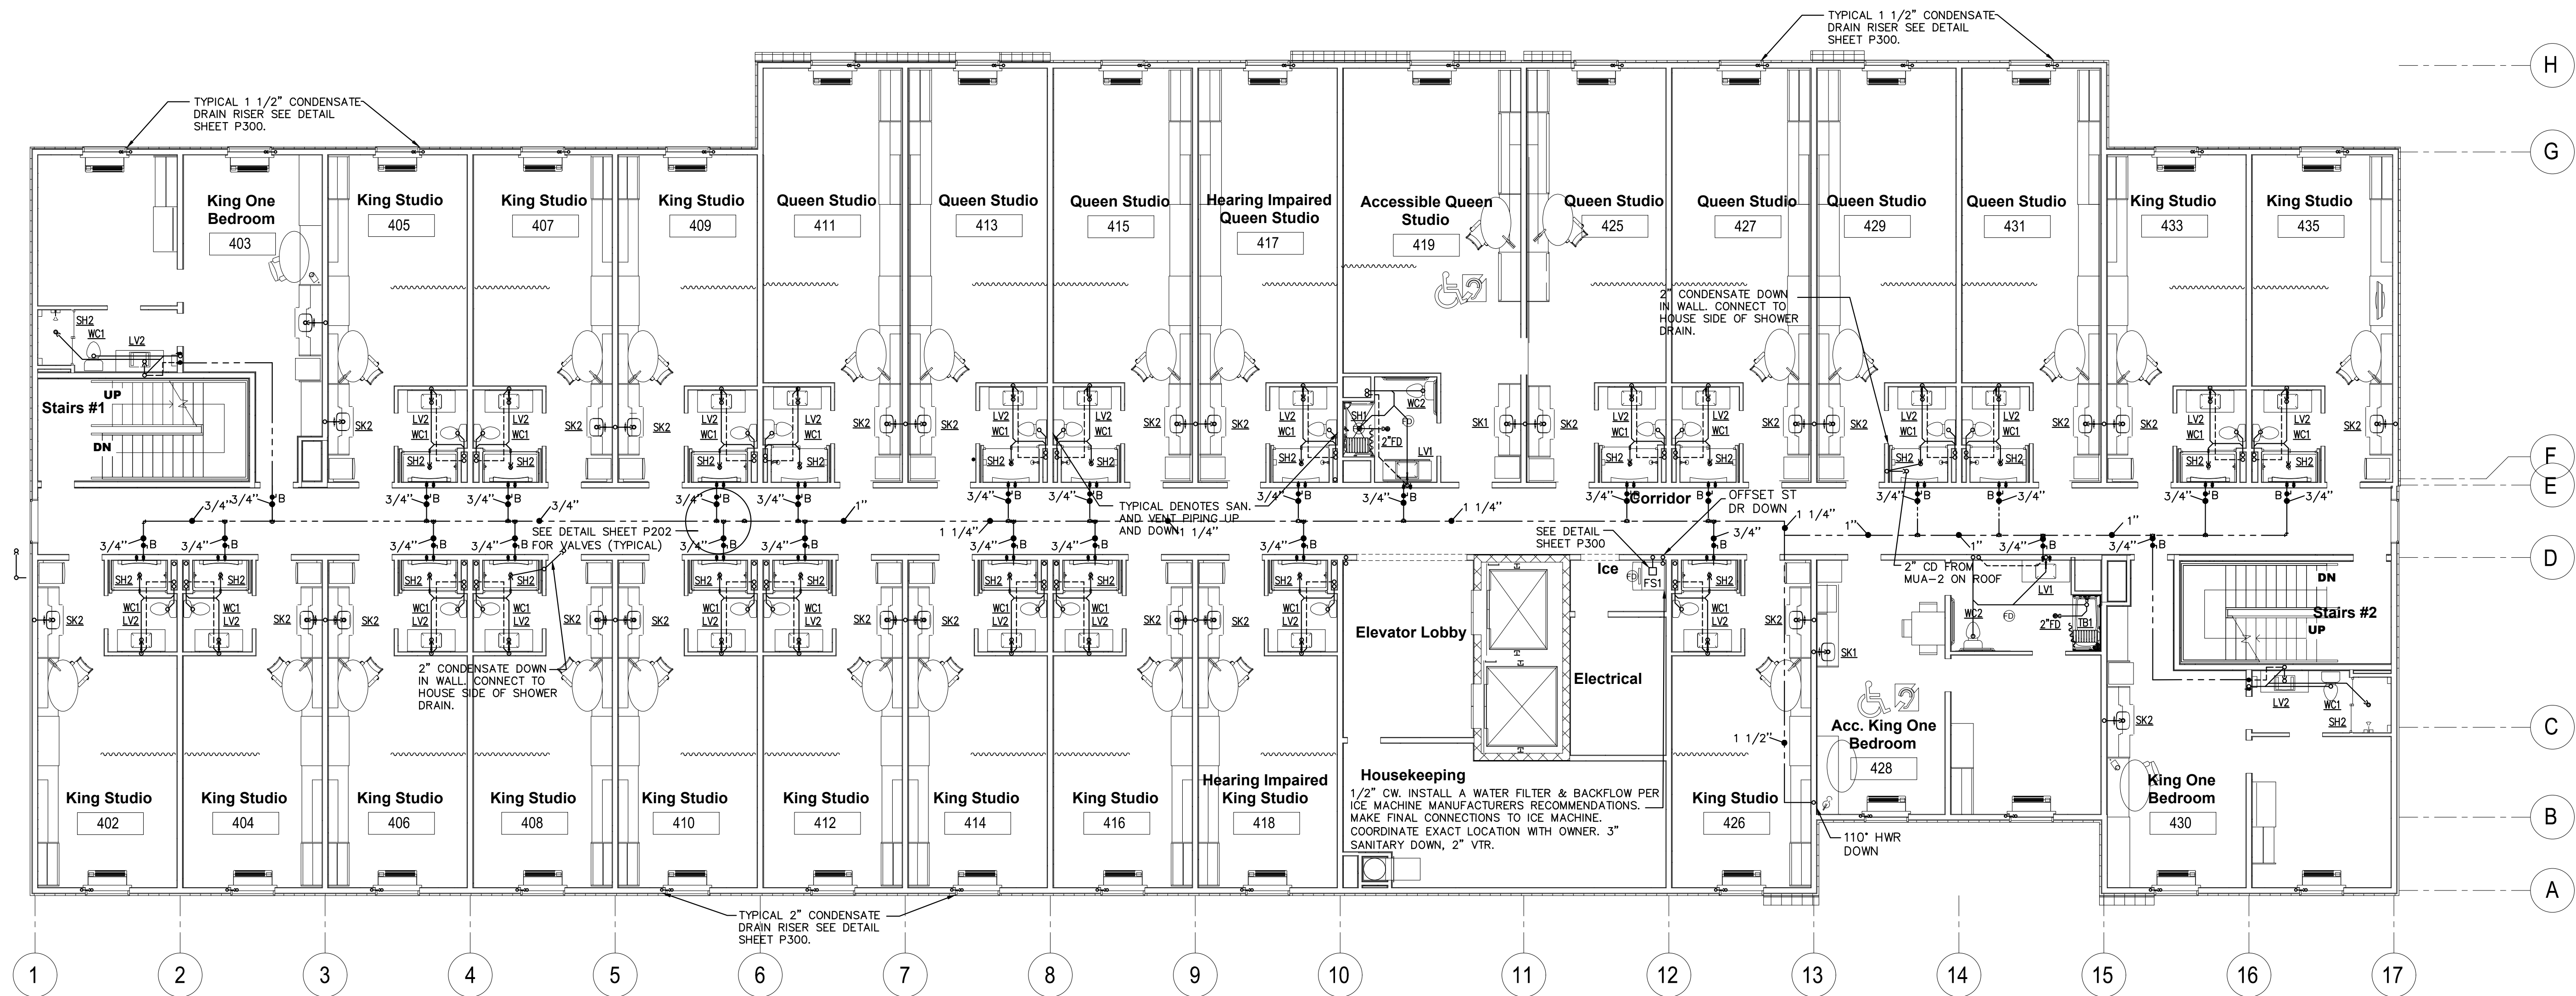




CIVIL:
Benchmark Engineering and Surveying
101 Highpointe Court, Suite B
Brandon, MS 39042
Phone: (601) 591-1077
Fax: (601) 591-0177
Email: mikebes@bellsouth.net

STRUCTURAL:
Whisonant Engineering Services, LLC
122 Nut Tree Court
Lexington, SC 29074
Phone: (803) 957-4008
Email: bill@weslex.com

MEP:
INNOVATIVE ENGINEERING SERVICES
2787 Stage Center Dr.
Suite 101
Bartlett, Tennessee 38134
Phone: (662) 890-4220
Email: www.innovativees-llc.com

[illegible]

Information contained on this drawing and in all digital files associated is authorized for use on the project named herein only and is the property of MISHRA ARCHITECTURE PLLC and may not be reproduced in any manner without express written or verbal permission from authorized individuals. Original drawing is 24"x36" and scales are as indicated.^o
2011 MISHRA ARCHITECTURE PLLC

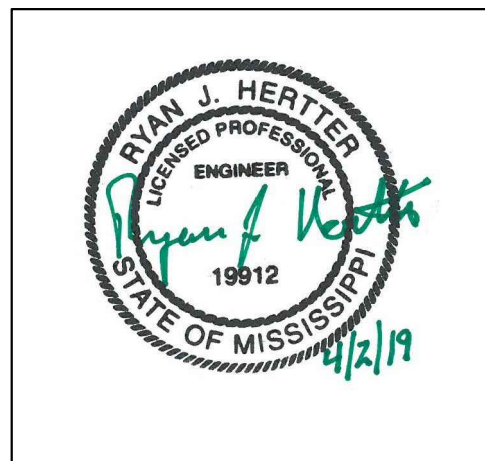

KEY PLAN

Pramukh Vicksburg,
LLC

Home2Suites
Vicksburg

Berryman Road
Vicksburg, MS 39180


Drawing Title





Roof Plan

Phase
Construction Documentss

Project No.	17-051	Sheet No. P105
Prepared by	RHP	
Checked by	RJH	
Date	MAR. 28, 2019	

Released in

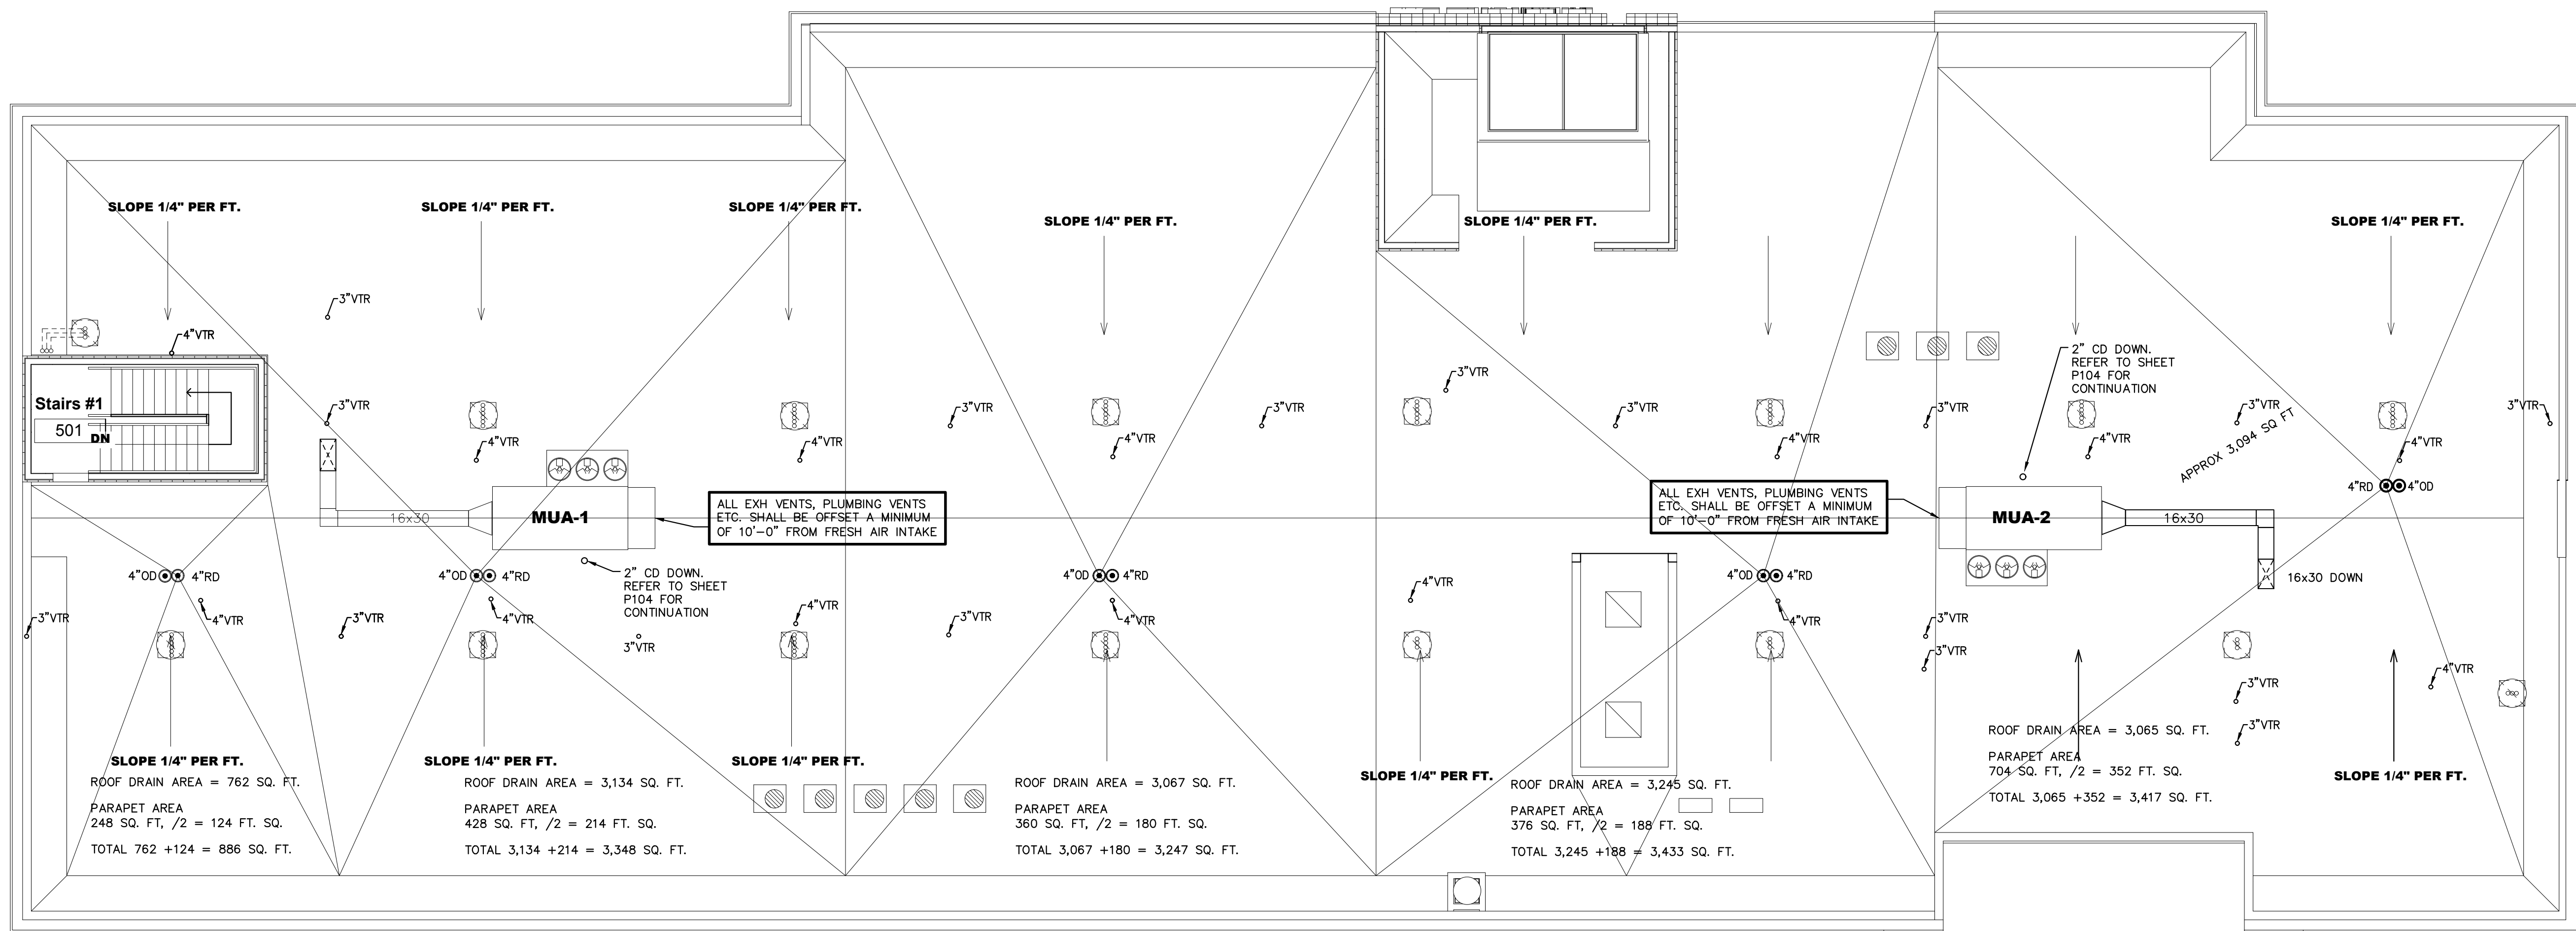

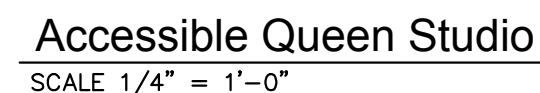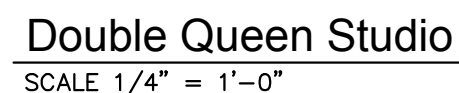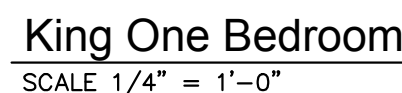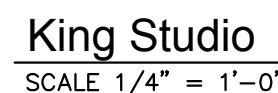




STRUCTURAL:
Whisonant Engineering Services, LLC
122 Nut Tree Court
Lexington, SC 29074
Phone: (803) 957-4008
Email: bill@weslex.com


[illegible]

RYAN J. HERTTER
LICENSED PROFESSIONAL
ENGINEER
19012
STATE OF MISSISSIPPI
4/2/19


Drawing Title
Sanitary Risers
Phase
Construction Documentss

Released for

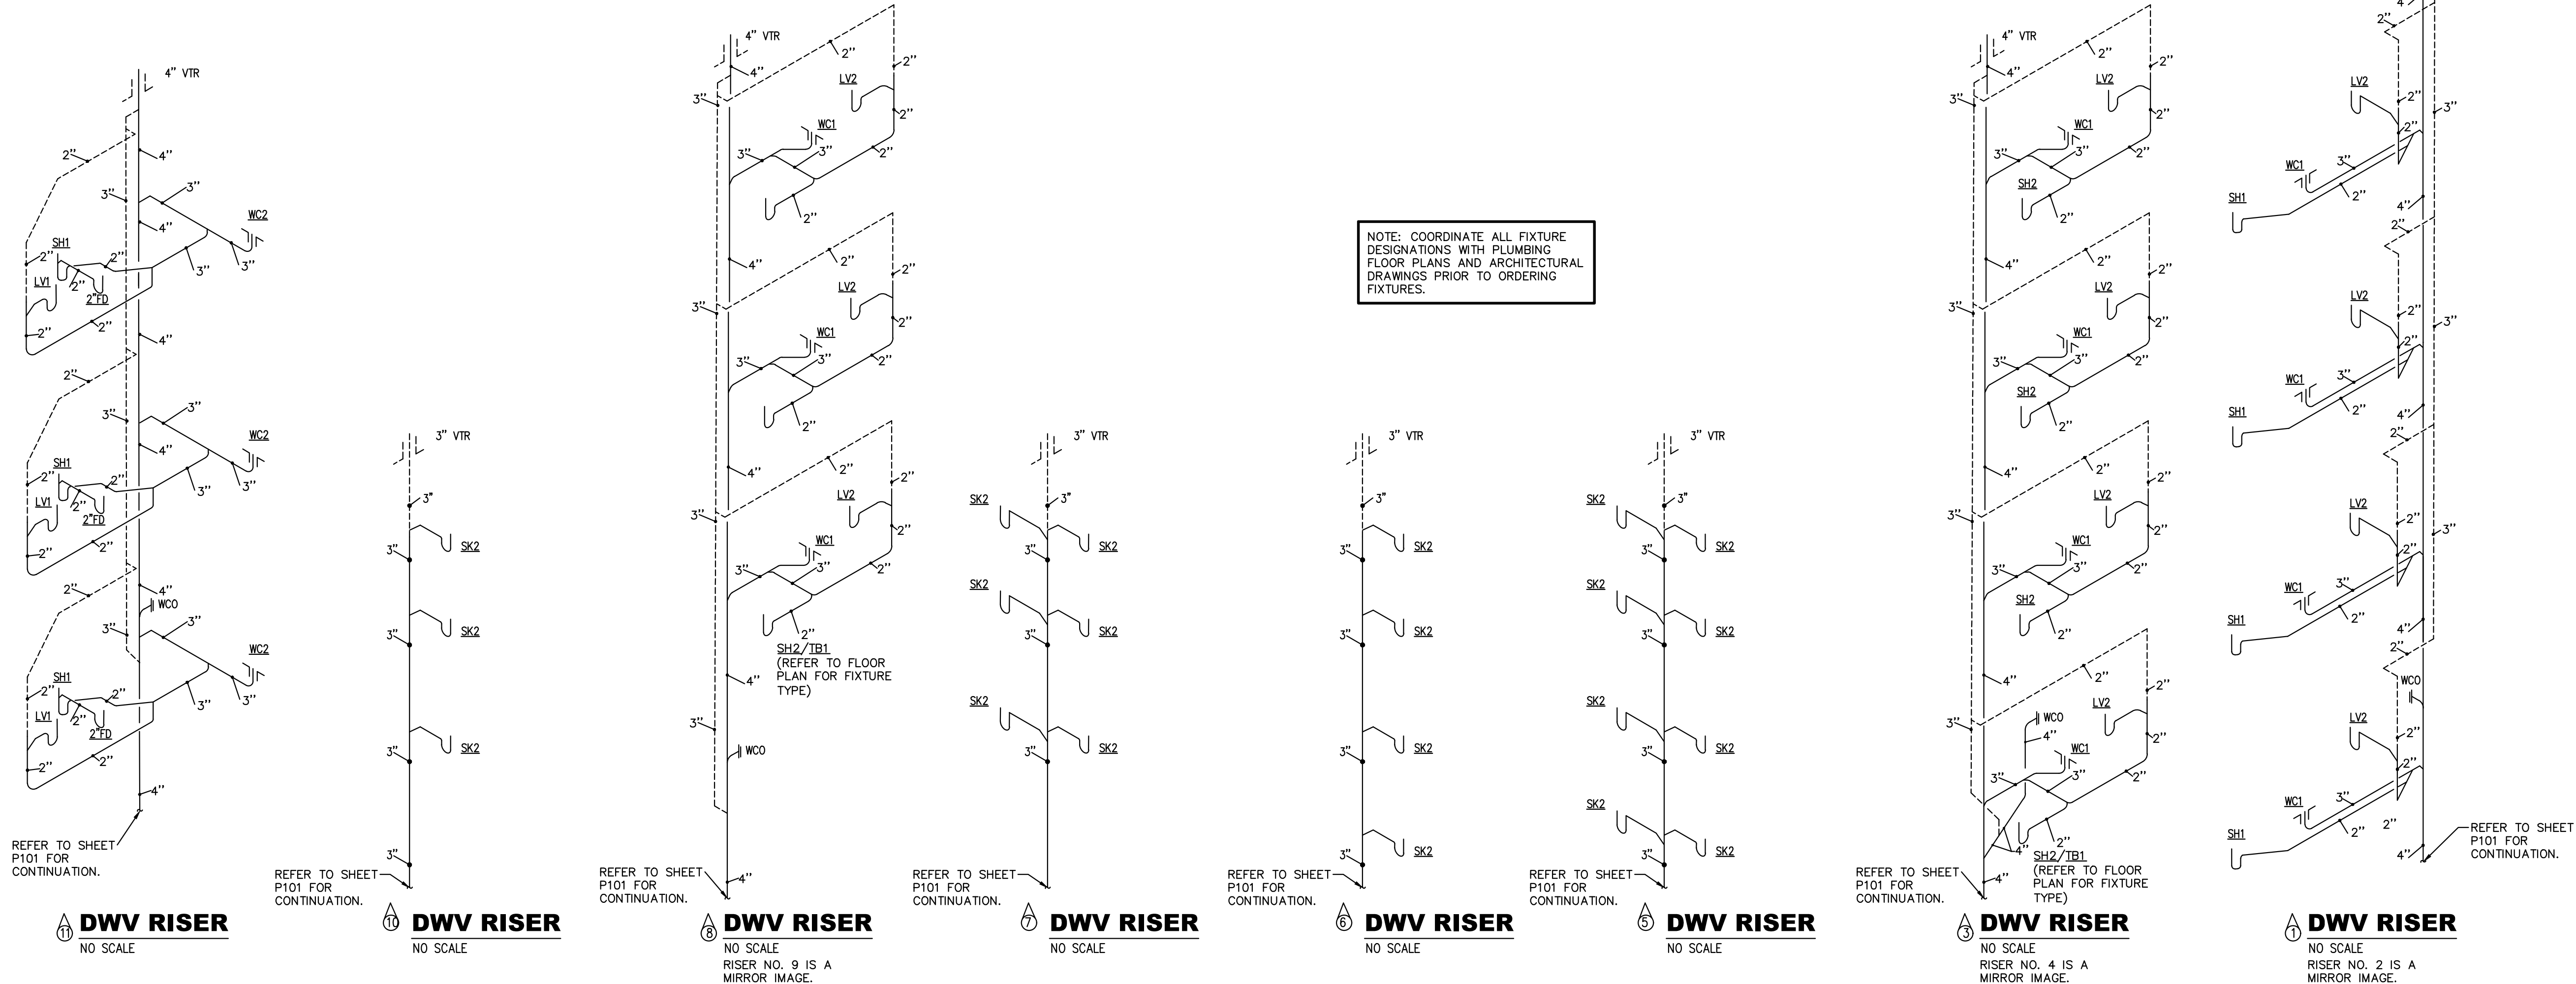


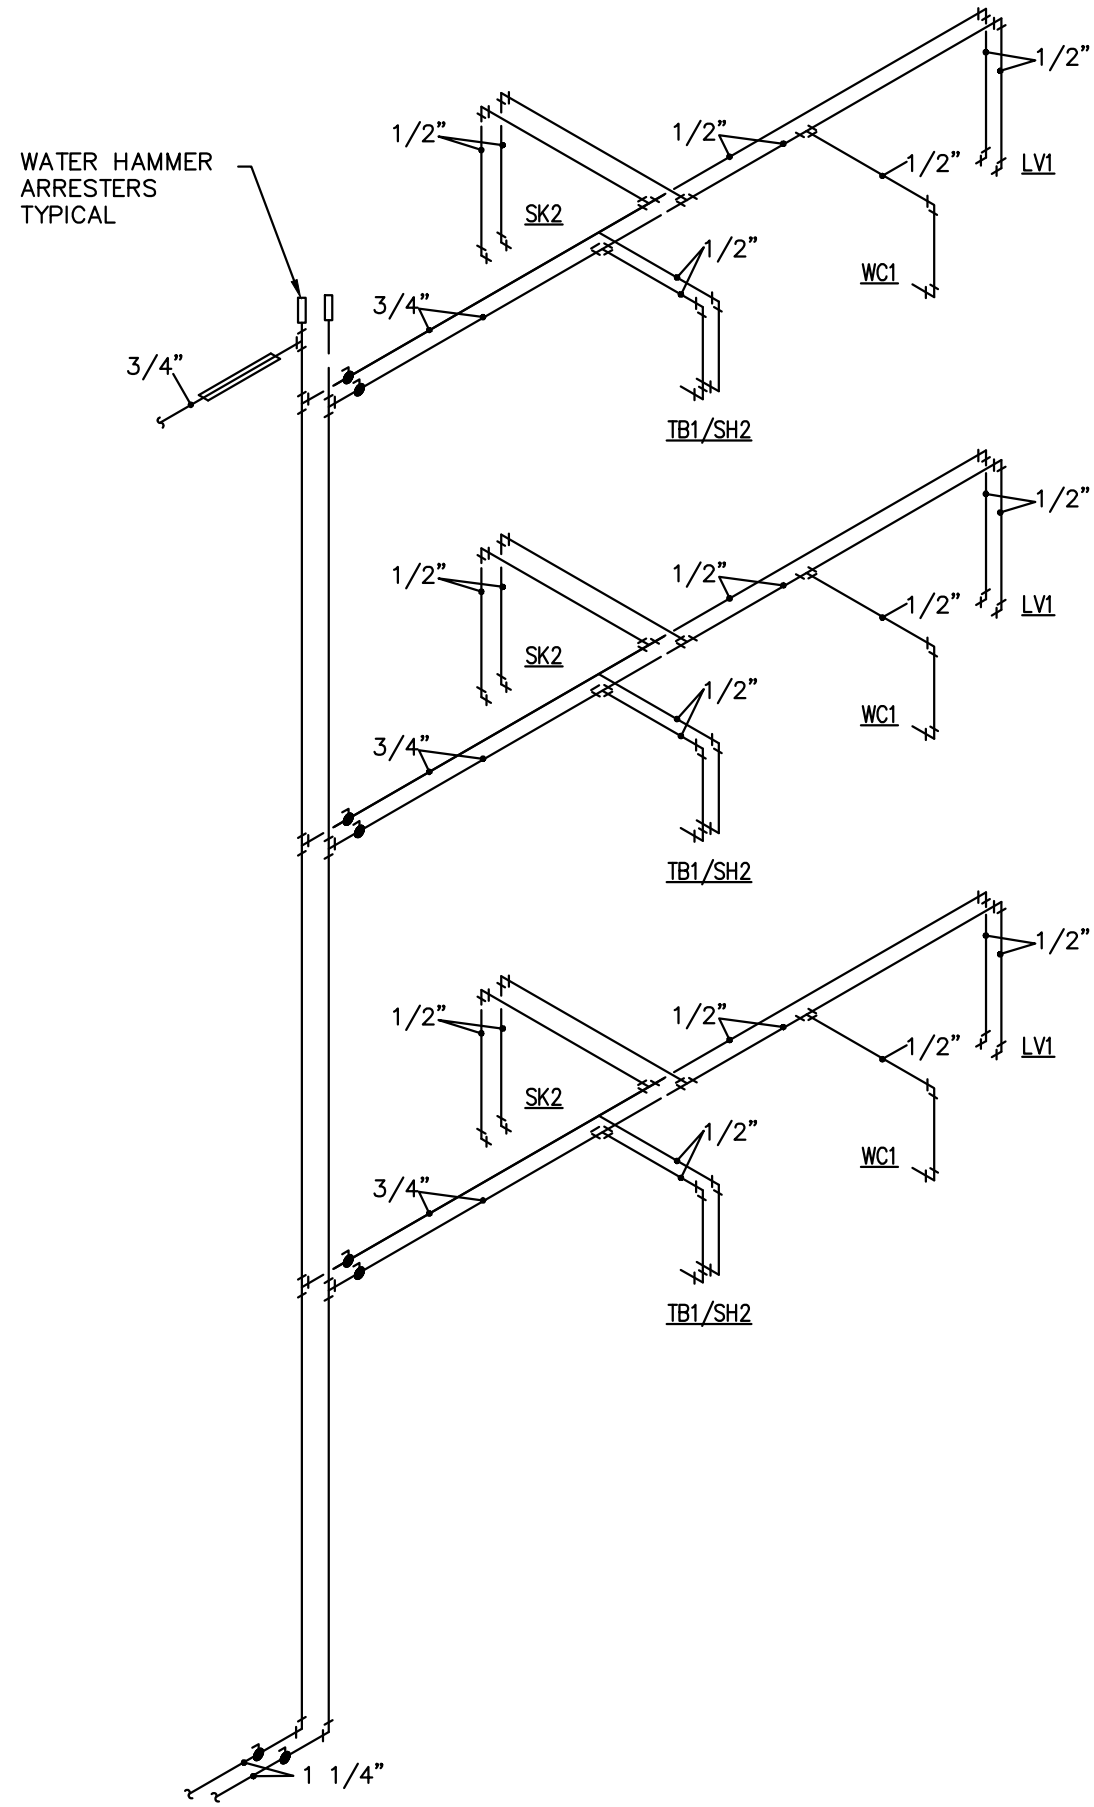


WATER RISER
NO SCALE
"A" IS A MIRROR IMAGE

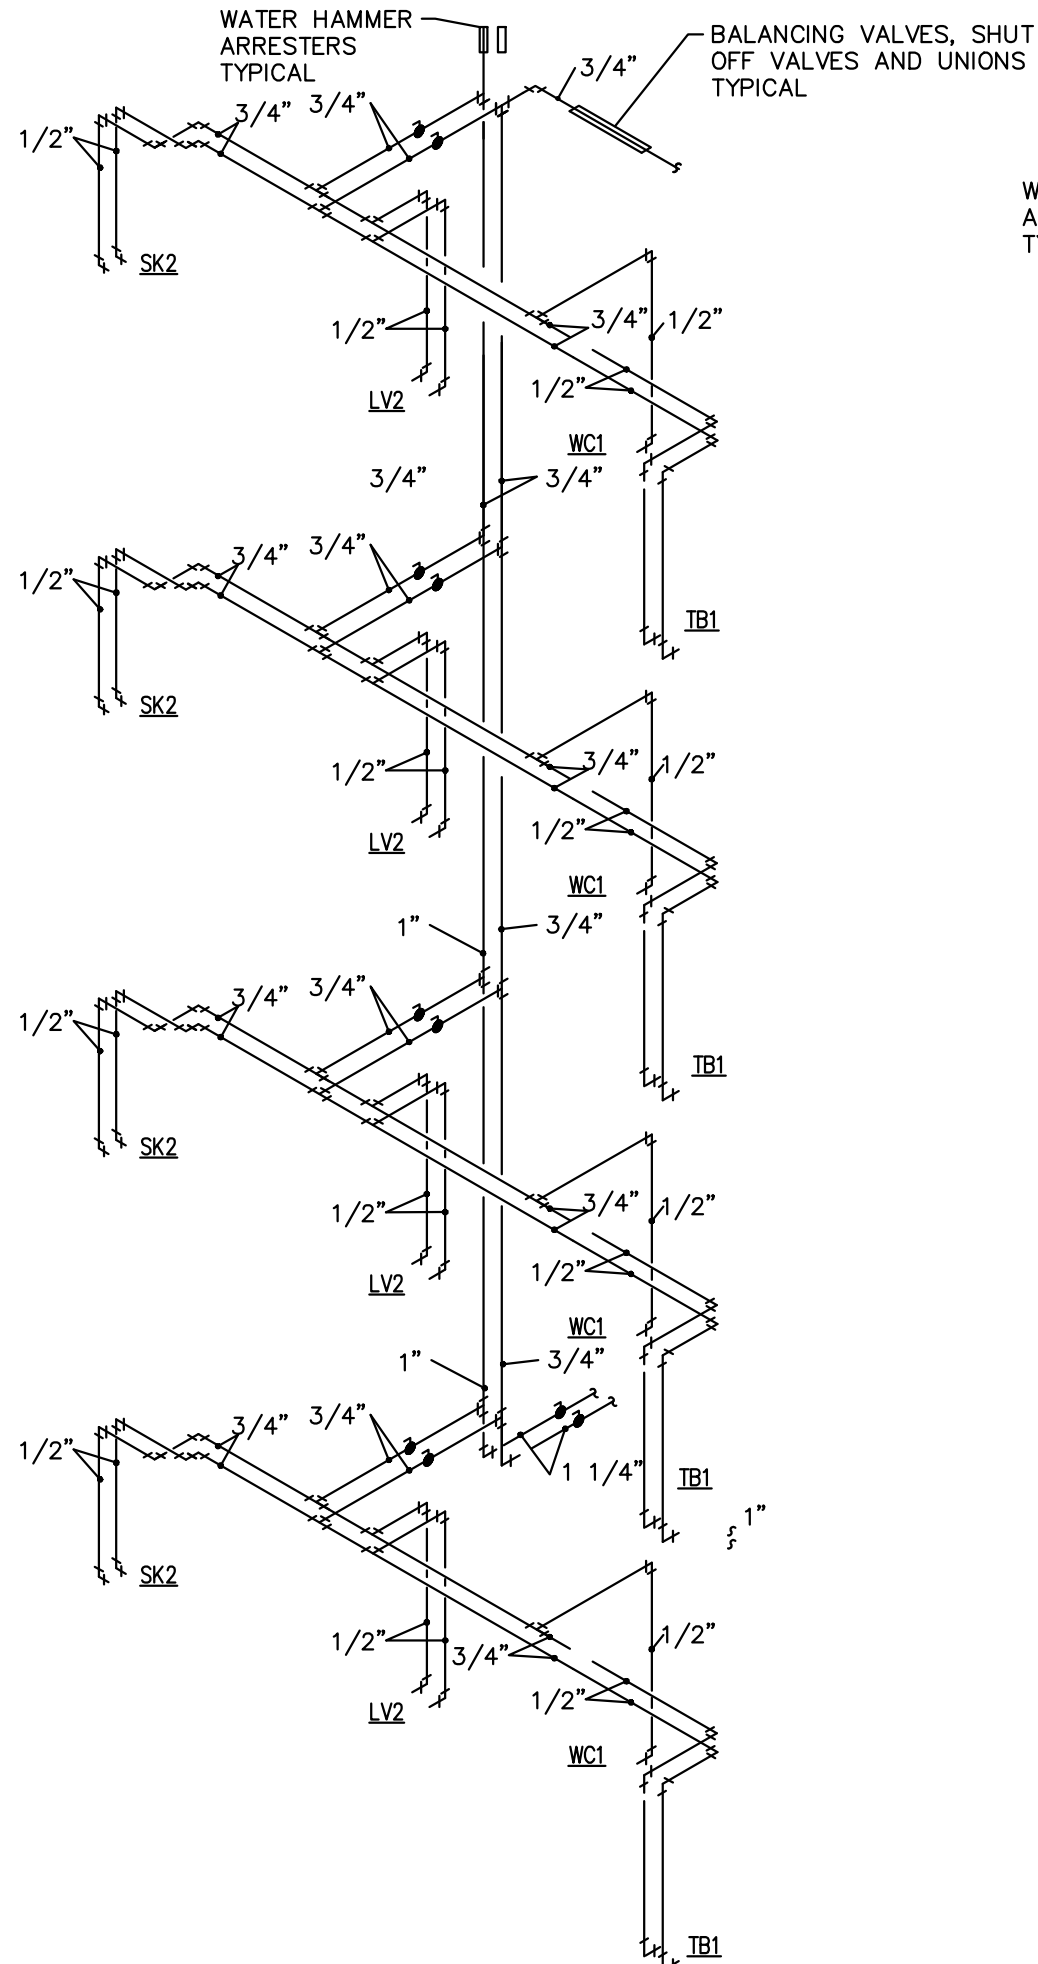


WATER RISER
NO SCALE

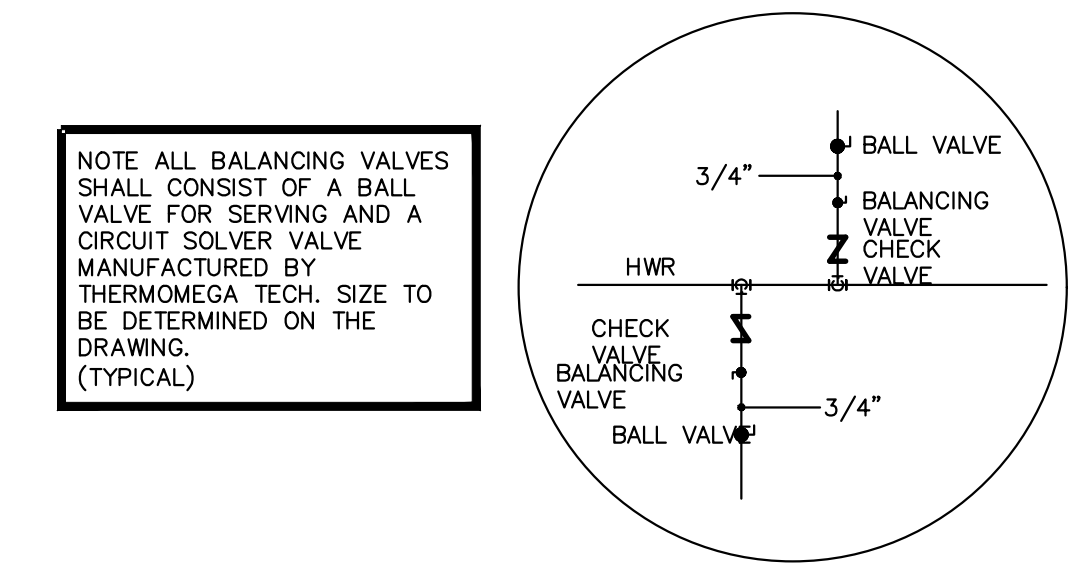


HOT WATER RETURN PIPNG DETAIL
NO SCALE

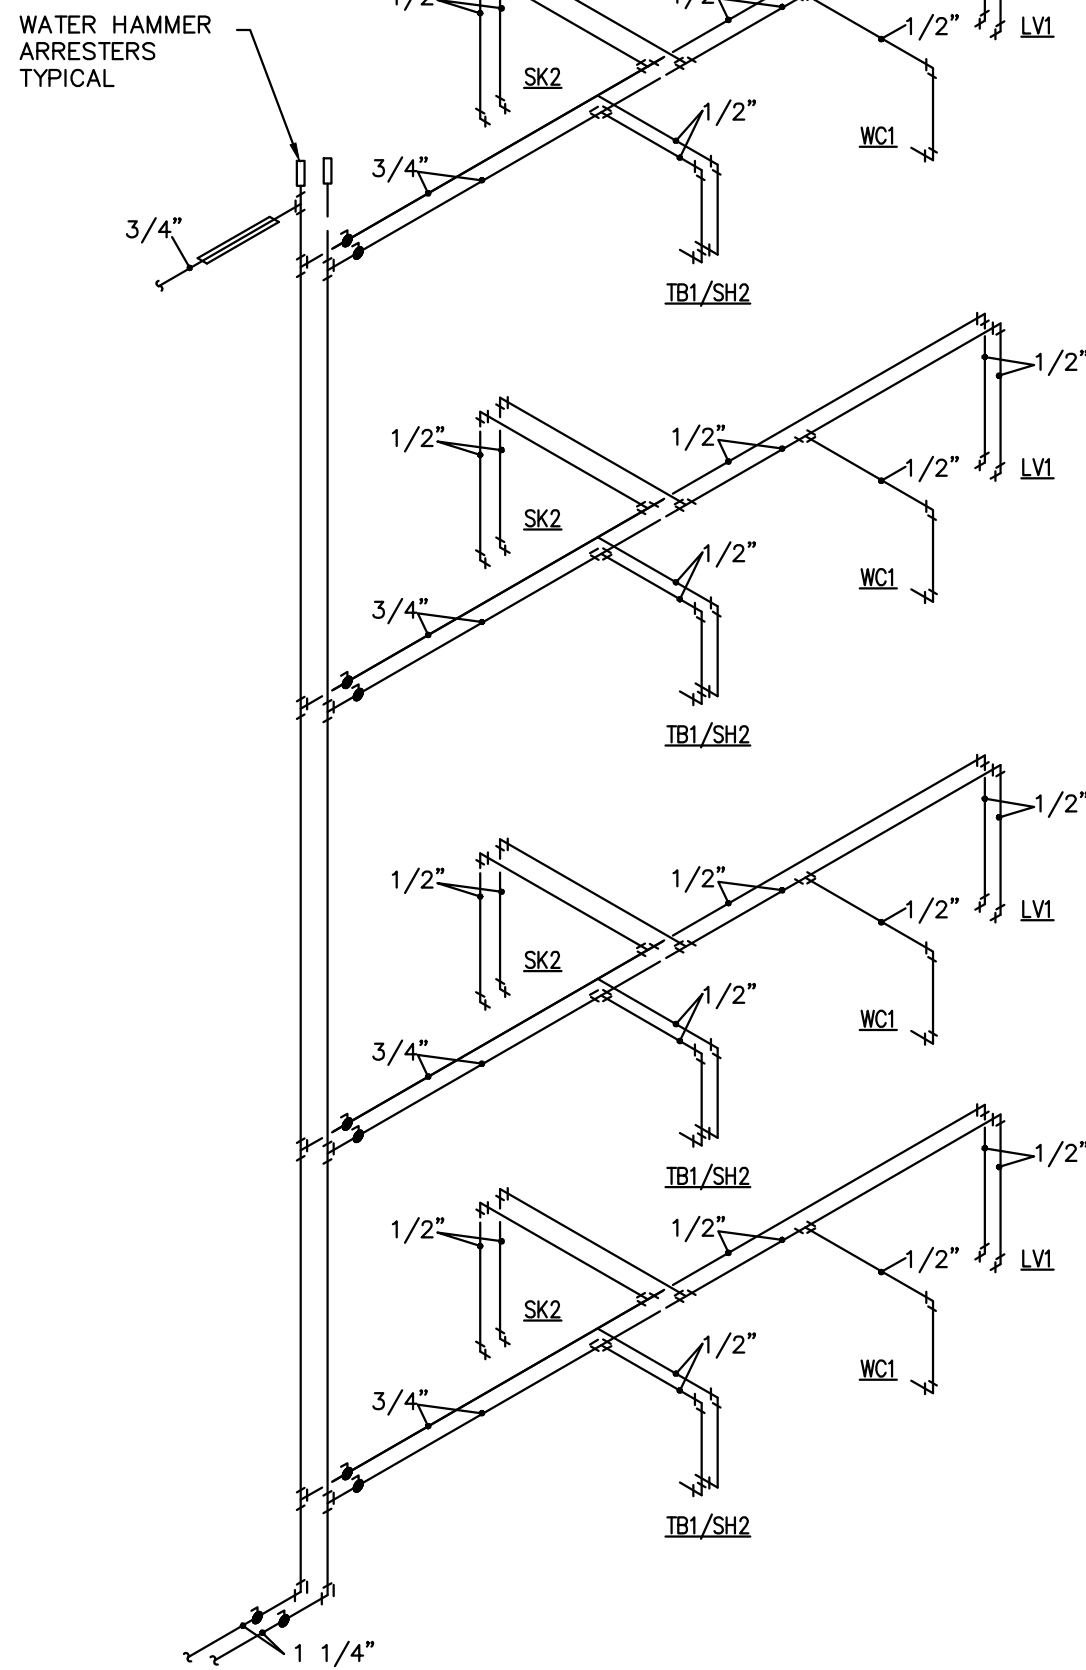


WATER RISER
NO SCALE

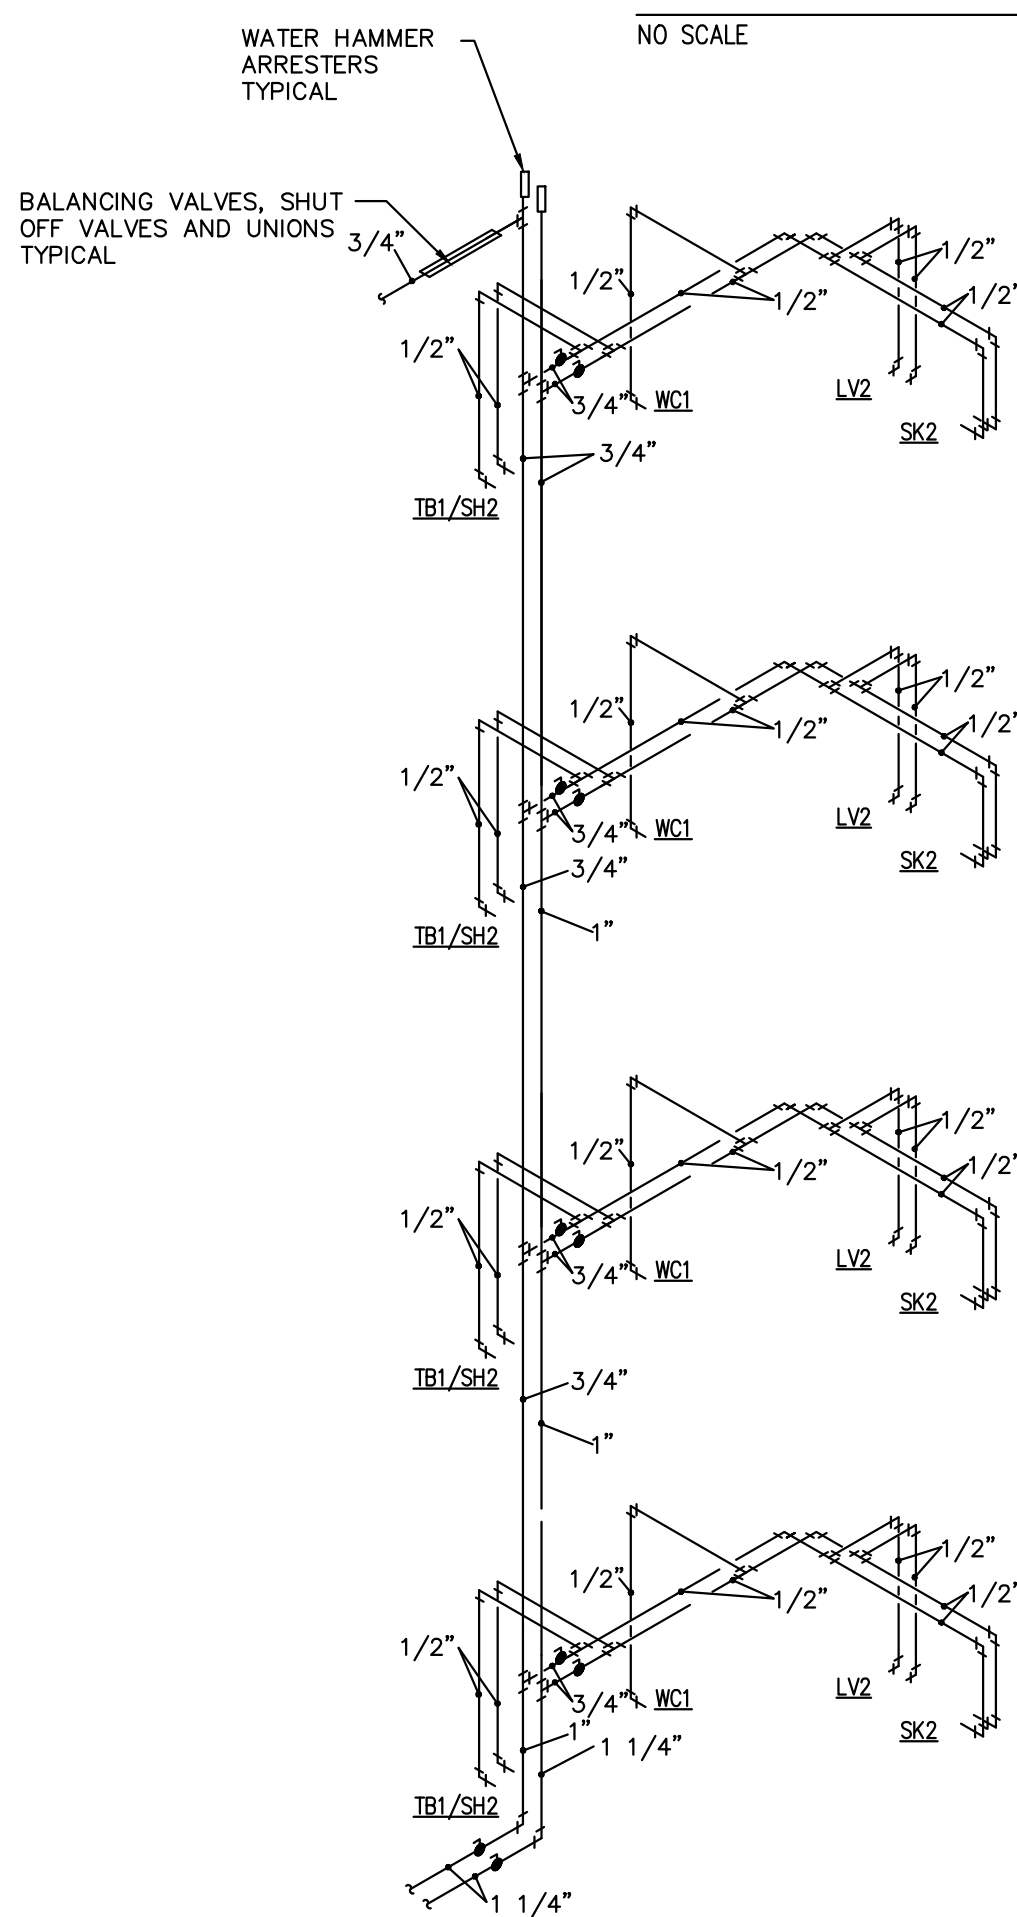


WATER RISER
NO SCALE

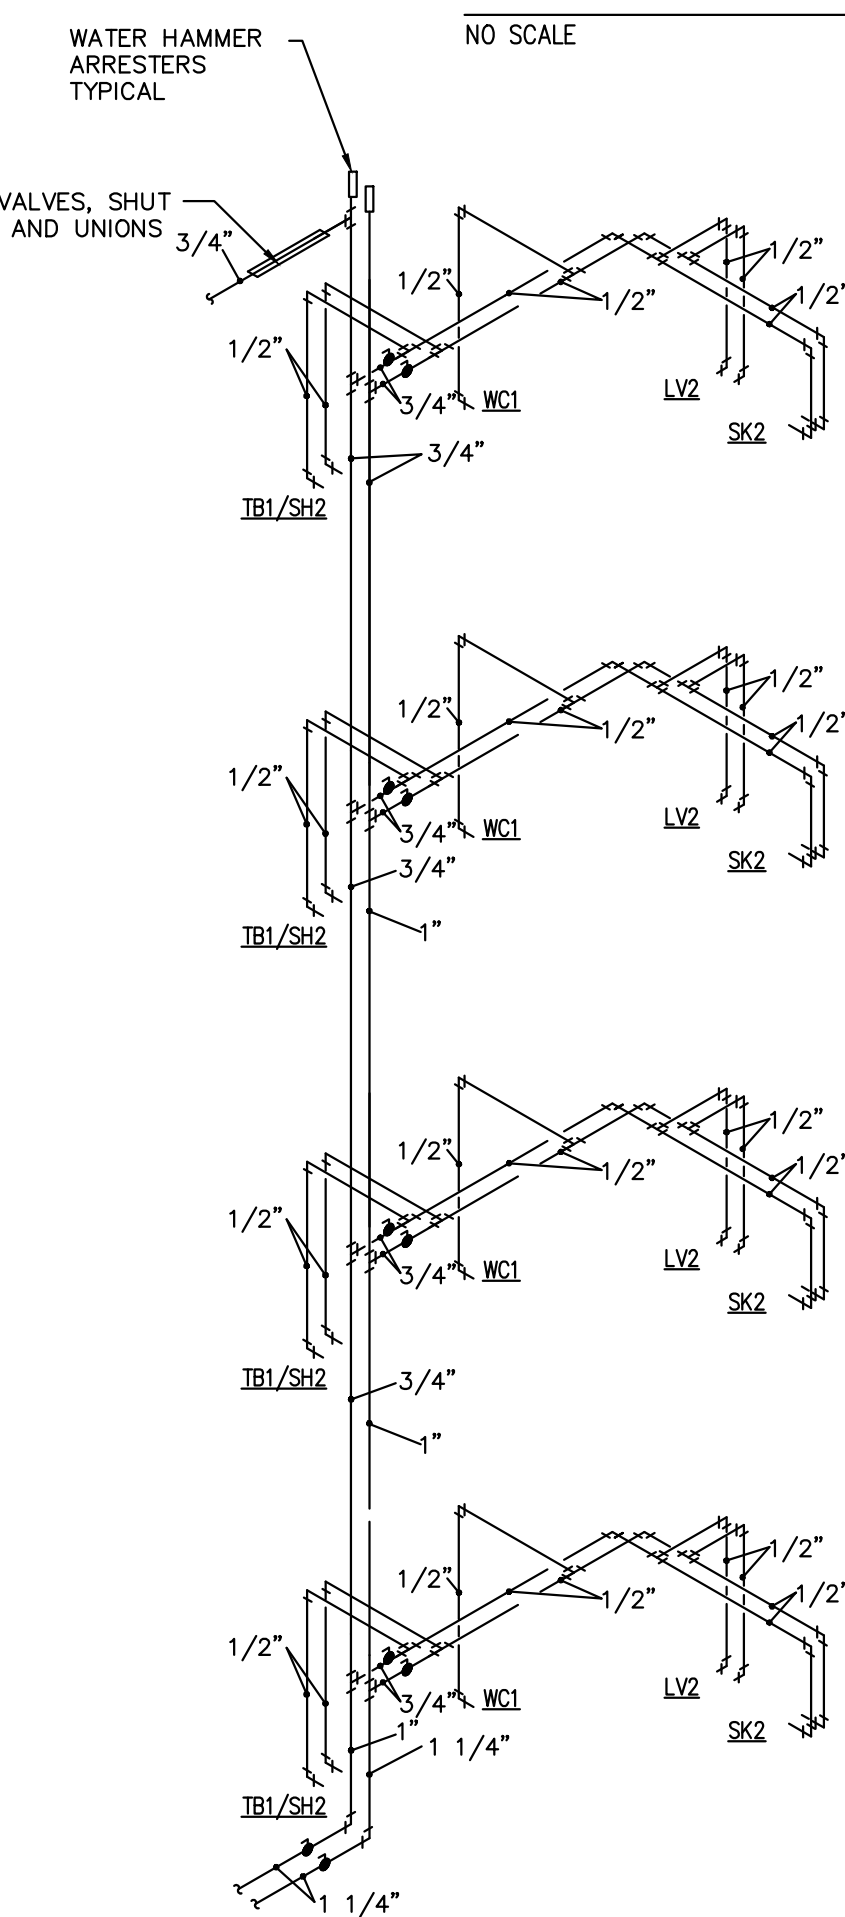


WATER RISER
NO SCALE

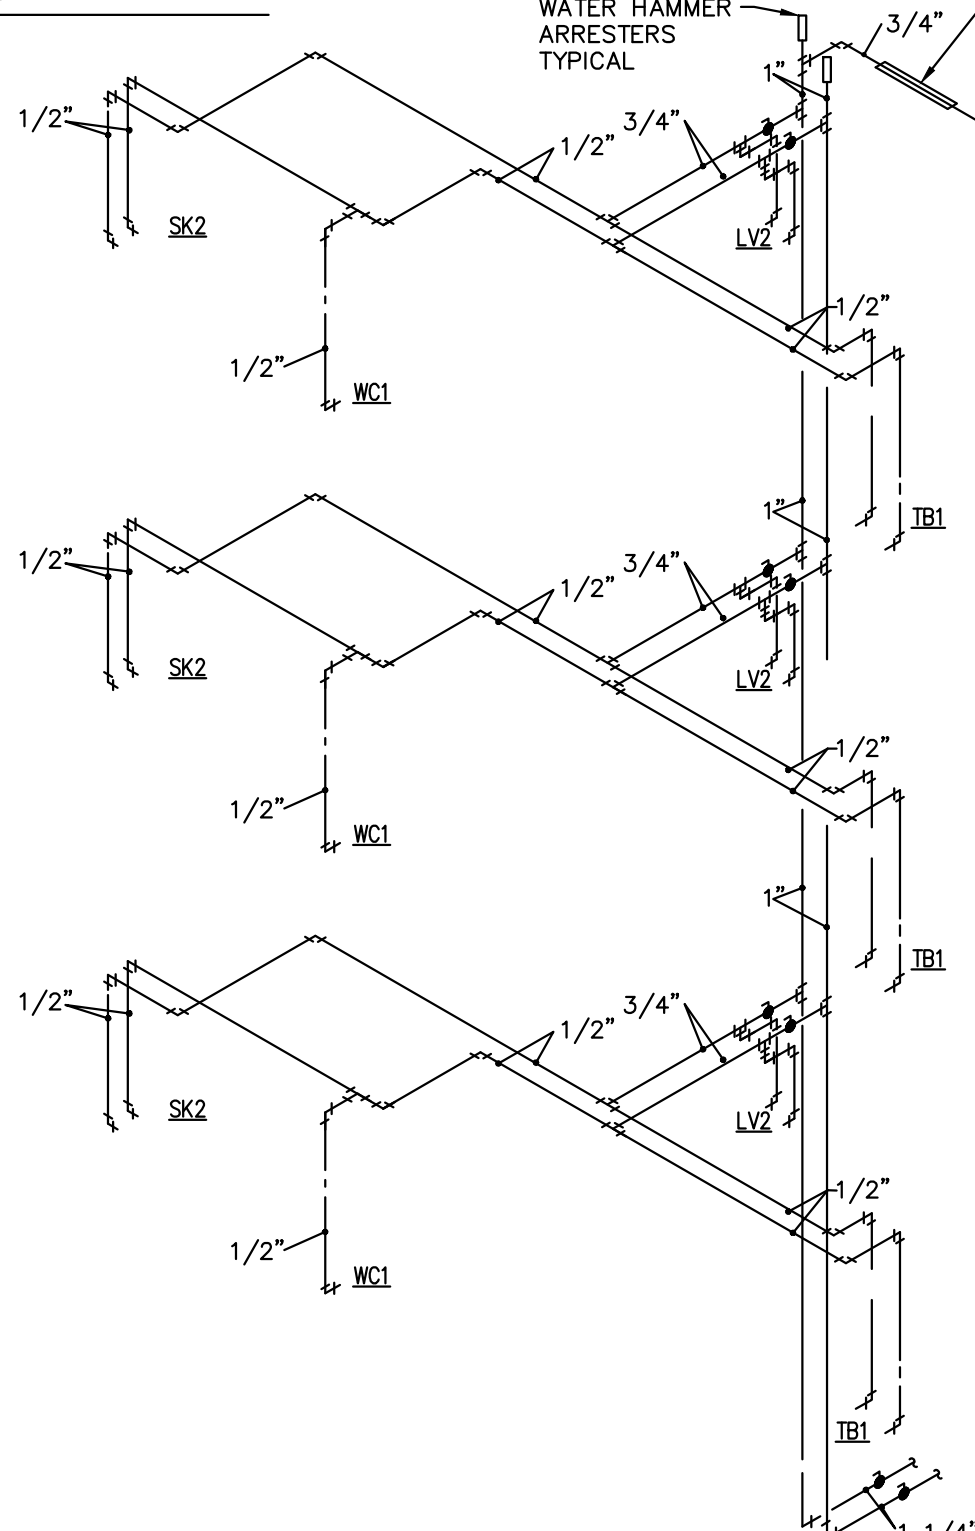



WATER RISER
NO SCALE

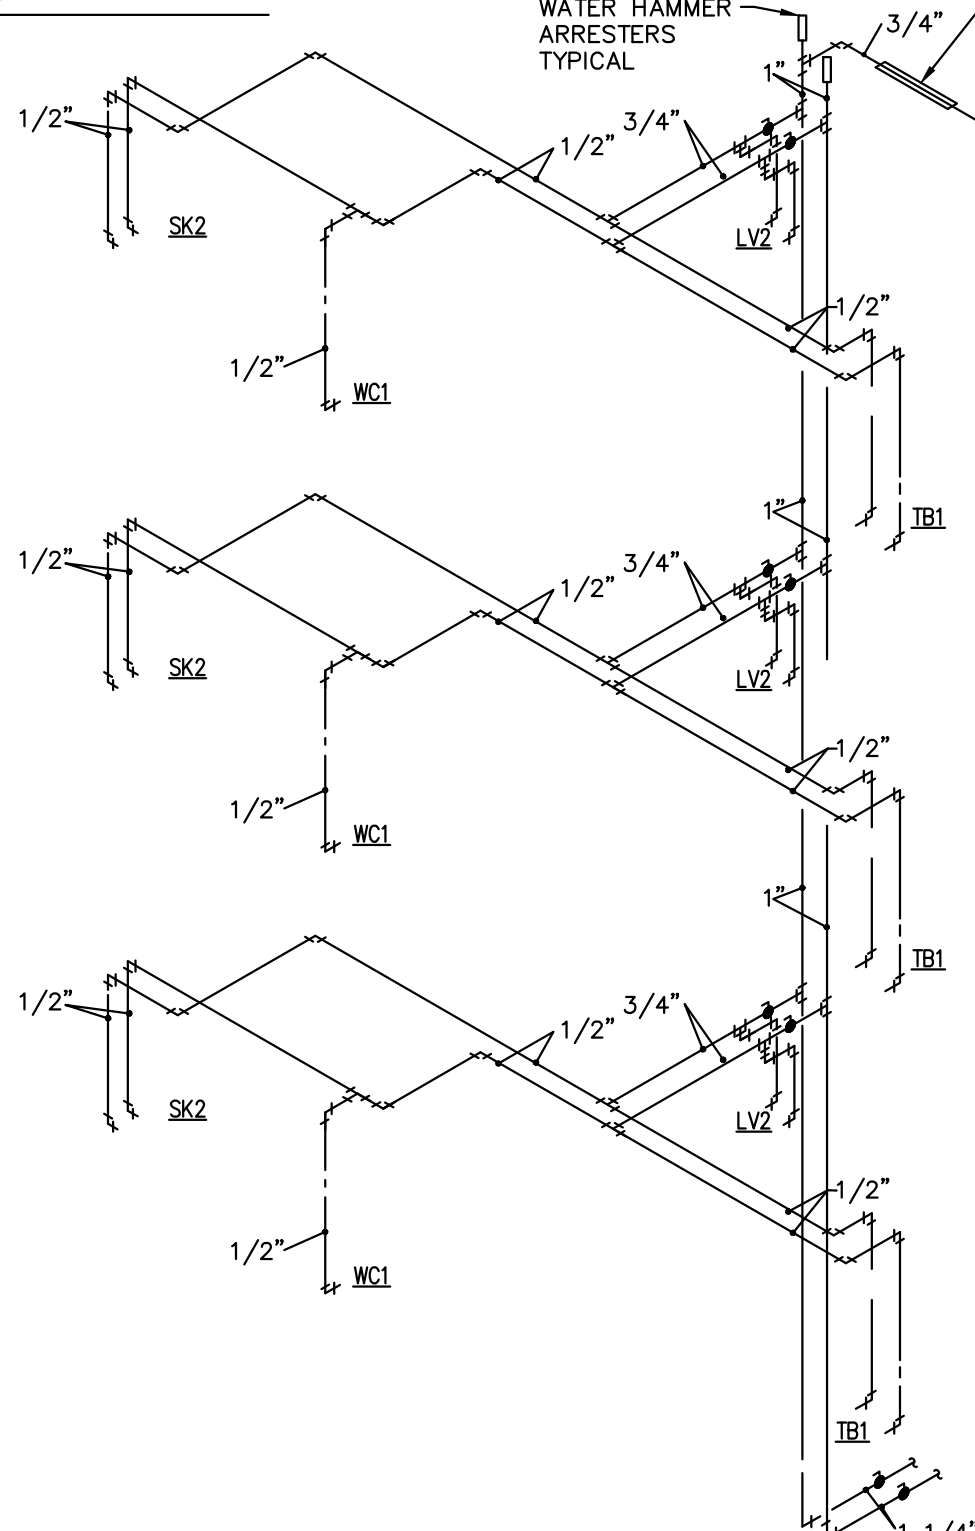

WATER RISER
NO SCALE

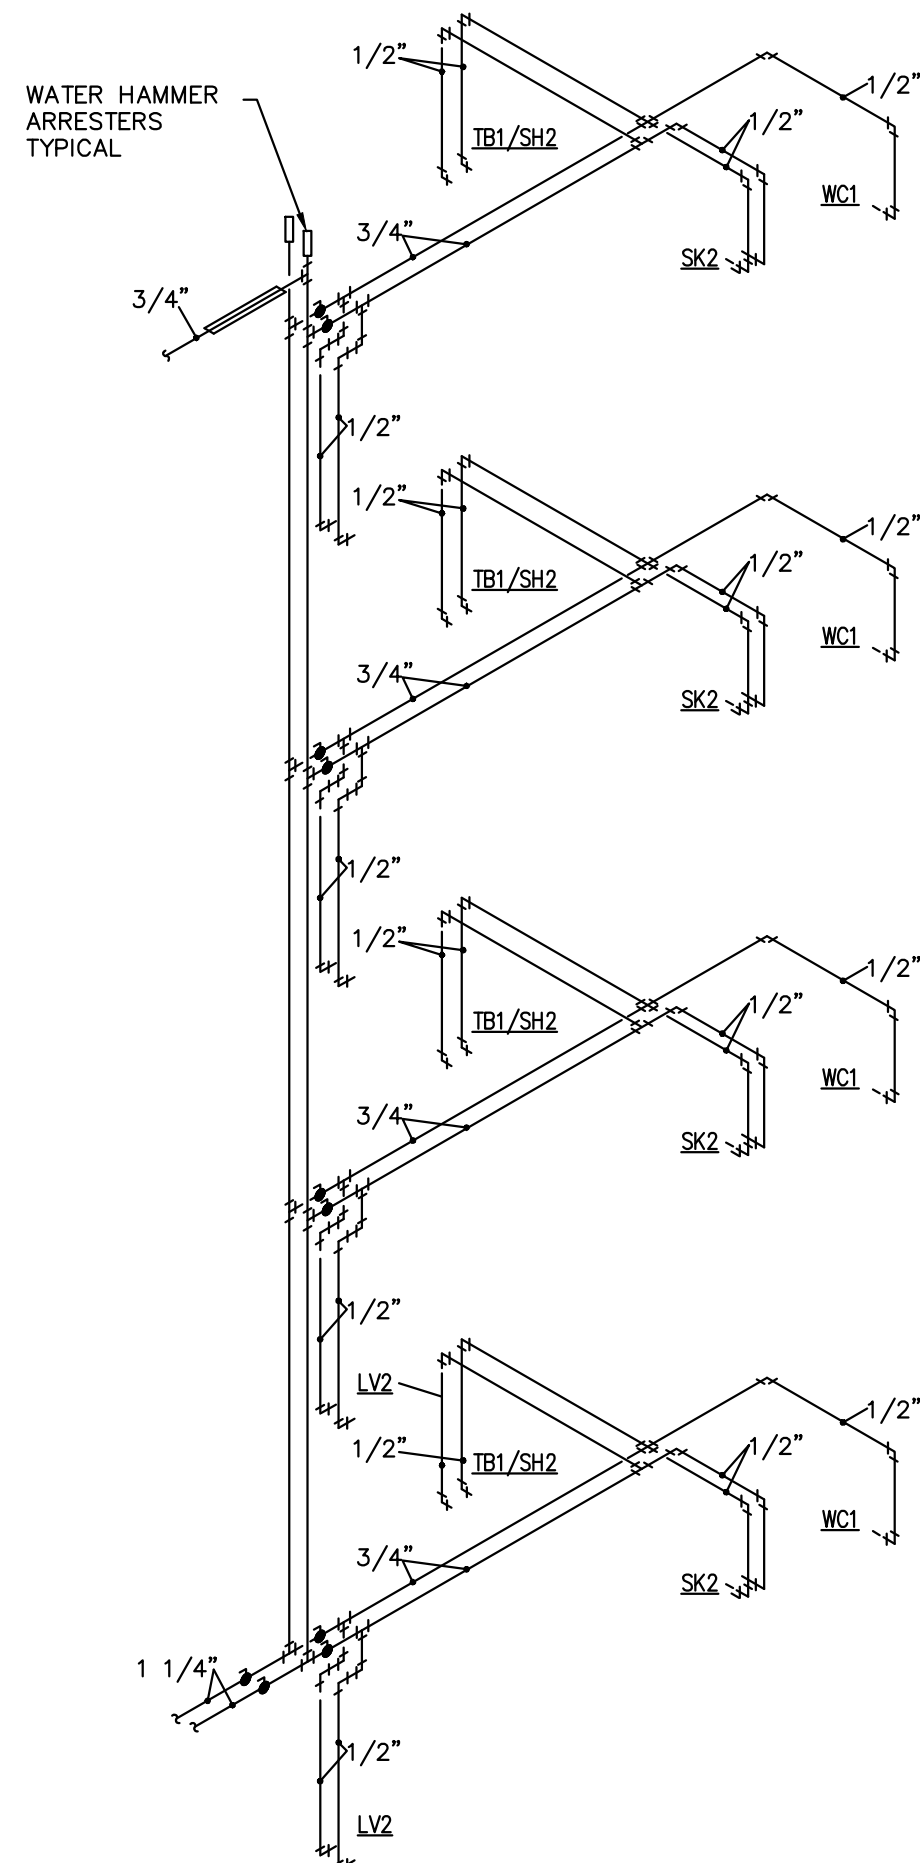

WATER RISER
NO SCALE
"B" IS A MIRROR IMAGE

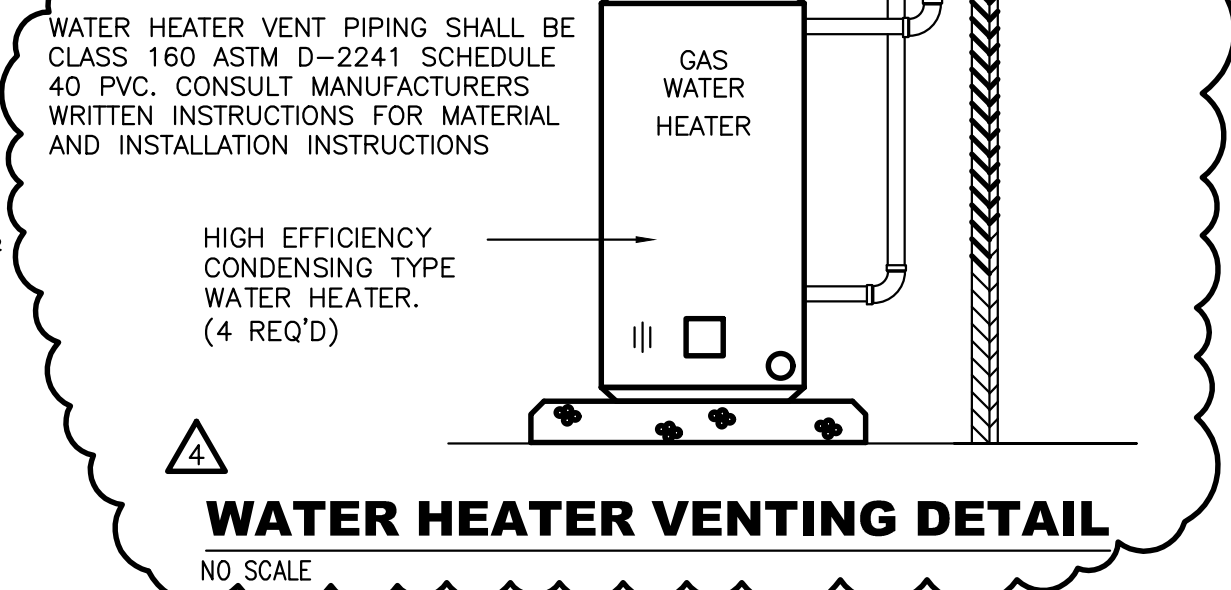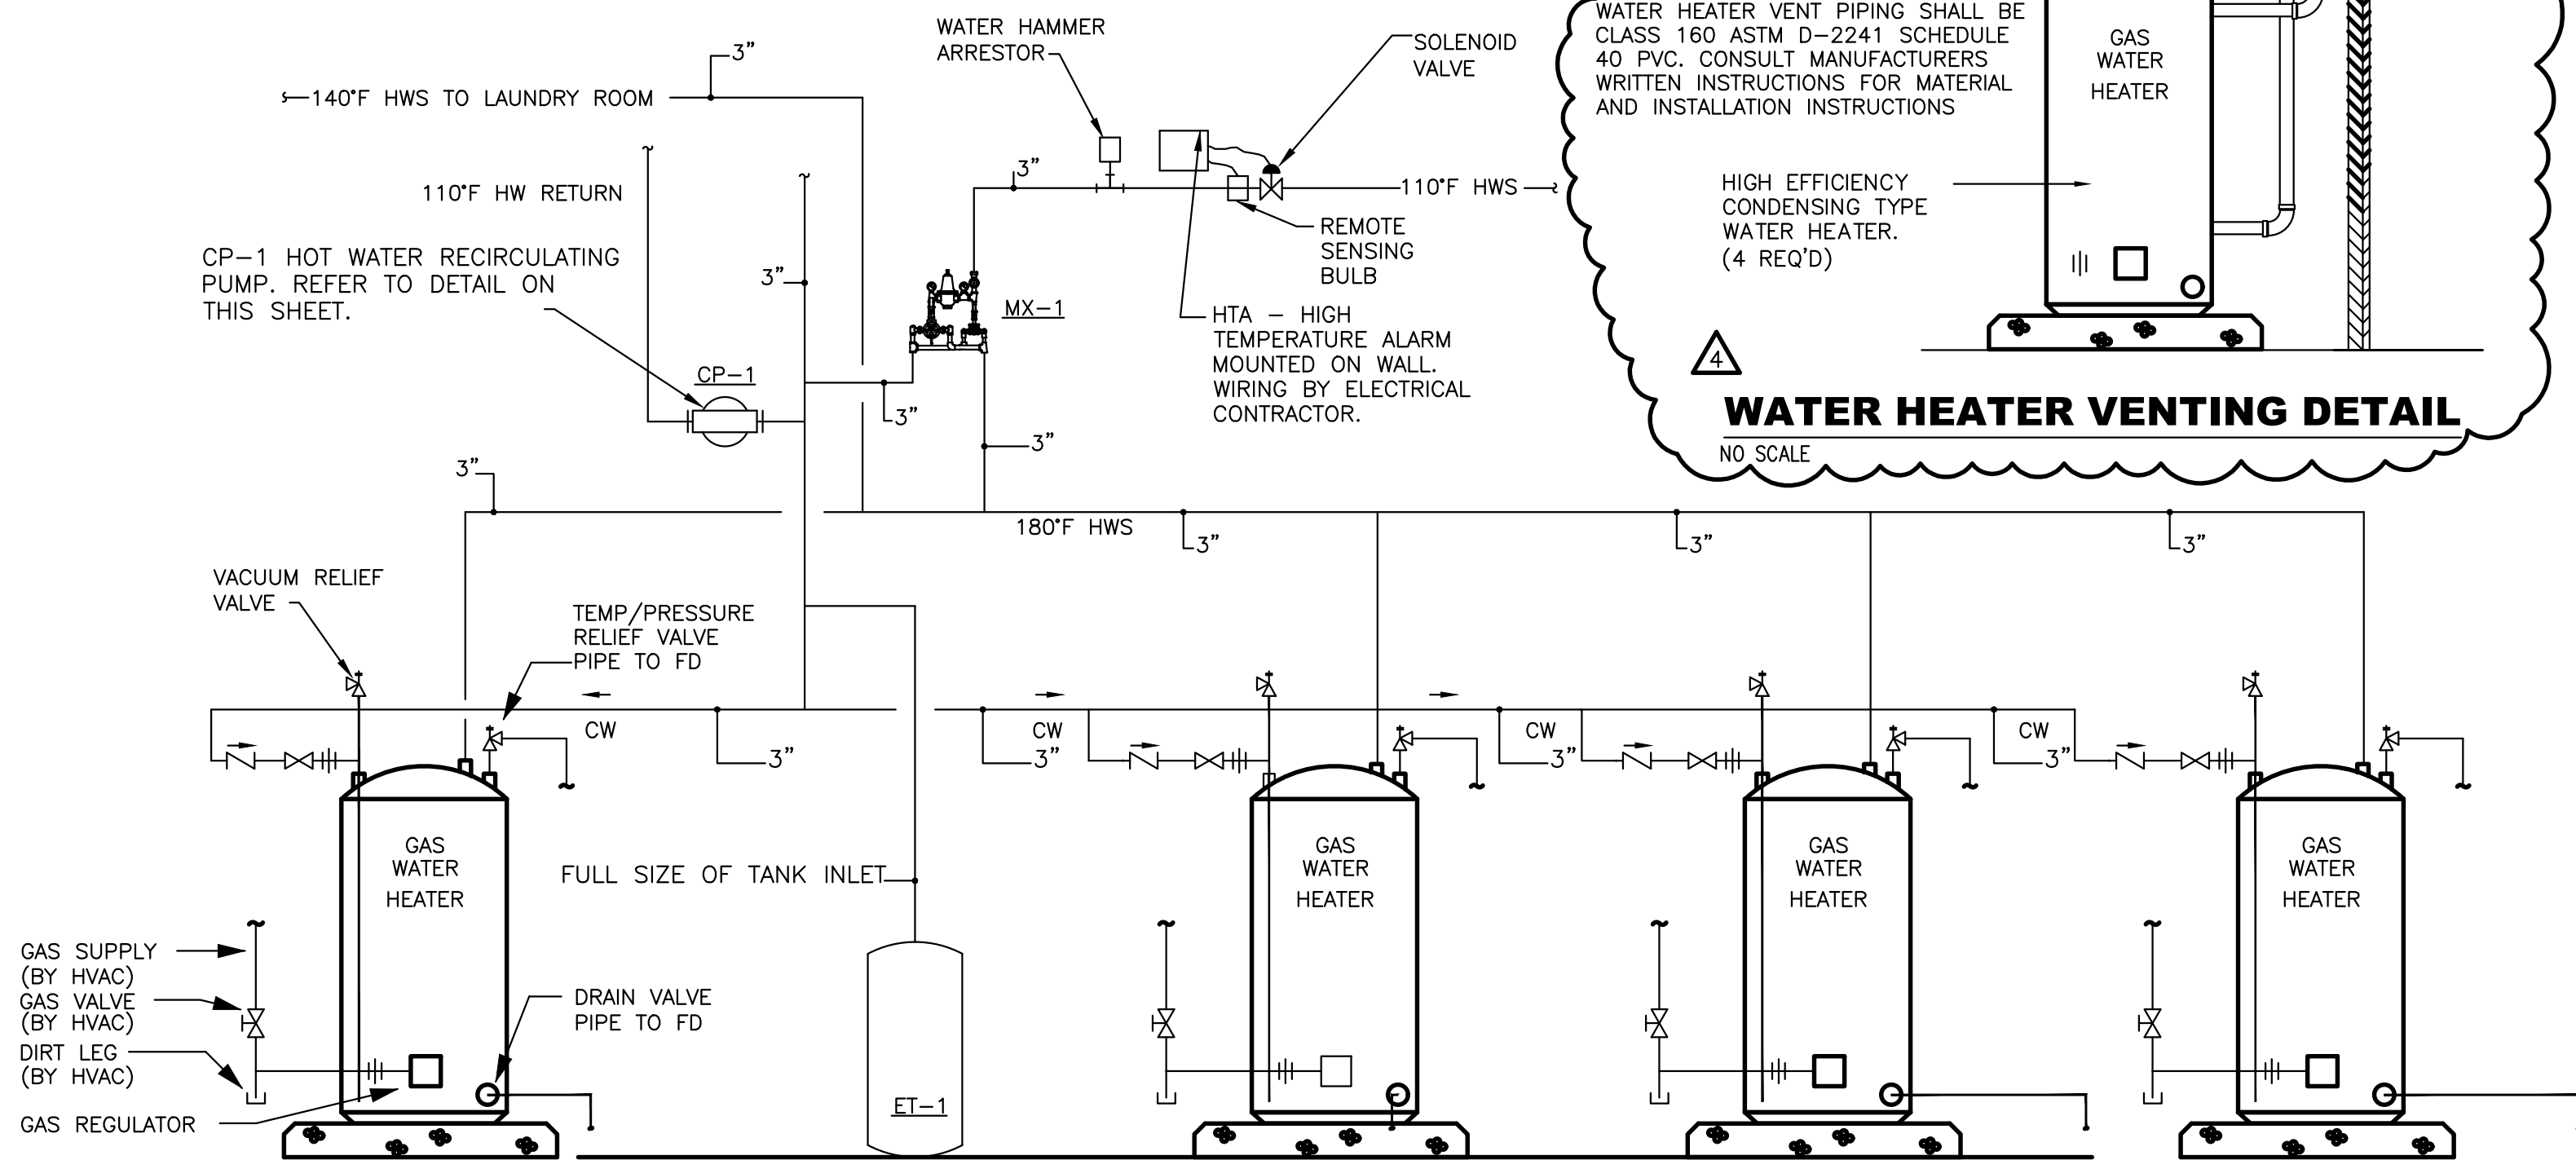

WATER HEATER VENTING DETAIL
NO SCALE

STATE SUF100-199NE(A) GAS FIRED HEATER WITH 100 GALLON STORAGE, 199,000 BTU INPUT, 3" PVC AIR INTAKE, 3" EXHAUST THROUGH EXTERIOR WALL. THIS PIPING DIAGRAM IS A SCHEMATIC ONLY. INSTALL A TRU-FLO MANIFOLD KIT PER MANUFACTURERS WRITTEN INSTRUCTIONS. (GAS PIPING BY HVAC AND ELECTRICAL CONNECTIONS BY ELECTRICAL).
ET-1 EQUAL TO WATTS ET-100 ASME THERMAL EXPANSION TANK.
CP-1 EQUAL TO GRUNDFOS UP 43-75 BF, 20 GPM AT 15 FT HEAD, 1/6 HP AT 120 VOLTS.
MX-1 EQUAL TO LEONARD 2" HIGH-LOW MIXING VALVE WITH A MINIMUM FLOW OF 1/2 GPM.

NOTES:

1. INSTALL A JOHNSON CONTROLS MODEL A19DAC-1 REMOTE BULB THERMOSTAT IN WATER HEATER ROOM. STRAP BULB TO HOT WATER RETURN PIPE ON INTAKE SIDE OF PUMP. SET THERMOSTAT TO TURN PUMP ON AT 105 DEGREES AND OFF AT 110 DEGREES. WIRING BY DIVISION 16 ELECTRICAL.
HTA - HIGH TEMPERATURE ALARM: POWERS MODEL# 460 COMPLETE WITH THERMOSTAT SOLENOID, 120 TO 24 VOLT TRANSFORMER, SHOCK ABSORBER AND CONTROL PANEL (WIRING BY DIVISION -16 ELECTRICAL)
2. IF ALARM PANEL CAUSES THE SOLENOID TO STOP THE FLOW OF WATER, THEN THE RECIRCULATING PUMP SHALL ALSO BE STOPPED.

WATER HEATER CONNECTION DETAIL

NO SCALE

CIVIL:
Benchmark Engineering and Surveying
101 Highpointe Court, Suite B
Brandon, MS 39042
Phone: (601) 591-1077
Fax: (601) 591-0177
Email: mikes@bellsouth.net

STRUCTURAL:
Whisonant Engineering Services, LLC
122 Nut Tree Court
Lexington, SC 29074
Phone: (803) 957-4008
Email: bill@weslex.com

MEP:
INNOVATIVE ENGINEERING SERVICES
2787 Stage Center Dr.
Suite 101
Bartlett, Tennessee 38134
Phone: (662) 890-4220
Email: www.innovatives-llc.com

REVISIONS		
No.	Date	Description
4	7/01/19	CITY PLAN REVIEW

Information contained on this drawing and in all digital files associated is authorized for use on the project named herein only and is the property of MISHRA ARCHITECTURE PLLC and may not be reproduced in any manner without express written or verbal permission from authorized individuals. Original drawing is 24"x36" and scales are as indicated. 2011 MISHRA ARCHITECTURE PLLC



KEY PLAN

Pramukh Vicksburg, LLC

Home2Suites Vicksburg

Berryman Road Vicksburg, MS 39180

Drawing Title
Water Risers

Phase
Construction Documentss

Project No.	17-051	Sheet No.	P203
Prepared by	RHP		
Checked by	RJH		
Date	MAR. 28, 2019		

Released for




STRUCTURAL:
Whisonant Engineering Services, LLC
122 Nut Tree Court
Lexington, SC 29074
Phone: (803) 957-4008
Email: bill@weslex.com

[illegible]

RYAN J. HERTZ
LICENSED PROFESSIONAL
ENGINEER
99812
STATE OF MISSISSIPPI
4/2/19

Project No.	17-051	Sheet No. P301
Prepared by	RHP	
Checked by	RJH	
Date	MAR. 28, 2019	

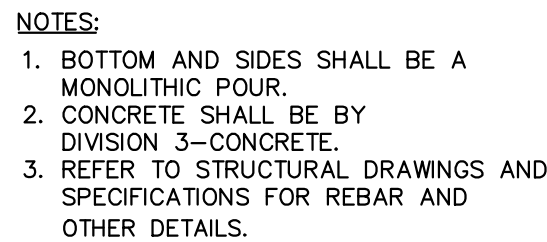

TELEPHONE SERVICE
COORDINATE THE LOCATION OF ALL TELEPHONE SERVICE CONDUITS WITH THE
LOCAL TELEPHONE COMPANY. PROVIDE SIZE AND QUANTITIES OF CONDUITS
AS REQUIRED. PROVIDE CONDUITS FROM THE PBX ROOM TO A POINT AT THE
PROPERTY LINE WITH CONDUITS STUBBED-UP AS DIRECTED BY THE LOCAL
TELEPHONE COMPANY.

CATV SERVICE

COORDINATE THE LOCATION OF ALL CATV SERVICE CONDUITS WITH THE LOCAL CABLE TELEVISION COMPANY. PROVIDE SIZE AND QUANTITIES OF CONDUITS AS REQUIRED. PROVIDE CONDUITS FROM THE PBX ROOM TO A POINT AT THE PROPERTY LINE WITH CONDUITS STUBBED-UP AS DIRECTED BY THE LOCAL CABLE TELEVISION COMPANY.

ELECTRICAL SERVICE

1.) SERVICE VOLTAGE TO THIS PROJECT SHALL BE 120/208V, 3-PHASE, 4-WIRE, 60 HZ.

2.) THE ROUTING OF THE UNDERGROUND ELECTRIC PRIMARY SERVICE ENTRANCE SHALL BE AS DETERMINED BY THE LOCAL POWER COMPANY. PROVIDE NECESSARY UNDERGROUND CONDUITS CONSISTING OF THE SIZE AND QUANTITIES AS REQUIRED BY THE LOCAL POWER COMPANY.

3.) THE LOCATION OF THE PAD MOUNTED TRANSFORMER IS SHOWN ON THE ELECTRICAL SITE PLAN, HOWEVER THE PRECISE LOCATION SHALL BE COORDINATED WITH THE LOCAL POWER COMPANY.

4.) ARRANGE WITH THE LOCAL POWER COMPANY FOR BOTH TEMPORARY AND PERMANENT POWER TO THIS PROJECT. CONSULT WITH THE LOCAL POWER COMPANY REPRESENTATIVES TO INSURE THAT ADEQUATE POWER OF THE DESIRED VOLTAGE AND PHASE CHARACTERISTICS IS AVAILABLE. ASSIST THE OWNER IN OBTAINING THE NECESSARY SERVICE AGREEMENTS.

5.) ALL SERVICE REQUIREMENTS SHALL BE CAREFULLY INVESTIGATED BY AND COORDINATED BY THE ELECTRICAL CONTRACTOR. PROVIDE ALL REQUIRED FACILITIES INCLUDING, BUT NOT LIMITED TO:

TRENCHING AND BACKFILL, CONDUIT, PULL WIRES AND/OR ROPES & STRINGS,
CABLE, CONNECTIONS, AND METERING PROVISIONS AND REQUIREMENTS.

6.) DO NOT BEGIN ANY WORK IN CONNECTION WITH THE MAIN SERVICE PRIOR TO RECEIVING AN ENGINEERING DRAWING FROM THE POWER COMPANY SHOWING THE REQUIRED FACILITIES.

1.) ALL WORK SHALL CONFORM TO ALL LOCAL, STATE AND NATIONAL ELECTRICAL CODES, INCLUDING THE LATEST EDITION OF THE N. E. C. AND ADA GUIDELINES.

2.) ELECTRICAL CONTRACTOR SHALL BE RESPONSIBLE FOR OBTAINING AND PURCHASING ALL NECESSARY LICENSES, PERMITS, AND INSPECTIONS, AS WELL AS ANY OTHER FEES REGARDING THE ELECTRICAL INSTALLATION.

3.) CONNECT ALL PIV VALVES TO THE FIRE ALARM SYSTEM. -- VERIFY LOCATION OF ALL PIV VALVES WITH THE SPRINKLE CONTRACTOR.

4.) PAD MOUNTED TRANSFORMER BY LOCAL POWER COMPANY. PAD AS DIRECTED BY THE LOCAL POWER COMPANY.


5.) ALL WIRING SHOWN ON THIS SITE PLAN SHALL BE A MINIMUM OF #10 THHN / THWN COPPER IN A MINIMUM 3/4" C., UNLESS NOTED OTHERWISE.

6.) PROVIDE ALL NECESSARY DISCONNECT AND SWITCHES FOR ALL SIGNS -- COORDINATE ALL SIGN CONNECTIONS WITH SIGN CONTRACTOR.

7.) SEE SHEET "E405" FOR POLE BASE DETAIL.

8.) UNDERWATER POOL LIGHTS BY POOL CONTRACTOR.

9.) IN OUTDOOR STORAGE BUILDING PROVIDE 2-TYPE "H" FIXTURES WITH ZERO DEGREE BALLASTS CONTROLLED BY 1-S.P.S.T. SWITCH AND 1-GFI DUPLEX RECEPTACLE. ALL FEED FROM CIRCUITS "CC-16 & 18".

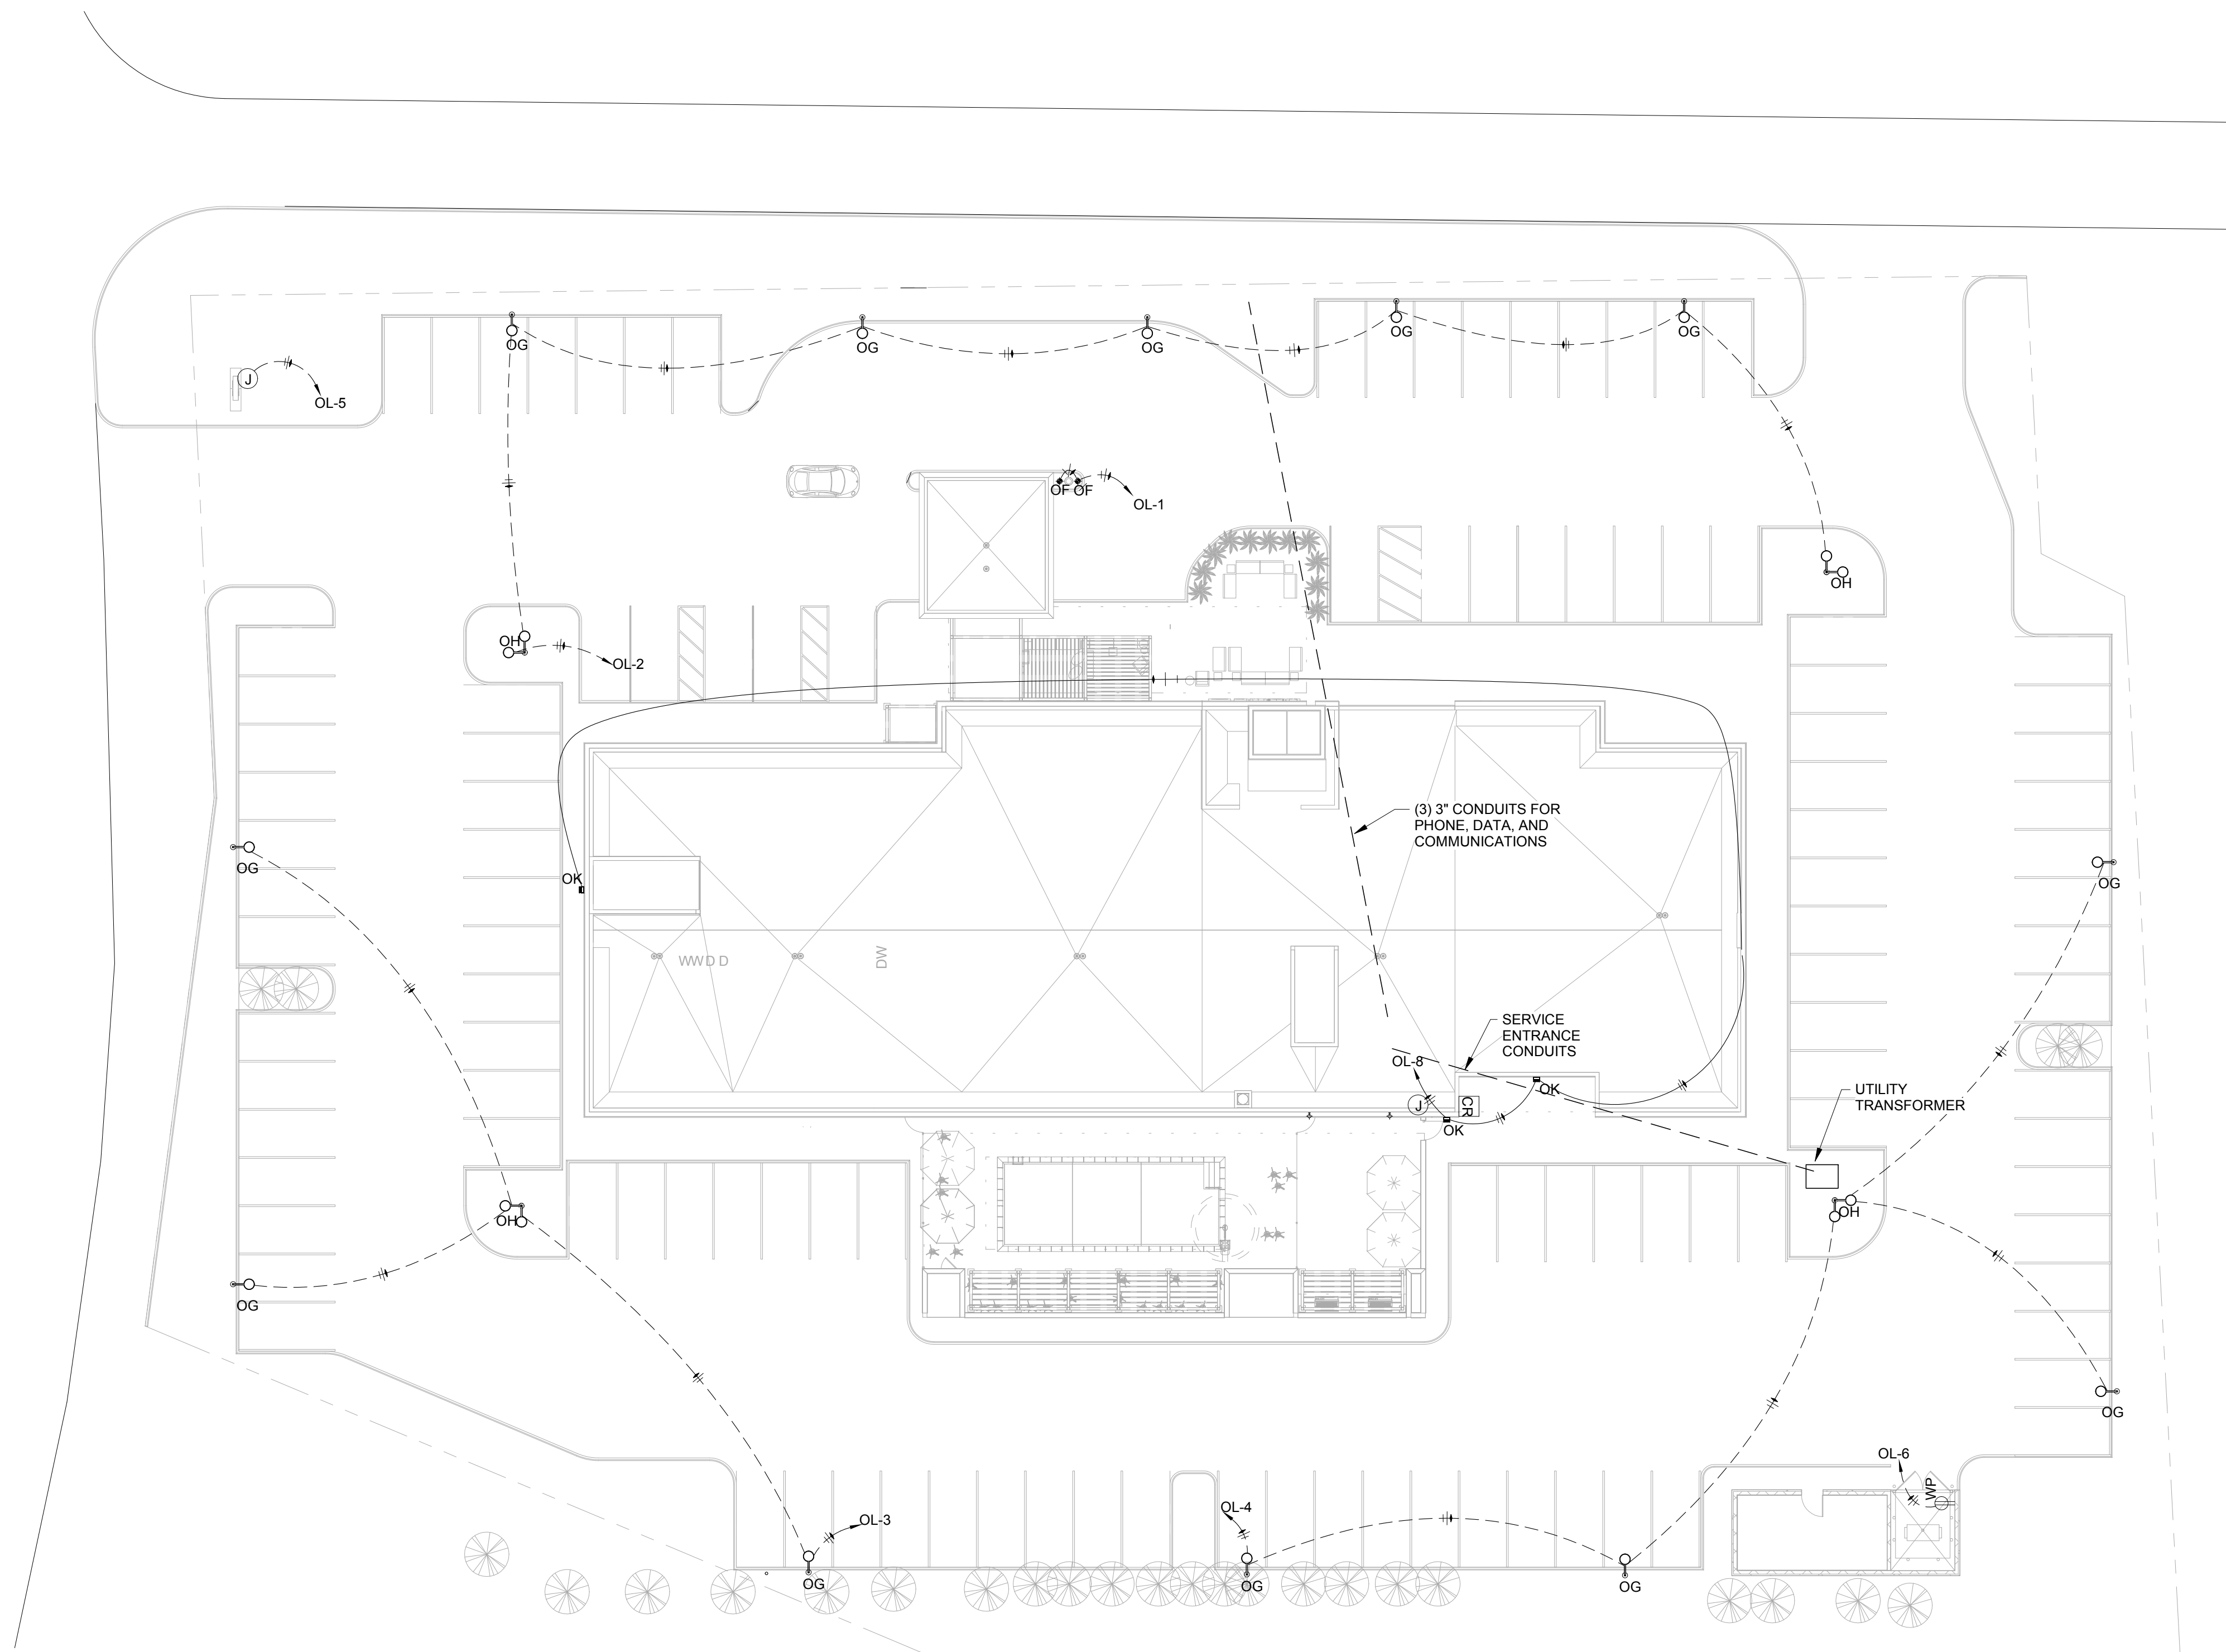


1 ELECTRICAL SITE PLAN
1" = 20'-0"

ALL PARKING AREA FOOTCANDLE LEVELS SHALL BE 2 FC MAINTAINED. PARKING AREA LIGHTING (TYPE "OG" & "OH" FIXTURES) SHALL BE FURNISHED AND INSTALLED BY ELEC. CONTR. - SUBMIT BOTH FIXTURES AND POLES TO "HOME2" FOR APPROVAL PRIOR TO PURCHASING.

DRAWING NOTES

A. PLEASE REFER TO SHEET E000 FOR PROJECT NOTES, LEGEND
SCHEDULES, & DETAILS

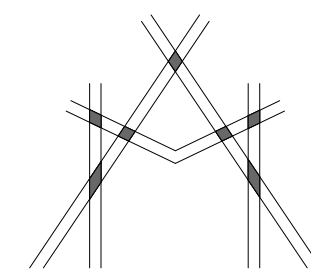

M I S H R A
ARCHITECTURE PLLC

6800 S Creek Rd, Charlotte, NC 28277
Ph:(704) 625-6554 Fax:(704) 919-5822
EMAIL:ashish@mishraarch.com
WEB: www.mishraarch.com

CIVIL:
Benchmark Engineering and Surveying
101 Highpointe Court, Suite B
Brandon, MS 39042
Phone: (601) 591-1077
Fax: (601) 591-0177
Email: mikebes@bellsouth.net

STRUCTURAL:
Whisonant Engineering Services, LLC
122 Nut Tree Court
Lexington, SC 29074
Phone: (803) 957-4008
Email: bill@weslex.com

MEP:
Innovative Engineering Services, LLC
2787 Stage Center DR., Suite 101
Bartlett, TN 38134
Phone: (901) 379-0500
Email: rhertter@innovativees-llc.com

[illegible]

Information contained on this drawing and in all digital files associated is authorized for use on the project named herein only and is the property of MISHRA ARCHITECTURE PLLC and may not be reproduced in any manner without express written or verbal permission from authorized individuals. Original drawing is 24"x36" and scales are as indicated.⁶
2011 MISHRA ARCHITECTURE PLLC



KEY PLAN

Pramukh Vicksburg.
LLC

HOME2suites
Vicksburg

Berryman Road
Vicksburg, MS 39180

Drawing Title

ELECTRICAL - SITE PLAN

Phase
Construction Documents

Project No. 19008

Prepared by PTH

Checked by R.J.H.

Date 04/02/19

Sheet No

E101

Released for

[illegible]

Information contained on this drawing and in all digital files associated is authorized for use on the project named herein only and is the property of MISHRA ARCHITECTURE PLLC and may not be reproduced in any manner without express written or verbal permission from authorized individuals. Original drawing is 24"x36" and scales are as indicated.
2011 MISHRA ARCHITECTURE PLLC



KEY PLAN

Pramukh Vicksburg.
LLC

HOME2suits
Vicksburg

Berryman Road
Vicksburg, MS 39180

Drawing Title

ELECTRICAL - SITE
PHOTOMETRICS

Phase
Construction Documents


Project No. 10005 Sheet No.

Prepared by	19005
-------------	-------

Prepared by	PTH	E102
Checked by		

Checked by	RJH
------------	-----

Released for

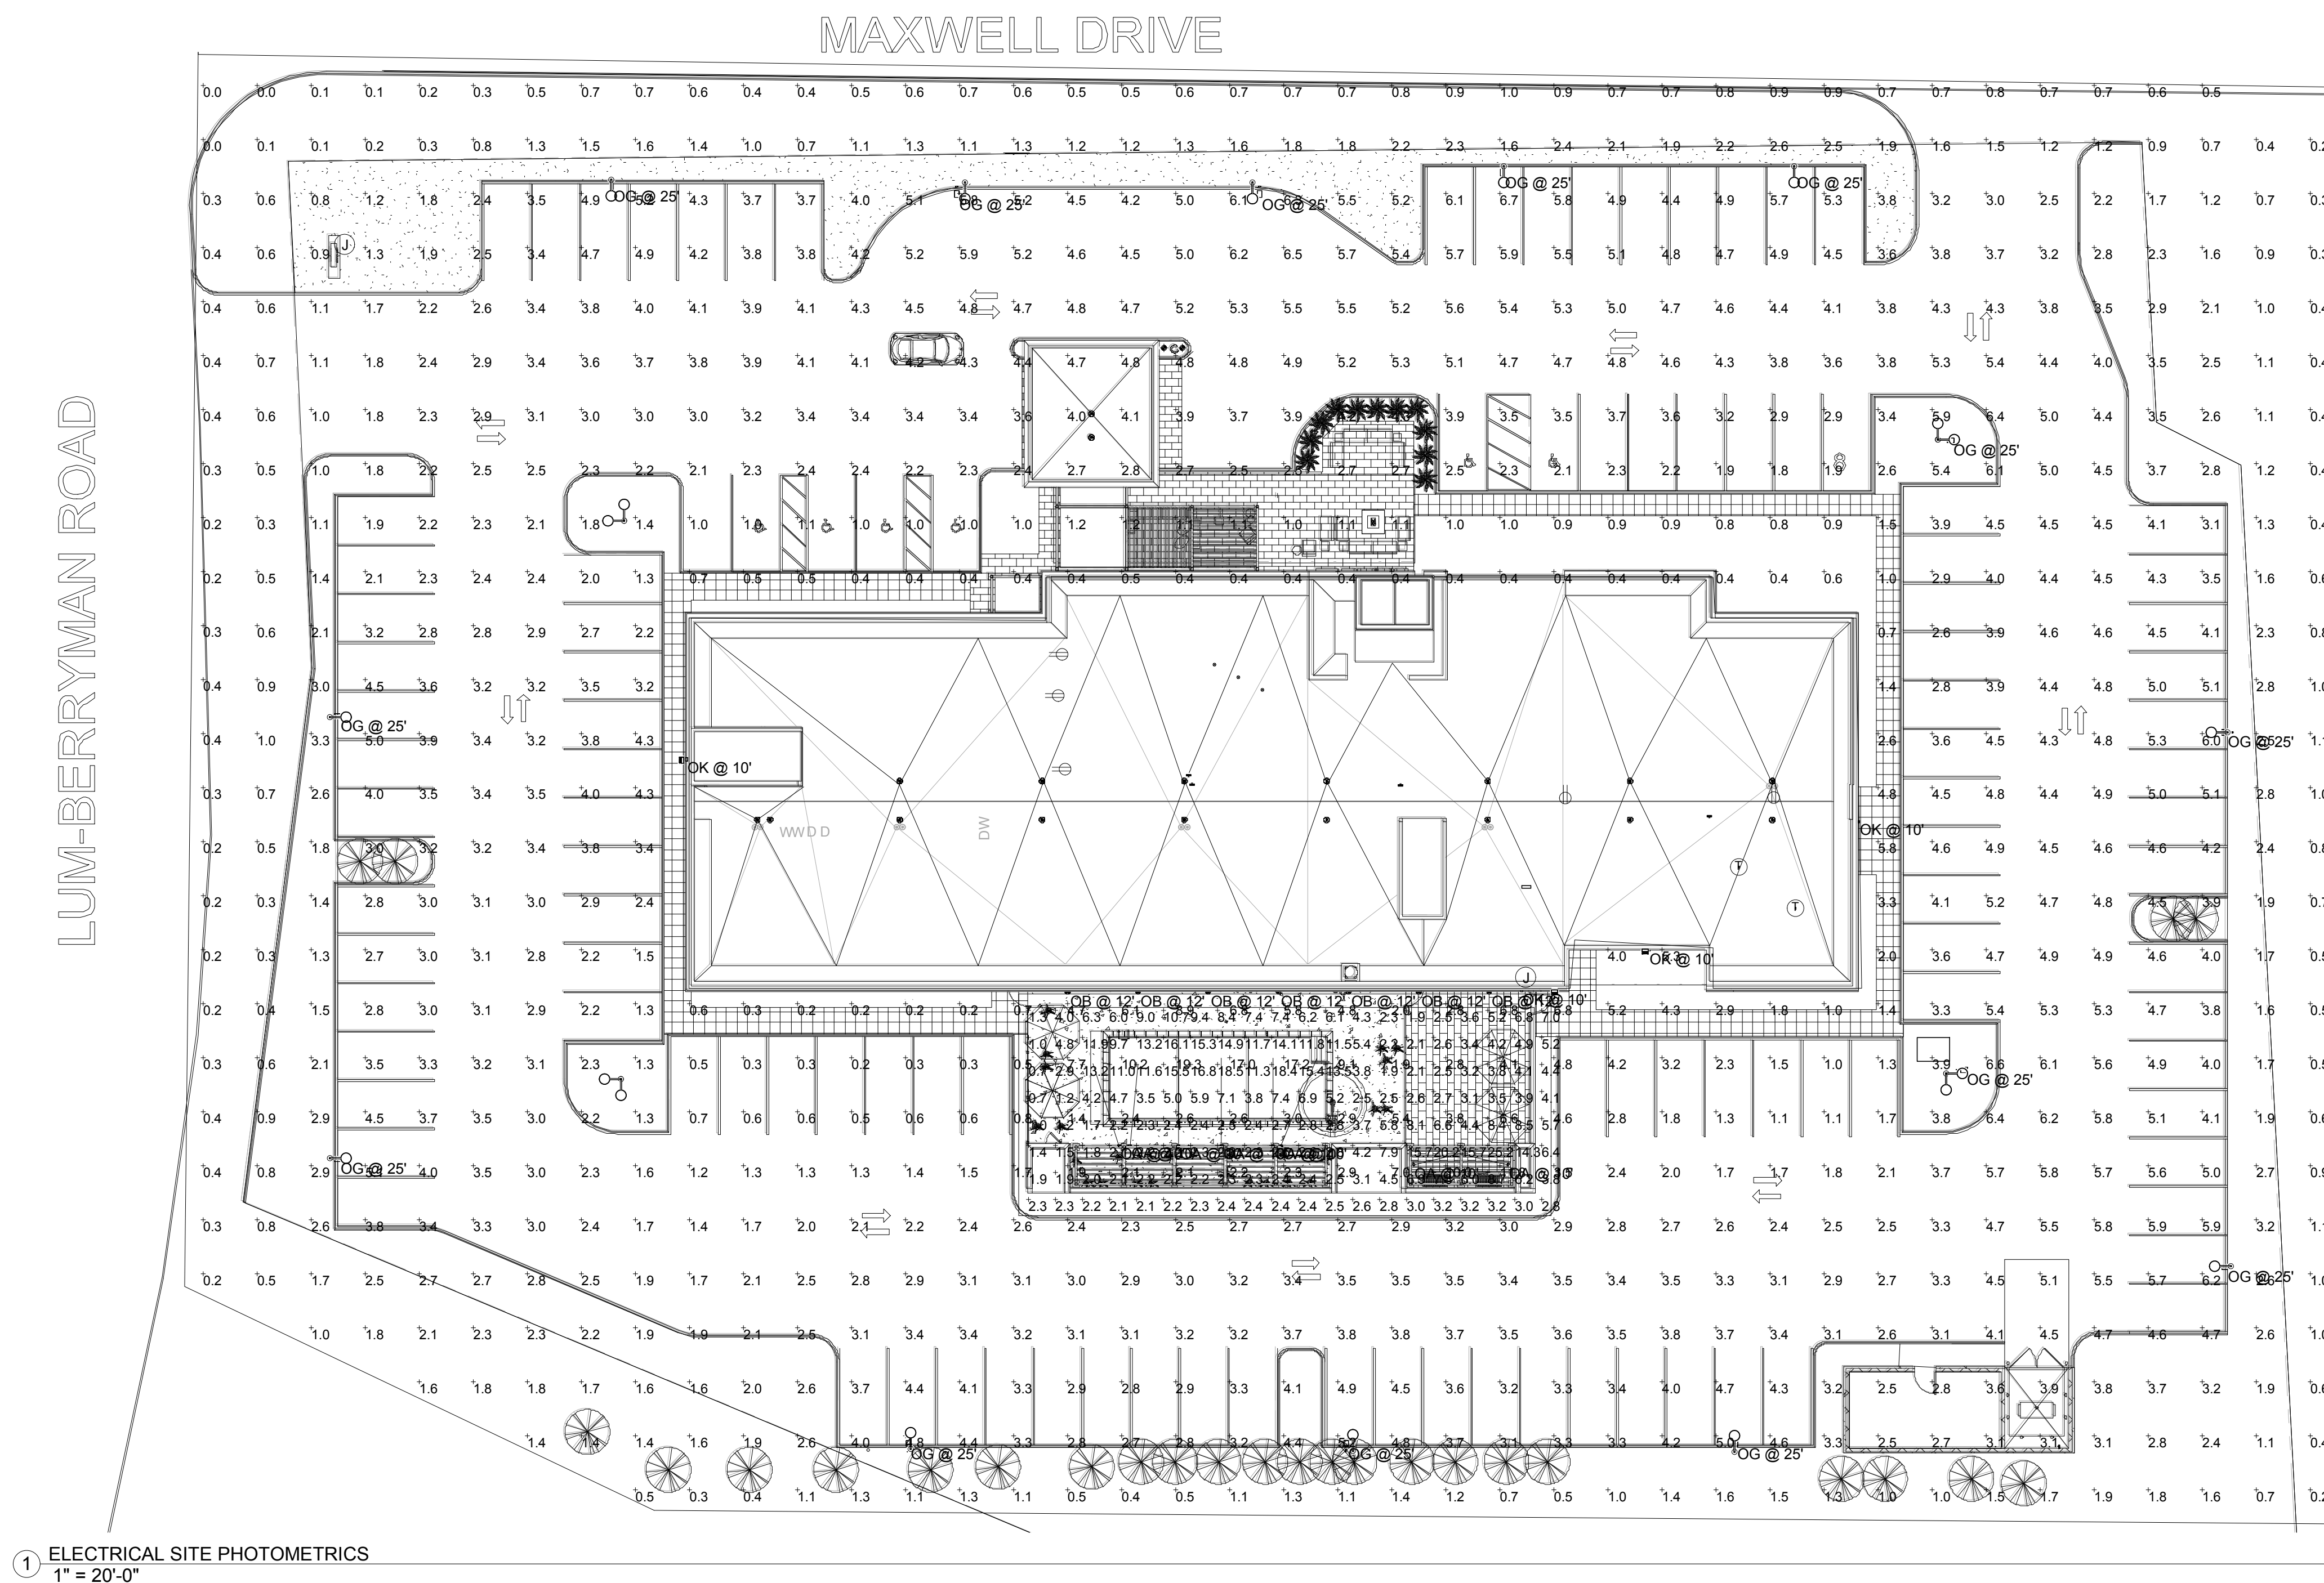

OUTDOOR LIGHT FIXTURE SCHEDULE

Label	Quantity	Manufacturer	Catalog Number	Description	Lamp	Lumens Per Lamp	Light Loss Factor	Wattage
OA	8	Hydrel	TPS1 18LED WHT41K MFL FLC	AXIAL LED FLOODLIGHT 8.4" OD X 10.5" LONG	18 CHIP LED ARRAY	2581	1	34
OB	7	BEGA Converted by LUMCat V 08/09/2017 / H.R.		33 308 K3	LED 2, 1W	66	1	3
OF	2	Hydrel	M9700 22LED WHT53K MFL	M9700 LAMP MODULE, 9" DIA. X 3" DEPTH WITH 18 WHITE 53K LED, WITH MFL OPTICS, TEMPERED CLEAR FLAT LENS, TEMP 53.2C	ONE 20 5-WATT LED, AIMED UP POS.	Absolute	1	20.5
OG	14	Lithonia Lighting	DSX1 LED 60C 1000 40K T4M MVOLT HS	DSX1 LED with 60 LEDs @ 1000 mA , 4000K , TYPE 4 MEDIUM OPTICS WITH HOUSE-SIDE SHIELD	LED	17084	1	209
OH	0	Lithonia Lighting	DSX1 LED 60C 1000 40K T4M MVOLT HS	DSX1 LED with 60 LEDs @ 1000 mA , 4000K , TYPE 4 MEDIUM OPTICS WITH HOUSE-SIDE SHIELD	LED	17084	1	418
OL	0	Lithonia Lighting	DSXF2 LED 4 A53040K HMF MVOLT	D-SERIES FLOOD SIZE 2 WITH 4 COB, 4000K, (HMF) DISTRIBUTION, NEMA TYPE 6HX4V	LED	Absolute	1	79.35
OK	4	Lithonia Lighting	DSXW1 LED 20C 700 40K T4M MVOLT	DSXW1 LED WITH 2 LIGHT ENGINES, 20 LED's, 700mA DRIVER, 4000K LED, TYPE 4 MEDIUM OPTIC	LED	4430	1	47

Statistics						
Description	Symbol	Avg	Max	Min	Max/Min	Avg/Min
SITE PLAN	+	2.8 fc	19.3 fc	0.0 fc	N/A	N/A
POOL PLAN	+	5.5 fc	25.2 fc	0.7 fc	36.0:1	7.9:1

POOL EQUIPMENT:

ELECTRICAL CONTRACTOR SHALL VERIFY EXACT LOCATIONS & ELECTRICAL REQUIREMENTS OF ALL POOL EQUIPMENT INCLUDING, BUT NOT LIMITED TO: POOL PUMP OR PUMPS, SPA PUMP OR PUMPS, UNDERWATER POOL LIGHTS, TRANSFORMERS, DEHUMIDIFIERS, CONDENSING UNITS, ETC. PRIOR TO THE ROUGH-IN OF ANY ELECTRICAL EQUIPMENT. ELECTRICAL CONTRACTOR SHALL NOTIFY THE OWNER & ARCHITECT OF ANY CONFLICTS WITH THE ELECTRICAL DESIGN DRAWINGS AND THE EQUIPMENT FURNISHED BY THE OWNER AND THE POOL CONTRACTOR. ALL POOL AREA LIGHTING, EQUIPMENT, AND RECEPTACLE CIRCUITS SHALL HAVE GFCI PROTECTION.


LAUNDRY EQUIPMENT:

ELECTRICAL CONTRACTOR SHALL VERIFY EXACT LOCATIONS & ELECTRICAL REQUIREMENTS OF ALL LAUNDRY EQUIPMENT INCLUDING, BUT NOT LIMITED TO:

COMMERCIAL WASHERS & DRYERS, GUEST WASHERS & DRYERS, WATER SOFTENERS, MOTORIZED LOUVERS, SOAP DISPENSERS, ETC. PRIOR TO THE ROUGH-IN OF ANY ELECTRICAL EQUIPMENT. ELECTRICAL CONTRACTOR SHALL NOTIFY THE OWNER & ARCHITECT OF ANY CONFLICTS WITH THE ELECTRICAL DESIGN DRAWINGS AND OWNER SUPPLIED EQUIPMENT.



INNOVATIVE • ENGINEERING
SERVICES, LLC

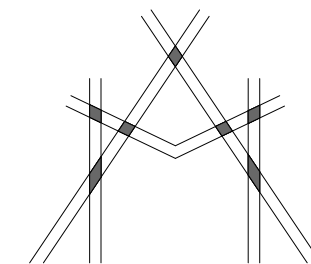

MISHRA
ARCHITECTURE PLLC

6800 S Creek Rd, Charlotte, NC 28277
Ph: (704) 625-6554 Fax: (704) 919-5822
EMAIL: ashish@mishraarch.com
WEB: www.mishraarch.com

CIVIL:
Benchmark Engineering and Surveying
101 Highpointe Court, Suite B
Brandon, MS 39042
Phone: (601) 591-1077
Fax: (601) 591-0177
Email: mikebes@bellsouth.net

STRUCTURAL:
Whisonant Engineering Services, LLC
122 Nut Tree Court
Lexington, SC 29074
Phone: (803) 957-4008
Email: bill@weslex.com

MEP:
Innovative Engineering Services, LLC
2787 Stage Center DR., Suite 101
Bartlett, TN 38134
Phone: (901) 379-0500
Email: rhtetter@innovatees-llc.com

REVISIONS		
No.	Date	Description
1	04/22/19	Owner Request
2	05/06/19	Hilton Comments
3	05/21/19	Added PBX

Information contained on this drawing and in all digital files associated is authorized for use on the project named herein only and is the property of MISHRA ARCHITECTURE PLLC and may not be reproduced in any manner without express written or verbal permission from authorized individuals. Original drawing is 24"x36" and scales are as indicated. 2011 MISHRA ARCHITECTURE PLLC



KEY PLAN

Pramukh Vicksburg, LLC

HOME2suites
Vicksburg

Berryman Road
Vicksburg, MS 39180

Drawing Title


**ELECTRICAL - FIRST
FLOOR POWER PLAN**

Phase
Construction Documents

Project No. 19005
Prepared by PTH
Checked by RJH
Date 04/02/19

Sheet No.
E201

Released for

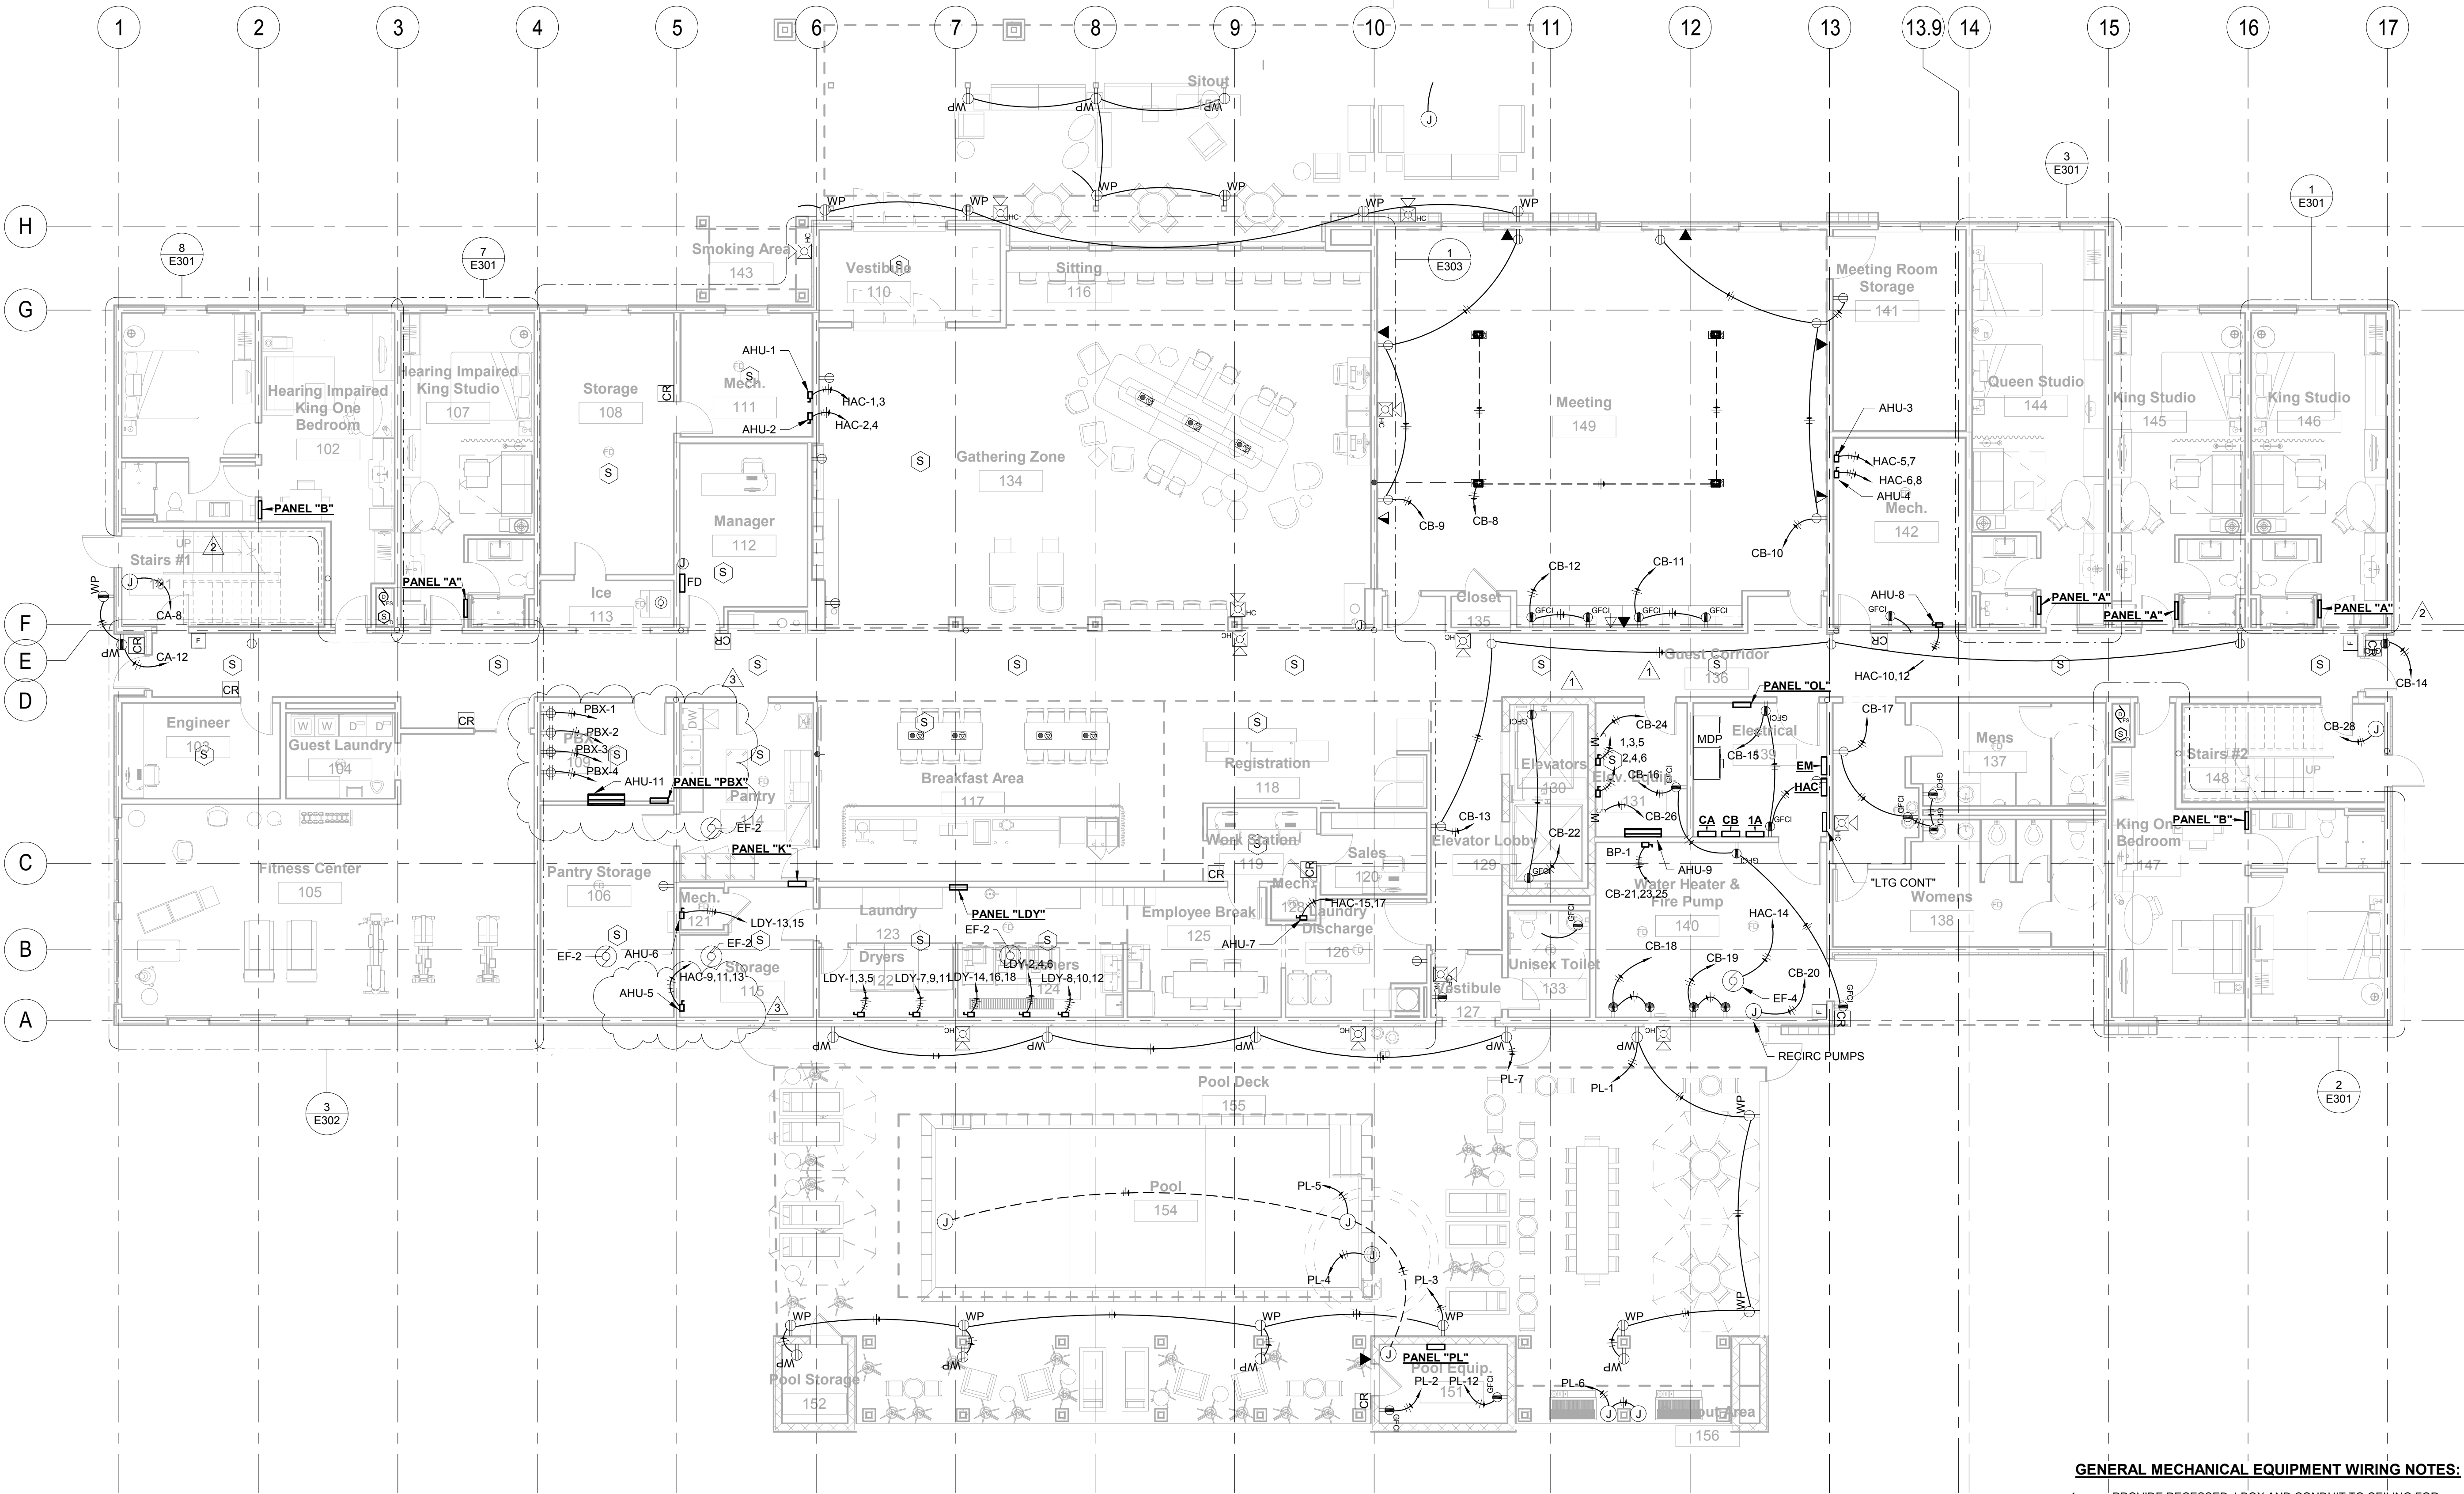


① FIRST FLOOR PLAN - POWER
1/8" = 1'-0"

GENERAL MECHANICAL EQUIPMENT WIRING NOTES:

- PROVIDE RECESSED J-BOX AND CONDUIT TO CEILING FOR THERMOSTATS AS REQUIRED BY MECHANICAL TRADES.
- SEE PANELBOARD SCHEDULES FOR CIRCUIT NUMBER INFORMATION.
- PROVIDE DISCONNECTS AS SHOWN IN SCHEDULE WITH FLEXIBLE CONNECTION TO VIBRATING EQUIPMENT. MOUNT DISCONNECT ADJACENT TO EQUIPMENT.
- WHILE THE EQUIPMENT SHOWN IS BELIEVED TO BE ACCURATE, VERIFY WIRING AND OVERCURRENT PROTECTION REQUIREMENT AS INDICATED BY NAMEPLATE ON ACTUAL EQUIPMENT INSTALLED. DO NOT CIRCUIT EQUIPMENT UNTIL VERIFICATION IS MADE, THEN CIRCUIT ACCORDINGLY. PROVIDE NEMA 3R DISCONNECTS FOR ALL OUTSIDE UNITS.

GENERAL NOTES THIS SHEET:


1. INCREASE THE WIRE SIZE A MINIMUM OF ONE SIZE ON ALL 120V. HOME-RUNS OVER 100 FEET IN LENGTH. INCREASE THE WIRE SIZE A MINIMUM OF ONE SIZE FOR ALL 208V. HOME-RUNS OVER 150 FEET IN LENGTH.
2. VERIFY THE ELECTRICAL REQUIREMENTS OF ALL MECHANICAL EQUIPMENT WITH THE MECHANICAL CONTRACTOR AND HIS SUPPLIER PRIOR TO ROUGH-IN.
3. EMERGENCY LIGHTS IN CORRIDOR SHALL BE WIRED ON A SINGLE CIRCUIT PER FLOOR.
4. WHERE EXIT SIGNS ARE MOUNTED FROM THE CEILING, THERE SHALL ALSO BE LOW LEVEL EXIT SIGNS. THE BOTTOM OF THE SIGN SHALL BE NOT LESS THAN 10" & NO MORE THAN 12" ABOVE THE FLOOR LEVEL. THE SIGN SHALL BE FLUSH MOUNTED TO THE DOOR OR WALL. WHERE MOUNTED ON THE WALL, THE EDGE OF THE SIGN SHALL BE WITHIN 4" OF THE DOOR FRAME ON THE LATCH SIDE.

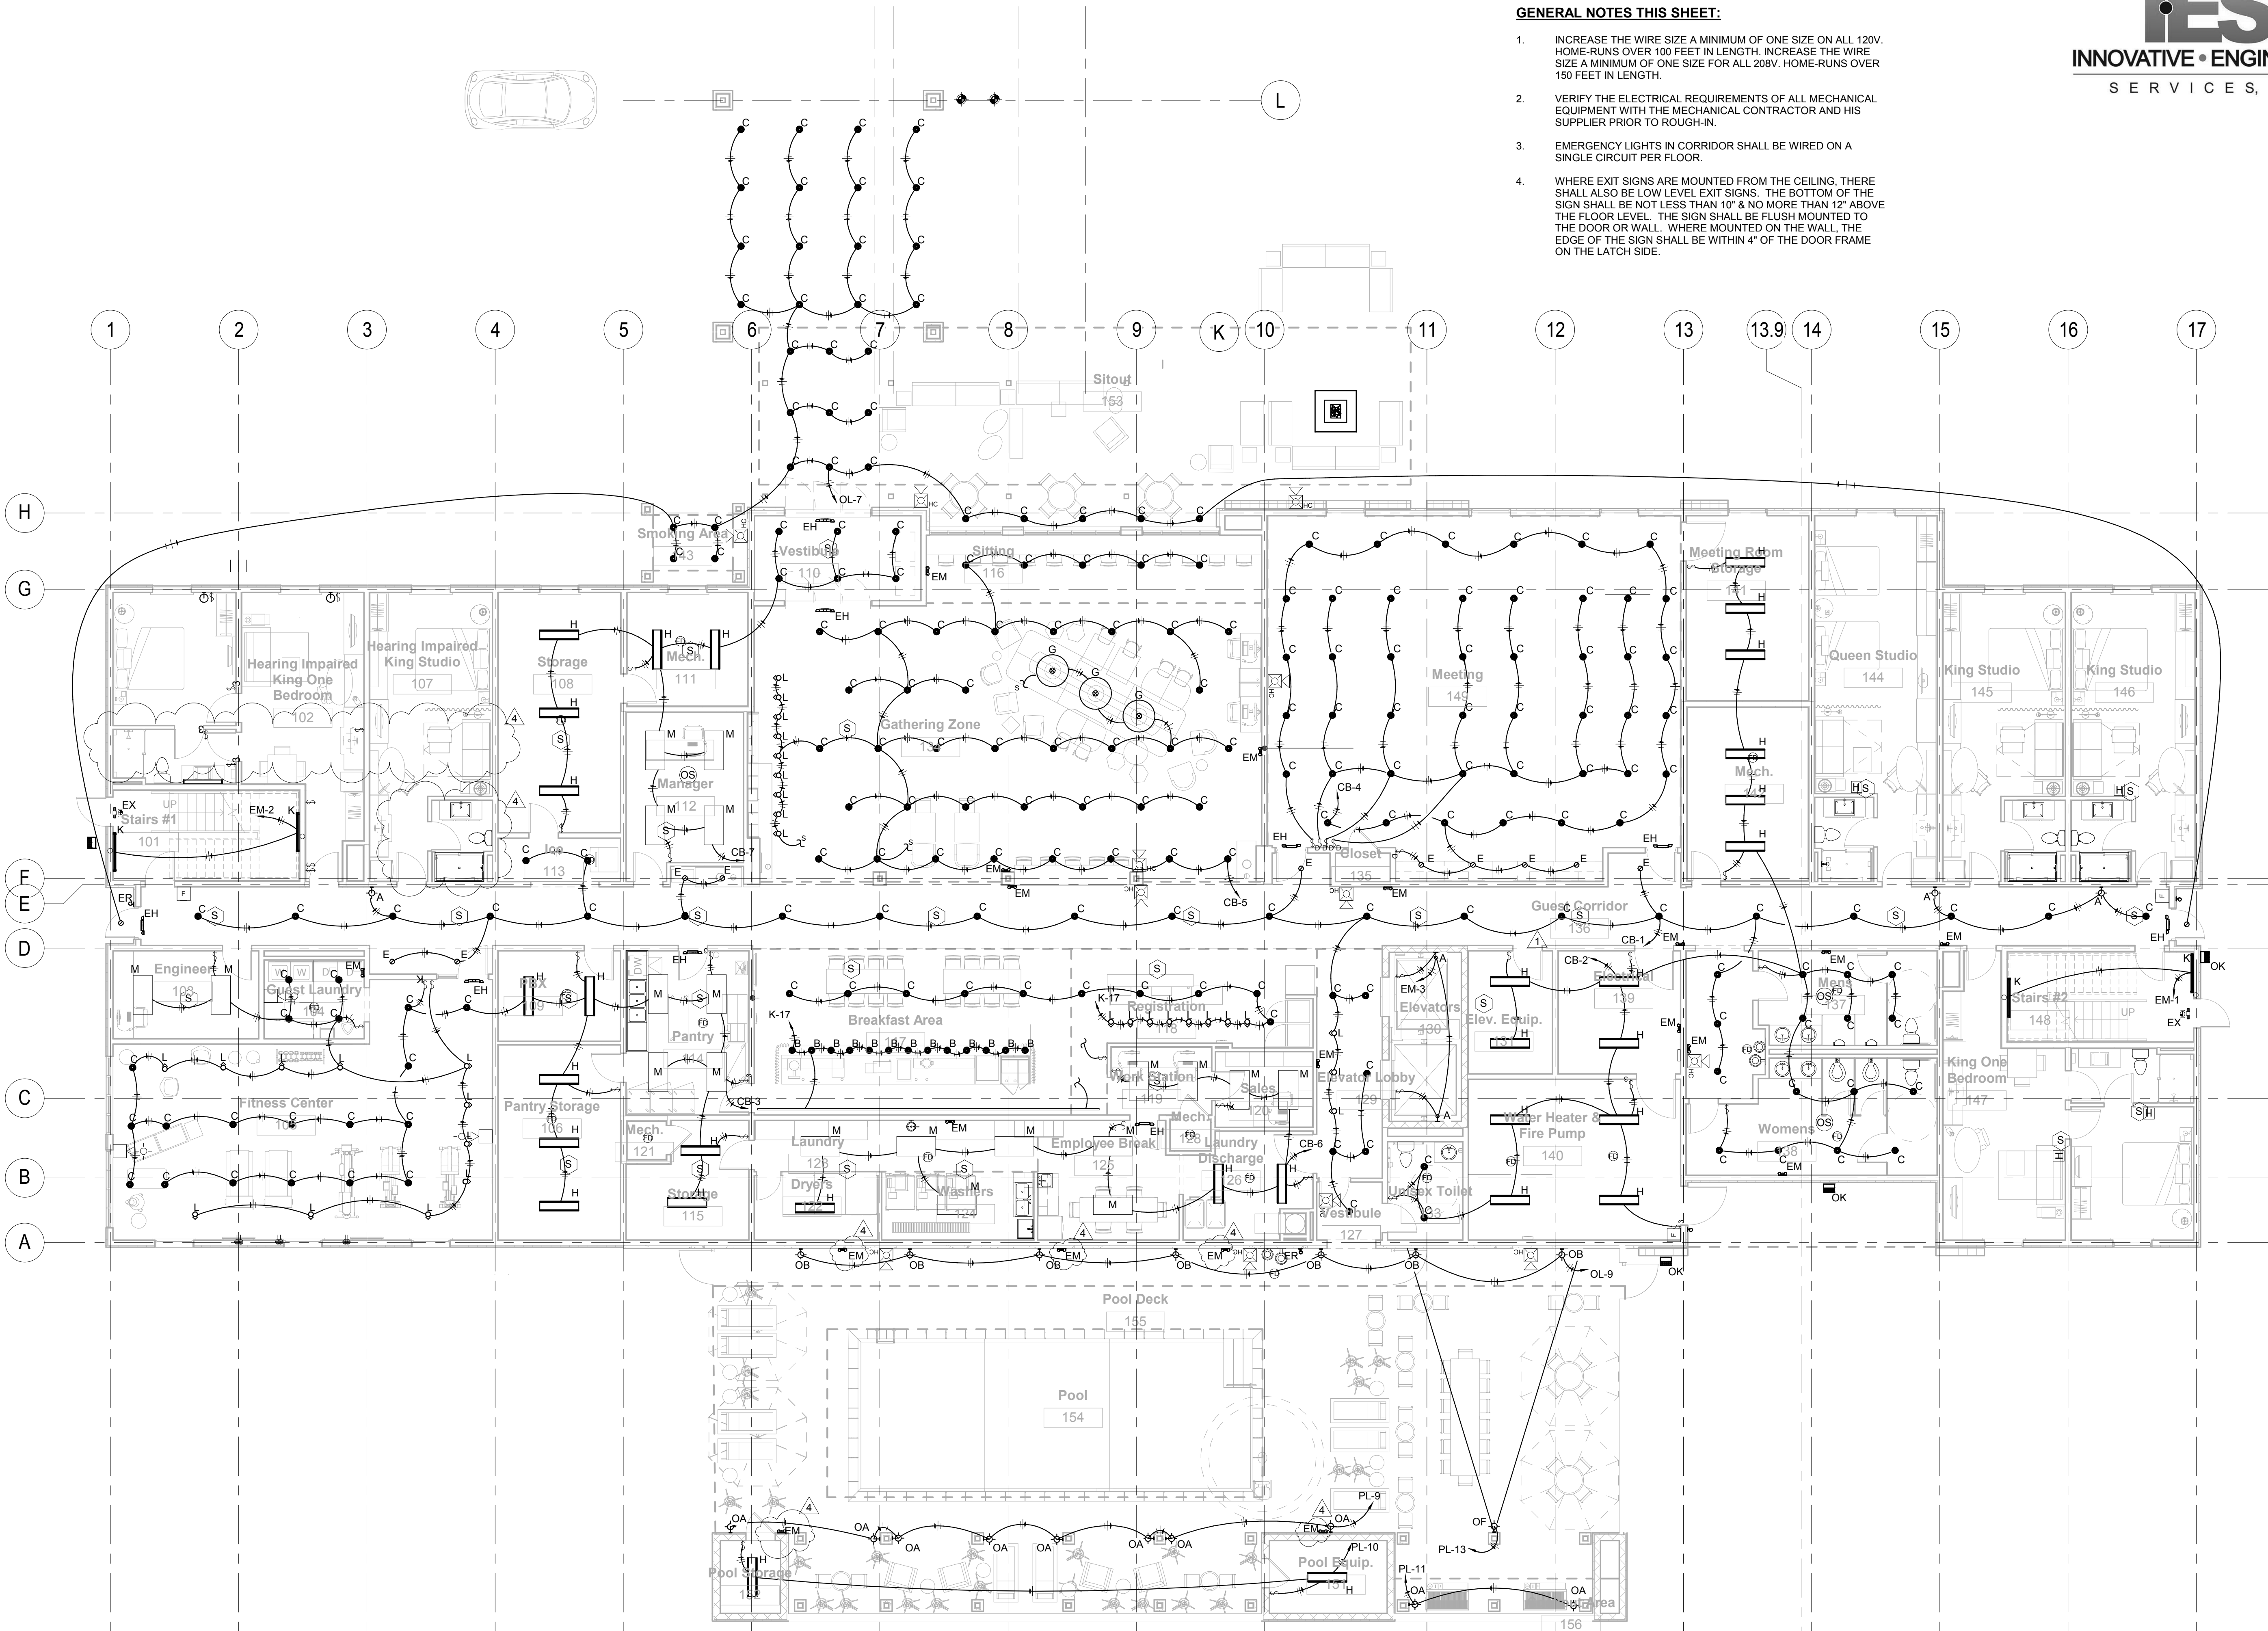

1 FIRST FLOOR PLAN - LIGHTING
1/8" = 1'-0"

REVISIONS		
No.	Date	Description
1	04/22/19	Owner Request
4	07/16/19	Code Response

Information contained on this drawing and in all digital files associated is authorized for use on the project named herein only and is the property of MISHRA ARCHITECTURE PLLC and may not be reproduced in any manner without express written or verbal permission from authorized individuals. Original drawing is 24"x36" and scales are as indicated. 2011 MISHRA ARCHITECTURE PLLC

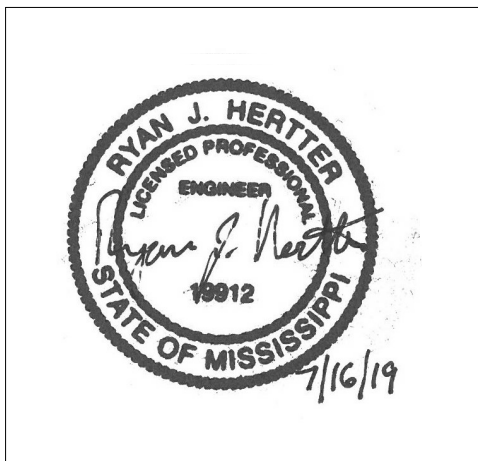

KEY PLAN

Pramukh Vicksburg, LLC

HOME2suits
Vicksburg

Berryman Road
Vicksburg, MS 39180

Drawing Title
ELECTRICAL - FIRST
FLOOR LIGHTING PLAN

Phase
Construction Documents

Project No. 19005
Prepared by PTH
Checked by RJH
Date 04/02/19

Sheet No.
E202


Released for

RYAN J. HEATTER
ENGINEER
LICENSED PROFESSIONAL
19912
STATE OF MISSISSIPPI
4/2/19

E203

HOME2suits Vicksburg

1. INCREASE THE WIRE SIZE A MINIMUM OF ONE SIZE ON ALL 120V. HOME-RUNS OVER 100 FEET IN LENGTH. INCREASE THE WIRE SIZE A MINIMUM OF ONE SIZE FOR ALL 208V. HOME-RUNS OVER 150 FEET IN LENGTH.
2. VERIFY THE ELECTRICAL REQUIREMENTS OF ALL MECHANICAL EQUIPMENT WITH THE MECHANICAL CONTRACTOR AND HIS SUPPLIER PRIOR TO ROUGH-IN.
3. EMERGENCY LIGHTS IN CORRIDOR SHALL BE WIRED ON A SINGLE CIRCUIT PER FLOOR.
4. WHERE EXIT SIGNS ARE MOUNTED FROM THE CEILING, THERE SHALL ALSO BE LOW LEVEL EXIT SIGNS. THE BOTTOM OF THE SIGN SHALL BE NOT LESS THAN 10" & NO MORE THAN 12" ABOVE THE FLOOR LEVEL. THE SIGN SHALL BE FLUSH MOUNTED TO THE DOOR OR WALL. WHERE MOUNTED ON THE WALL, THE EDGE OF THE SIGN SHALL BE WITHIN 4" OF THE DOOR FRAME ON THE LATCH SIDE.

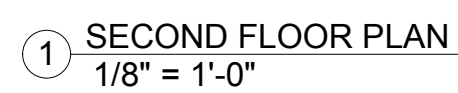


RYAN J. HEATTER
ENGINEER
LICENSED PROFESSIONAL
19912
STATE OF MISSISSIPPI
4/2/19

HOME2suites
Vicksburg

Released for

HOME2suits Vicksburg

1. INCREASE THE WIRE SIZE A MINIMUM OF ONE SIZE ON ALL 120V. HOME-RUNS OVER 100 FEET IN LENGTH. INCREASE THE WIRE SIZE A MINIMUM OF ONE SIZE FOR ALL 208V. HOME-RUNS OVER 150 FEET IN LENGTH.
2. VERIFY THE ELECTRICAL REQUIREMENTS OF ALL MECHANICAL EQUIPMENT WITH THE MECHANICAL CONTRACTOR AND HIS SUPPLIER PRIOR TO ROUGH-IN.
3. EMERGENCY LIGHTS IN CORRIDOR SHALL BE WIRED ON A SINGLE CIRCUIT PER FLOOR.
4. WHERE EXIT SIGNS ARE MOUNTED ON THE CEILING, THERE SHALL ALSO BE LOW LEVEL EXIT SIGNS. THE BOTTOM OF THE SIGN SHALL BE NOT LESS THAN 10" & NO MORE THAN 12" ABOVE THE FLOOR LEVEL. THE SIGN SHALL BE FLUSH MOUNTED TO THE FLOOR OR WALL. WHERE MOUNTED ON THE WALL, THE EDGE OF THE SIGN SHALL BE WITHIN 4" OF THE DOOR FRAME ON THE LATCH SIDE.

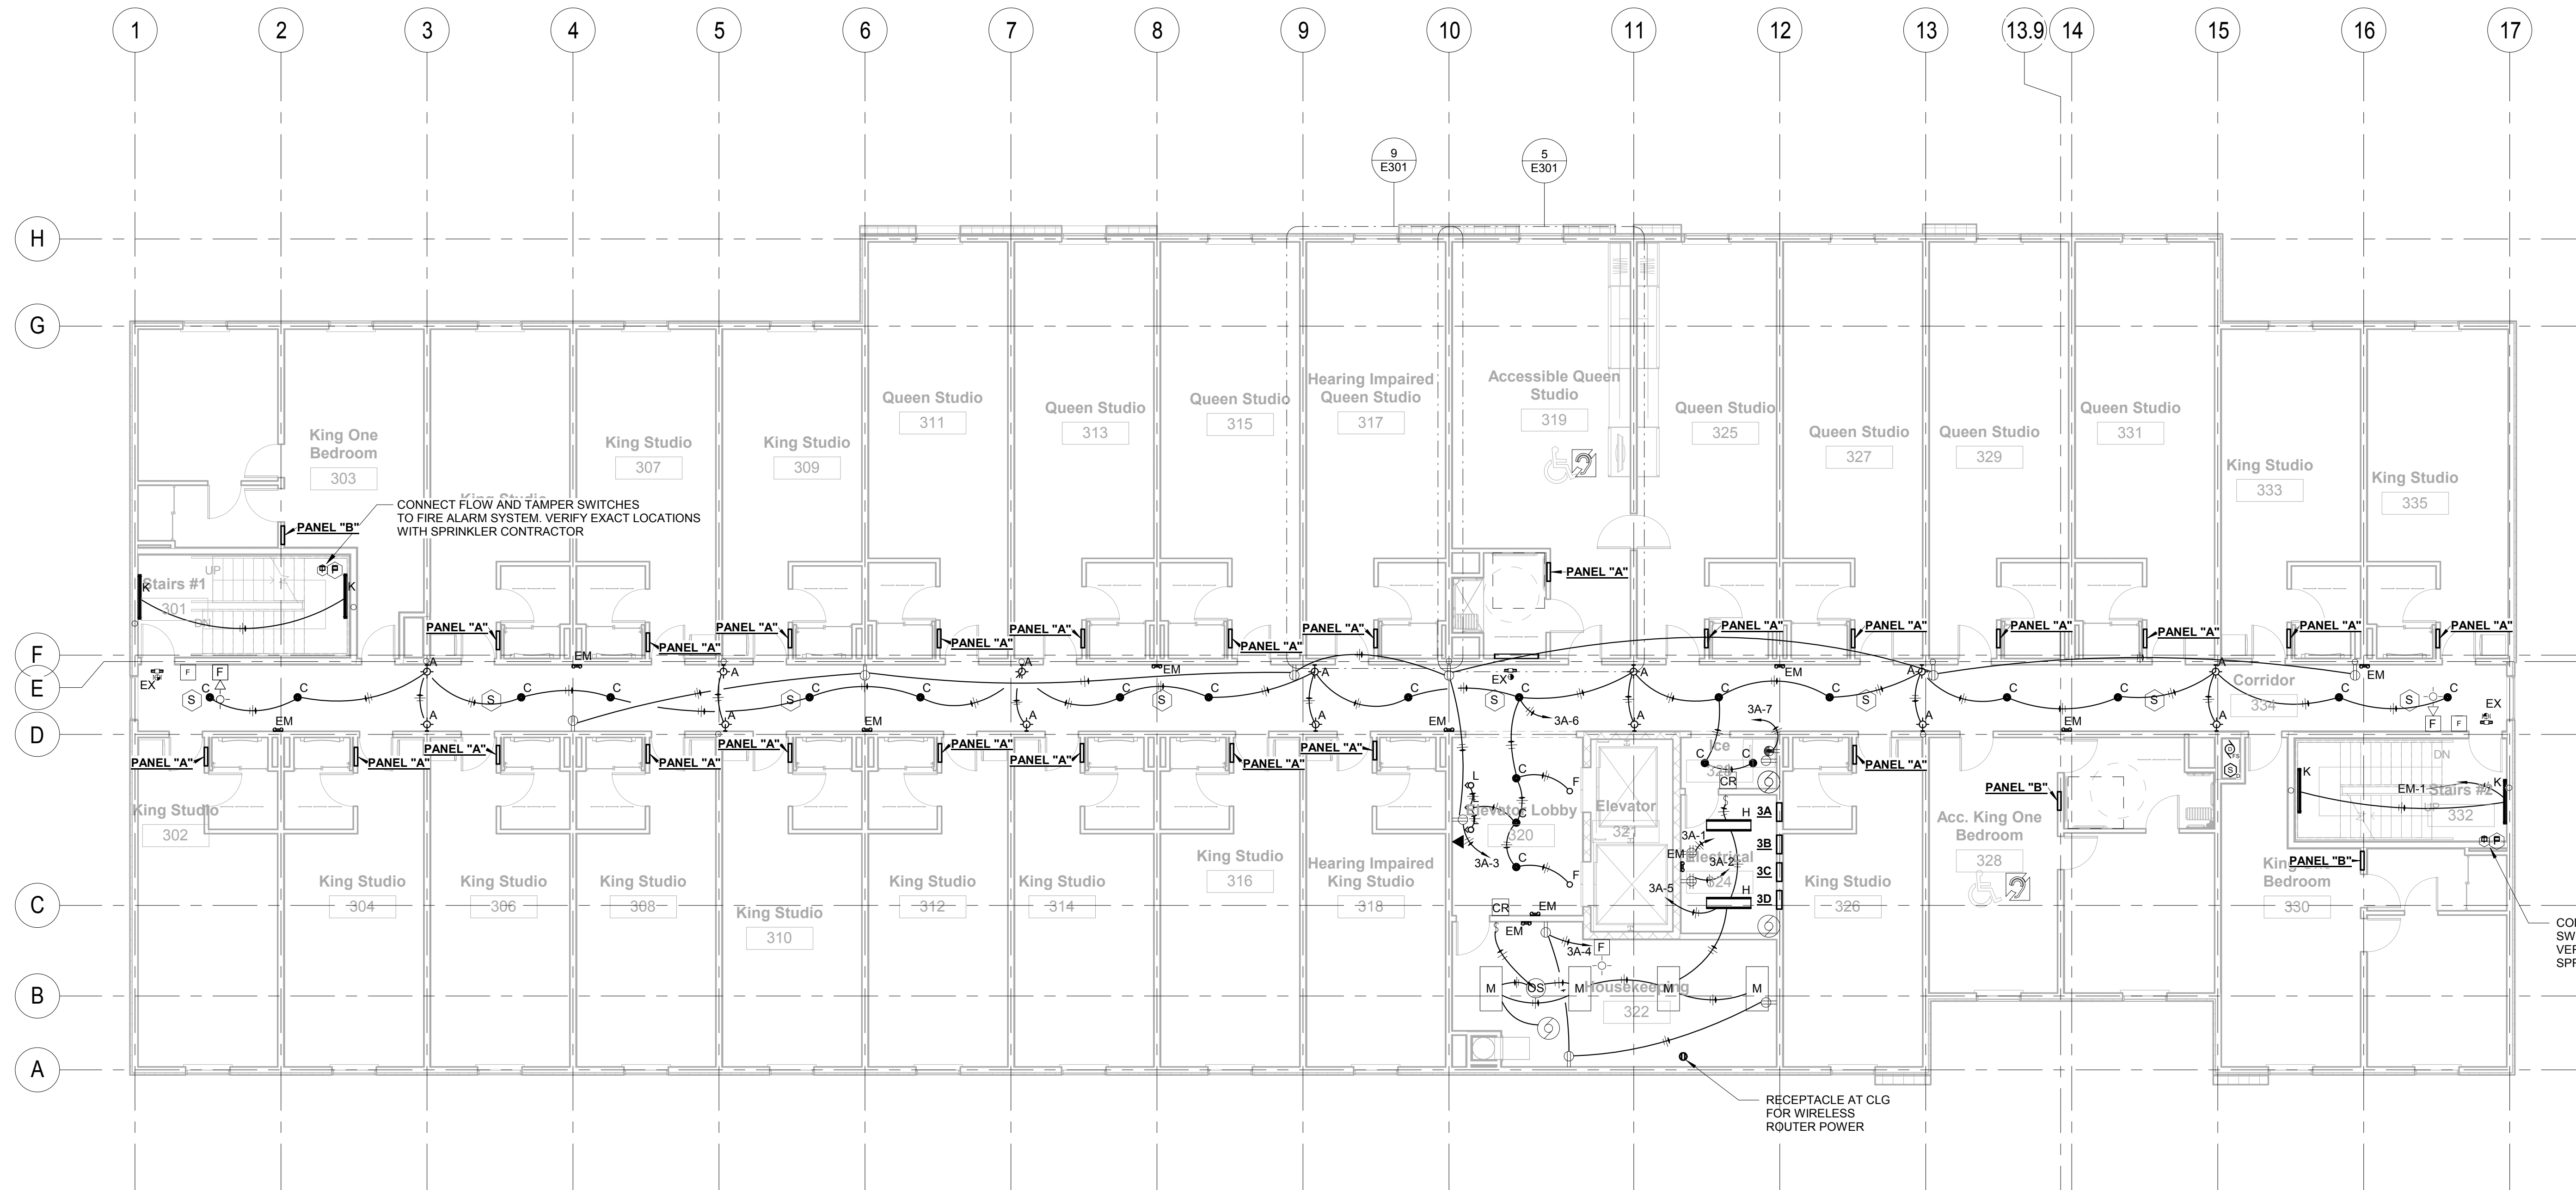

① THIRD FLOOR PLAN
1/8" = 1'-0"

STRUCTURAL:
Whisonant Engineering Services, LLC
122 Nut Tree Court
Lexington, SC 29074
Phone: (803) 957-4008
Email: bill@weslex.com

MEP:
Innovative Engineering Services, LLC
2787 Stage Center DR., Suite 101
Bartlett, TN 38134
Phone: (901) 379-0500
Email: rhertter@innovativees-llc.com

[illegible]

Information contained on this drawing and in all digital files associated is authorized for use on the project named herein only and is the property of MISHRA ARCHITECTURE PLLC and may not be reproduced in any manner without express written or verbal permission from authorized individuals. Original drawing is 24"x36" and scales are as indicated.²
2011 MISHRA ARCHITECTURE PLLC



KEY PLAN

Pramukh Vicksburg.
LLC

HOME2suites
Vicksburg

Berryman Road
Vicksburg, MS 39180

Drawing Title


ELECTRICAL - FOURTH FLOOR PLAN

Phase
Construction Documents

Project No.	19005
Prepared by	PTH
Checked by	RJH
Date	04/02/19

Released for

1. INCREASE THE WIRE SIZE A MINIMUM OF ONE SIZE ON ALL 120V. HOME-RUNS OVER 100 FEET IN LENGTH. INCREASE THE WIRE SIZE A MINIMUM OF ONE SIZE FOR ALL 208V. HOME-RUNS OVER 150 FEET IN LENGTH.
2. VERIFY THE ELECTRICAL REQUIREMENTS OF ALL MECHANICAL EQUIPMENT WITH THE MECHANICAL CONTRACTOR AND HIS SUPPLIER PRIOR TO ROUGH-IN.
3. EMERGENCY LIGHTS IN CORRIDOR SHALL BE WIRED ON A SINGLE CIRCUIT PER FLOOR.
4. WHERE EXIT SIGNS ARE MOUNTED FROM THE CEILING, THERE SHALL ALSO BE LOW LEVEL EXIT SIGNS. THE BOTTOM OF THE SIGN SHALL BE NOT LESS THAN 10" & NO MORE THAN 12" ABOVE THE FLOOR LEVEL. THE SIGN SHALL BE FLUSH MOUNTED TO THE FLOOR OR WALL. WHERE MOUNTED ON THE WALL, THE EDGE OF THE SIGN SHALL BE WITHIN 4" OF THE DOOR FRAME ON THE LATCH SIDE.

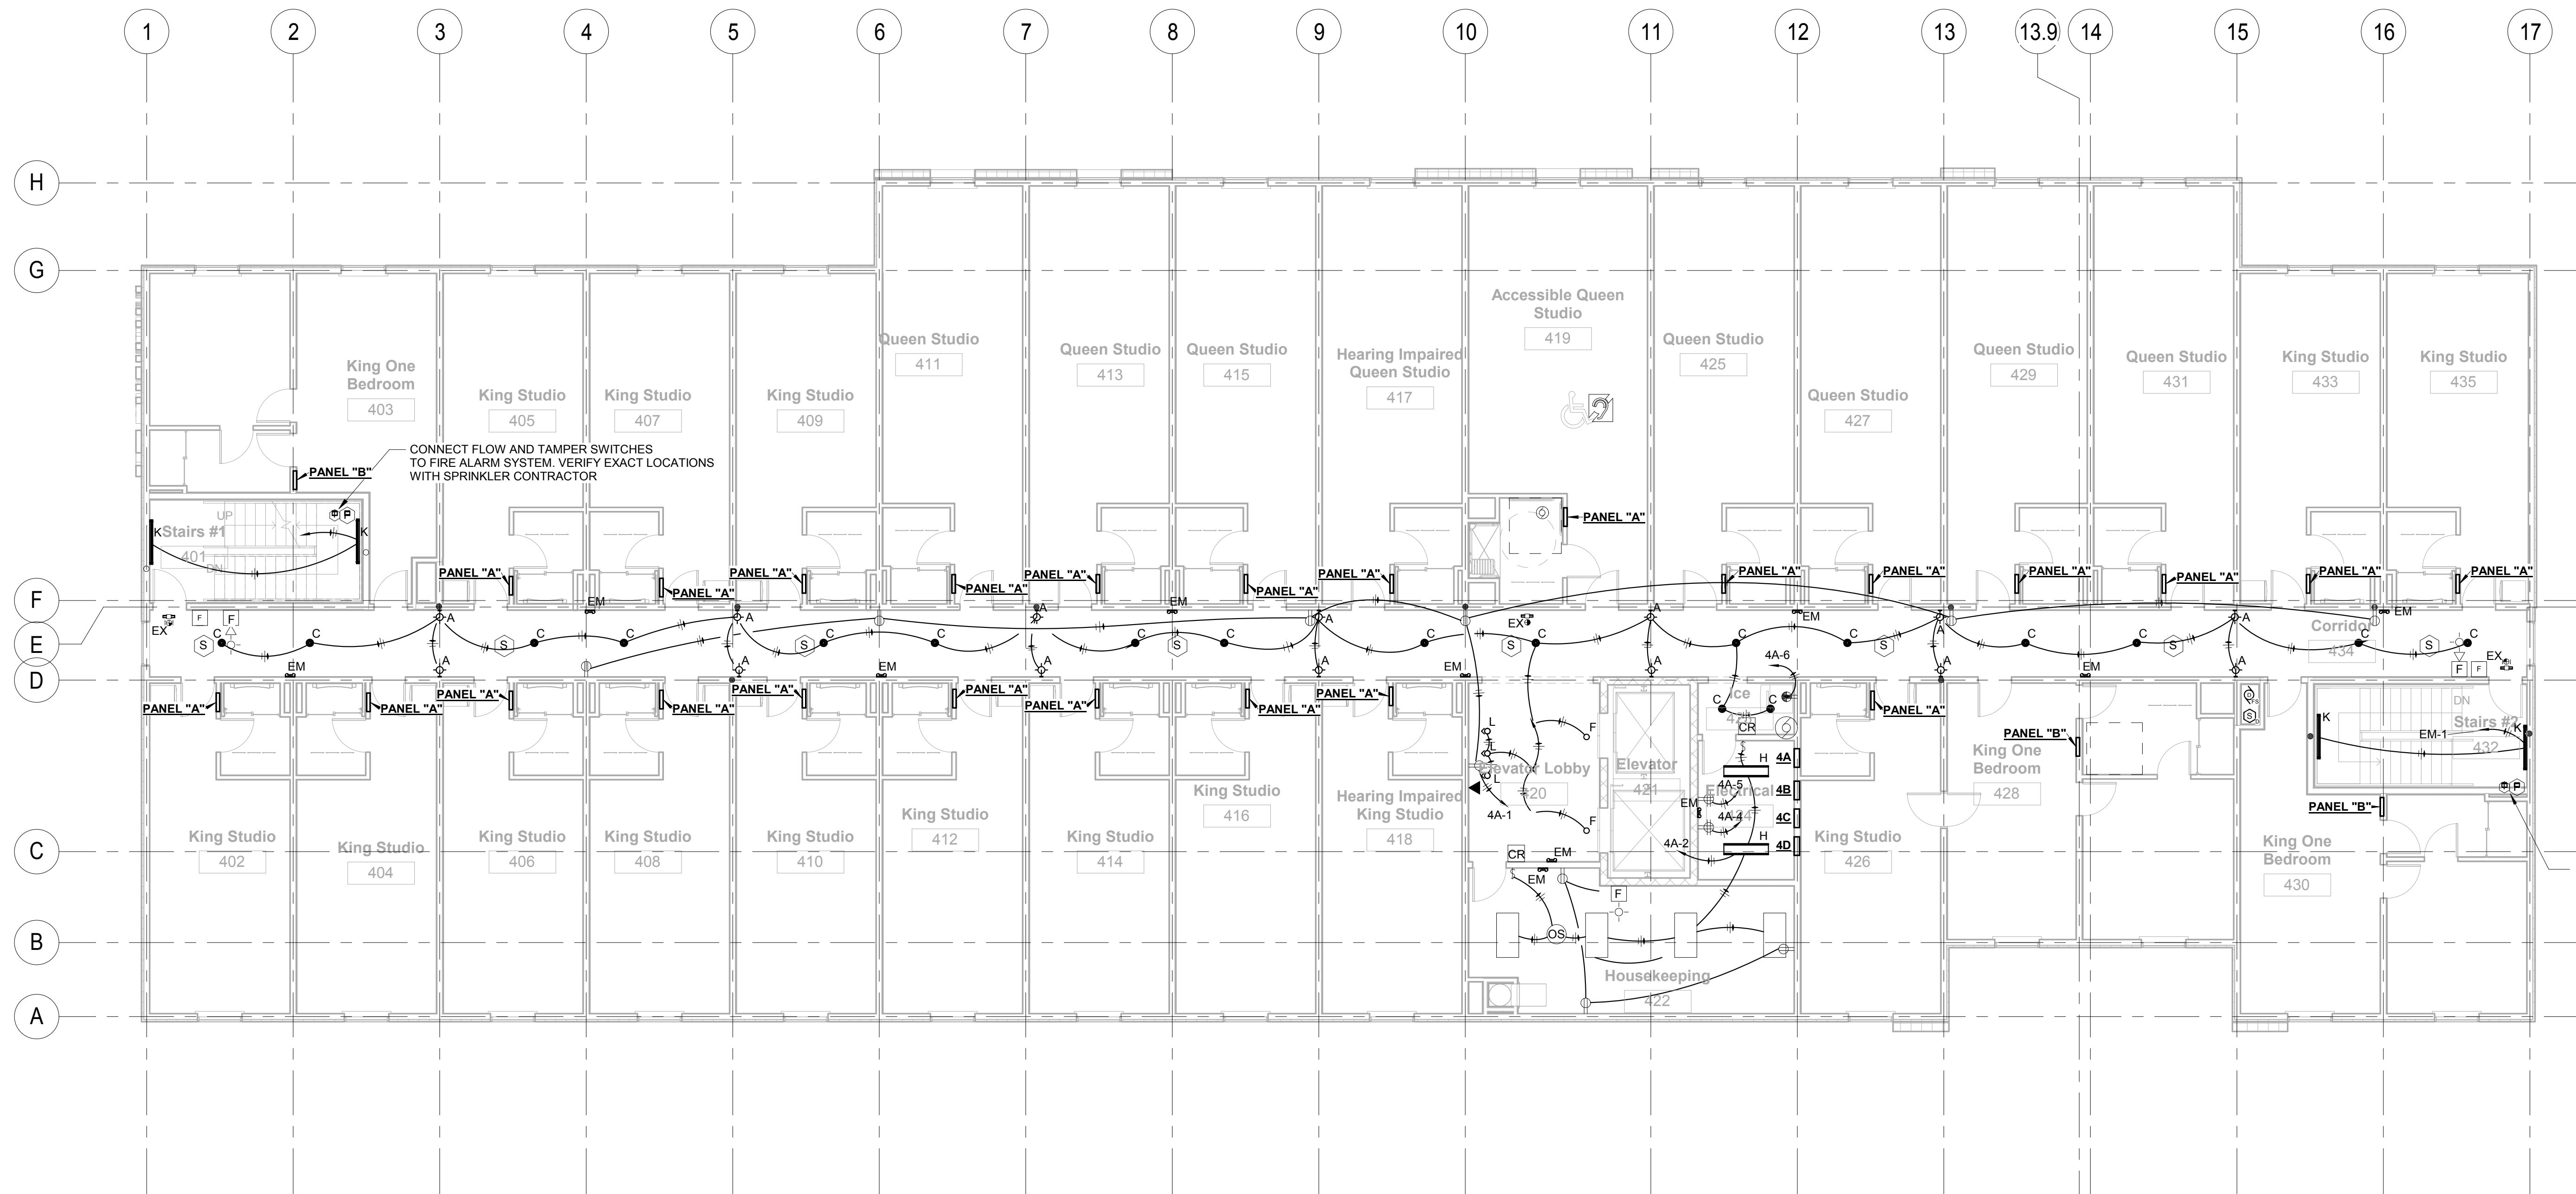


① FOURTH FLOOR PLAN
1/8" = 1'-0"

LIGHTNING PROTECTION SYSTEM:

THE CONTRACTOR SHALL FURNISH AND INSTALL ALL LABOR, MATERIALS, EQUIPMENT, AND SERVICES TO PROVIDE A COMPLETE LIGHTNING PROTECTION SYSTEM ON THIS BUILDING. THE SYSTEM SHALL INCLUDE ROOF MOUNTED AIR TERMINALS, INTERCONNECTING CONDUCTORS, DOWN CONDUCTORS TO GROUND,

APPROPRIATE GROUND TERMINALS, INTERCONNECTING CONDUCTORS, GROUNDED BUILDING SYSTEMS THAT WILL COMPLY WITH THE CURRENT EDITION OF THE NATIONAL FIRE PROTECTION ASSOCIATION LIGHTNING CODE NO. 78. A REPRESENTATIVE OF THE OWNER AND THE INSTALLING CONTRACTOR SHALL COMPLETE THE LIGHTNING PROTECTION INSTITUTE INSPECTION REPORT DURING CONSTRUCTION.

ANY COMPONENTS OR METHODS FOUND NOT IN COMPLIANCE WITH THIS SPECIFICATION SHALL BE REPAIRED OR REPLACED AT THE SATISFACTION OF THE OWNER'S REPRESENTATIVE BEFORE SUBMITTAL OF THE L.P.I. INSPECTION REPORT AND DELIVERY OF THE L.P.I. CERTIFIED SYSTEM LABEL.

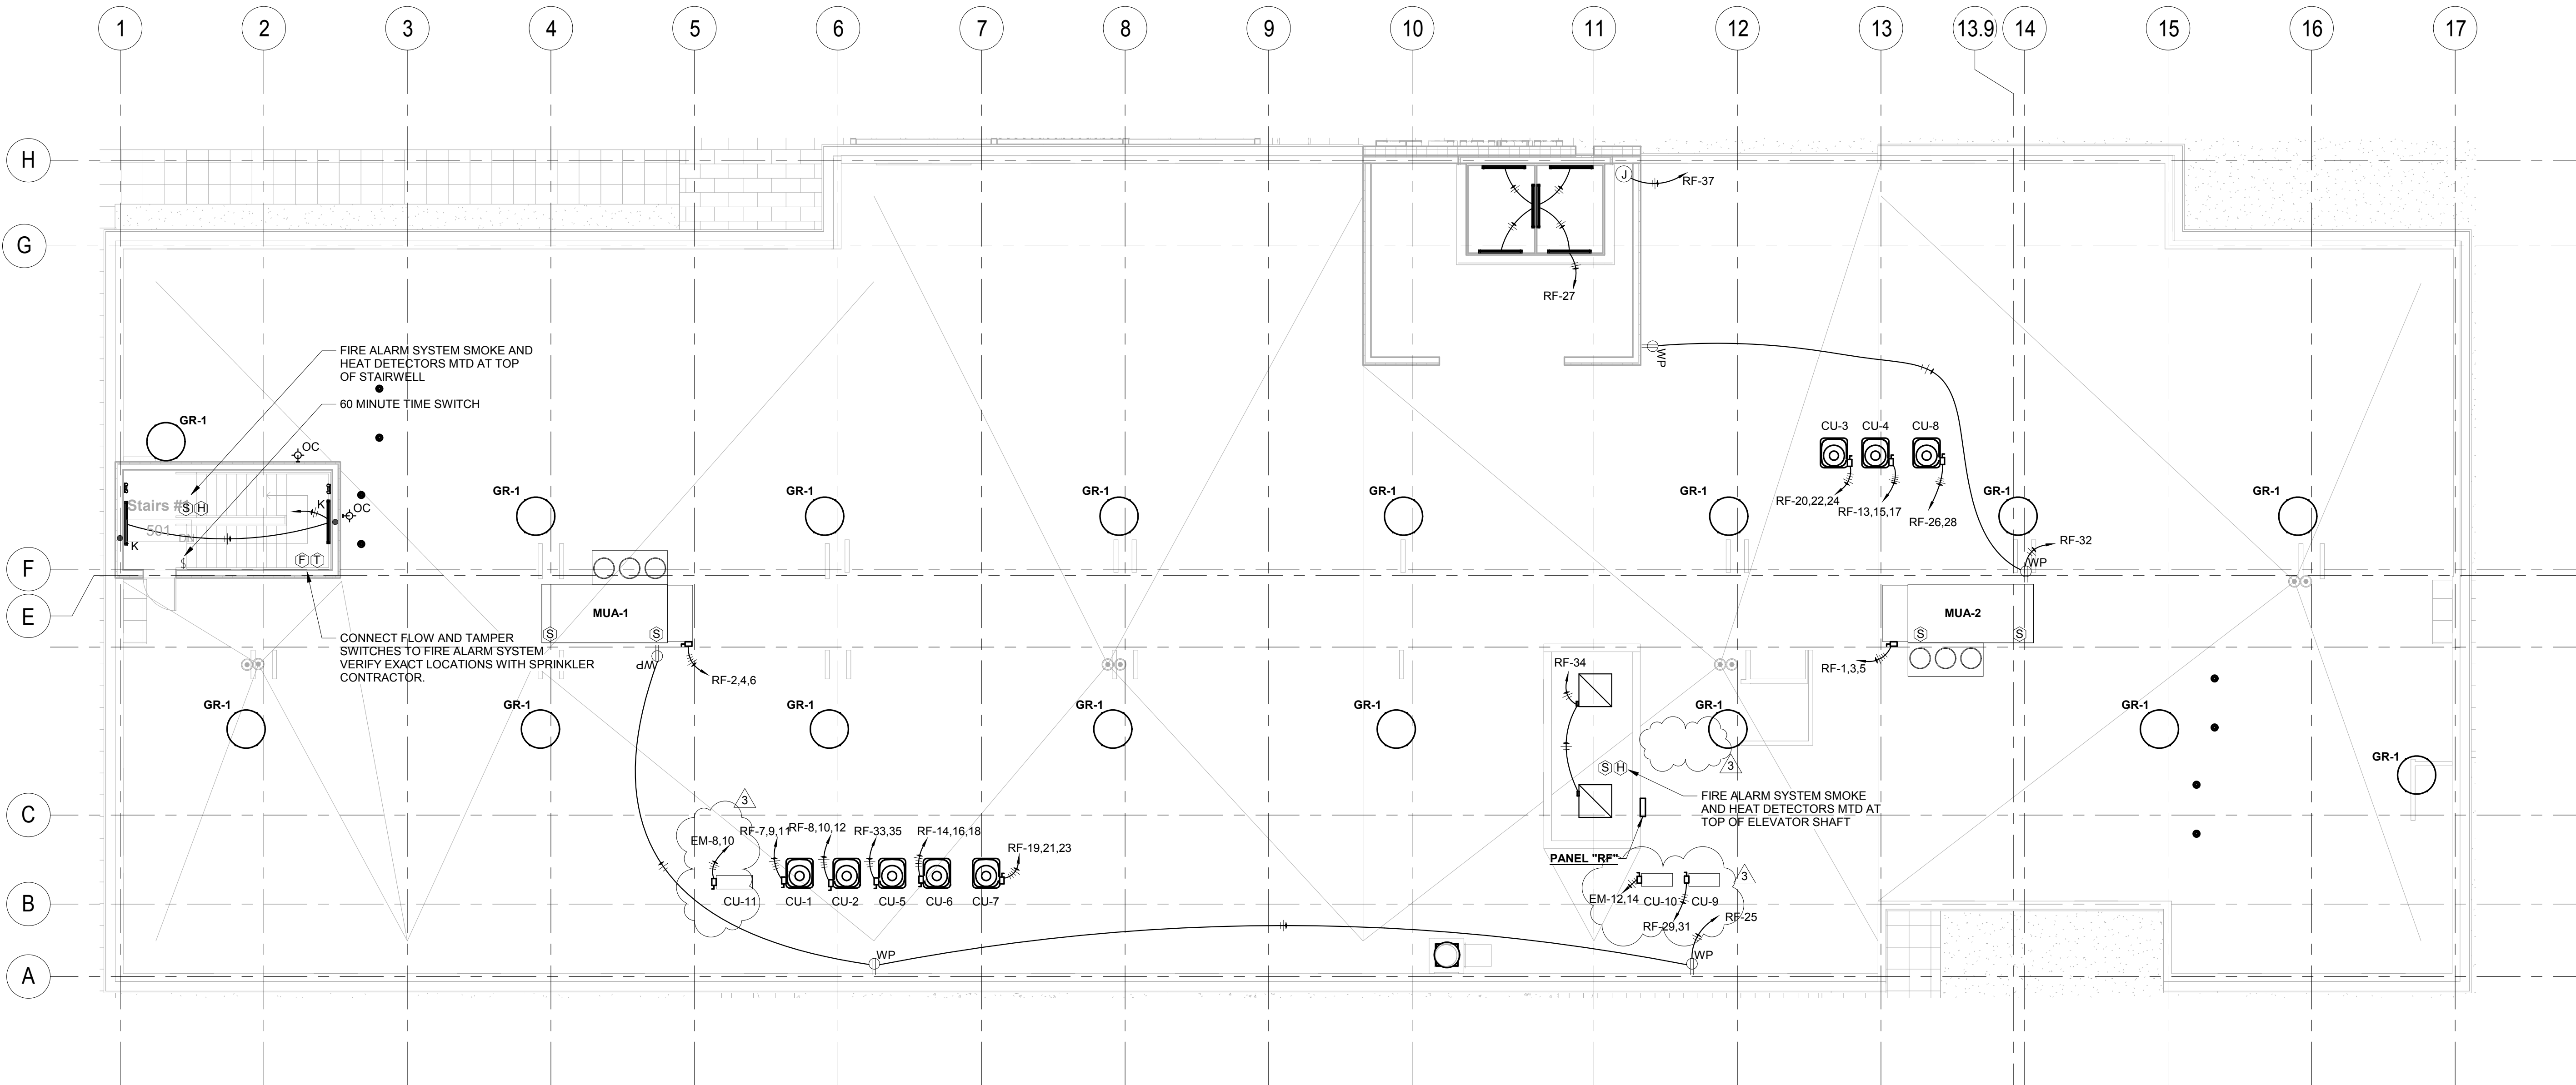

1. PROVIDE RECESSED J-BOX AND CONDUIT TO CEILING FOR THERMOSTATS AS REQUIRED BY MECHANICAL TRADES.
2. SEE PANELBOARD SCHEDULES FOR CIRCUIT NUMBER INFORMATION.
3. PROVIDE DISCONNECTS AS SHOWN IN SCHEDULE WITH FLEXIBLE CONNECTION TO VIBRATING EQUIPMENT. MOUNT DISCONNECT ADJACENT TO EQUIPMENT.
4. WHILE THE EQUIPMENT SHOWN IS BELIEVED TO BE ACCURATE, VERIFY WIRING AND OVERCURRENT PROTECTION REQUIREMENTS AS INDICATED BY NAMEPLATE ON ACTUAL EQUIPMENT INSTALLED. DO NOT CIRCUIT EQUIPMENT UNTIL VERIFICATION IS MADE, THEN CIRCUIT ACCORDINGLY. PROVIDE NEMA 3R DISCONNECTS FOR ALL OUTSIDE UNITS.

1 ROOF PLAN
1/8" = 1'-0"

REVISIONS		
No.	Date	Description
3	05/21/19	Added PBX

Information contained on this drawing and in all digital files associated is authorized for use on the project named herein only and is the property of MISHRA ARCHITECTURE PLLC and may not be reproduced in any manner without express written or verbal permission from authorized individuals. Original drawing is 24"x36" and scales are as indicated. 2011 MISHRA ARCHITECTURE PLLC



KEY PLAN

Pramukh Vicksburg, LLC

HOME2suites Vicksburg

Berryman Road
Vicksburg, MS 39180

Drawing Title
ELECTRICAL ROOF PLAN


Phase
Construction Documents

Project No.	19005	Sheet No.	E206
Prepared by	PTH		
Checked by	RJH		
Date	04/02/19		

Released for

REVISIONS		
No.	Date	Description
4	07/16/19	Code Response

Information contained on this drawing and in all digital files associated is authorized for use on the project named herein only and is the property of MISHRA ARCHITECTURE PLLC and may not be reproduced in any manner without express written or verbal permission from authorized individuals. Original drawing is 24"x36" and scales are as indicated. 2011 MISHRA ARCHITECTURE PLLC

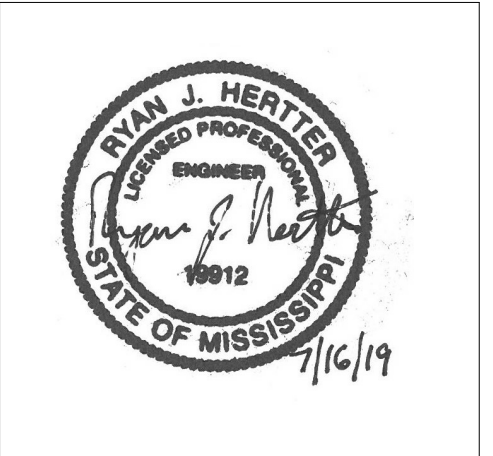

KEY PLAN

Pramukh Vicksburg, LLC

HOME2suites
Vicksburg


Berryman Road
Vicksburg, MS 39180

Drawing Title
ELECTRICAL TYPICAL
ROOM ENLARGED


Phase
Construction Documents

Project No.	19005	Sheet No.	E301
Prepared by	PTH		
Checked by	RJH		
Date	04/02/19		


Released for

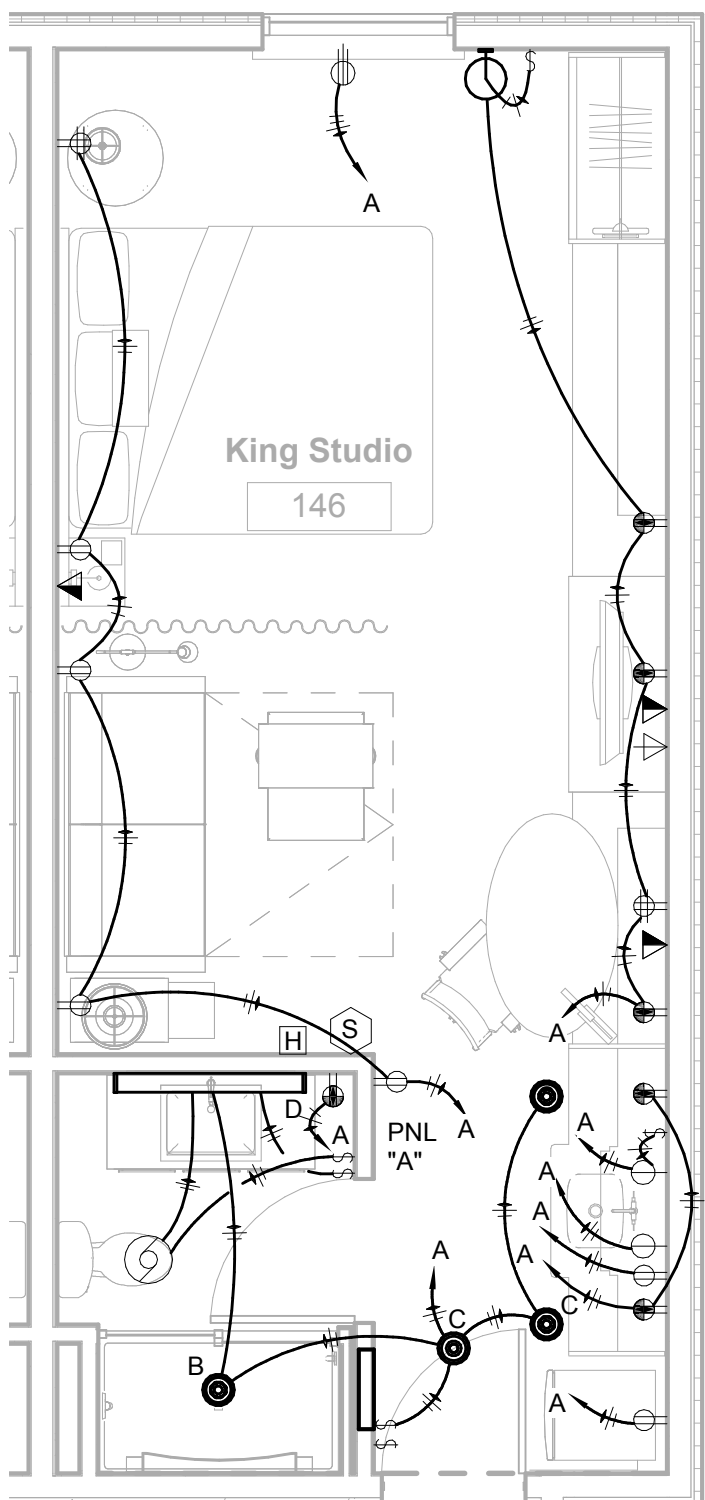


1 KING STUDIO
1/4" = 1'-0"

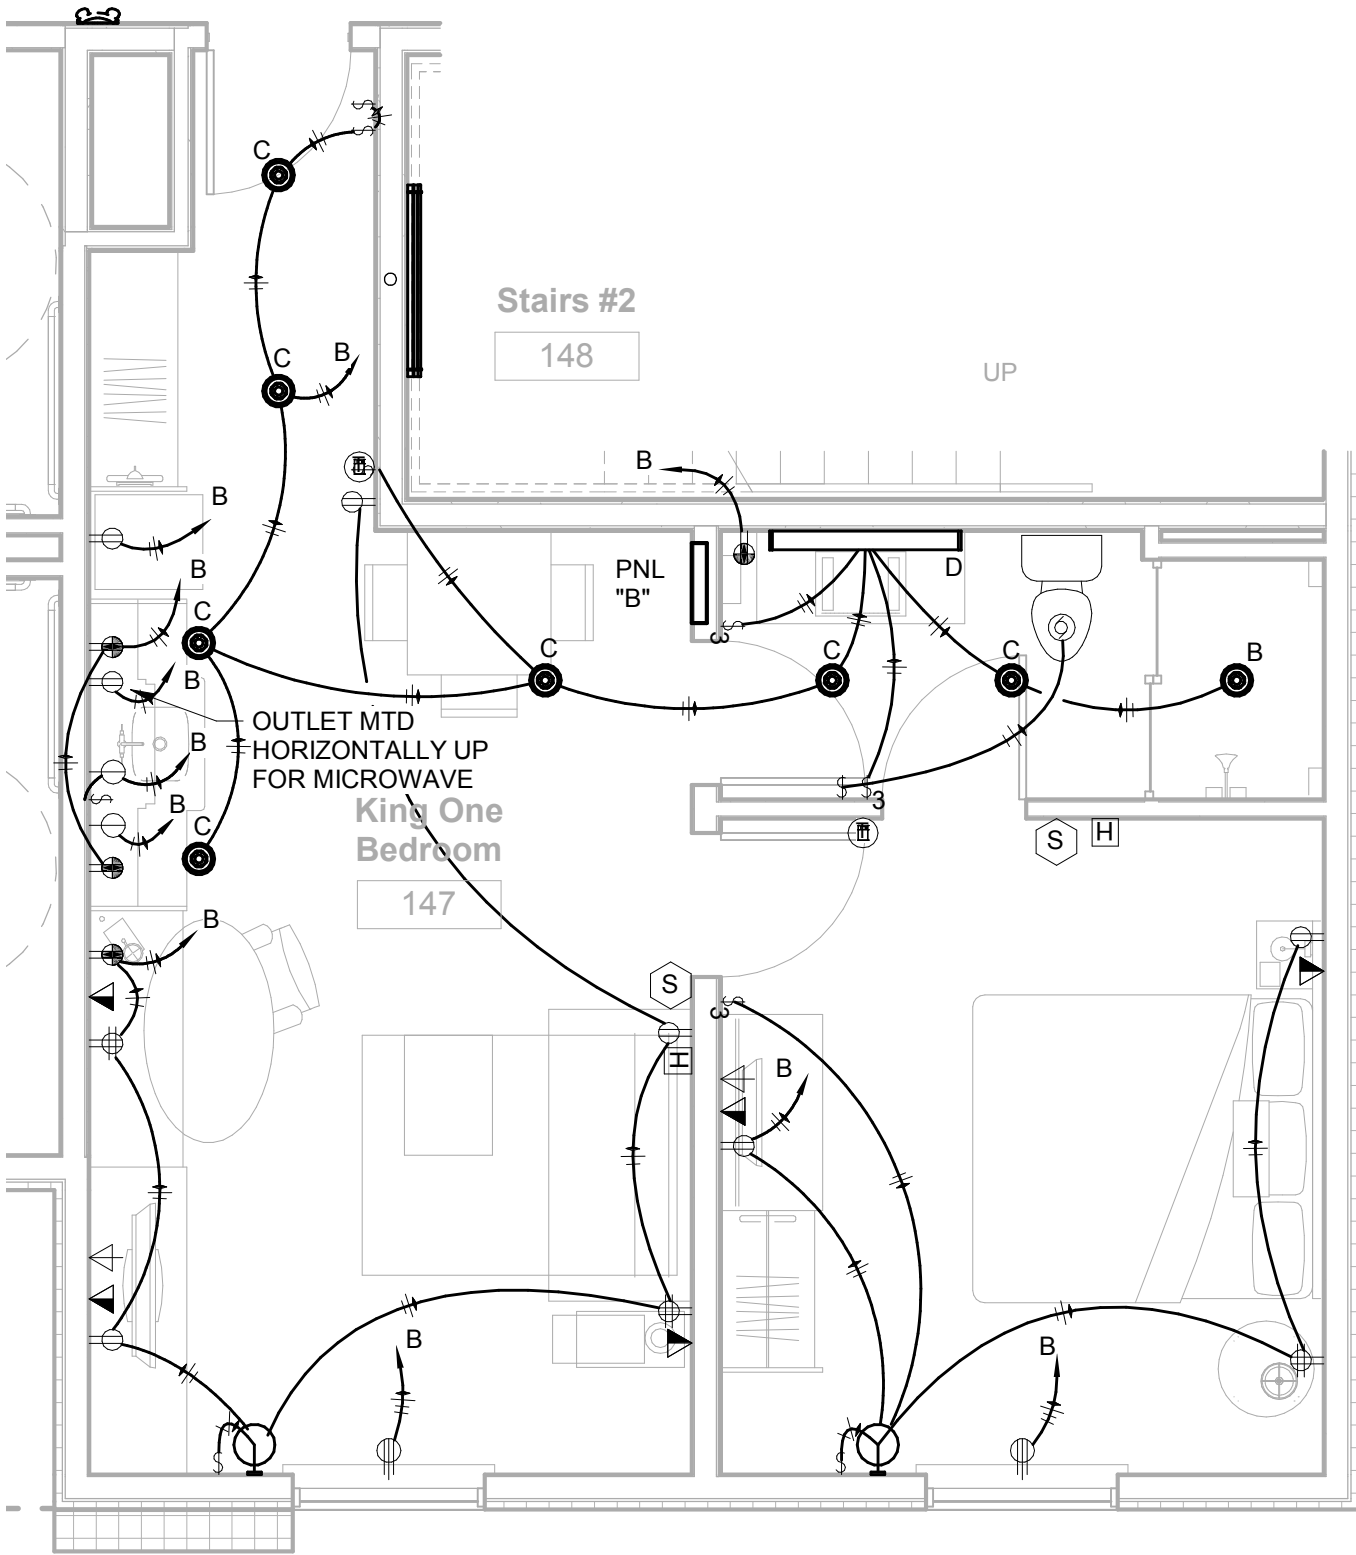


2 KING ONE BEDROOM
1/4" = 1'-0"

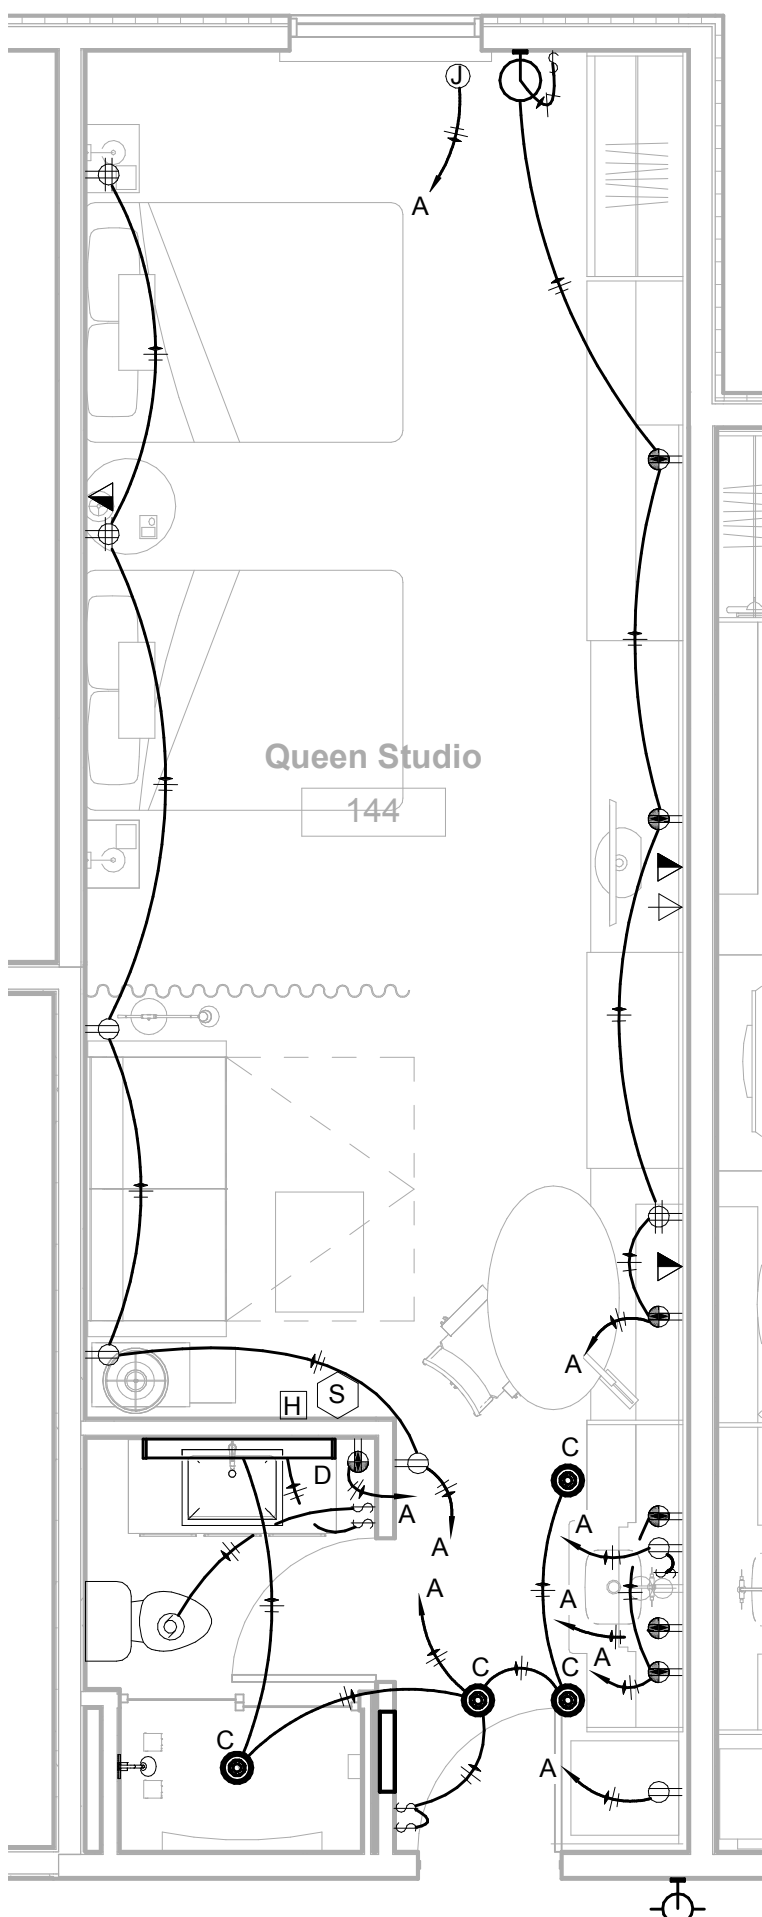


3 DOUBLE QUEEN STUDIO
1/4" = 1'-0"

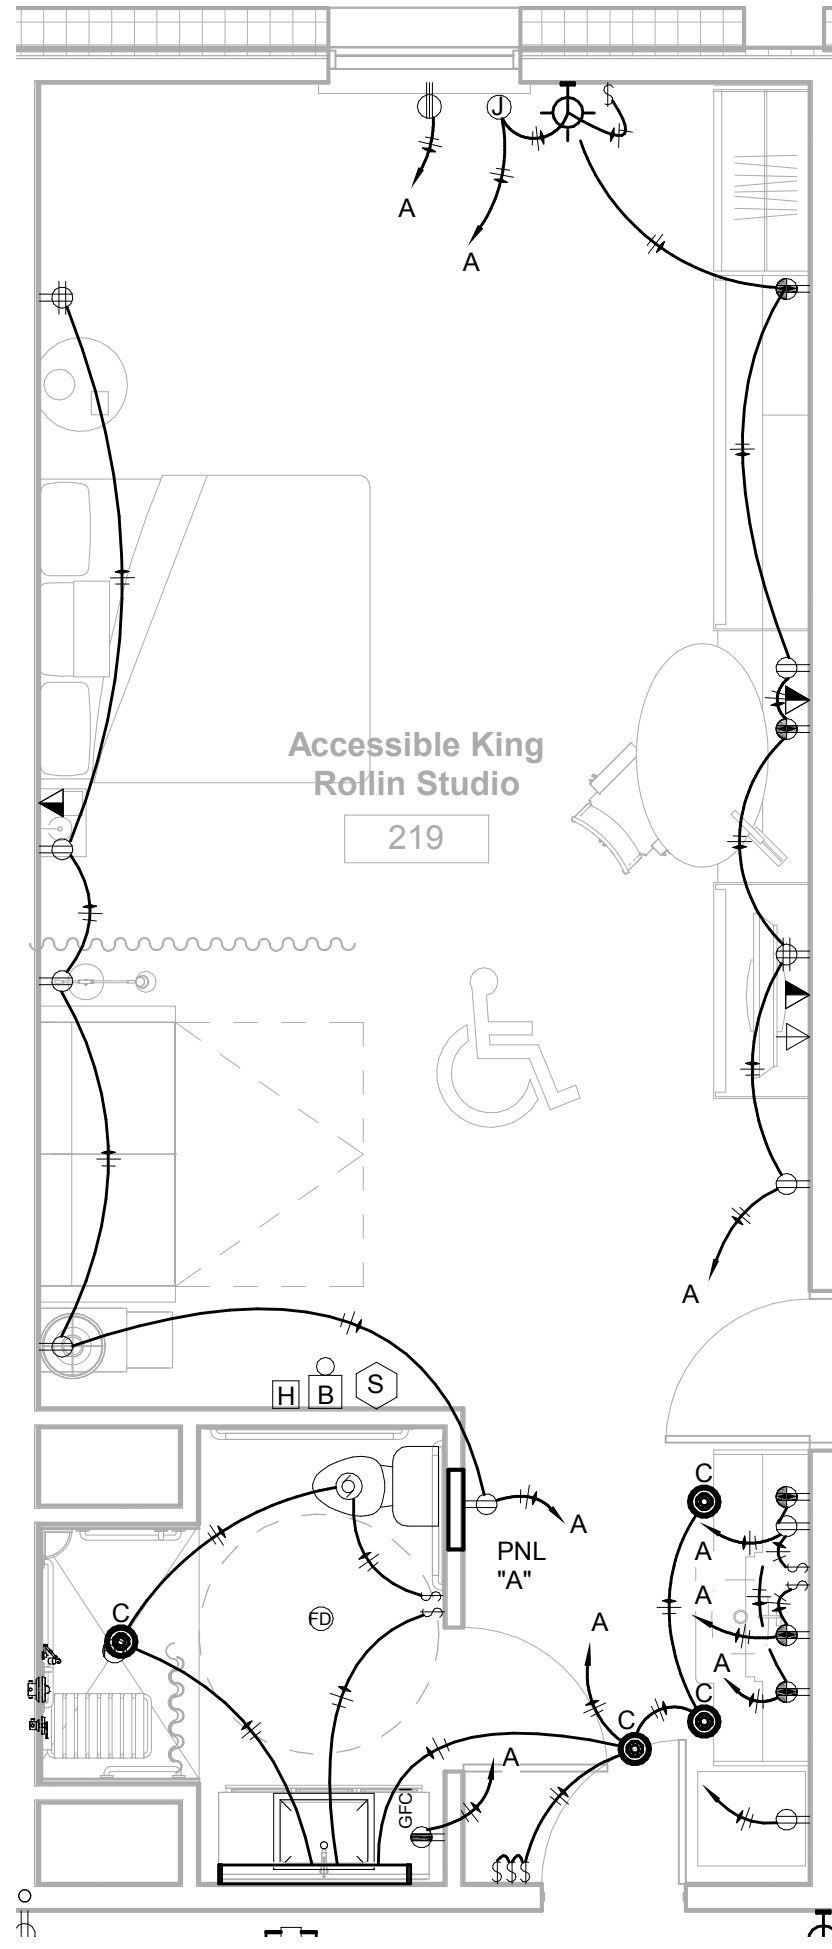


4 ACCESSIBLE KING ROLLIN STUDIO
1/4" = 1'-0"

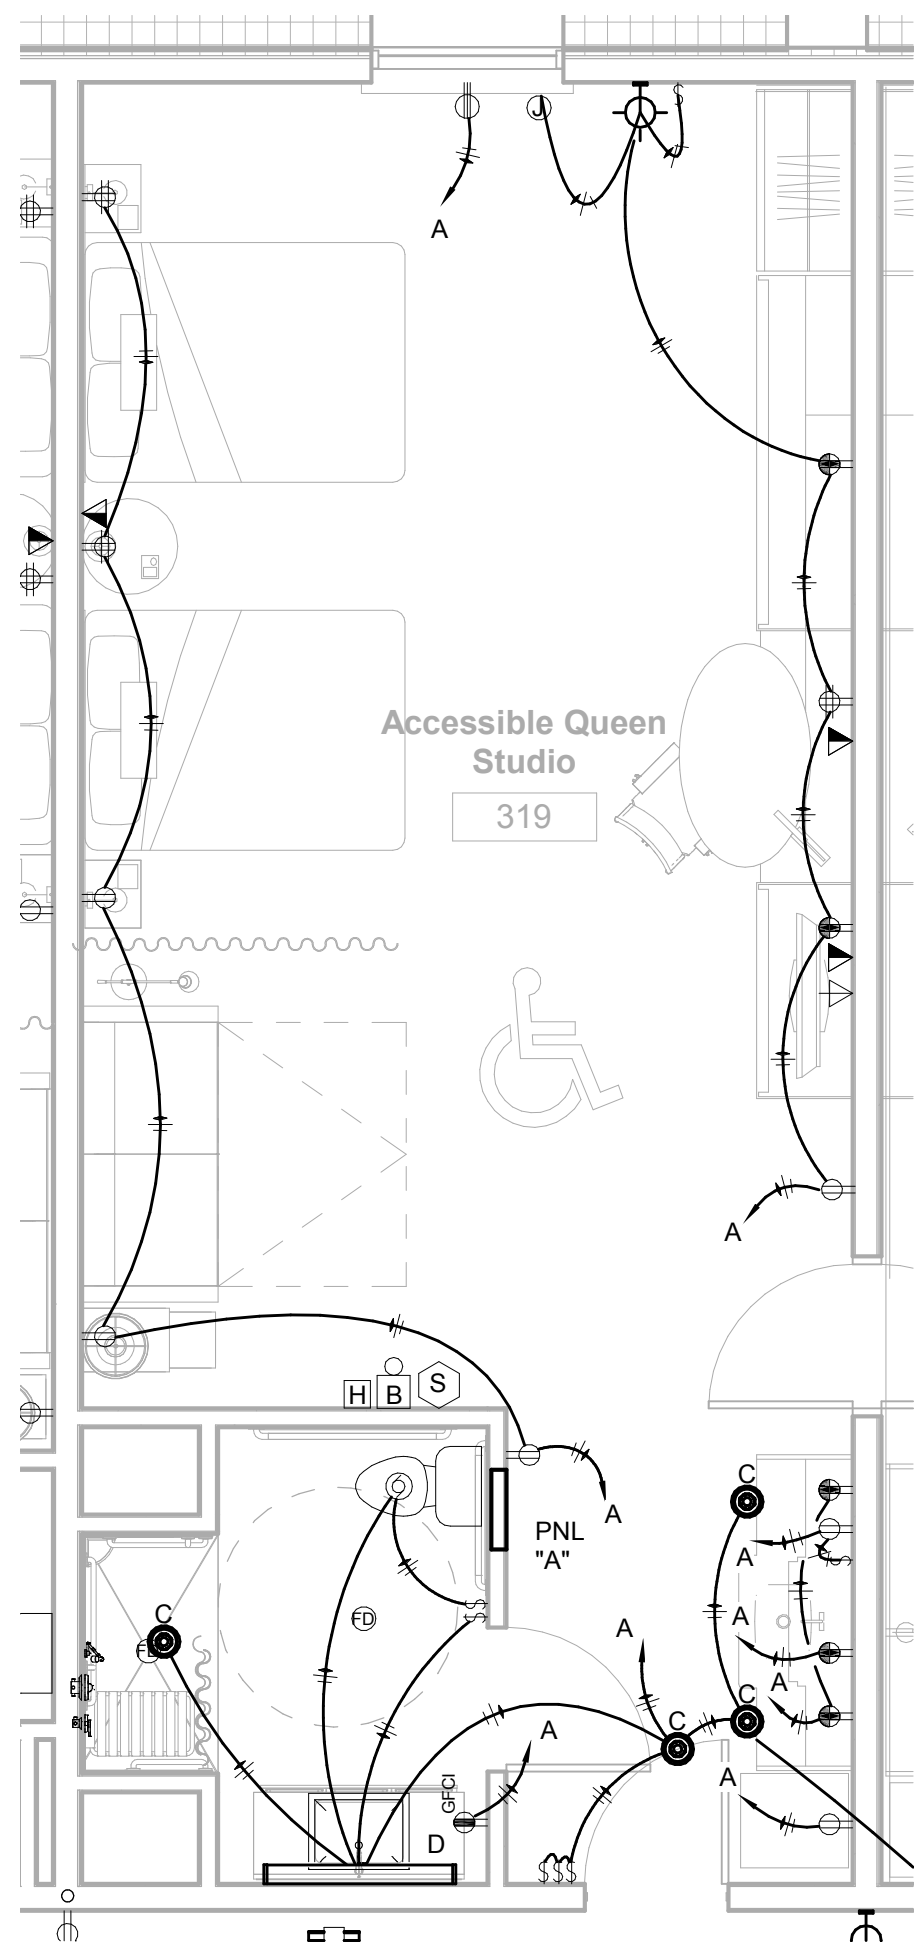


5 ACCESSIBLE QUEEN STUDIO
1/4" = 1'-0"

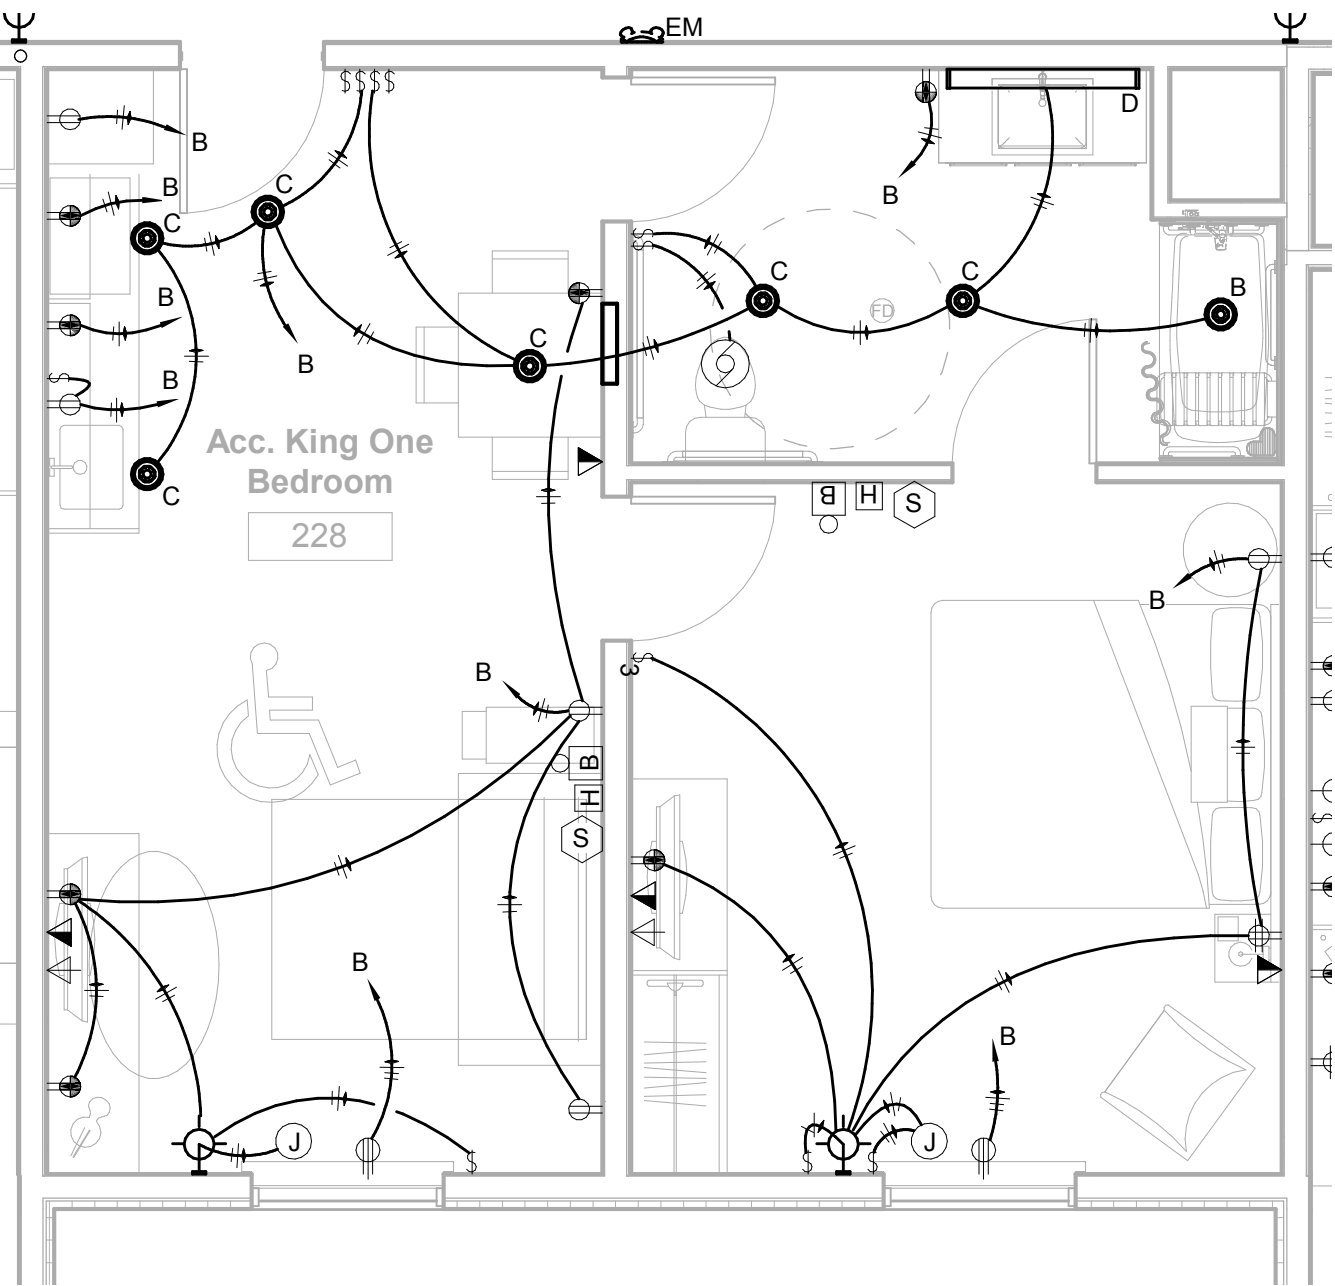


6 ACCESSIBLE KING ONE BEDROOM
1/4" = 1'-0"

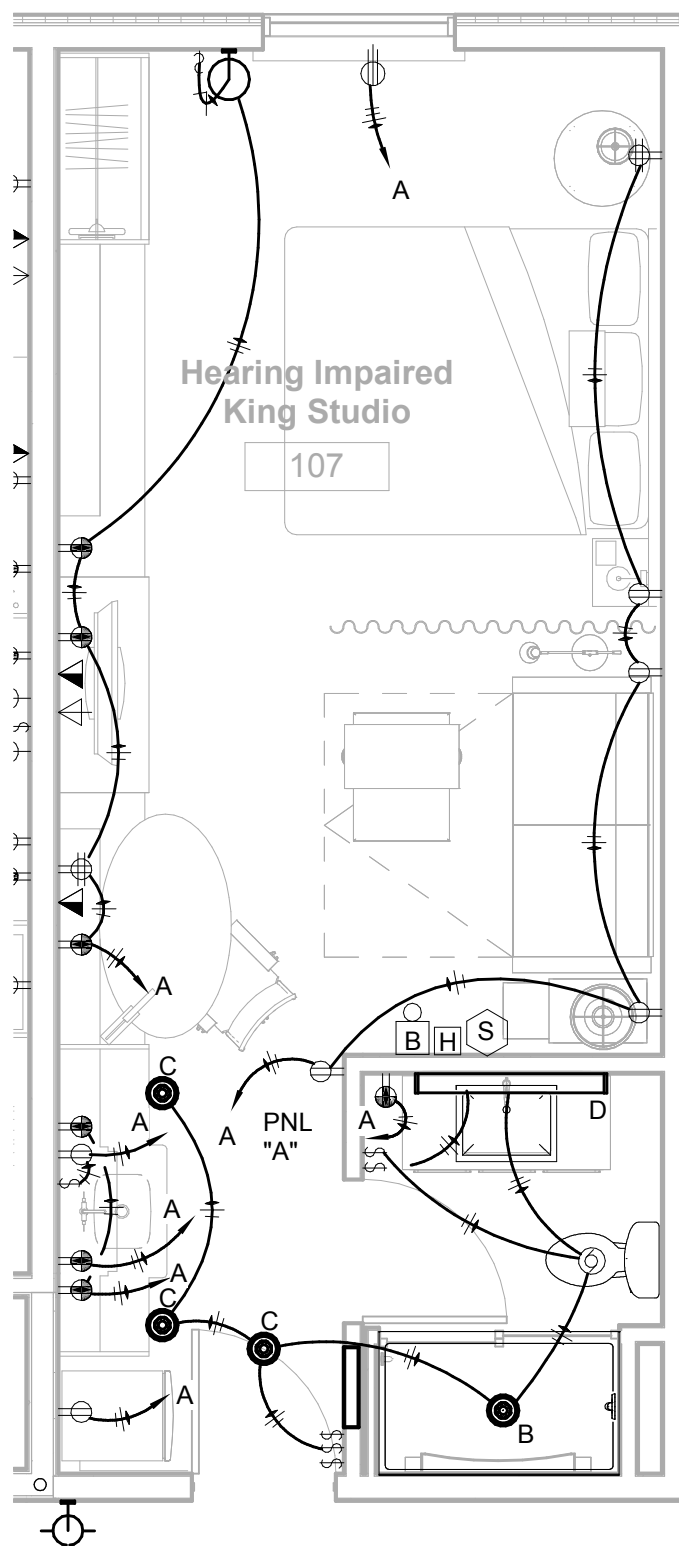

7 HEARING IMPAIRED KING STUDIO
1/4" = 1'-0"

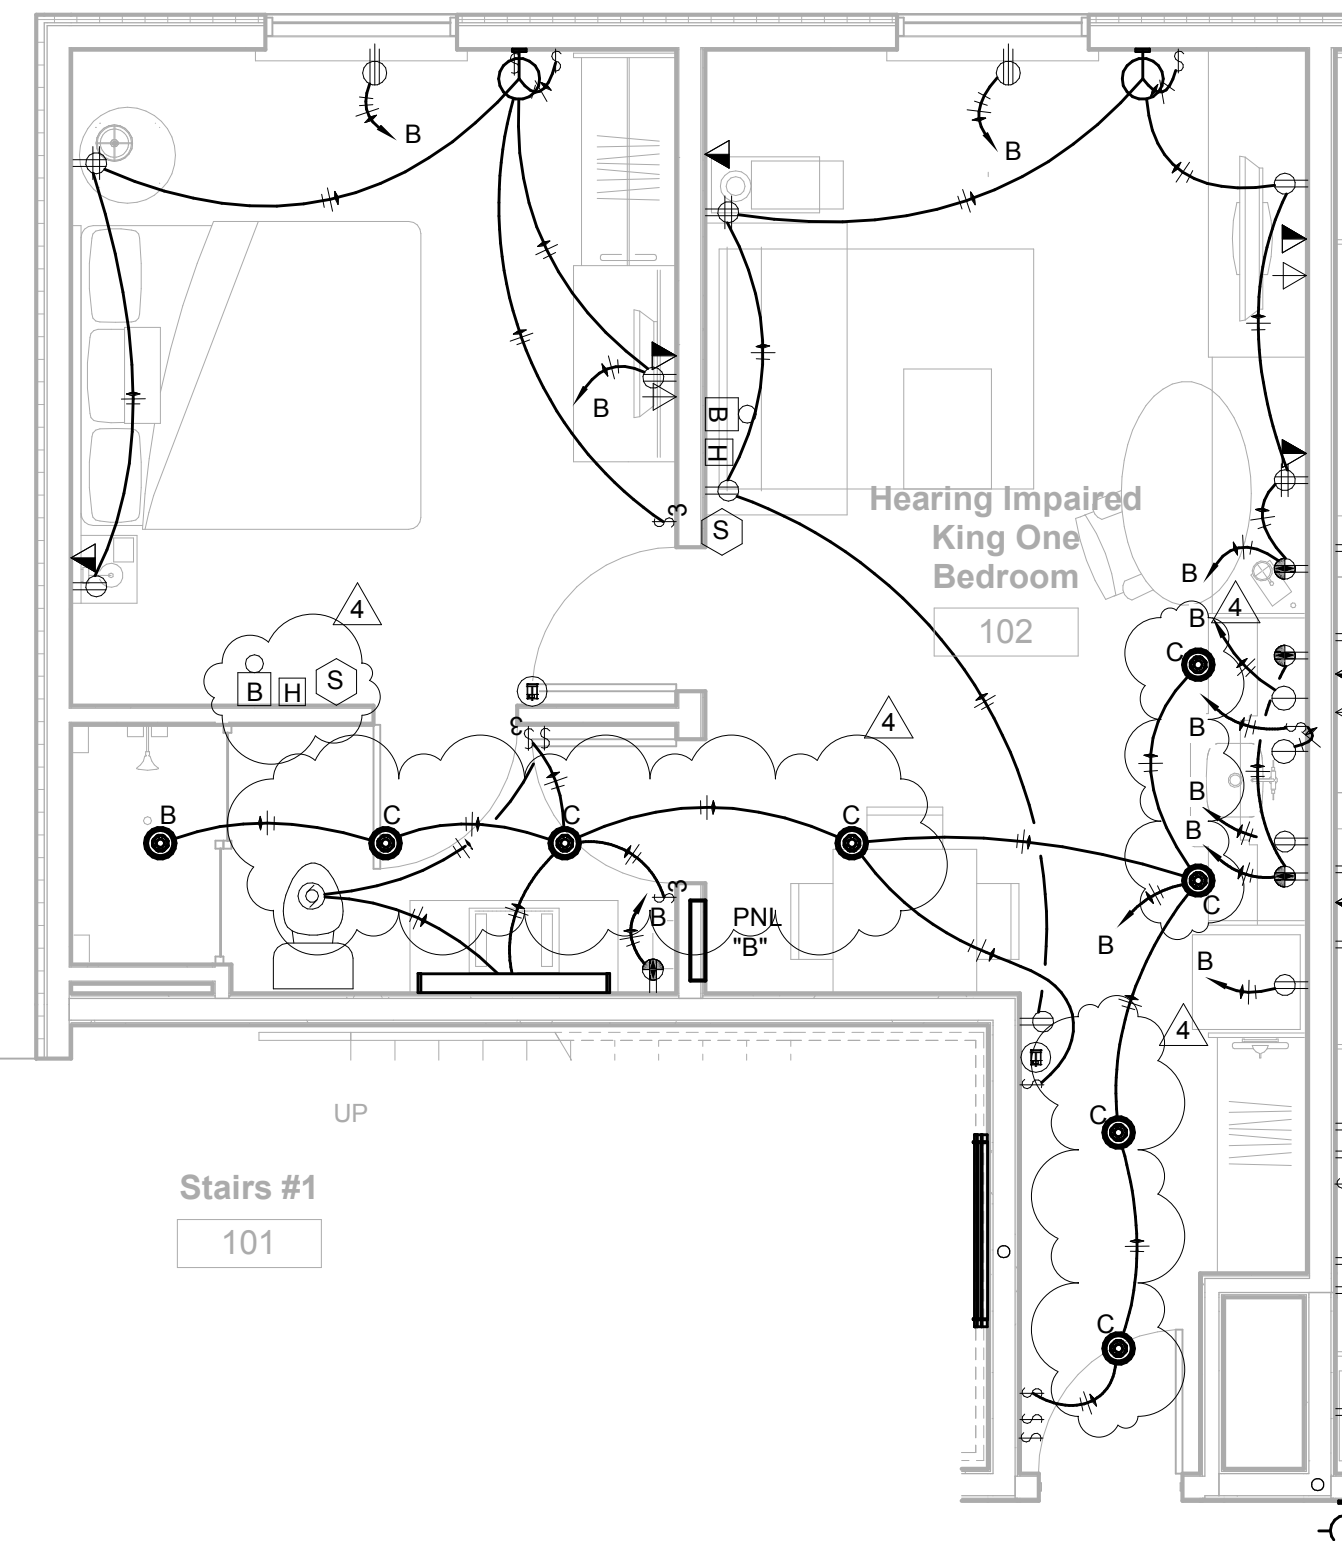

8 HEARING IMPAIRED KING ONE
BEDROOM (HI)
1/4" = 1'-0"

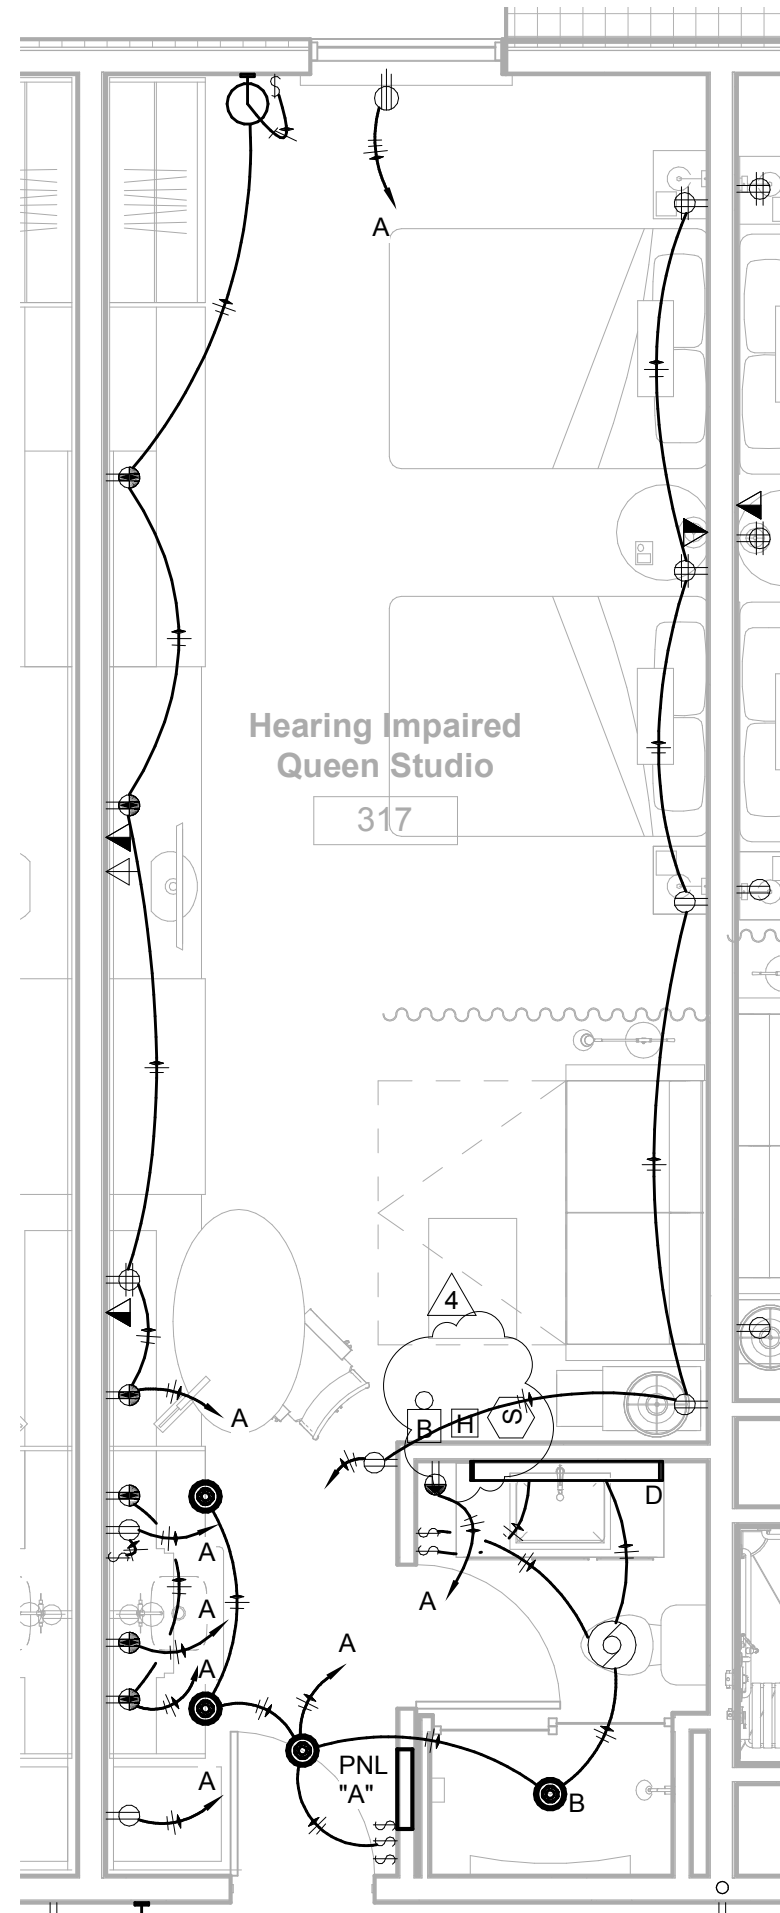


9 HEARING IMPAIRED QUEEN STUDIO
1/4" = 1'-0"

STRUCTURAL:
Whisonant Engineering Services, LLC
122 Nut Tree Court
Lexington, SC 29074
Phone: (803) 957-4008
Email: bill@weslex.com

MEP:
Innovative Engineering Services, LLC
2787 Stage Center DR., Suite 101
Bartlett, TN 38134
Phone: (901) 379-0500
Email: rhertter@innovativees-llc.com

Information contained on this drawing and in all digital files associated is authorized for use on the project named herein only and is the property of MISHRA ARCHITECTURE PLLC and may not be reproduced in any manner without express written or verbal permission from authorized individuals. Original drawing is 24"x36" and scales are as indicated.⁹
2011 MISHRA ARCHITECTURE PLLC

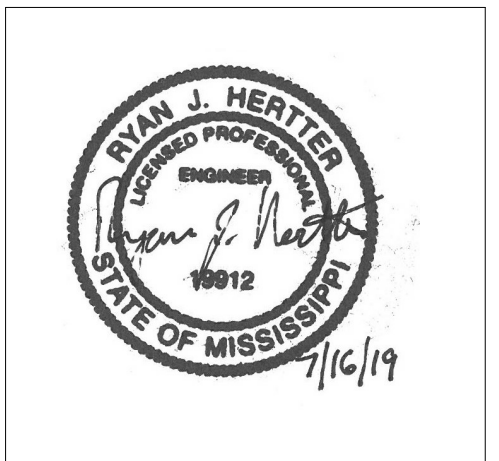

KEY PLAN

Pramukh Vicksburg.
LLC

HOME2suites
Vicksburg

Berryman Road
Vicksburg, MS 39180


Drawing Title

ELECTRICAL TYPICAL
ROOM ENLARGED


Phase
Construction Documents

Project No.	19005	Sheet No. E302
Prepared by	PTH	
Checked by	RJH	
Date	04/02/19	


Released for

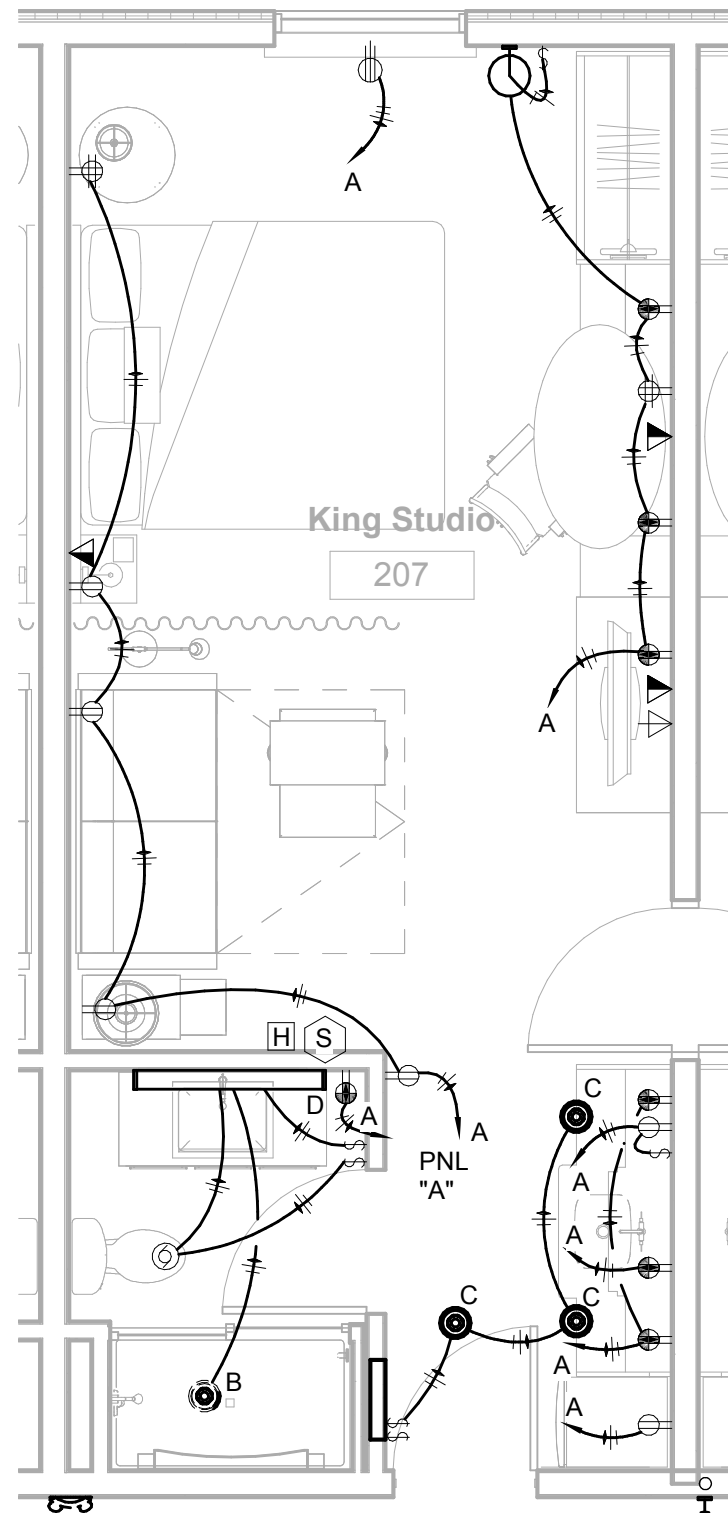

① KING STUDIO CONNECTING
1/4" = 1'-0"

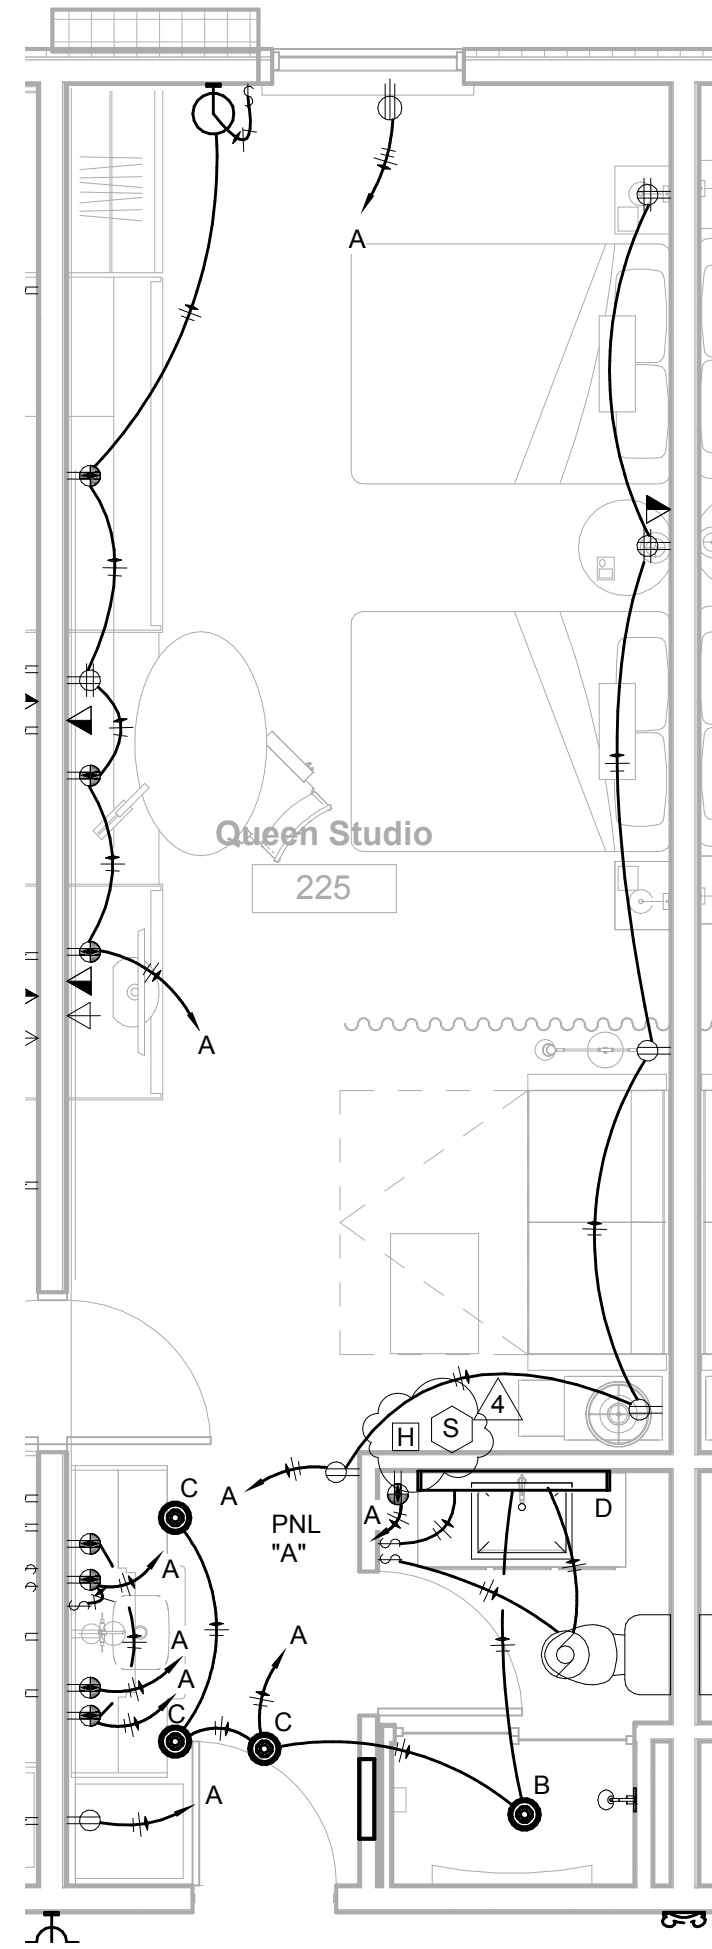

② QUEEN STUDIO CONNECTOR
1/4" = 1'-0"

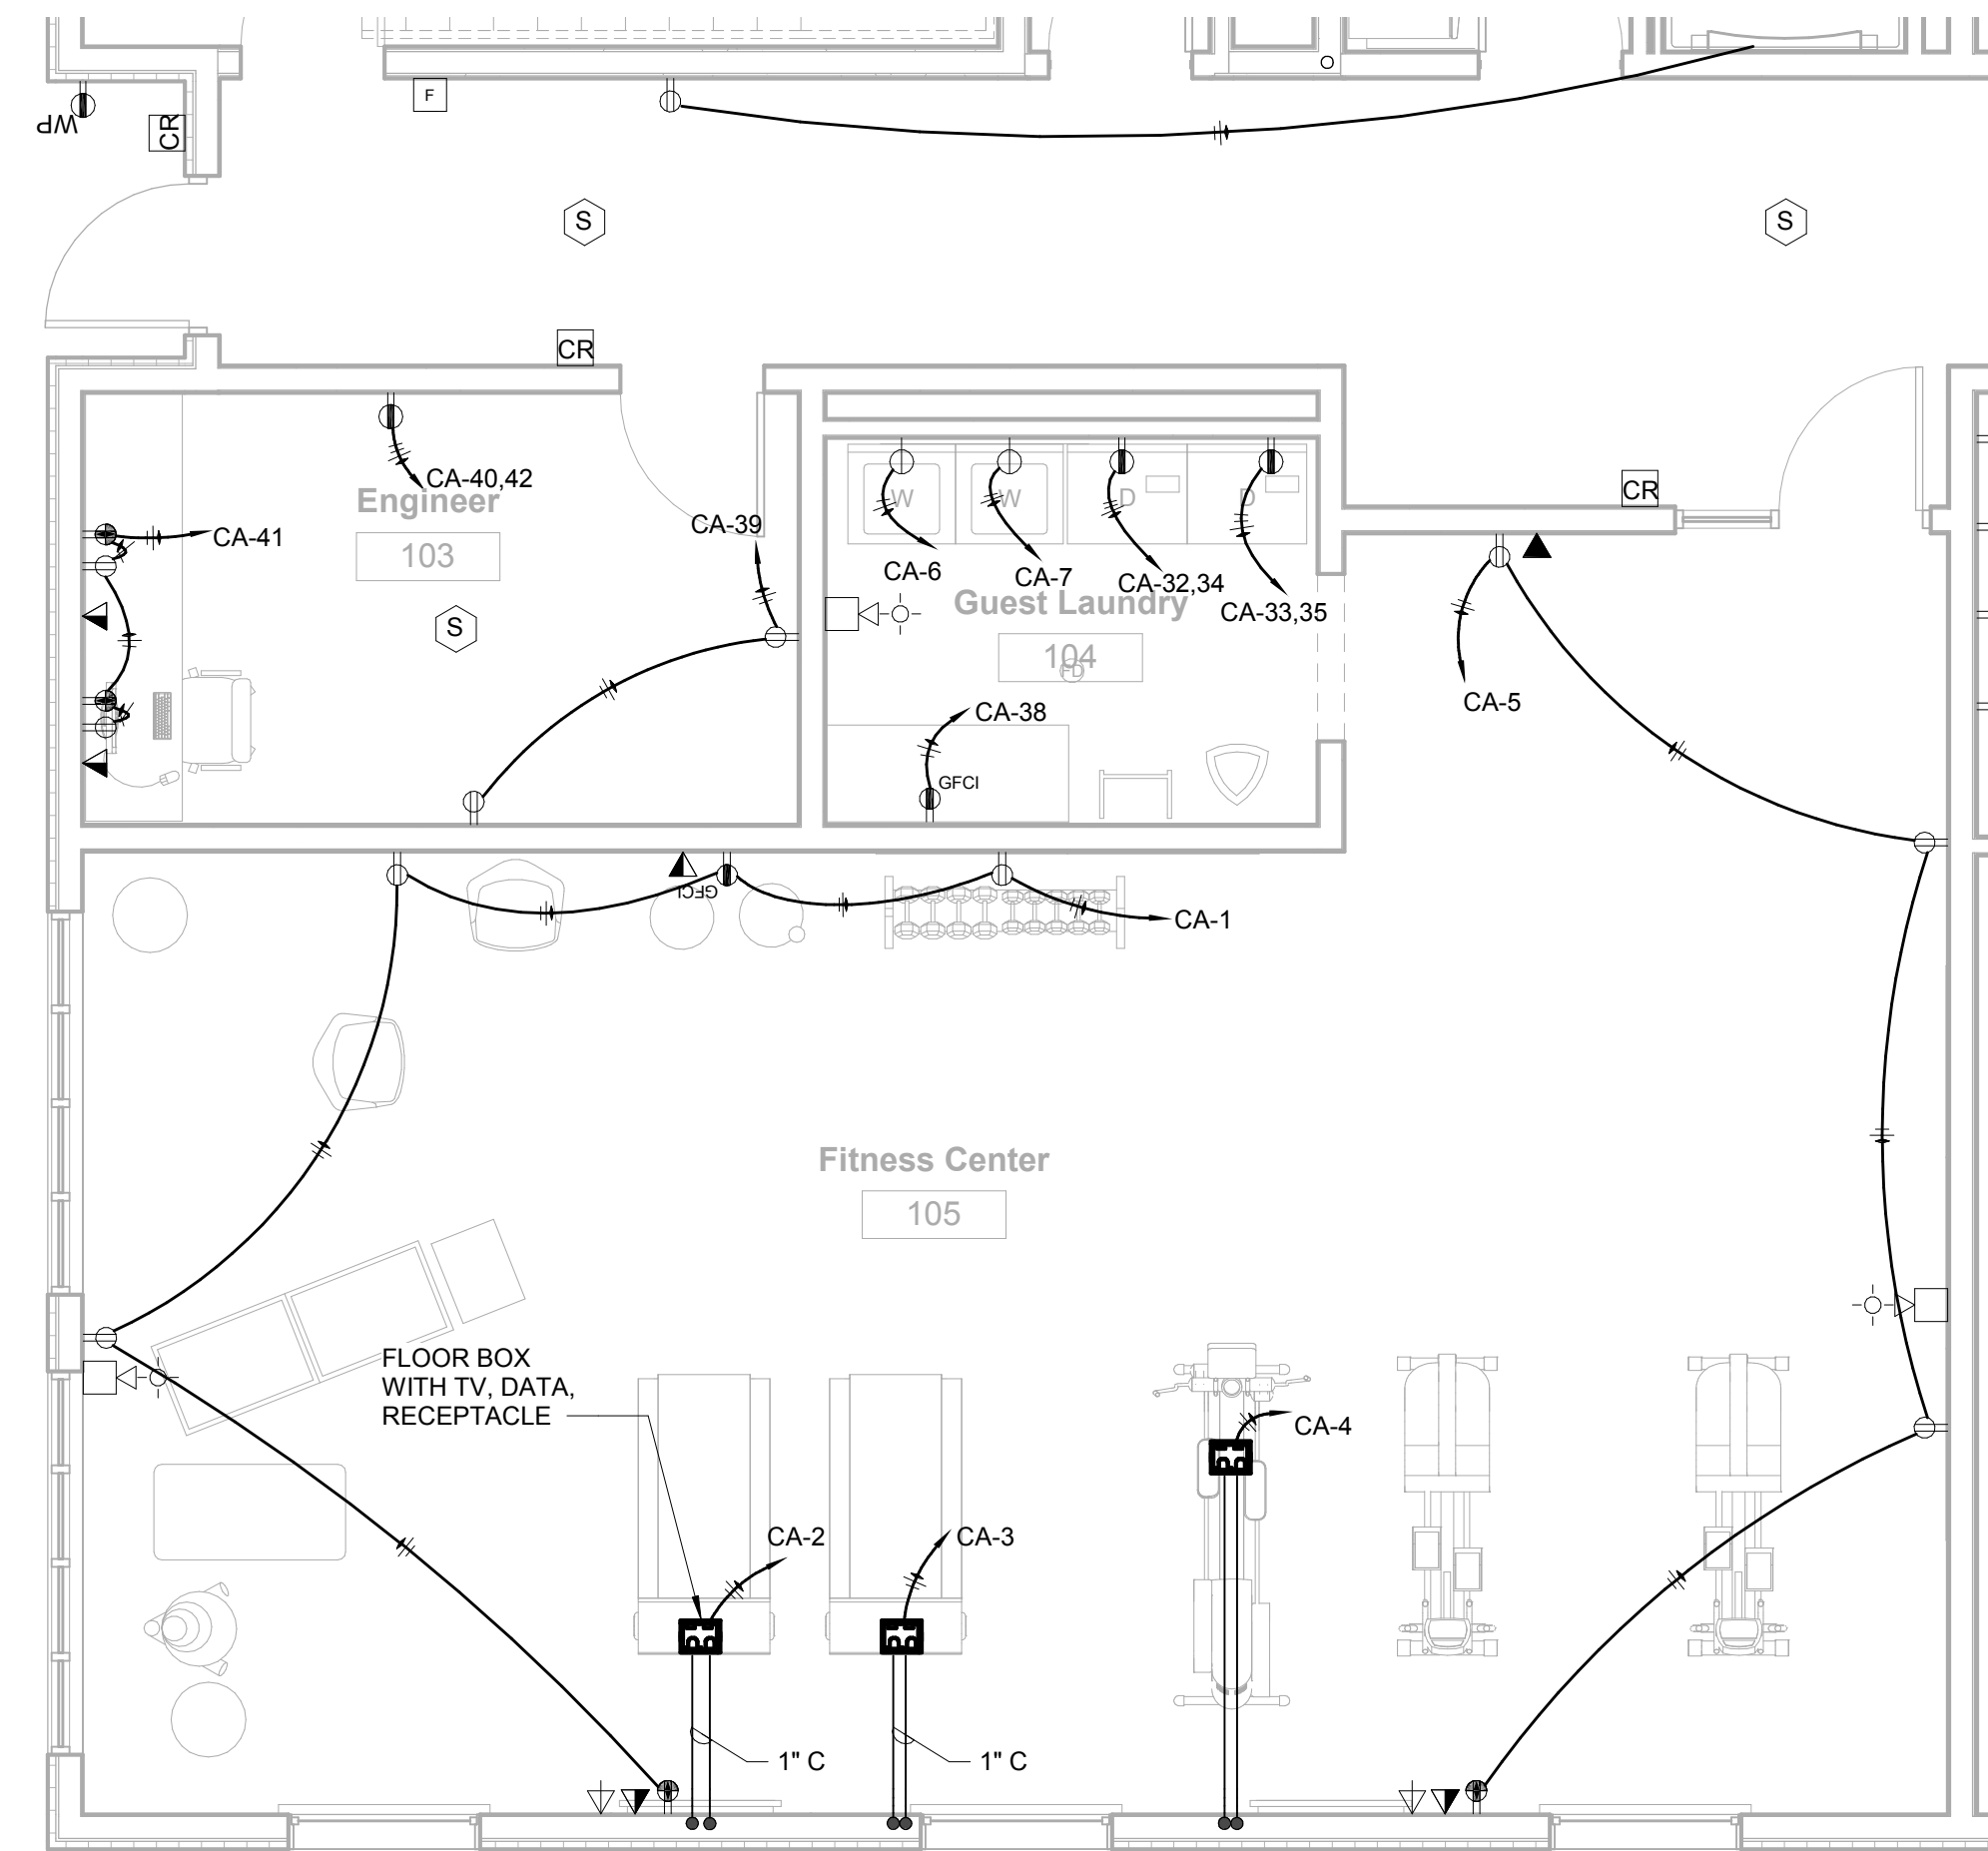

3 FITNESS CENTER & GUEST LAUNDRY
1/4" = 1'-0"



Information contained on this drawing and in all digital files associated is authorized for use on the project named herein only and is the property of MISHRA ARCHITECTURE PLLC and may not be reproduced in any manner without express written or verbal permission from authorizing individuals. Original drawing is 24"x36" and scales are as indicated.
2011 MISHRA ARCHITECTURE PLLC

A circular professional engineer seal for Ryan J. Hertter, State of Mississippi. The seal contains the text: RYAN J. HERTTER, LICENSED PROFESSIONAL ENGINEER, 19912, and STATE OF MISSISSIPPI. A handwritten signature "Ryan J. Hertter" is written across the seal. To the right of the seal, the date "4/2/19" is handwritten.


Pramukh Vicksburg.
LLC

Berryman Road
Vicksburg, MS 39180

ELECTRICAL - ONE LINE DIAGRAM

Released for

E401

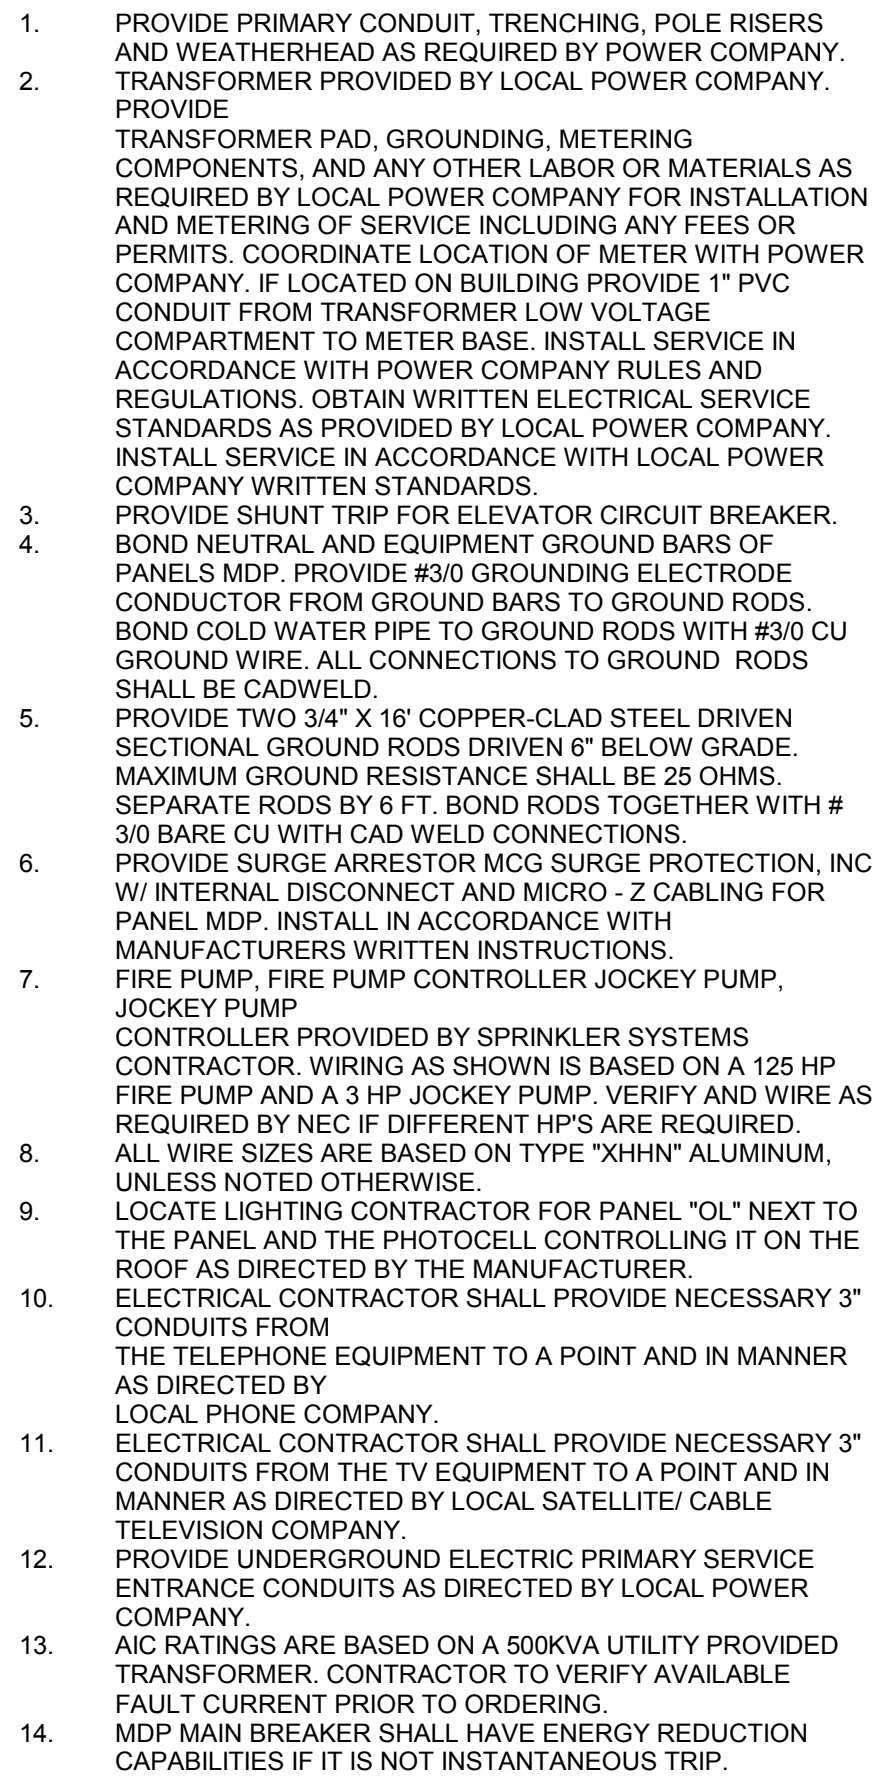

1 RISER AND ONE - LINE DIAGRAMS
N.T.S.

Branch Panel: CA 2

Location: Electrical 139

Supply From: MDP

Mounting: Surface

Enclosure: Type 1

Volts: 120/208 Wye

Phases: 3

Wires: 4

A.I.C. Rating: 22K

Mains Type: MLO

Mains Rating: 250 A

MCB Rating: 225 A

Notes:

CKT	Circuit Description	Trip	Poles	A		B		C		Poles	Trip	Circuit Description	CKT
CA-1	Receptacle	20 A	1	900 VA	0 VA					1	20 A	Other	CA-2
CA-3	Other	20 A	1			0 VA	0 VA			1	20 A	Other	CA-4
CA-5	Receptacle	20 A	1					720 VA	180 VA	1	20 A	Receptacle	CA-6
CA-7	Receptacle	20 A	1	180 VA	1800...					1	20 A	EWB Stairs #1	CA-8
CA-9	Receptacle	20 A	1			180 VA	180 VA			1	20 A	Receptacle	CA-10
CA-11	Receptacle	20 A	1					1080...	360 VA	1	20 A	Receptacle - Exterior	CA-12
CA-13	Receptacle	20 A	1	1080...	900 VA					1	20 A	Receptacle	CA-14
CA-15	Receptacle	20 A	1			900 VA	1080...			1	20 A	Receptacle	CA-16
CA-17	Receptacle	20 A	1					1080...	720 VA	1	20 A	Receptacle	CA-18
CA-19	Receptacle	20 A	1	720 VA	720 VA					1	20 A	Receptacle	CA-20
CA-21	Receptacle	20 A	1			720 VA	500 VA			1	20 A	Power	CA-22
CA-23	Power	20 A	1					500 VA	540 VA	1	20 A	Receptacle	CA-24
CA-25	Receptacle	20 A	1	900 VA	360 VA					1	20 A	Receptacle	CA-26
CA-27	Receptacle	20 A	1			180 VA	900 VA			1	20 A	Receptacle	CA-28
CA-29	Receptacle	20 A	1					180 VA	180 VA	1	20 A	Receptacle	CA-30
CA-31	Other	20 A	1	0 VA	2500...					2	20 A	Receptacle	CA-32
CA-33	Receptacle	20 A	2			2500...	2500...						CA-34
CA-35								2500...					CA-36
CA-37					180 VA					1	20 A	Receptacle	CA-38
CA-39	Receptacle	20 A	1			360 VA	2500...			2	20 A	Receptacle	CA-40
CA-41	Receptacle	20 A	1					720 VA	2500...				CA-42
Total Load:				10240 VA		12500 VA		11260 VA					
Total Amps:				85 A		105 A		95 A					

Legend:

Load Classification	Connected Load	Demand Factor	Estimated Demand	Panel Totals	
Other	0 VA	0.00%	0 VA		
Receptacle	31200 VA	66.03%	20600 VA	Total Conn. Load:	34000 VA
Power	2800 VA	100.00%	2800 VA	Total Est. Demand:	23400 VA
				Total Conn.:	94 A
				Total Est. Demand:	65 A

Notes:

Branch Panel: CB

Location: Electrical 139

Supply From: MDP

Mounting: Surface

Enclosure: Type 1

Volts: 120/208 Wye

Phases: 3

Wires: 4

A.I.C. Rating: 22K

Mains Type: MLO

Mains Rating: 250 A

MCB Rating: 225 A

Notes:


CKT	Circuit Description	Trip	Poles	A		B		C		Poles	Trip	Circuit Description	CKT
				20 A	1	1477... 308 VA							
CB-1	Guest Corridor Lights	20 A	1							1	20 A	Maintenance/RR Lights	CB-2
CB-3	Fintess Center Lights	20 A	1			1057... 1132...				1	20 A	Meeting Room Lights	CB-4
CB-5	Lobby Lights	20 A	1							1	20 A	Laundry Lights	CB-6
CB-7	Entrance/Storage Lights	20 A	1	123 VA	0 VA					1	20 A	Other	CB-8
CB-9	Receptacle	20 A	1			540 VA	720 VA			1	20 A	Receptacle	CB-10
CB-11	Receptacle	20 A	1					360 VA	360 VA	1	20 A	Receptacle	CB-12
CB-13	Receptacle	20 A	1	540 VA	180 VA					1	20 A	Receptacle - Exterior	CB-14
CB-15	Receptacle	20 A	1			540 VA	540 VA			1	20 A	Receptacle	CB-16
CB-17	Receptacle	20 A	1					720 VA	360 VA	1	20 A	Receptacle	CB-18
CB-19	Receptacle	20 A	1	360 VA	500 VA					1	20 A	Power	CB-20
CB-21						2005... 360 VA				1	20 A	Receptacle	CB-22
CB-23	Booster Pump	30 A	3					2005... 1500...		1	20 A	Elevator lights, fan, controls	CB-24
CB-25				2005... 1500...						1	20 A	Elevator lights, fan, controls	CB-26
CB-27	Spare	20 A	1			0 VA	1800...			1	20 A	EWB - Stairs #2	CB-28
CB-29	Spare	20 A	1					0 VA	0 VA	1	20 A	Spare	CB-30
CB-31													CB-32
CB-33													CB-34
CB-35													CB-36
CB-37													CB-38
CB-39													CB-40
CB-41													CB-42
Total Load:				6974 VA		8677 VA		6868 VA					
Total Amps:				58 A		72 A		57 A					

Legend:

Load Classification	Connected Load	Demand Factor	Estimated Demand	Panel Totals	
Lighting - Dwelling Unit	2280 VA	100.00%	2280 VA		
Other	3000 VA	100.00%	3000 VA	Total Conn. Load:	22519 VA
Receptacle	5580 VA	100.00%	5580 VA	Total Est. Demand:	23380 VA
Power	8315 VA	100.00%	8315 VA	Total Conn.:	63 A
Lighting	3447 VA	125.00%	4308 VA	Total Est. Demand:	65 A

Notes:

5/24/2019 7:22:50 PM

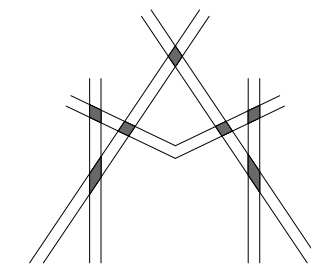

M I S H R A
ARCHITECTURE PLLC

6800 S Creek Rd, Charlotte, NC 28277
Ph:(704) 625-6554 Fax:(704) 919-5822
EMAIL:ashish@mishraarch.com
WEB: www.mishraarch.com

CIVIL:
Benchmark Engineering and Surveying
101 Highpointe Court, Suite B
Brandon, MS 39042
Phone: (601) 591-1077
Fax: (601) 591-0177
Email:mikebes@bellsouth.net

STRUCTURAL:
Whisonant Engineering Services, LLC
122 Nut Tree Court
Lexington, SC 29074
Phone: (803) 957-4008
Email: bill@weslex.com

MEP:
Innovative Engineering Services, LLC
2787 Stage Center DR., Suite 101
Bartlett, TN 38134
Phone: (901) 379-0500
Email: rhertter@innovativees-llc.com

[illegible]

Information contained on this drawing and in all digital files associated is authorized for use on the project named herein only and is the property of MISHRA ARCHITECTURE PLLC and may not be reproduced in any manner without express written or verbal permission from authorized individuals. Original drawing is 24"x36" and scales are as indicated.[®]
2011 MISHRA ARCHITECTURE PLLC



KEY PLAN

Pramukh Vicksburg.
LLC

HOME2suits Vicksburg

Berryman Road
Vicksburg, MS 39180

Drawing Title

ELECTRICAL - PANEL SCHEDULES

Phase
Construction Documents

Project No.	19005
Prepared by	PTH
Checked by	RJH
Date	04/02/19

Released for

HOME2suites Vicksburg

Branch Panel: HAC

Location: Electrical 139

Supply From: MDP

Mounting: Surface

Enclosure: Type 1

Volts: 120/208 Wye

Phases: 3

Wires: 4

A.I.C. Rating: 22K

Mains Type: MLO

Mains Rating: 250 A

MCB Rating: 225 A

Notes:

CKT	Circuit Description	Trip	Poles	A		B		C		Poles	Trip	Circuit Description	CKT
HAC-1	AHU-1	60 A	2	4990...	4990...					2	60 A	AHU-2	HAC-2
HAC-3						4990...	4990...						HAC-4
HAC-5								4990...	4990...				HAC-6
HAC-7	AHU-3	60 A	2	4990...	4990...					2	60 A	AHU-4	HAC-8
HAC-9						5280...	3950...						HAC-10
HAC-11	AHU-5	60 A	3					5280...	3950...	2	50 A	AHU-8	HAC-12
HAC-13				5280...	530 VA					1	20 A	EF-4	HAC-14
HAC-15	AHU-7	60 A	2			4990...							HAC-16
HAC-17								4990...					HAC-18
HAC-19													HAC-20
HAC-21													HAC-22
HAC-23													HAC-24
HAC-25													HAC-26
HAC-27													HAC-28
HAC-29													HAC-30
HAC-31													HAC-32
HAC-33													HAC-34
HAC-35													HAC-36
HAC-37													HAC-38
HAC-39													HAC-40
HAC-41													HAC-42
Total Load:				25770 VA		24200 VA		24200 VA					
Total Amps:				215 A		202 A		202 A					

Legend:

Load Classification		Connected Load	Demand Factor	Estimated Demand	Panel Totals	
Motor		530 VA	125.00%	663 VA		
Power		73640 VA	100.00%	73640 VA	Total Conn. Load:	74170 VA
					Total Est. Demand:	74303 VA
					Total Conn.:	206 A
					Total Est. Demand:	206 A

Notes:

Branch Panel: PANEL "K"

Location: Pantry 114

Supply From: MDP

Mounting: Surface

Enclosure: Type 1

Volts: 120/208 Wye

Phases: 3

Wires: 4

A.I.C. Rating: 22K

Mains Type:

Mains Rating: 250 A

MCB Rating:

Notes:

CKT	Circuit Description	Trip	Poles	A		B		C		Poles	Trip	Circuit Description	CKT	
K-1	Receptacle	20 A	1	180 VA	180 VA					1	20 A	Receptacle	K-2	
K-3	Receptacle	20 A	1			180 VA	180 VA			1	20 A	Receptacle	K-4	
K-5	Receptacle	20 A	1					180 VA	180 VA	1	20 A	Receptacle	K-6	
K-7	Receptacle	20 A	1	180 VA	180 VA					1	20 A	Receptacle	K-8	
K-9	Receptacle	20 A	1			180 VA	180 VA			1	20 A	Other	K-10	
K-11	Receptacle	20 A	1					180 VA					K-12	
K-13	Receptacle	20 A	1	180 VA	180 VA					1	20 A	Receptacle	K-14	
K-15	Receptacle	20 A	1			180 VA	180 VA			1	20 A	Receptacle	K-16	
K-17		20 A	1					678 VA	540 VA	1	20 A	Receptacle	K-18	
K-19	Power	20 A	3	8000...		8000...							K-20	
K-21													K-22	
K-23								8000...						K-24
K-25														K-26
K-27														K-28
K-29														K-30
K-31														K-32
K-33														K-34
K-35														K-36
K-37														K-38
K-39														K-40
K-41														
Total Load:				9080 VA		9080 VA		9742 VA						
Total Amps:				76 A		76 A		81 A						

Legend:

Load Classification				Connected Load		Demand Factor		Estimated Demand		Panel Totals		
Lighting - Dwelling Unit				480 VA		100.00%		480 VA				
Other				0 VA		0.00%		0 VA				
Receptacle				3240 VA		100.00%		3240 VA				
Power				24000 VA		100.00%		24000 VA				
Lighting				205 VA		125.00%		256 VA				

Notes:

Branch Panel: PANEL "LDY"

Location: Laundry 123

Supply From: MDP

Mounting: Surface

Enclosure: Type 1

Volts: 120/208 Wye

Phases: 3

Wires: 4

A.I.C. Rating: 22K

Mains Type:

Mains Rating: 250 A

MCB Rating:

Notes:

CKT	Circuit Description	Trip	Poles	A		B		C		Poles	Trip	Circuit Description	CKT
LDY-1	DRYER	30 A	3	1500...	1500...					3	30 A	WASHER	LDY-2
LDY-3						1500...	1500...						LDY-4
LDY-5								1500...	1500...				LDY-6
LDY-7				1500...	1500...								LDY-8
LDY-9	DRYER	30 A	3			1500...	1500...			3	30 A	WASHER	LDY-10
LDY-11								1500...	1500...				LDY-12
LDY-13													LDY-14
LDY-15				4990...	1500...								LDY-16
LDY-17	AHU-6	60 A	2			4990...	1500...			3	30 A	WASHER	LDY-18
LDY-19				20 A	1			720 VA	1500...				LDY-20
LDY-21				20 A	1	360 VA	615 VA						LDY-22
LDY-23				20 A	1			180 VA	180 VA				LDY-24
LDY-25	Receptacle												LDY-26
LDY-27													LDY-28
LDY-29													LDY-30
LDY-31													LDY-32
LDY-33													LDY-34
LDY-35													LDY-36
LDY-37													LDY-38
LDY-39													LDY-40
LDY-41													LDY-42
Total Load:				13465 VA		12850 VA		8220 VA					
Total Amps:				118 A		113 A		69 A					

Legend:

Load Classification	Connected Load	Demand Factor	Estimated Demand	Panel Totals		
Receptacle	1440 VA	100.00%	1440 VA	Total Conn. Load: 34535 VA	Total Est. Demand: 96 A	
Power	32480 VA	100.00%	32480 VA			Total Est. Demand: 34535 VA
Refrigerator	615 VA	100.00%	615 VA			Total Conn.: 96 A
				Total Est. Demand: 96 A		

Notes:

Branch Panel: PANEL "OL"

Location: Electrical 139

Supply From: MDP

Mounting: Surface

Enclosure: Type 1

Volts: 120/208 Wye

Phases: 3

Wires: 4

A.I.C. Rating: 22K

Mains Type:

Mains Rating: 150 A

MCB Rating:

Notes:

CKT	Circuit Description	Trip	Poles	A		B		C		Poles	Trip	Circuit Description	CKT
OL-1	Lighting	20 A	1	0 VA	3600...					1	20 A	Lighting - Exterior	OL-2
OL-3	Lighting - Exterior	20 A	1			2000...	2400...			1	20 A	Lighting - Exterior	OL-4
OL-5	Power	20 A	1					500 VA	180 VA	1	20 A	Receptacle	OL-6
OL-7		20 A	1	812 VA	0 VA					1	20 A	Lighting	OL-8
OL-9		20 A	1			700 VA							OL-10
OL-11													OL-12
OL-13													OL-14
OL-15													OL-16
OL-17													OL-18
OL-19													OL-20
OL-21													OL-22
OL-23													OL-24
OL-25													OL-26
OL-27													OL-28
OL-29													OL-30
Total Load:				4388 VA		5100 VA		680 VA					
Total Amps:				41 A		47 A		6 A					

Legend:

Load Classification	Connected Load	Demand Factor	Estimated Demand	Panel Totals	
Lighting - Dwelling Unit	820 VA	100.00%	820 VA		
Lighting - Exterior	8000 VA	125.00%	10000 VA	Total Conn. Load:	10137 VA
Receptacle	180 VA	100.00%	180 VA	Total Est. Demand:	12303 VA
Power	500 VA	100.00%	500 VA	Total Conn.:	28 A
Lighting	697 VA	125.00%	871 VA	Total Est. Demand:	34 A

Notes:

Branch Panel: PANEL "RF"

Location:

Supply From: MDP

Mounting: Surface

Enclosure: Type 1

Volts: 120/208 Wye

Phases: 3

Wires: 4

A.I.C. Rating:

Mains Type:

Mains Rating: 400 A

MCB Rating:

Notes:

CKT	Circuit Description	Trip	Poles	A	B	C	Poles	Trip	Circuit Description	CKT
RF-1	MUA-1	175 A	3	1550...	1550...			3	175 A	MUA-2
RF-3					1550...	1550...				
RF-6						1550...	1550...			
RF-7	CU-1	20 A	3	1440...	1440...			3	20 A	CU-2
RF-9					1440...	1440...				
RF-11						1440...	1440...			
RF-13	CU-4	20 A	3	1440...	1440...			3	20 A	CU-6
RF-15					1440...	1440...				
RF-17						1440...	1440...			
RF-19	CU-7	20 A	3	1440...	1440...			3	20 A	CU-3
RF-21					1440...	1440...				
RF-23						1440...	1440...			
RF-25	Roof Receptacles	20 A	1	540 VA	1456...			2	20 A	CU-8
RF-27	Roof Lighting	20 A	1		144 VA	1456...				
RF-29	CU-9	20 A	2			1350...	0 VA	1	20 A	Spare
RF-31				1350...	360 VA			1	20 A	Roof Receptacles
RF-33					2912...	400 VA		1	20 A	Motorized Dampers
RF-35	CU-5	20 A	2			2912...	1350...			
RF-37	Sign	20 A	1	500 VA	1350...			2	20 A	CU-10
RF-39	Spare	20 A	1		0 VA	0 VA		1	20 A	Spare
RF-41	Spare	20 A	1			0 VA	0 VA	1	20 A	Spare
Total Load:				45196 VA	44552 VA	45252 VA				
Total Amps:				377 A	371 A	378 A				

Legend:

Load Classification	Connected Load	Demand Factor	Estimated Demand	Panel Totals
Other	400 VA	100.00%	400 VA	
Receptacle	900 VA	100.00%	900 VA	Total Conn. Load: 135000 VA
Power	133556 VA	100.00%	133556 VA	Total Est. Demand: 135036 VA
Lighting	144 VA	125.00%	180 VA	Total Conn.: 375 A
				Total Est. Demand: 375 A

Notes:

Branch Panel: 1A

Location: Electrical 139

Supply From: MDP

Mounting: Surface

Enclosure: Type 1

Volts: 120/208 Wye

Phases: 3

Wires: 4

A.I.C. Rating: 10K

Mains Type: MLO

Mains Rating: 250 A

MCB Rating: 225 A

Notes:

CKT	Circuit Description	Trip	Poles	A		B		C		Poles	Trip	Circuit Description	CKT
1A-1	PANEL "B"	20 A	2	1113...	7605...					2	20 A	PANEL "A"	1A-2
1A-3						9530...	6875...						1A-4
1A-5	PANEL "A"	20 A	2					7605...	7605...	2	20 A	PANEL "A"	1A-6
1A-7				6875...	6875...								1A-8
1A-9	PANEL "A"	20 A	2			7605...	1019...			2	20 A	PANEL "B" KO	1A-10
1A-11								6875...	1046...				1A-12
1A-13													1A-14
1A-15													1A-16
1A-17													1A-18
1A-19													1A-20
1A-21													1A-22
1A-23													1A-24
1A-25													1A-26
1A-27													1A-28
1A-29													1A-30
1A-31													1A-32
1A-33													1A-34
1A-35													1A-36
1A-37													1A-38
1A-39													1A-40
1A-41													1A-42
Total Load:				32490 VA		34209 VA		32551 VA					
Total Amps:				271 A		285 A		271 A					

Legend:

Load Classification	Connected Load	Demand Factor	Estimated Demand	Panel Totals	
HVAC	48000 VA	100.00%	48000 VA		
Motor	584 VA	105.18%	614 VA	Total Conn. Load:	99250 VA
Other	0 VA	0.00%	0 VA	Total Est. Demand:	85942 VA
Receptacle	22320 VA	72.40%	16160 VA	Total Conn.:	275 A
Lighting	1298 VA	125.00%	1623 VA	Total Est. Demand:	239 A
Refrigerator	3690 VA	75.00%	2768 VA		
Dishwasher	9000 VA	75.00%	6750 VA		
Microwave	7200 VA	75.00%	5400 VA		

Notes:

Information contained on this drawing and in all digital files associated is authorized for use on the project named herein only and is the property of MISHRA ARCHITECTURE PLLC and may not be reproduced in any manner without express written or verbal permission from authorized individuals. Original drawing is 24"x36" and scales are as indicated.
2011 MISHRA ARCHITECTURE PLLC



Pramukh Vicksburg.
LLC

Berryman Road
Vicksburg, MS 39180

Drawing Title

**ELECTRICAL - PANEL
SCHEDULES**

Phase
Construction Documents

Project No.	19005	Sheet No. E404
Prepared by	PTH	
Checked by	RJH	
Date	04/02/19	

Released fo

HOME2suites Vicksburg


SPECIFICATIONS & NOTES

- GENERAL:** FURNISH ALL LABOR, EQUIPMENT, AND MATERIALS NECESSARY FOR A COMPLETE INSTALLATION OF ELECTRICAL WIRING. THE DRAWINGS INDICATE DIAGRAMMATICALLY THE EXTENT, GENERAL CHARACTER, AND THE APPROXIMATE LOCATION OF THE WORK TO PERFORMED. OMISSIONS OF THE DETAILS OF WORK, MOUNTING HARDWARE, FITTING, J-BOXES, OUTLET BOXES, PULL BOXES, SUPPORTS, CONNECTORS, ACCESSORIES, AND/OR ADAPTORS WHICH ARE EVIDENTLY NECESSARY TO CARRY OUT THE INTENT OF THE DRAWINGS AND SPECIFICATIONS, SHALL BE PROVIDED. CONNECT ALL ELECTRICAL EQUIPMENT WHETHER FURNISHED BY ELECTRICAL CONTRACTOR OR BY OTHERS AND WHETHER SHOWN ON PLANS OR NOT. INSTALL AND CONNECT ALL STARTERS FURNISHED BY THIS CONTRACTOR OR OTHERS. FURNISH, INSTALL, AND CONNECT DISCONNECTS AND SAFETY SWITCHES FOR ALL ELECTRICAL EQUIPMENT WHETHER FURNISHED BY THIS CONTRACTOR OR OTHERS AND WHERE REQUIRED BY NEC. BEFORE INSTALLING RACEWAYS FOR MOTORS, APPLIANCES, HVAC AND/OR OTHER EQUIPMENT PROVIDED BY OTHERS VERIFY LOCATIONS AND ARRANGE RACEWAYS ACCORDINGLY. VERIFY ALL DOOR SWINGS WITH ARCHITECTURAL PLANS BEFORE ROUGHING IN LIGHT SWITCHES. WHERE NO RACEWAY SIZES OR WIRE SIZES ARE SHOWN INSTALL AS REQUIRED BY NEC. VERIFY POWER AND CONNECTION REQUIREMENTS FOR ALL EQUIPMENT BEFORE INSTALLATION. WIRE AS REQUIRED BY EQUIPMENT MANUFACTURER AND IN COMPLIANCE WITH NEC. OBTAIN MOCP AND MCA INFORMATION FROM ACTUAL EQUIPMENT BEING INSTALLED AND CIRCUIT ACCORDINGLY. ALL CIRCUIT BREAKERS SUPPLYING HVAC EQUIPMENT SHALL BE HACR TYPE. ALL WORK SHALL COMPLY WITH APPLICABLE LAWS OF THE COMMUNITY AND WITH THE NEC. OBTAIN AND PAY FOR ALL PERMITS REQUIRED. OBTAIN APPROVAL FOR ALL WORK INDICATED ON PLANS AND IN SPECIFICATIONS FROM ALL AGENCIES AND AUTHORITIES HAVING JURISDICTION. AFTER COMPLETION OF THE WORK, SUBMIT CERTIFICATE OF FINAL INSPECTION AND APPROVAL FROM THE LOCAL ELECTRICAL INSPECTOR AND LOCAL FIRE DEPARTMENT AUTHORITIES CERTIFYING THAT THE INSTALLATION COMPLIES WITH ALL REGULATIONS GOVERNING THE SAME. ALL MATERIALS SHALL BE NEW AND UL LISTED. EXECUTE ALL WORK IN A WORKMANLIKE MANNER SO AS TO PRESENT A NEAT AND MECHANICAL APPEARANCE WHEN COMPLETED.
- COORDINATION:** COORDINATE WORK SO AS TO CONFORM TO THE PROGRESS OF THE WORK OF THE OTHER TRADES, AND COMPLETE THE ENTIRE INSTALLATION AS SOON AS THE CONDITION OF THE BUILDING PERMITS. SOME SAFETY DISCONNECT SWITCHES MAY BE PROVIDED BY THE MECHANICAL CONTRACTOR BUT INSTALLED AND CONNECTED BY THE ELECTRICAL CONTRACTOR. THE WORK SHALL BE COORDINATED BY THE ELECTRICAL CONTRACTOR.
- INTERFERENCE:** IN THE EVENT THAT INTERFERENCES OR CONFLICTS DEVELOP, THE ARCHITECT SHALL DECIDE WHICH EQUIPMENT SHALL BE RELOCATED AT NO COST TO OWNER REGARDLESS OF WHICH WAS FIRST INSTALLED.
- CUTTING AND PATCHING:** PROVIDE CUTTING AND PATCHING, UNDER THE SUPERVISION OF THE GENERAL CONTRACTOR, AS REQUIRED FOR ELECTRICAL WORK. COORDINATE WITH OTHER TRADES AS WORK PROGRESSES SO CUTTING AND PATCHING WILL NOT BE REQUIRED OR BE MINIMAL.
- SUBMITTALS:** WITHIN TWENTY (20) DAYS AFTER AWARD OF CONTRACT, SUBMIT SIX (6) COPIES OF MANUFACTURER'S DRAWINGS TO THE ARCHITECT FOR REVIEW OF THE FOLLOWING ITEMS: PANELBOARDS, LIGHT FIXTURES, DISCONNECT SWITCHES, FIRE ALARM SYSTEM (COMPLETE WITH PLAN SHOWING WIRING/ CONDUIT).
- TESTING:** UPON COMPLETION OF THE WORK, CONDUCT A THOROUGH TEST IN THE ARCHITECT'S PRESENCE, AND SHOW THE ENTIRE SYSTEM TO BE IN PERFECT WORKING CONDITION.
- GUARANTEE:** GUARANTEE THAT ALL WORK EXECUTED UNDER THESE SPECIFICATIONS AND PLANS WILL BE FREE FROM DEFECTS OF WORKMANSHIP AND MATERIALS FOR A PERIOD OF ONE (1) YEAR FROM THE DATE OF FINAL ACCEPTANCE OF THIS WORK. PROMPTLY REPAIR, REPLACE, OR OTHERWISE MAKE GOOD, UPON NOTIFICATION, ANY DEFECT BECOMING APPARENT DURING THIS PERIOD, AT NO COST TO THE OWNER.
- TEMPORARY SYSTEMS:** THE ELECTRICAL CONTRACTOR SHALL BE RESPONSIBLE FOR FURNISHING AND INSTALLING EQUIPMENT AND MATERIALS NECESSARY FOR PROVIDING ELECTRICAL POWER WHERE NEEDED FOR THE CONSTRUCTION OF THE PROJECT IN ACCORDANCE WITH ALL OSHA REGULATIONS.
- SITE VISIT:** BEFORE SUBMITTING A BID, VISIT THE SITE AND VERIFY ALL EXISTING CONDITIONS. MAKE SUCH ADJUSTMENTS TO WORK AS REQUIRED BY THE ACTUAL CONDITIONS ENCOUNTERED.
- SERVICE ENTRANCE:** IT SHALL BE THE RESPONSIBILITY OF THIS CONTRACTOR TO VERIFY THAT THE LOCATION, ARRANGEMENT, VOLTAGE, PHASE AND CONNECTIONS TO UTILITY SERVICE, AS WELL AS THE REQUIRED METERING EQUIPMENT, ARE COORDINATED WITH AND IN ACCORDANCE WITH REQUIREMENTS OF THE LOCAL POWER COMPANY. IF THE REQUIREMENTS ARE AT VARIANCE WITH THESE DRAWINGS OR SPECIFICATIONS, THE CONTRACT PRICE SHALL INCLUDE ANY ADDITIONAL COST NECESSARY TO MEET THOSE REQUIREMENTS WITHOUT EXTRA COST TO THE OWNER AFTER THE CONTRACT IS ENTERED INTO. NOTIFY ARCHITECT OF ANY CHANGES REQUIRED BEFORE PROCEEDING WITH WORK. ANY CHARGES BY THE UTILITY COMPANY FOR THE ELECTRICAL SERVICE TO THE FACILITY SHALL BE INCLUDED IN THE BID PRICE.
- CONDUIT PENETRATIONS:** WHERE CONDUITS AND OTHER ELECTRICAL EQUIPMENT RACEWAYS PASS THROUGH FIRE PARTITIONS, FIRE WALLS, OR FLOORS, INSTALL A FIRE STOP THE PROVIDES AN EFFECTIVE BARRIER AGAINST THE SPREAD OF FIRE, SMOKE, AND GASES AND WHICH MAINTAINS THE FIRE RATING OF THE WALL WHICH HAS BEEN PENETRATED. WHERE EXTERIOR WALLS OR FLOORS ARE PENETRATED PROVIDE COMPLETELY WEATHERPROOFING OF PENETRATION. FURNISH ROOF FLASHING FOR ALL CONDUIT OR EQUIPMENT WHICH PENETRATES ROOF.
- LIGHT FIXTURES:** IT SHALL BE THE RESPONSIBILITY OF THE CONTRACTOR TO VERIFY THE EXACT TYPE CEILING, TYPE FIXTURE MOUNTING AND TRIM, AND RECESSING DEPTH OF ALL RECESSED FIXTURES PRIOR TO PURCHASING ANY FIXTURES. REGARDLESS OF PART NUMBERS IDENTIFIED ON THE LIGHT FIXTURE SCHEDULE, IT SHALL BE THE CONTRACTOR'S RESPONSIBILITY TO VERIFY THE PROPER OPERATING VOLTAGE OF LIGHT FIXTURES ACCORDING TO THE PLANS PRIOR TO PURCHASING ANY FIXTURES. EQUIVALENT FIXTURES SUBSTITUTES BY LITHONIA, COOPER LIGHTING, AND HUBBELL WILL BE ACCEPTED. PROVIDE LAMPS FOR ALL FIXTURES. LAMPS SHALL BE MANUFACTURED BY GE, OSRAM- SYLVANIA, OR PHILIPS. FLUORESCENT BALLASTS SHALL BE HIGH FREQUENCY ELECTRONIC TYPE BY MAGNETIC TRIAD, LUTRON, OSRAM- SYLVANIA OR MOTOROLA AND SHALL HAVE A 5 YEAR WARRANTY. BF SHALL BE GREATER THAN .9, THD SHALL BE LESS THAN 20%, CF GREATER THAN 1.7 AND PF GREATER THAN .93. HID LAMPS BALLASTS SHALL BE HIGH POWER FACTOR (.90 OR GREATER) TYPE. HID LAMPS SHALL BE CERAMIC TYPE. PROVIDE ALL MOUNTING HARDWARE, ADAPTORS, AND ACCESSORIES AS REQUIRED. UOM, CENTER ALL DOWNLIGHTS AND WALLWASHERS ON CEILING TILE.
- BUILDING WIRES & CABLE:** INTERIOR WIRE SHALL BE COPPER THHN, #12 AWG MINIMUM TYPE "XHHW" COPPER SHALL BE USED EXTERIOR OR UNDERGROUND. CONDUCTORS #10 AND #12 SHALL BE SOLID. LARGER SIZES SHALL BE STRANDED. CONTROL AND SIGNAL WIRE SHALL BE TYPE "TFF" COPPER, MINIMUM SIZE #16. JOINTS AND SPLICES IN WIRE SHALL BE MADE WITH SOLDERLESS CONNECTORS, AND COVERED SO THAT INSULATION IS EQUAL TO CONDUCTOR INSULATION. WIRE NUTS SHALL NOT BE USED FOR CONDUCTOR #8 AND LARGER. NO SPLICES SHALL BE PULLED INTO CONDUIT. BOTH IN CONNECTORS AND CONDUITS SHALL BE CONTINUOUS FROM OUTLET TO OUTLET. ALL CONDUITS SHALL HAVE DUSHING WITH SMOOTH BEVELED THROATS INSTALLED AT BOTH ENDS PRIOR TO INSTALLING CONDUCTORS. CIRCUITS MAY BE COMBINED IF CONDUIT SIZES ARE ADJUSTED WHERE NECESSARY AND NEC DERATING FACTORS ARE OBSERVED. BRANCH CIRCUIT WIRE GAUGES SHALL BE INCREASED AS REQUIRED FOR A MAXIMUM OF 3% VOLTAGE DROP. TYPE MC CABLE MAY BE USED AS PERMITTED BY ARTICLE 330 OF NEC.
- CONDUIT:** ALL WIRING SHALL BE IN RACEWAYS, MINIMUM 1/2" DIAMETER. USE EMT FOR GENERAL INTERIOR WORK. RIGID GALVANIZED STEEL OR INTERMEDIATE METAL CONDUIT SHALL BE USED IN FLOOR SLABS, WHERE EMBEDDED IN CONCRETE, AREAS EXPOSED TO MOISTURE, AREAS IN DANGER OF MECHANICAL INJURY AND HAZARDOUS AREAS. PVC SCHEDULE 40 (3/4" MINIMUM DIAMETER) SHALL BE USED BELOW GRADE WITH STEEL TRANSITIONS THRU SLABS. USE FLEXIBLE METAL CONDUIT CONNECTIONS TO MOTORS, TRANSFORMERS AND OTHER VIBRATING EQUIPMENT. EXTERIOR FLEW SHALL BE LIQUIDTIGHT. EMT CONDUIT FITTINGS SHALL BE SET-SCREW TYPE. ALL EXPOSED CONDUIT SHALL BE PAINTED TO MATCH SURFACE UPON WHICH IT IS INSTALLED. INTERIOR WIRING AS SHOWN ON PLANS WILL, TYPICALLY BE CONCEALED IN CEILINGS WALLS OR FLOORS EXCEPT IN MECHANICAL/ ELECTRICAL ROOMS, JANITOR CLOSETS, UNFINISHED ROOMS AND OTHER SUCH ROOM WHERE CONDUITS ARE TYPICALLY EXPOSED. WHERE NO RACEWAY SIZES OR WIRE SIZES ARE SHOWN ON PLAN PROVIDE AND INSTALL AS REQUIRED BY NEC.
- DEVICE PLATES:** COVER PLATES SHALL BE SMOOTH NYLON W/ COLOR MATCHING DEVICES. VERIFY COLOR W/ FF&E FINISH SCHEDULE. FOR UNFINISHED AREAS EXPOSED CONDUIT, COVER PLATES SHALL BE GALVANIZED STEEL WITH BEVELED EDGES.


1 SPECIFICATIONS & NOTES
1/8" = 1'-0"

SPECIFICATIONS & NOTES

- FUSES: CLASS RK-1 TIME DELAY FUSE FOR PROTECTING CIRCUIT BREAKERS. BUSSMAN LITRON OR EQUAL. CLASS RK-5 TIME DELAY FUSE FOR PROTECTION OF MOTORS AND TRANSFORMERS. BUSSMAN FUSETRON OR EQUAL. 200K AIC AT RATED VOLTAGE.
- OUTLET BOXES: EXCEPT AS NOTED, BOXES SHALL BE STANDARD GALVANIZED OR SHERADIZED AT LEAST 1 1/2 INCHES DEEP OR AS NOTED IN PLANS. OF METAL AT LEAST 1 1/16 INCH THICK, SIZED TO ACCOMMODATE DEVICES AND CONDUCTOR AS PER NEC ARTICLE 370. COORDINATE DEPTH WITH WALL CONSTRUCTION. BOXES USED WITH EXPOSED CONDUIT SHALL BE 4-INCH SQUARE UTILITY BOXES. EXTERIOR BOXES SHALL BE GALVANIZED CAST-IRON WITH GASKETS AND APPROPRIATE FITTINGS. BOXES SHALL BE PROVIDED WITH APPROVED 3/8" FIXTURE STUDS WHERE REQUIRED. EXCEPT WHERE LOCATED IN CONCRETE BLOCK, SWITCH AND RECEPTACLE BOXES SHALL BE 4" SQUARE FOR SINGLE GANG INSTALLATION. APPROPRIATE GANG BOXES SHALL BE USED FOR MOUNTING GANGED SWITCHES.
- WIRING DEVICES: SWITCHES SHALL BE A.C. TYPE AS MADE BY HUBBELL, P & S, G.E. OR LEVITON. RECEPTACLES SHALL BE HUBBELL, BRYANT, P & S, G.E. OR LEVITON. COLOR SHALL BE SELECTED BY FF&E FINISH SCHEDULE. PROVIDE MATCHING PLUGS FOR SPECIAL PURPOSE RECEPTACLES WHEN REQUIRED FOR CONNECTION EQUIPMENT. ALL RECEPTACLES IN TOILETS, WITHIN 6 FT. OR SINKS, IN COMMERCIAL KITCHENS AND IN EXTERIOR LOCATIONS SHALL BE GFI TYPE. EXTERIOR RECEPTACLES SHALL HAVE WEATHERPROOF AND GASKETED COVERS. ALL RECEPTACLES IN GUEST ROOMS SHALL BE TAMPERPROOF.
- PANELBOARDS: PANELBOARDS SHALL BE OF A DEAD-FRONT SAFETY TYPE EQUIPPED WITH THERMAL MAGNETIC CASE CIRCUIT BREAKERS WITH FRAME AND TRIP RATINGS AS SHOWN ON THE SCHEDULE. CIRCUIT BREAKER SHALL BE QUICK-BREAK, QUICK-BREAK THERMAL MAGNETIC TRIPS INDICATING AND SHALL HAVE COMMON TRIP ON ALL MULTIPOLAR BREAKERS. CONNECTION TO THE BUSS SHALL BE BOLT ON. TERMINALS FOR FEEDER CONDUCTORS TO THE PANELBOARD MAINS AND NEUTRAL SHALL BE UL LISTED AS SUITABLE FOR THE TYPE OF CONDUCTOR SPECIFIED. TERMINALS FOR BRANCH CIRCUIT WIRING, BOTH BREAKER AND NEUTRAL, SHALL BE UL LISTED AS SUITABLE FOR THE CONDUCTOR SPECIFIED. PANELBOARDS NOT SHOWN TO BE RATED FOR SERVICE ENTRANCE SHALL BE EQUIPPED WITH AN ISOLATED NEUTRAL AND A GROUNDING BUSS. THE PANELBOARD FRONT SHALL BE OF HINGED FRONT TYPE WITH DOORS EQUIPPED WITH FLUSH-BRUSHED STEEL, CYLINDER TUMBLER-TYPE LOCKS WITH CATCHES AND SPRING-LOADED DOOR PULLS. THE FLUSH LOCK SHALL NOT PROTRUDE BEYOND THE FRONT OF THE DOOR. ALL PANELBOARD LOCKS SHALL BE KEYPED ALIKE. A CIRCUIT DIRECTORY FRAME AND CARD WITH CLEAR PLASTIC COVERING SHALL BE PROVIDED ON THE INSIDE OF THE DOOR. PANELBOARDS SHALL BE RATED FOR USE AS SERVICE ENTRANCE EQUIPMENT WHERE REQUIRED BY NEC. FOR ALL FLUSH INSTALLED PANELBOARDS, LEAVE EMPTY 3/4" CONDUITS STUBBED TO THE ABOVE CEILING SPACE. PANELBOARDS SHALL BE BY GENERAL ELECTRIC, SQUARE "D", OR CUTLER-HAMMER. LOAD CENTERS SHALL NOT BE USED UNLESS INDICATED ON PLANS.
- SAFETY SWITCHES/DISCONNECTS: SAFETY SWITCHES AND DISCONNECT SWITCHES SHALL BE TYPE "D" OR GENERAL ELECTRIC. DISCONNECT SWITCHES SHALL BE TYPE "D" OR GENERAL ELECTRIC. DISCONNECTS ADJACENT TO EQUIPMENT ON SUITABLE STRUCTURE. A DISCONNECT SHALL NOT BE REQUIRED OTHER THAN THE CB WHICH PROVIDES POWER TO EQUIPMENT WHEN THE EQUIPMENT IS WITHIN SIGHT AND NOT GREATER THAN 50 FEET FROM CB. VERIFY DISCONNECT SIZE FROM EQUIPMENT NAMEPLATE DATA. MOUNT DISCONNECTS FOR OUTSIDE HVAC UNITS NO HIGHER THAN HEIGHT OF UNIT. PROVIDE CLEARANCES AS REQUIRED BY NEC 110.26.
- GROUNDING: ALL EQUIPMENT SHALL BE GROUNDED AND BONDED IN ACCORDANCE WITH LOCAL REGULATIONS AND NATIONAL ELECTRICAL CODE. INSTALL A GREEN EQUIPMENT GROUNDING CONDUCTOR IN ALL RACEWAYS.
- COLOR CODING OF CONDUCTORS: COLOR CODE CONDUCTORS IN ACCORDANCE WITH THE NEC AND WITH STANDARD AND ACCEPTED TRADE PRACTICES.
- OUTLET BOX MOUNTING HEIGHTS: UNLESS OTHERWISE NOTED, WALL SWITCHES (GENERAL): 48" AFF. RECEPTACLES: 18" AFF. TELEPHONE WALL OUTLETS: 48" AFF. THERMOSTATS: 48" AFF.
- OUTLETS AND CONDUIT FOR OTHER TRADES: PROVIDE CONCEALED 4" SQUARE (OR SMALLER WHEN REQUIRED) JET BOXES WITH EMPTY PLUMBING CONTRACTORS. COORDINATE REQUIREMENTS WITH EACH CONTRACTOR. WHETHER SHOWN ON PLANS OR NOT, PROVIDE A WP, GFI RECEPTACLE LOCATED WITHIN 25" OF ALL EXTERIOR HVAC EQUIPMENT.
- VERIFY: THE WORD "VERIFY" WHEN USED IN PLANS SHALL MEAN TO VERIFY LOCATION AND WIRING REQUIREMENTS BEFORE CIRCUITING AND CIRCUIT IN ACCORDANCE WITH MANUFACTURER'S RECOMMENDATIONS AND IN COMPLIANCE WITH NEC.
- DATA, CABLE TV, TELEPHONE: FOR CABLE TV OUTLETS, DATA OUTLETS, AND TELEPHONE OUTLETS THE WIRING, JACKS, AND FACEPLATES WILL BE PROVIDED BY OTHERS UNLESS OTHERWISE NOTED. MOUNT INDIVIDUAL DATA OUTLETS, TELEPHONE OUTLETS AND CABLE TV OUTLETS AT EXACTLY THE SAME HEIGHT AS RECEPTACLES UNLESS NOTED OTHERWISE.
- NEC: "NEC" REFERS TO THE LATEST EDITION OF THE NATIONAL ELECTRICAL CODE WHICH HAS BEEN ADOPTED INTO LOCAL BUILDING CODE BY AGENCIES AND AUTHORIZES HAVING JURISDICTION.
- EXTERIOR ENCLOSURES: ALL EXTERIORS ENCLOSURES OR ENCLOSURES EXPOSED TO MOIST CONDITIONS SHALL BE RATED NEMA 3R OR RATED FOR USE IN DAMP OR WET CONDITIONS AS EACH CASE REQUIRES.
- UNDERGROUND INSTALLATIONS: WHERE CONDUIT IS INSTALLED BELOW GRADE, THE MINIMUM BURIAL DEPTH SHALL BE 24" UNLESS INSTALLED UNDER BUILDING SLAB (WHERE THERE IS NO MINIMUM BURIAL DEPTH). WHERE RIGID CONDUIT IS INSTALLED BELOW GRADE, COAT CONDUIT AND COUPLINGS WITH (2) COATS OF ASPHALTUM PAINT. UNDERGROUND PRIMARY CONDUIT INSTALLED IN COORDINATION WITH POWER COMPANY SHALL BE INSTALLED AT DEPTH AS DIRECTED BY POWER COMPANY. AVOID ALL EXISTING UTILITIES. ANY EXISTING UTILITIES DAMAGED SHALL BE REPAIRED AT CONTRACTORS EXPENSE AND AS DIRECTED BY ARCHITECT. RESTORE ANY DAMAGE PAVING TO MATCH EXISTING.
- IDENTIFICATION: PROVIDE 1" HIGH LAMINATE PHENOLIC NAMEPLATES PERMANENTLY INSTALLED (WITH 3/8" HIGH WHITE LETTERS ON BLACK) ON THE FRONT OF ALL DISCONNECT SWITCHES, CB ENCLOSURES, PANELBOARDS, CONTACTORS, TRANSFORMERS, TRANSIENT VOLTAGE SURGE SUPPRESSORS AND STARTERS.
- CLEANING UP: DURING THE PROGRESS OF WORK, KEEP THE OWNER'S PREMISE IN A NEAT AND ORDERLY CONDITION, FREE FROM ACCUMULATION OF DEBRIS RESULTING FROM THIS WORK. AT THE COMPLETION OF THE WORK, REMOVE ALL MATERIAL, SCRAP, ETC. NOT A PART OF THIS CONTRACT.
- OPERATING & MAINTENANCE INSTRUCTIONS: TURN OVER TO THE ARCHITECT ONE SET OF ALL EQUIPMENT CATALOGS AND MAINTENANCE DATA. EXPLAIN AND DEMONSTRATE THE ELECTRICAL SYSTEMS TO OWNER AND/OR OWNER'S REPRESENTATIVE.

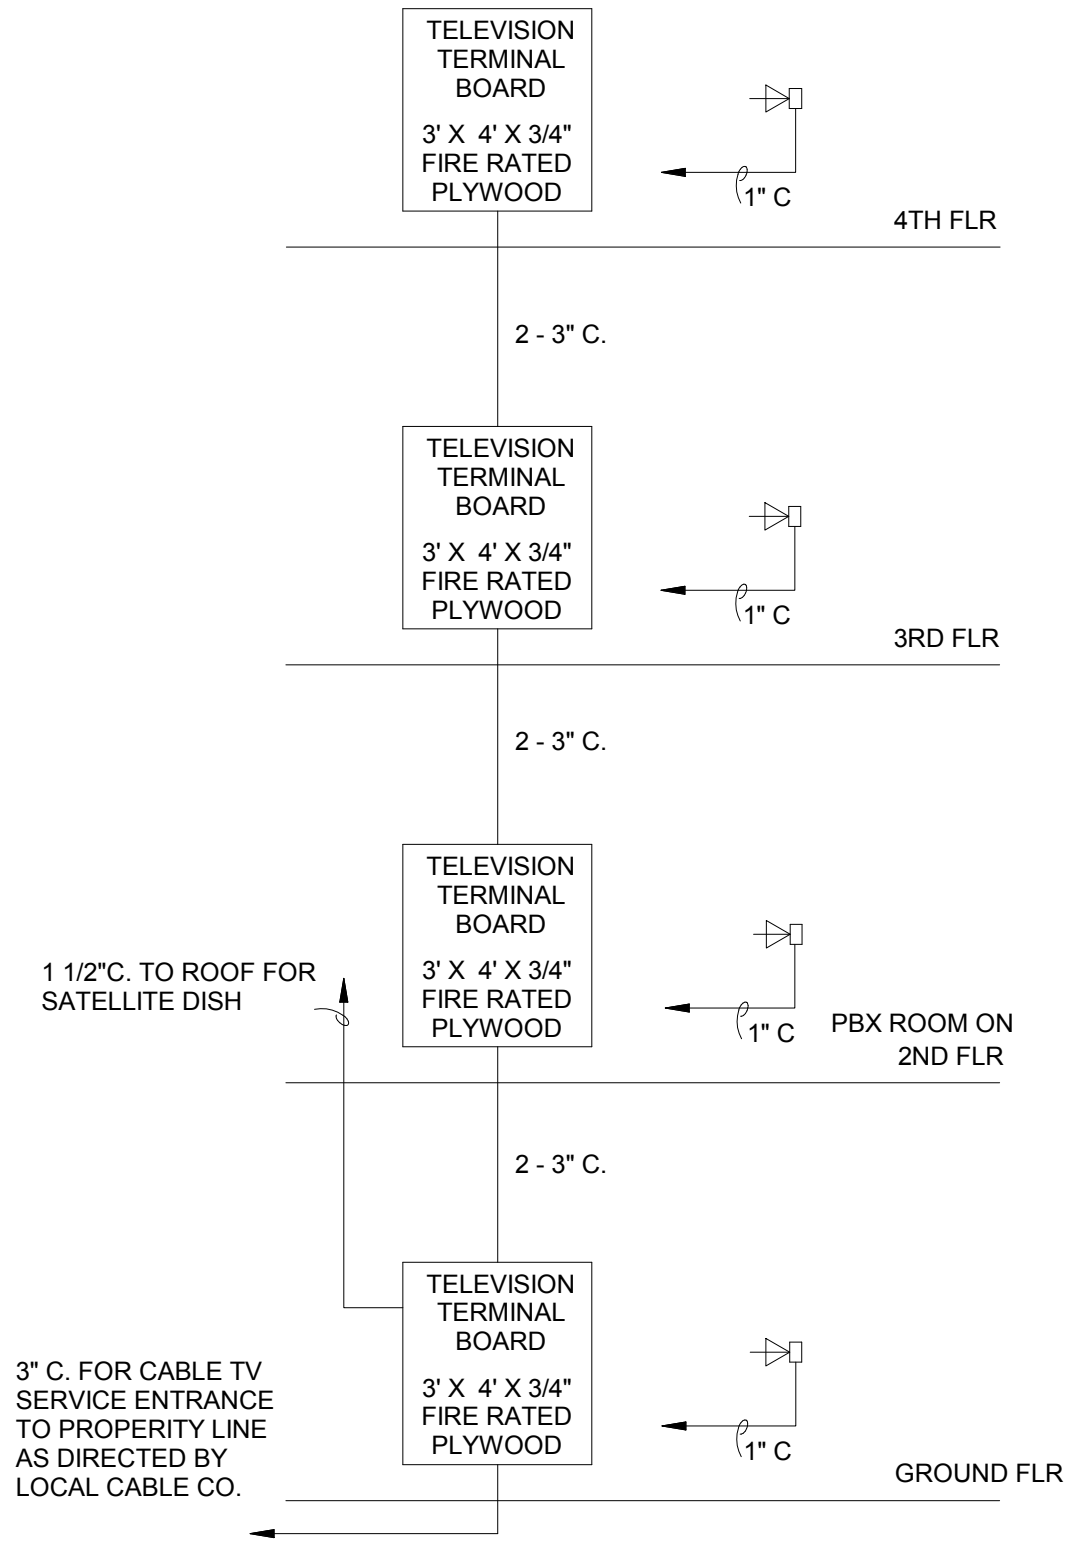

2 CABLE RISER
1/8" = 1'-0"

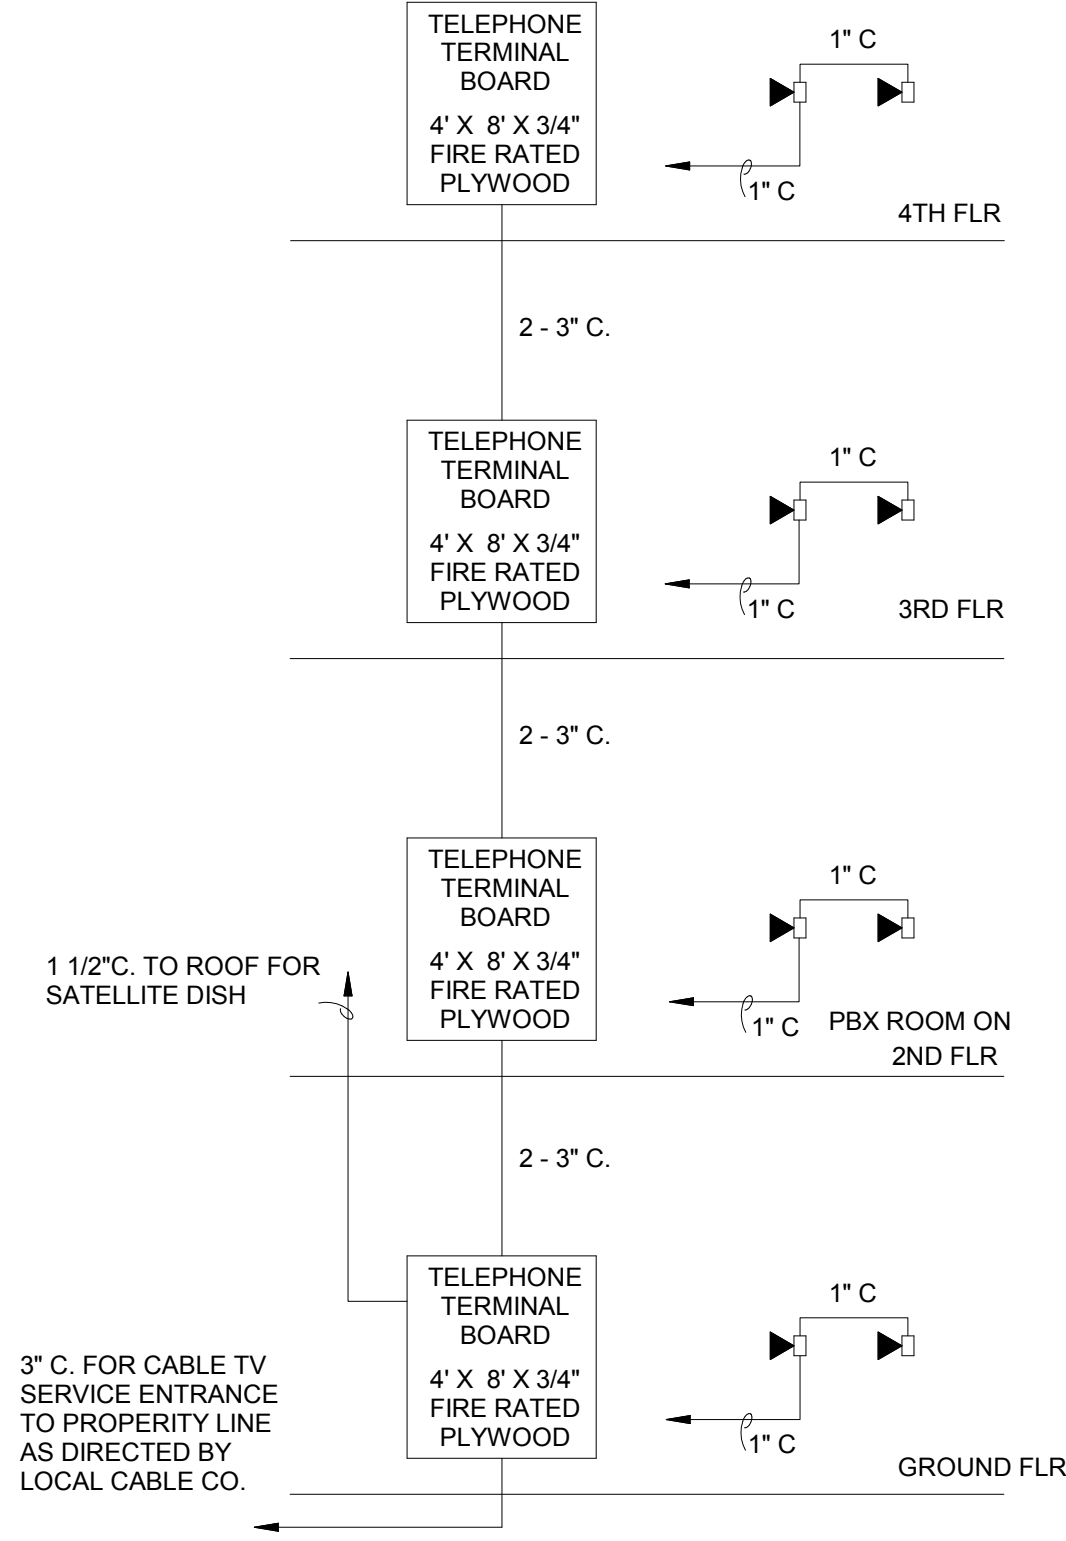

3 TELEPHONE RISER
1/8" = 1'-0"



CIVIL:
Benchmark Engineering and Surveying
101 Highpointe Court, Suite B
Brandon, MS 39042
Phone: (601) 591-1077
Fax: (601) 591-0177
Email: mikesbes@bellsouth.net

STRUCTURAL:
Whisonant Engineering Services, LLC
122 Nut Tree Court
Lexington, NC 27304
Phone: (803) 957-4008
Email: bill@weslex.com

MEP:
Innovative Engineering Services, LLC
2877 Stage Center DR., Suite 101
Bartlett, TN 38134
Phone: (901) 379-0500
Email: mherter@innovativees-llc.com

REVISIONS		
No.	Date	Description

Information contained on this drawing and in all digital files associated is authorized for use on the project named herein only and is the property of MISHRA ARCHITECTURE PLLC and may not be reproduced in any manner without express written or verbal permission from authorized individuals. Original drawing is 24"x36" and scales are as indicated. 2011 MISHRA ARCHITECTURE-LLC



KEY PLAN

Pramukh Vicksburg.
LLC

HOME2suites
Vicksburg

Berryman Road
Vicksburg, MS 39180

Drawing Title

ELECTRICAL -
COMMUNICATIONS
RISERS & DETAILS

Phase
Construction Documents

Project No.	19005	Sheet No.	E407
Prepared by	PTH		
Checked by	RJH		
Date	04/02/19		

Released for

