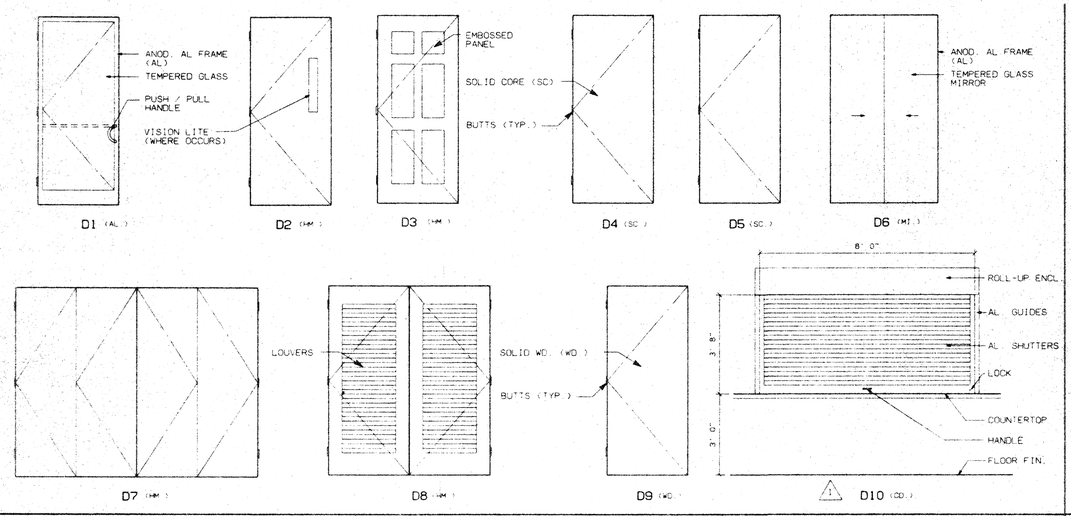

DOOR TYPES

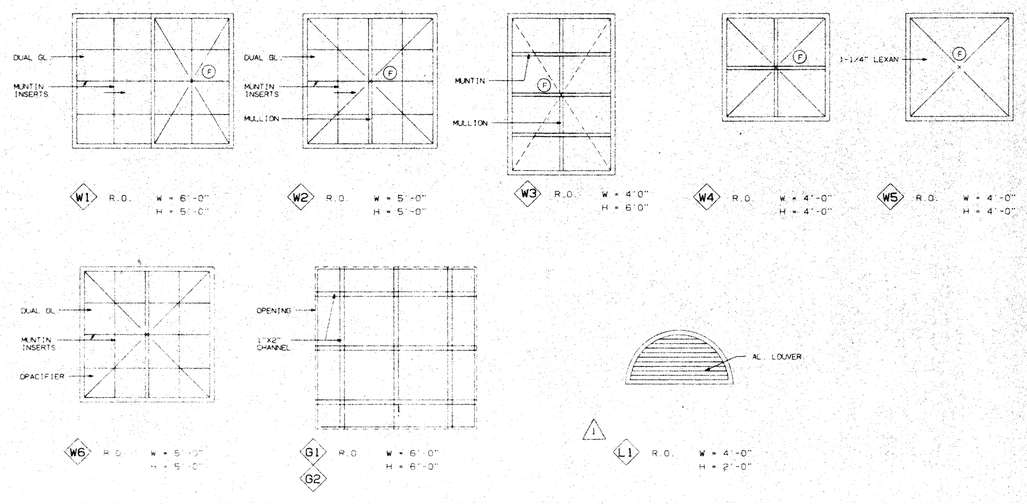

WINDOW TYPES

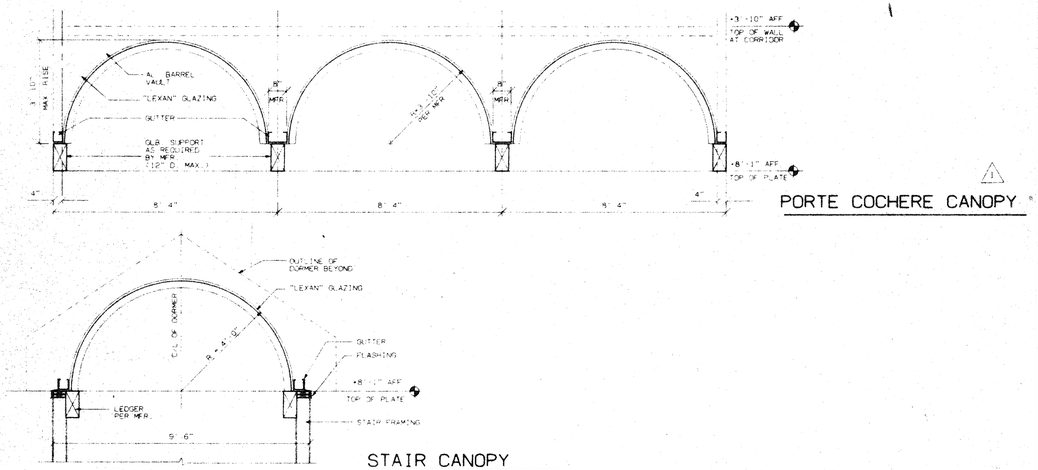

PORTE COCHERE CANOPY

STAIR CANOPY

CANOPY/SKYLIGHT PROFILE

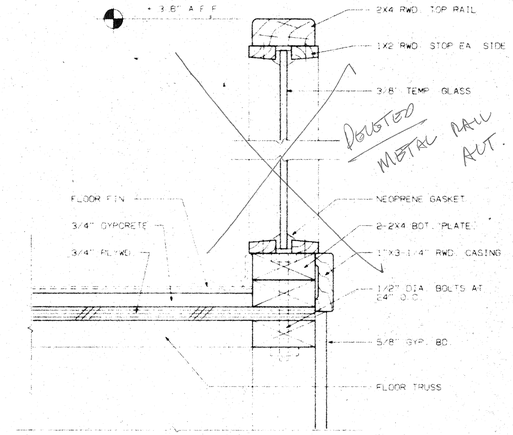

5 GLASS HANDRAIL

DRAWING NO. GLASS HANDRAIL1
SCALE 3" = 1'-0"

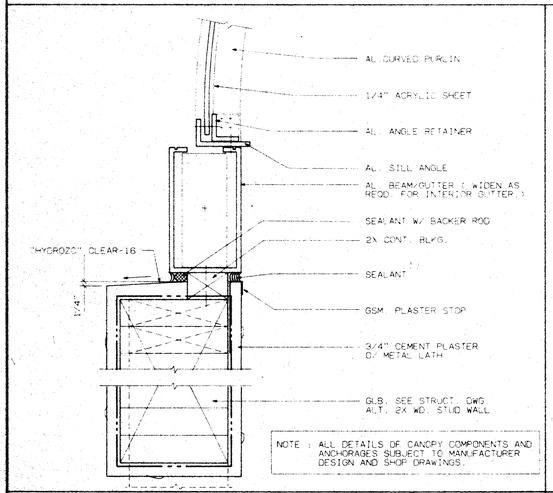

1 CANOPY SILL

DRAWING NO. CANOPY SILL1
SCALE 3" = 1'-0"

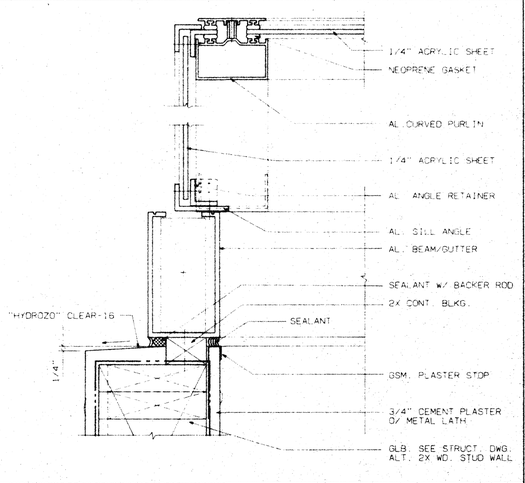

2 CANOPY END

DRAWING NO. CANOPY END1
SCALE 3" = 1'-0"

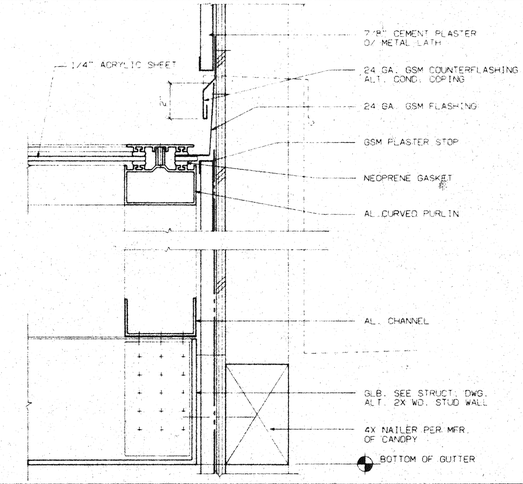

3 CANOPY AT WALL

DRAWING NO. CANOPY WALL1
SCALE 3" = 1'-0"

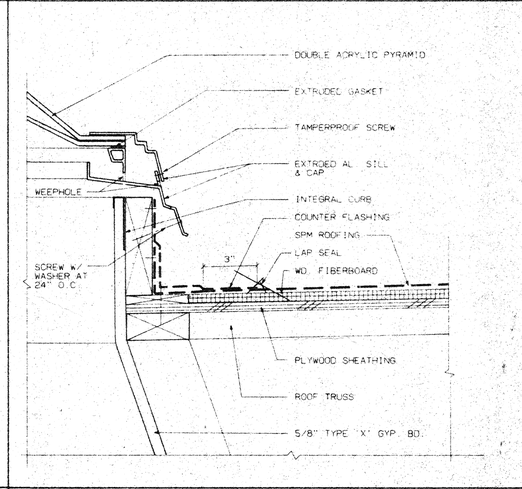

4 FLASHING AT SKYLIGHT

DRAWING NO. SKYLIGHT FLASH2
SCALE 3" = 1'-0"

© 1992 SKL ARCHITECTURE & PLANNING

SHEET NOTES

1. ALL WORK SHALL BE DONE IN ACCORDANCE WITH MANUFACTURER RECOMMENDATION.

2. ALL SHEET METAL SHALL BE 26 GA NO.3 GALVANIZED MIN. PROVIDE THICKNESS AS RECOMMENDED BY SMACNA.

3. CANOPIES : PROVIDE HALF-CIRCLE VAULTED SKYLIGHTS AS INDICATED ON DETAILS. SELECTED MANUFACTURER TO PROVIDE FINAL SHOP DRAWINGS. ALL FRAMING MEMEBERS TO BE OF 6063-T5 EXTRUDED ALUMINUM WITH A MIN. THICKNESS OF 0.78" FOR RETAINING CAPS AND 0.125" FOR CURB BEAMS. FINAL BEAM SIAIZING PER MANUFACTURER STRUCTURAL DESIGN. ALL RETAINING SCREWS SHALL BE ALUMINUM OR SERIES 300 NON-MAGNETICSTAINLESS STEEL. ACRYLIC CANOPY TO BE GRAY TINTED MIN. 1/4" THICK. SEALING SHALL BE PROVIDED WITH EPDM GASKETING. UNITS SHALL BE PROVIDED WITH INTEGRAL RAIN GUTTERS. PROVISION SHALL BE MADE FOR EXPANSION AND CONTRACTION OF ACRYLIC WHILE BEING HELD SECURELY IN PLACE. ALL UNITS TO BE SHIPPED PREGLAZED TO THE MAXIMUM POSSIBLE EXTENT.

MANUFACTURER : MAPES OR EQUAL.

4. PYRAMID SKYLIGHTS : SHALL BE FACTORY ASSEMBLED UNITS WITH 6063-T5 EXTRUDED ALUMINUM CURB FRAME WITH INTEGRAL SLOPED GUTTER ANDCOME ELEVATING LEG WITH CONTINUOUS SUPPORT GASKET AND RETAINING FRAME. SKYLIGHTS SHALL BE MANUFACTURED TO SUPPORT 40 PSF LIVE LOAD. OUTSIDE FASTENERS FOR 4" WIDE CURB SHALL BE INCLUDED. PRIMARY PYRAMID TO BE GRAY TINTED. SECONDARY PYRAMIND TO BE CLEAR 1/4" THICK MIN. ACRYLIC.

MANUFACTURER : O'KEEFE, HORIZONLITE, OR EQUAL.

DATE	DESCRIPTION	REV.	BY
12-21-92	PLAN CHECK ADDENDA	1	SKL

SKL ARCHITECTURE & PLANNING
3018 Willow Pass Road, Suite 208
Concord, California 94519
Phone 510 680 2711
Fax 510 680 2717

OWNER
H.L. PATEL
CONTACT VIJAY PATEL
1133 PEBBLEWOOD WAY
SAN MATEO, CA 94403
TEL. (415) 570 6970

PROJECT
PROPOSED 37-UNIT MOTEL
2834 EL CAMINO REAL
REDWOOD CITY, CA 94603

NORTH

SHEET TITLE
DOOR/WINDOW DETAILS

DRAWN	SKL 1
CHKD	
SCALE	3/8"=1'-0" AS SHOWN
DATE	OCT 15,1992
JOB NO.	92002
FILENAME	RCA-15

SHEET NO. A-15 OF