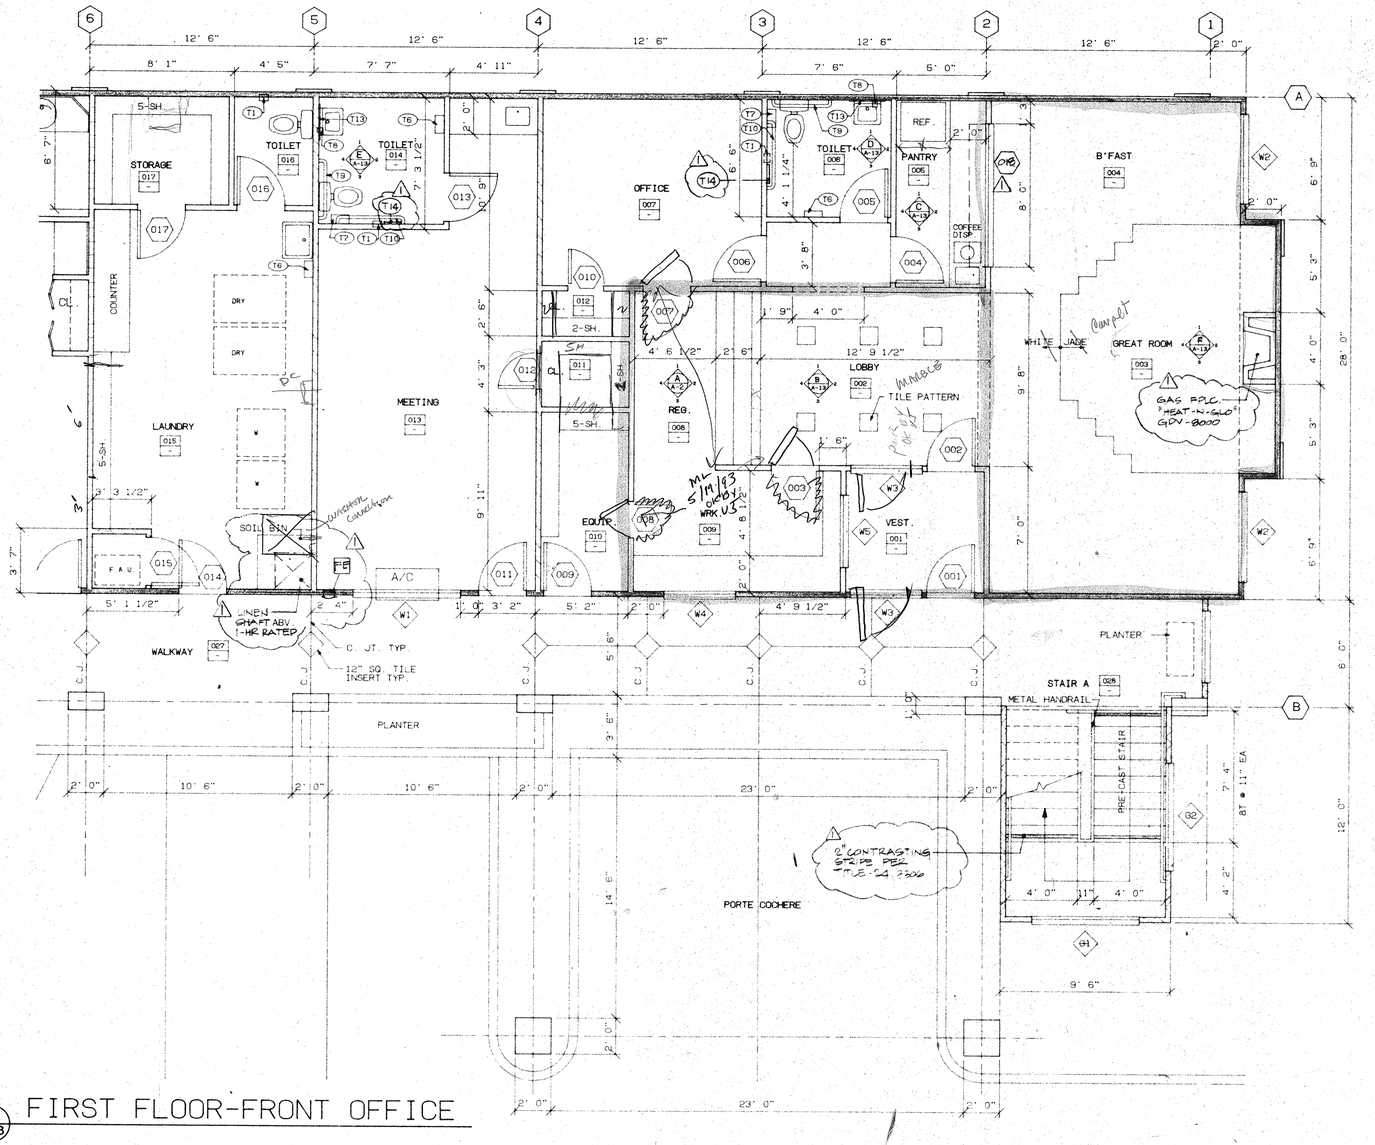

1 A-8 FIRST FLOOR-FRONT OFFICE

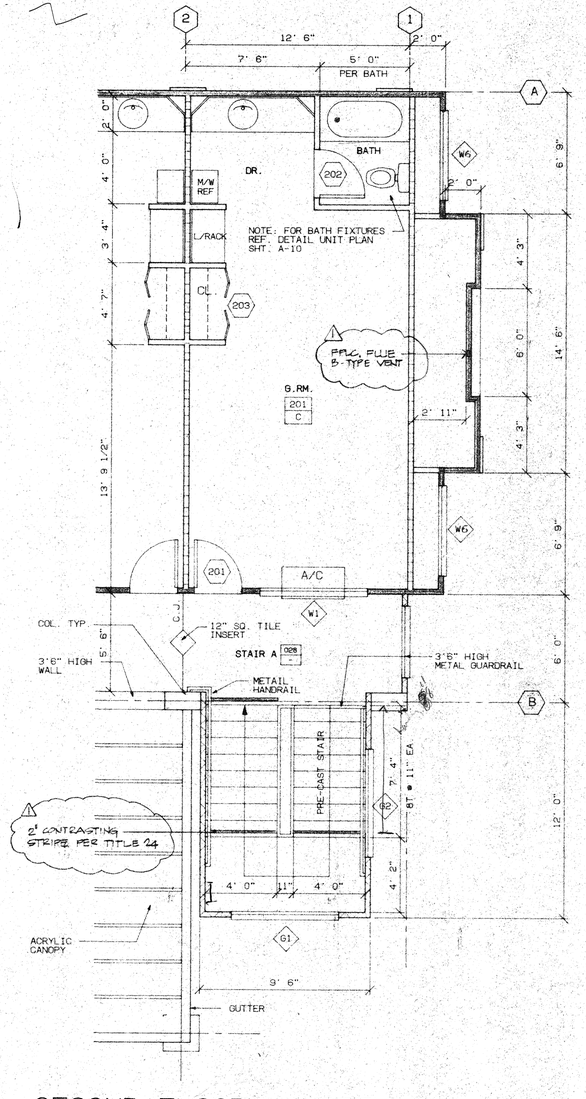

2 A-8 SECOND FLOOR - NORTH END

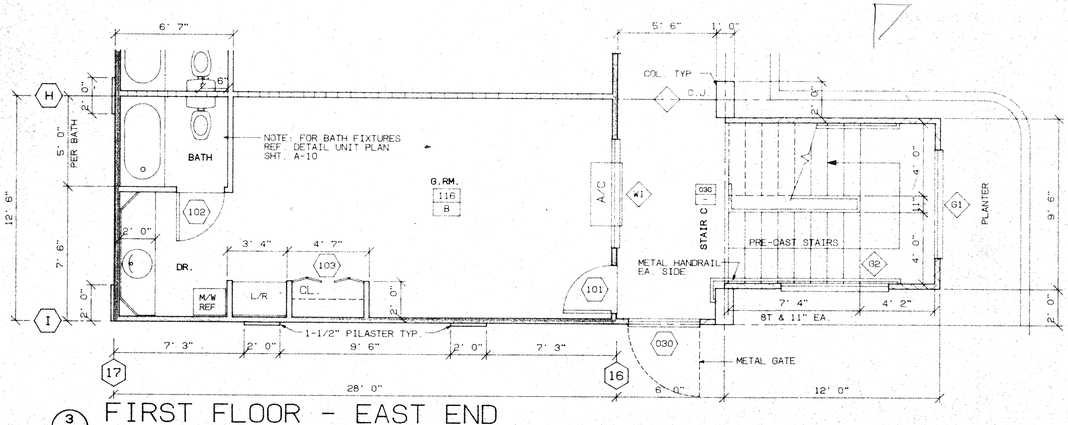

3 A-8 FIRST FLOOR - EAST END

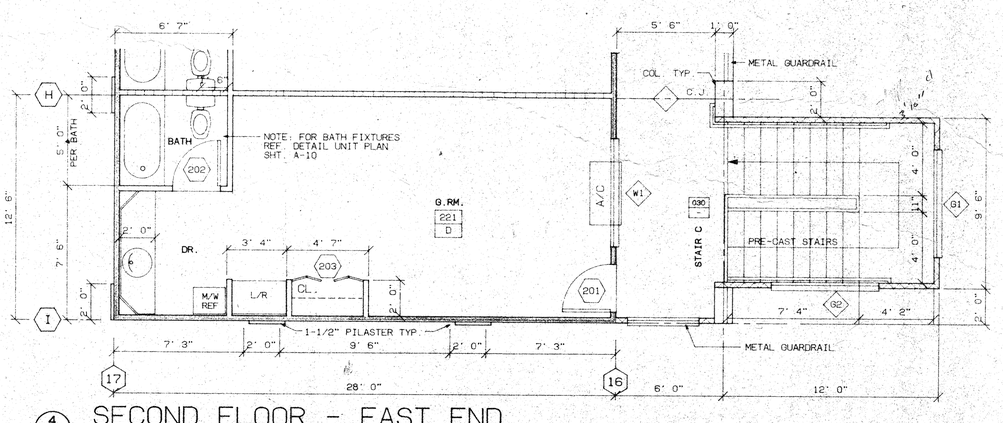

4 A-8 SECOND FLOOR - EAST END

© 1992 SKL ARCHITECTURE & PLANNING

WALL LEGEND

TYPE	RATING	DETAIL
EXTERIOR BEARING	1-HR	1/A-11
EXTERIOR EXPOSED	1-HR	2/A-11
INTERIOR BEARING	1-HR	5/A-11
INTERIOR PARTY	1-HR	3/A-11
INTERIOR PARTITION	NONE	4/A-11

NOTE: ALL PLUMBING WALLS TO BE 2X6 MIN.

FE FIRE EXTINGUISHER

TOILET FIXTURE LEGEND

CODE	ITEM
T1	EXT. 20LL RECESSED TOILET TISSUE HOLDER
T2	RECESSED FACIAL TISSUE DISPENSER
T3	HOTEL TOWEL RACK
T4	TOWEL BAR
T5	SHOWER CURTAIN ROD
T6	PAPER TOWEL DISPENSER
T7	SANITARY NAPKIN DISPOSER
T8	LIQUID SOAP DISPENSER
T9	36" GRAB BAR
T10	48" GRAB BAR
T11	48" MIRROR
T12	CUSTOM MIRROR
T13	24"X36" MIRROR
T14	TOILET SEAT COVER DISPENSER

SHEET NOTES

DATE	DESCRIPTION	REV	BY
12-21-92	PLAN CHECK ADDENDUM	1	SKL

SKL ARCHITECTURE & PLANNING
3018 Willow Pass Road, Suite 206
Concord, California 94519
Phone 510 680 2711
Fax 510 680 2717

OWNER
H.L. PATEL
CONTACT: VIJAY PATEL
1133 PEBBLEWOOD WAY
SAN MATEO, CA 94403
TEL : (415) 570 6970

PROJECT
PROPOSED 37-UNIT MOTEL
2834 EL CAMINO REAL
REDWOOD CITY, CA 94603

NORTH

SHEET TITLE
DETAIL FLOOR PLAN

DRAWN	SKL
CHKD	
SCALE	1/4"=1'-0"
DATE	SEP.15,1992
JOB NO.	92002
FILENAME	RCA-8.B

SHEET NO. A-8 OF