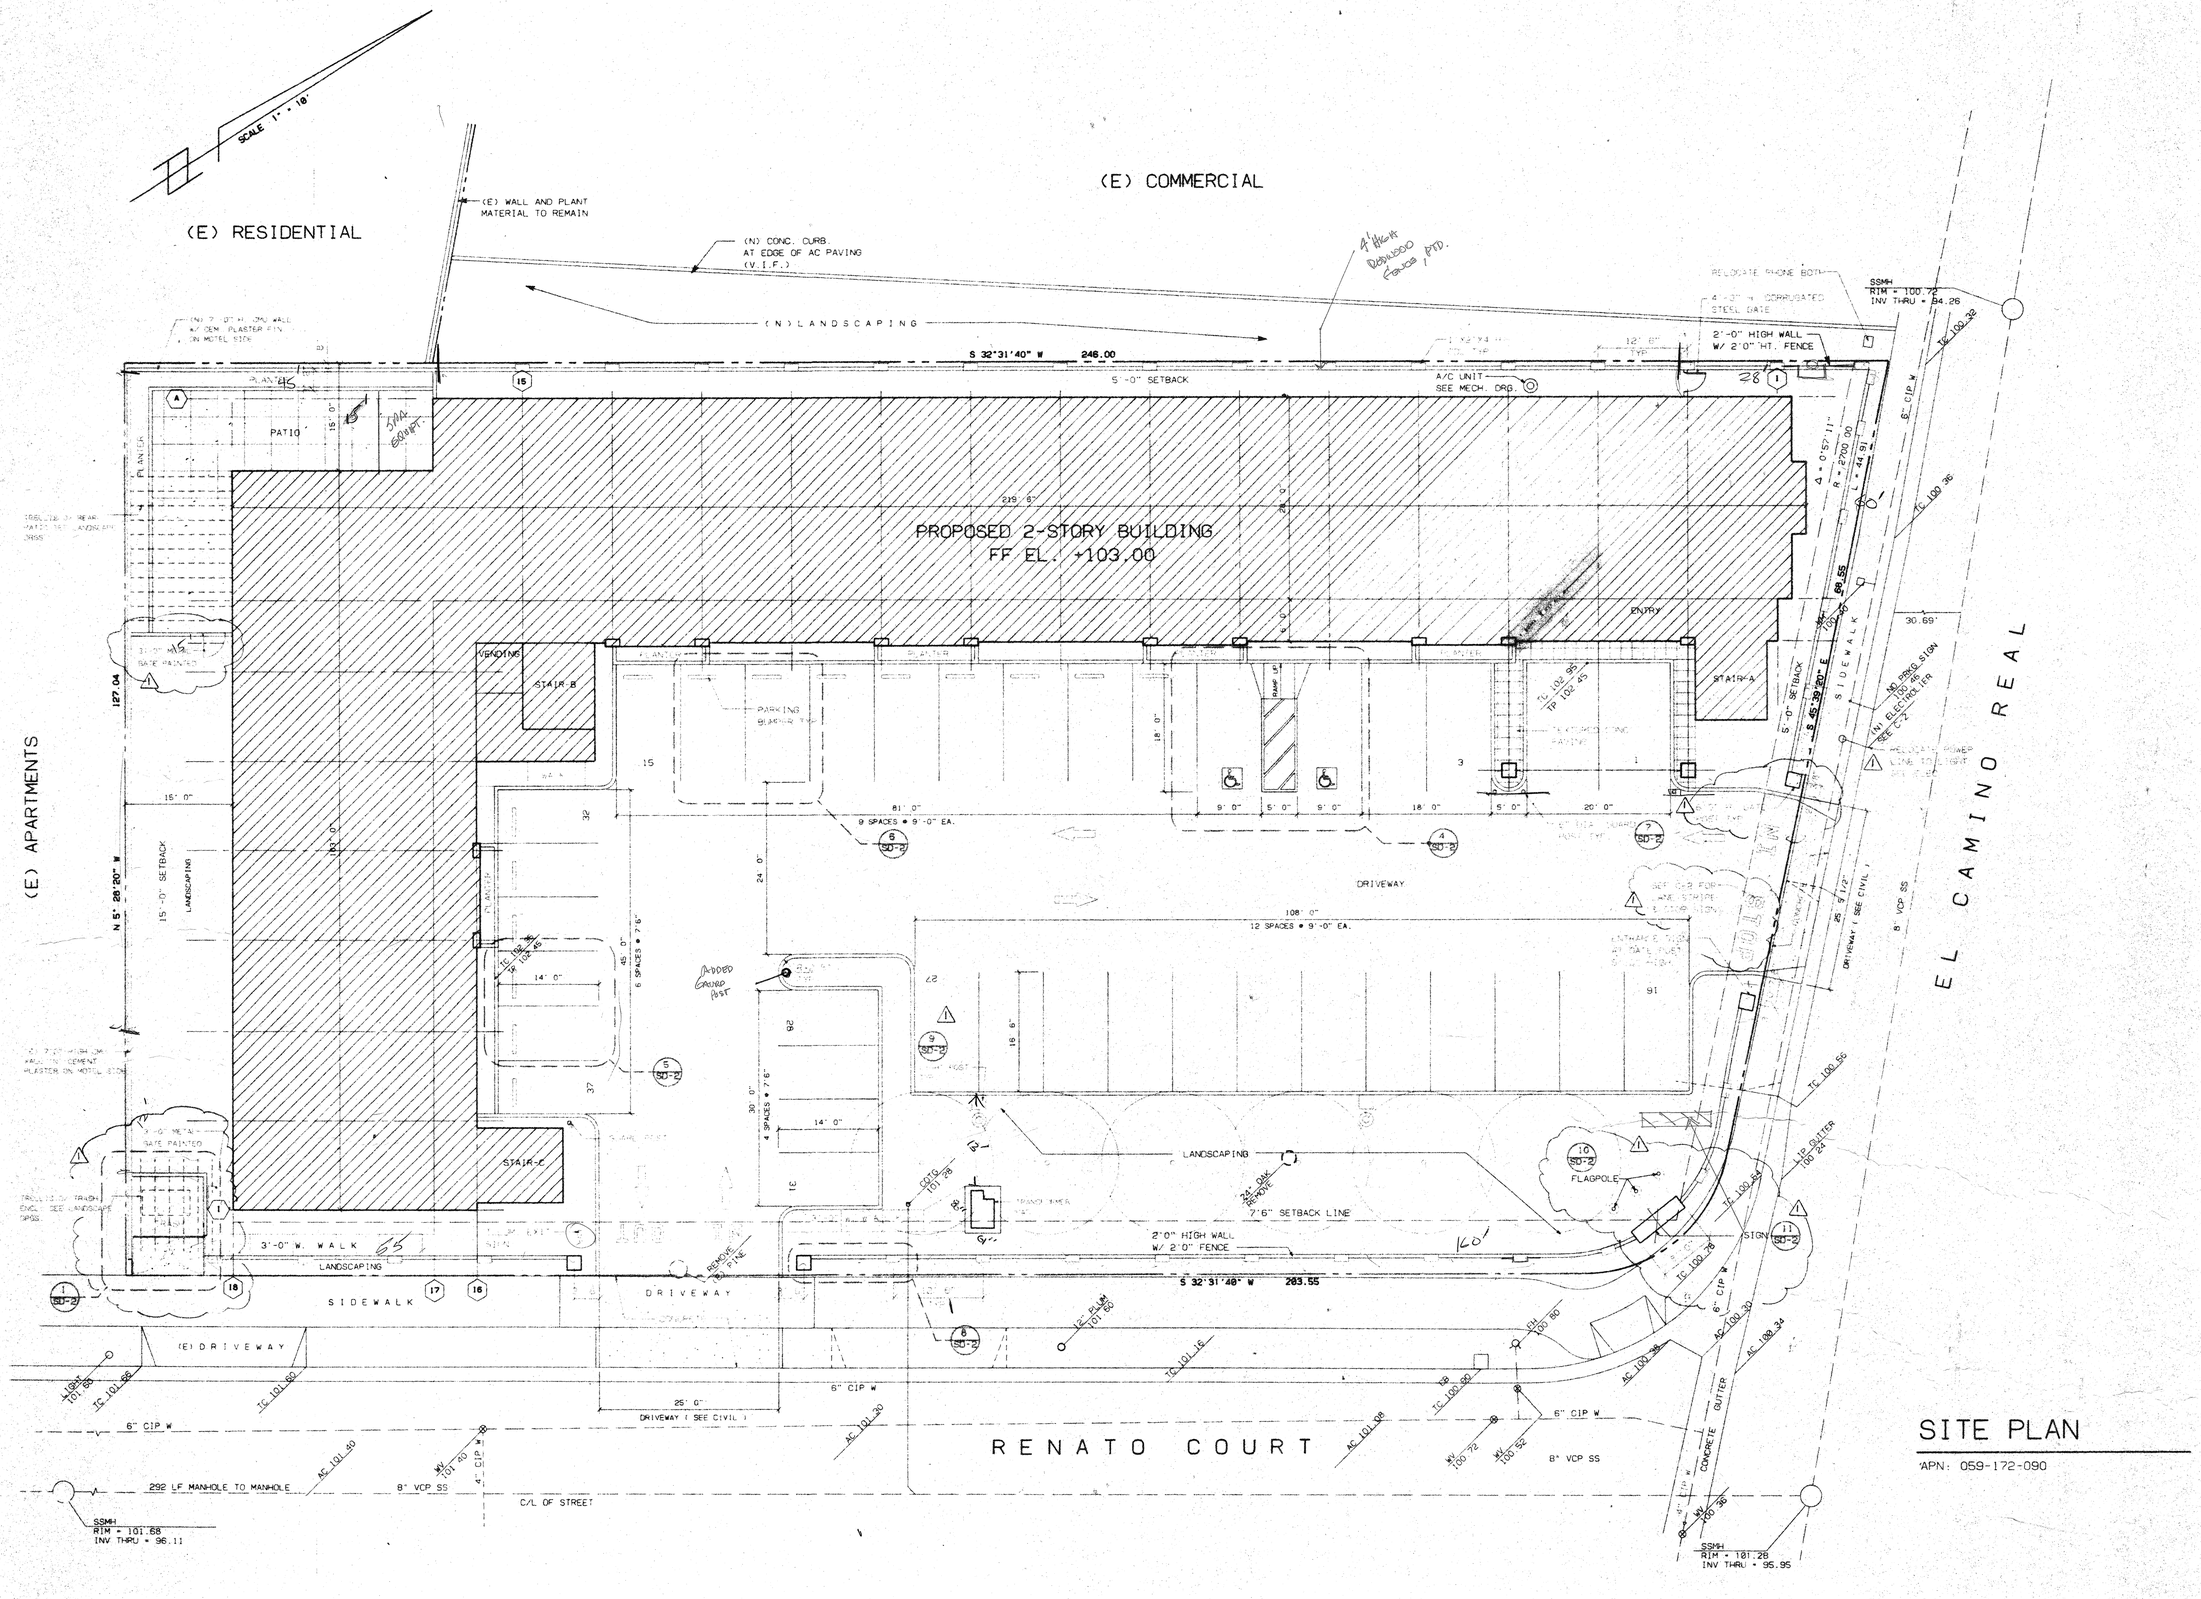

SITE PLAN

APN: 059-172-090

© 1992 SKL ARCHITECTURE & PLANNING

SHEET NOTES

1. ALL SURVEY DATA FROM SURVEY DRAWING PROVIDED BY BLISS ENGINEERING.

2. THIS DRAWING TO BE READ IN CONJUCTION WITH RELEVANT CIVIL, LANDSCAPE AND ELECTRICAL DRAWINGS.

LEGEND

- PROPOSED BUILDING
- EXISTING BUILDING
- CONCRETE PAVING
- ASPHALT PAVING
- PROPERTY LINE
- EASEMENT LINE
- SANITARY SEWER
- TOP OF PAVING
- TOP OF CURB
- CATCH BASIN
- STREET LIGHT

DATE	DESCRIPTION	REV	BY
12-21-92	PLAN CHECK ADDENDUM	1	SKL

SKL ARCHITECTURE & PLANNING
3018 Willow Pass Road, Suite 206
Concord, California 94519
Phone 510 680 2711
Fax 510 680 2717

OWNER
H.L. PATEL
CONTACT: VIJAY PATEL
1133 PEBBLEWOOD WAY
SAN MATEO, CA 94403
TEL : (415) 570 6970

PROJECT
PROPOSED 37-UNIT MOTEL
2834 EL CAMINO REAL
REDWOOD CITY, CA-94063

NORTH

SHEET TITLE
SITE PLAN

DRAWN	SKL
CHKD	
SCALE	1"=10'-0"
DATE	SEP 30,1992
JOB NO.	92002
FILENAME	RCSD-1.8

SHEET NO.
SD-1
OF